
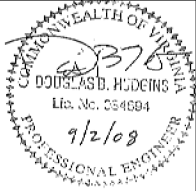


I:\Dwg\WWA\12307.08 Wasena Park Crossing\As-builts\C104.dwg, 6/15/2009 9:07:55 AM, mmohler

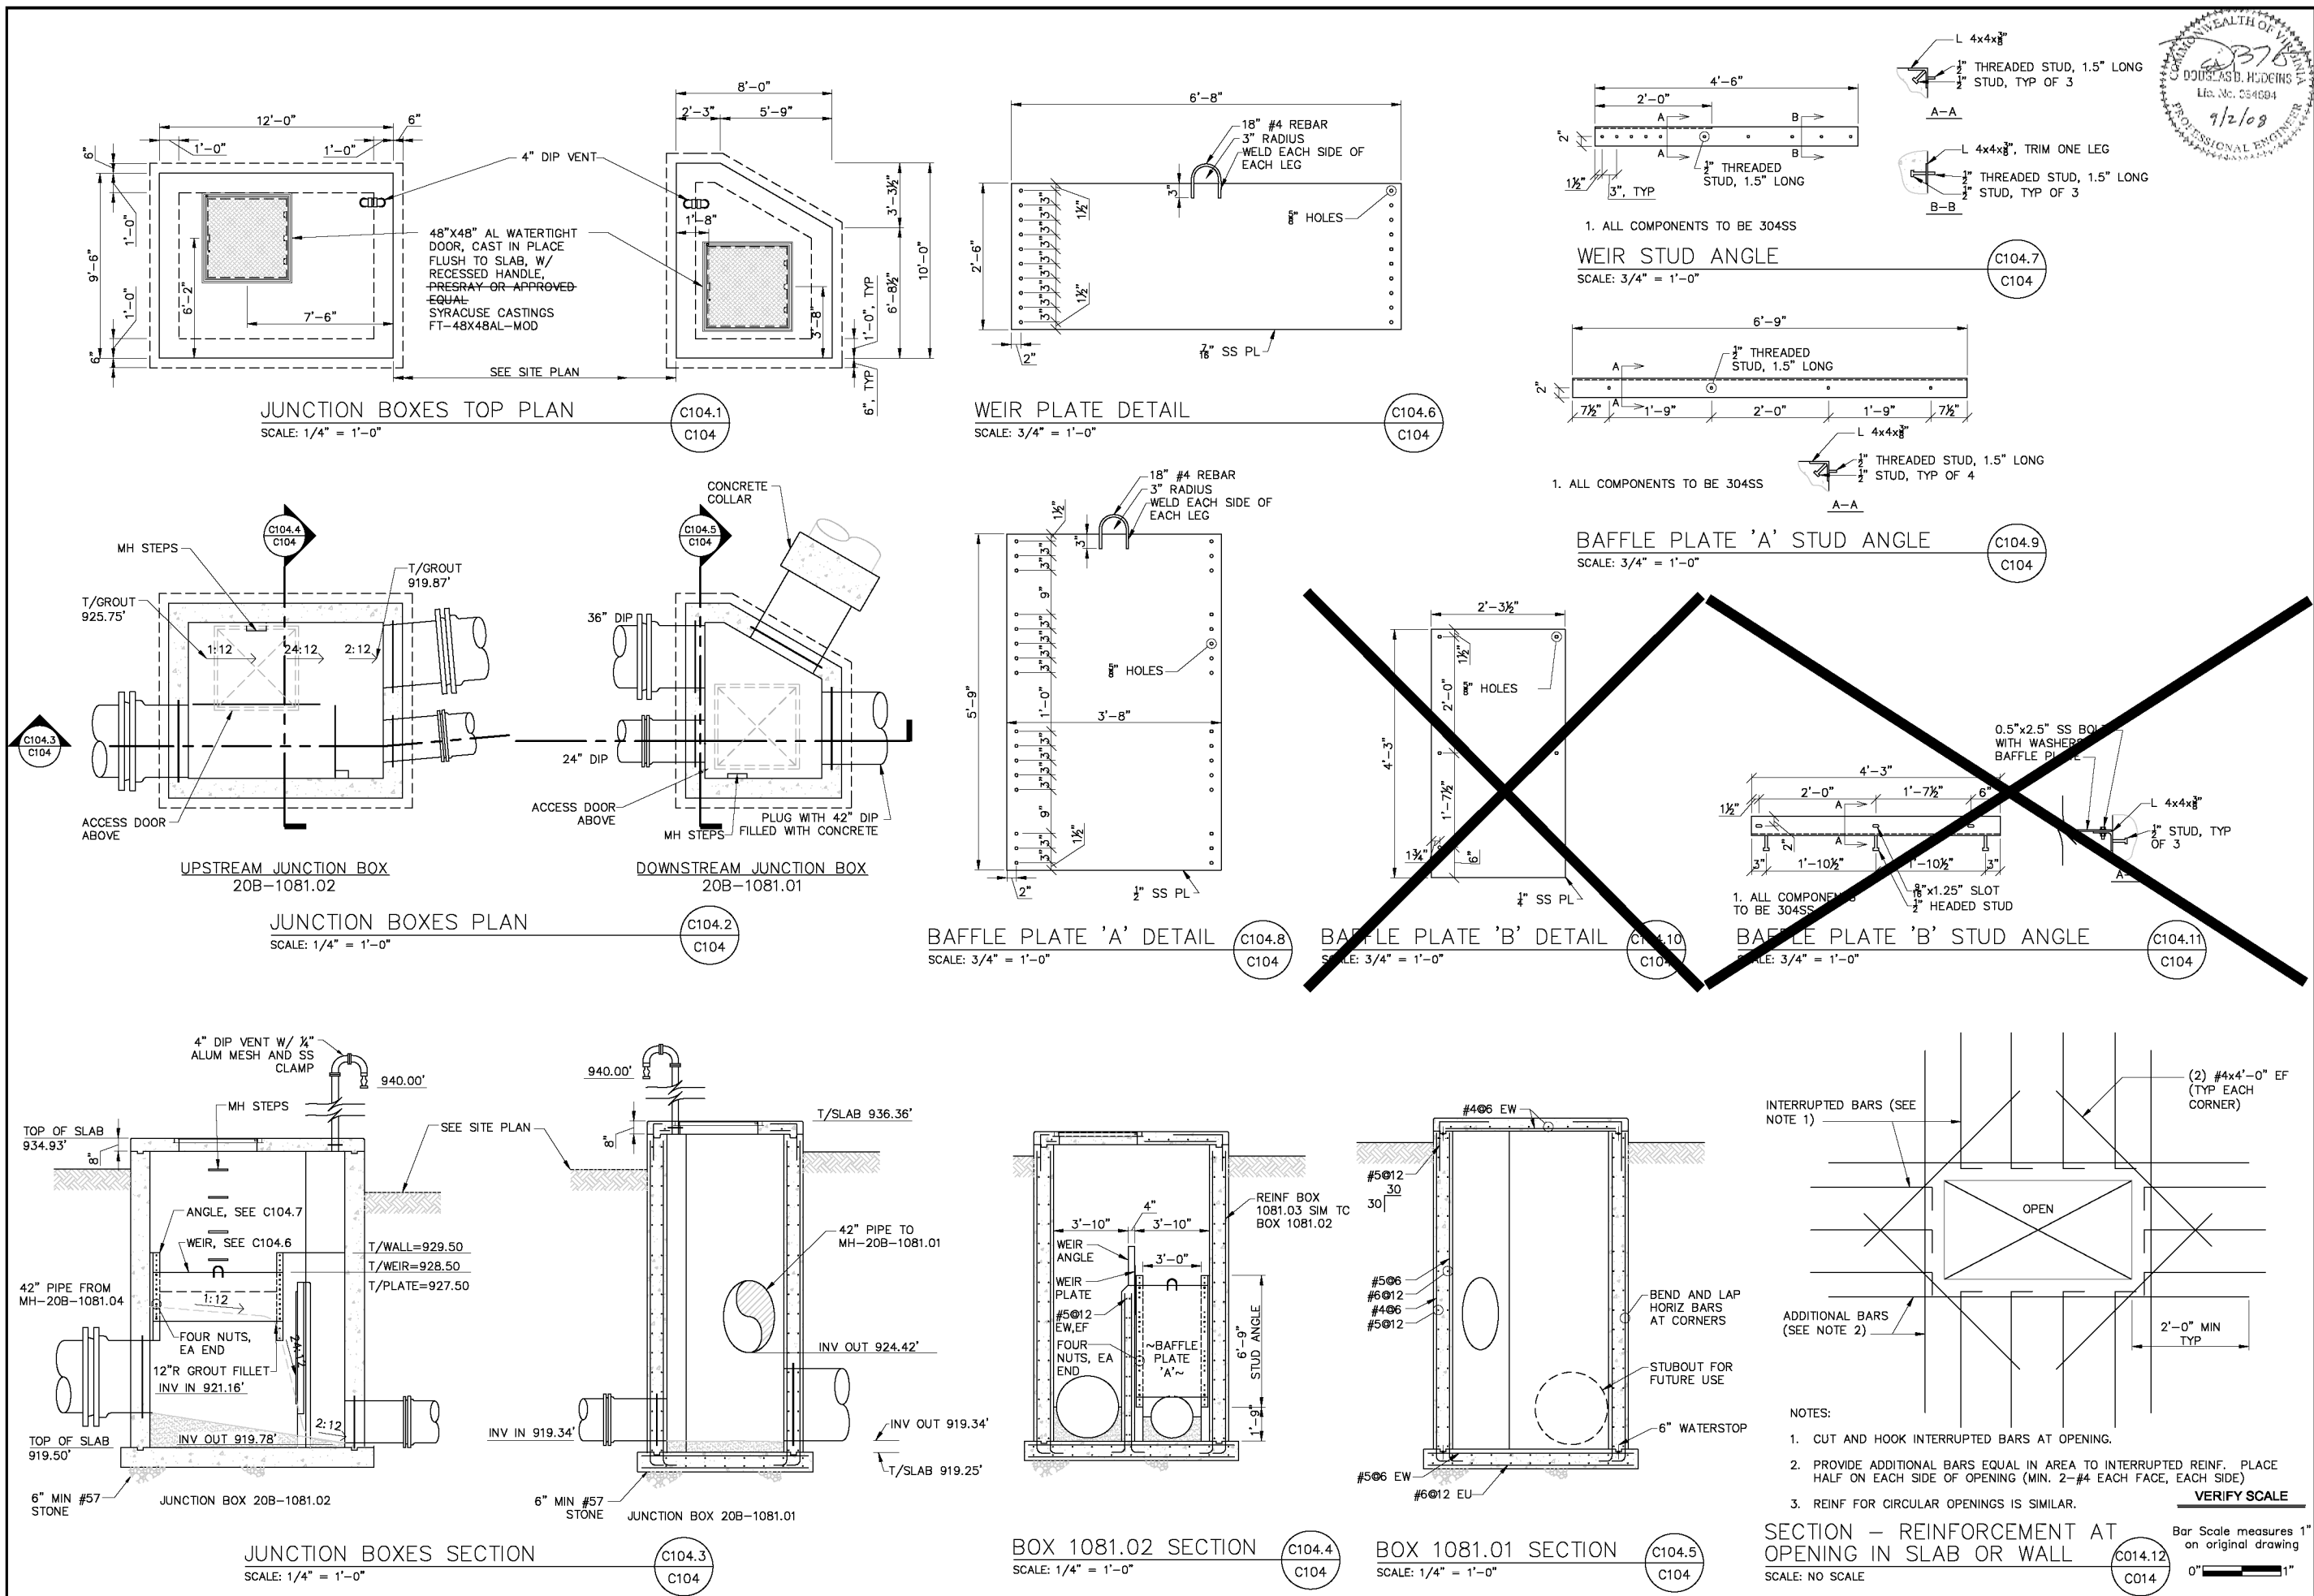

OLVER INCORPORATED
Consulting Engineers & Applied Scientists
1116 SOUTH MAIN STREET
BLACKSBURG, VIRGINIA 24060
(540) 552-5548

WESTERN VIRGINIA WATER AUTHORITY		INTERCEPTOR IMPROVEMENTS AT WASENA PARK		JUNCTION BOXES PLAN AND SECTION	
E	AS-BUILT	6/11/09	DBH		By
D	E&S COMMENTS	1/20/09	MFW		
C	CONSTRUCTION ISSUE	1/5/09	DBH		
B	BID ISSUE/VDQ REVIEW	8/27/08	DBH		
A	CLIENT REVIEW	8/20/08	DBH		
Rev	Description	Date			

Designed: ETA
Drawn: MJM
Checked: DBH
Date: 6/25/08
Scale: AS SHOWN
Job No. 12307.08
Archived File Name:

C104