

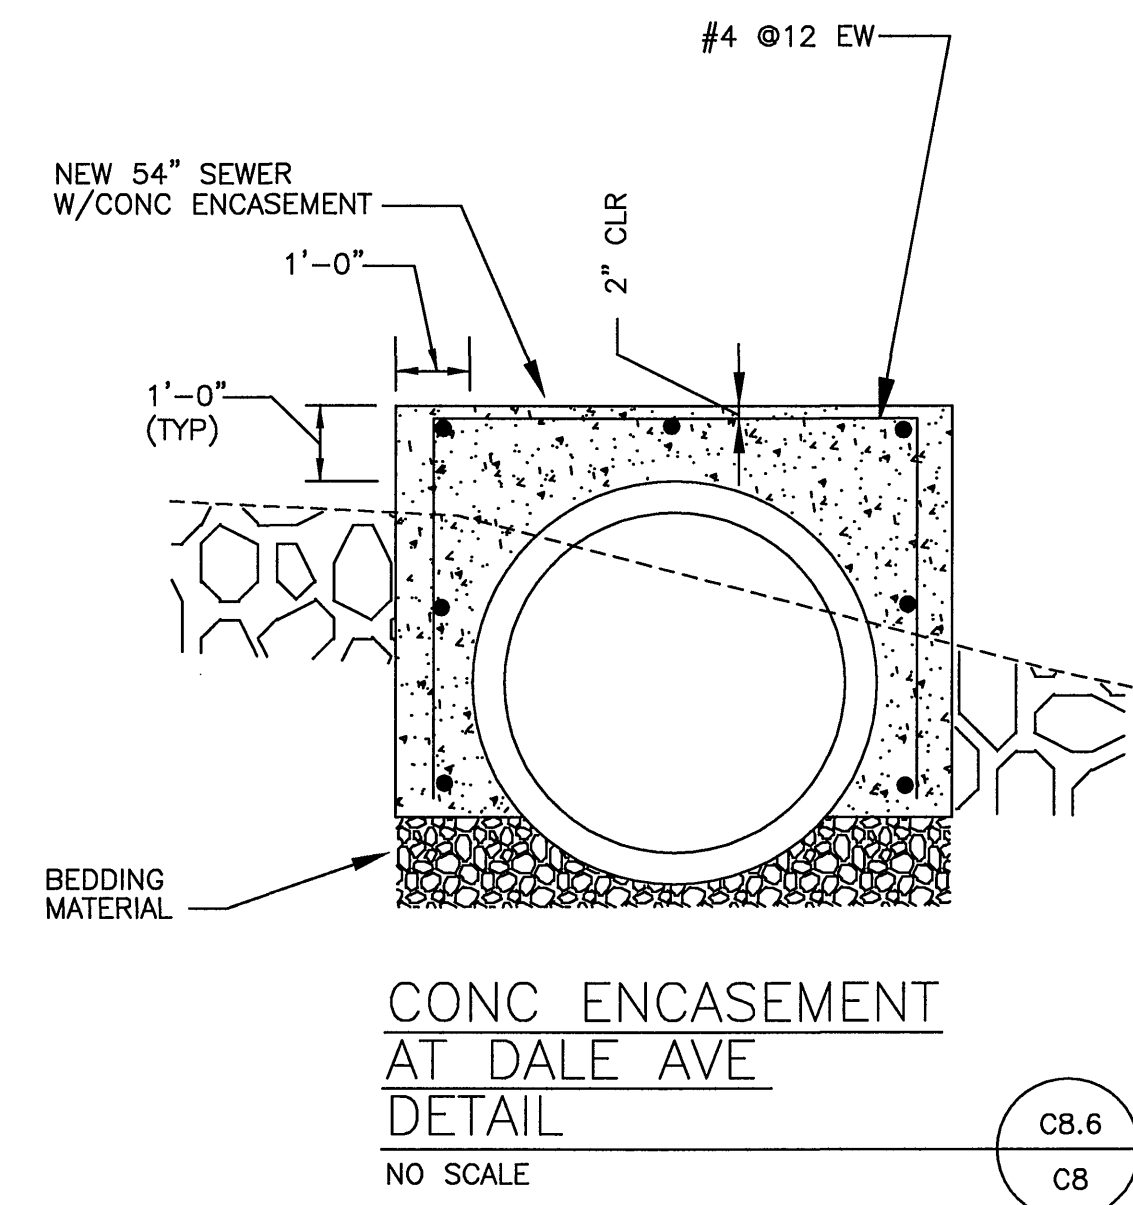
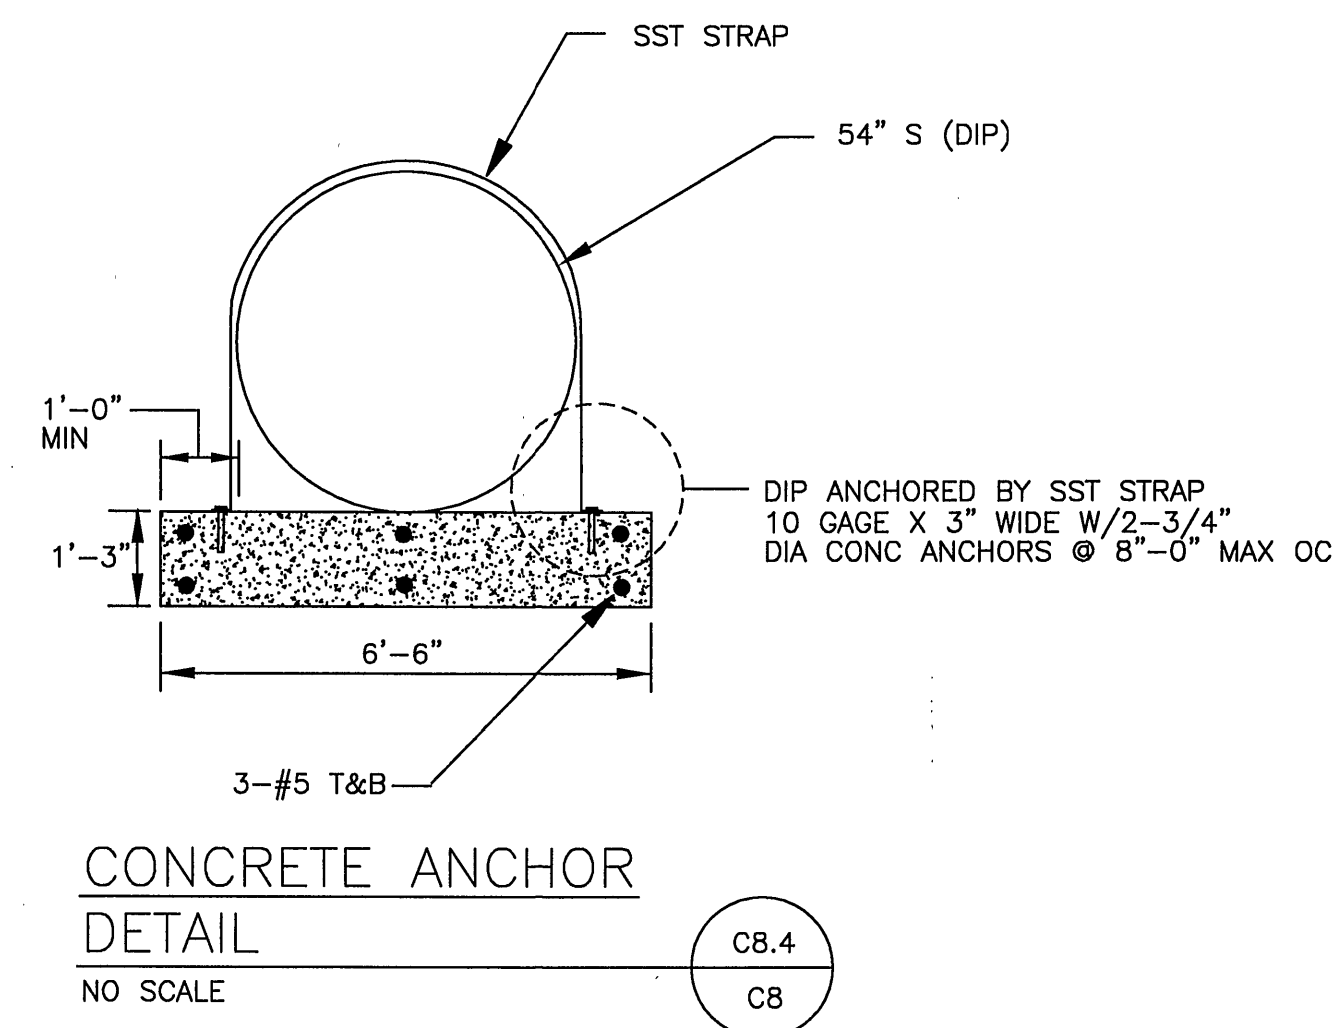
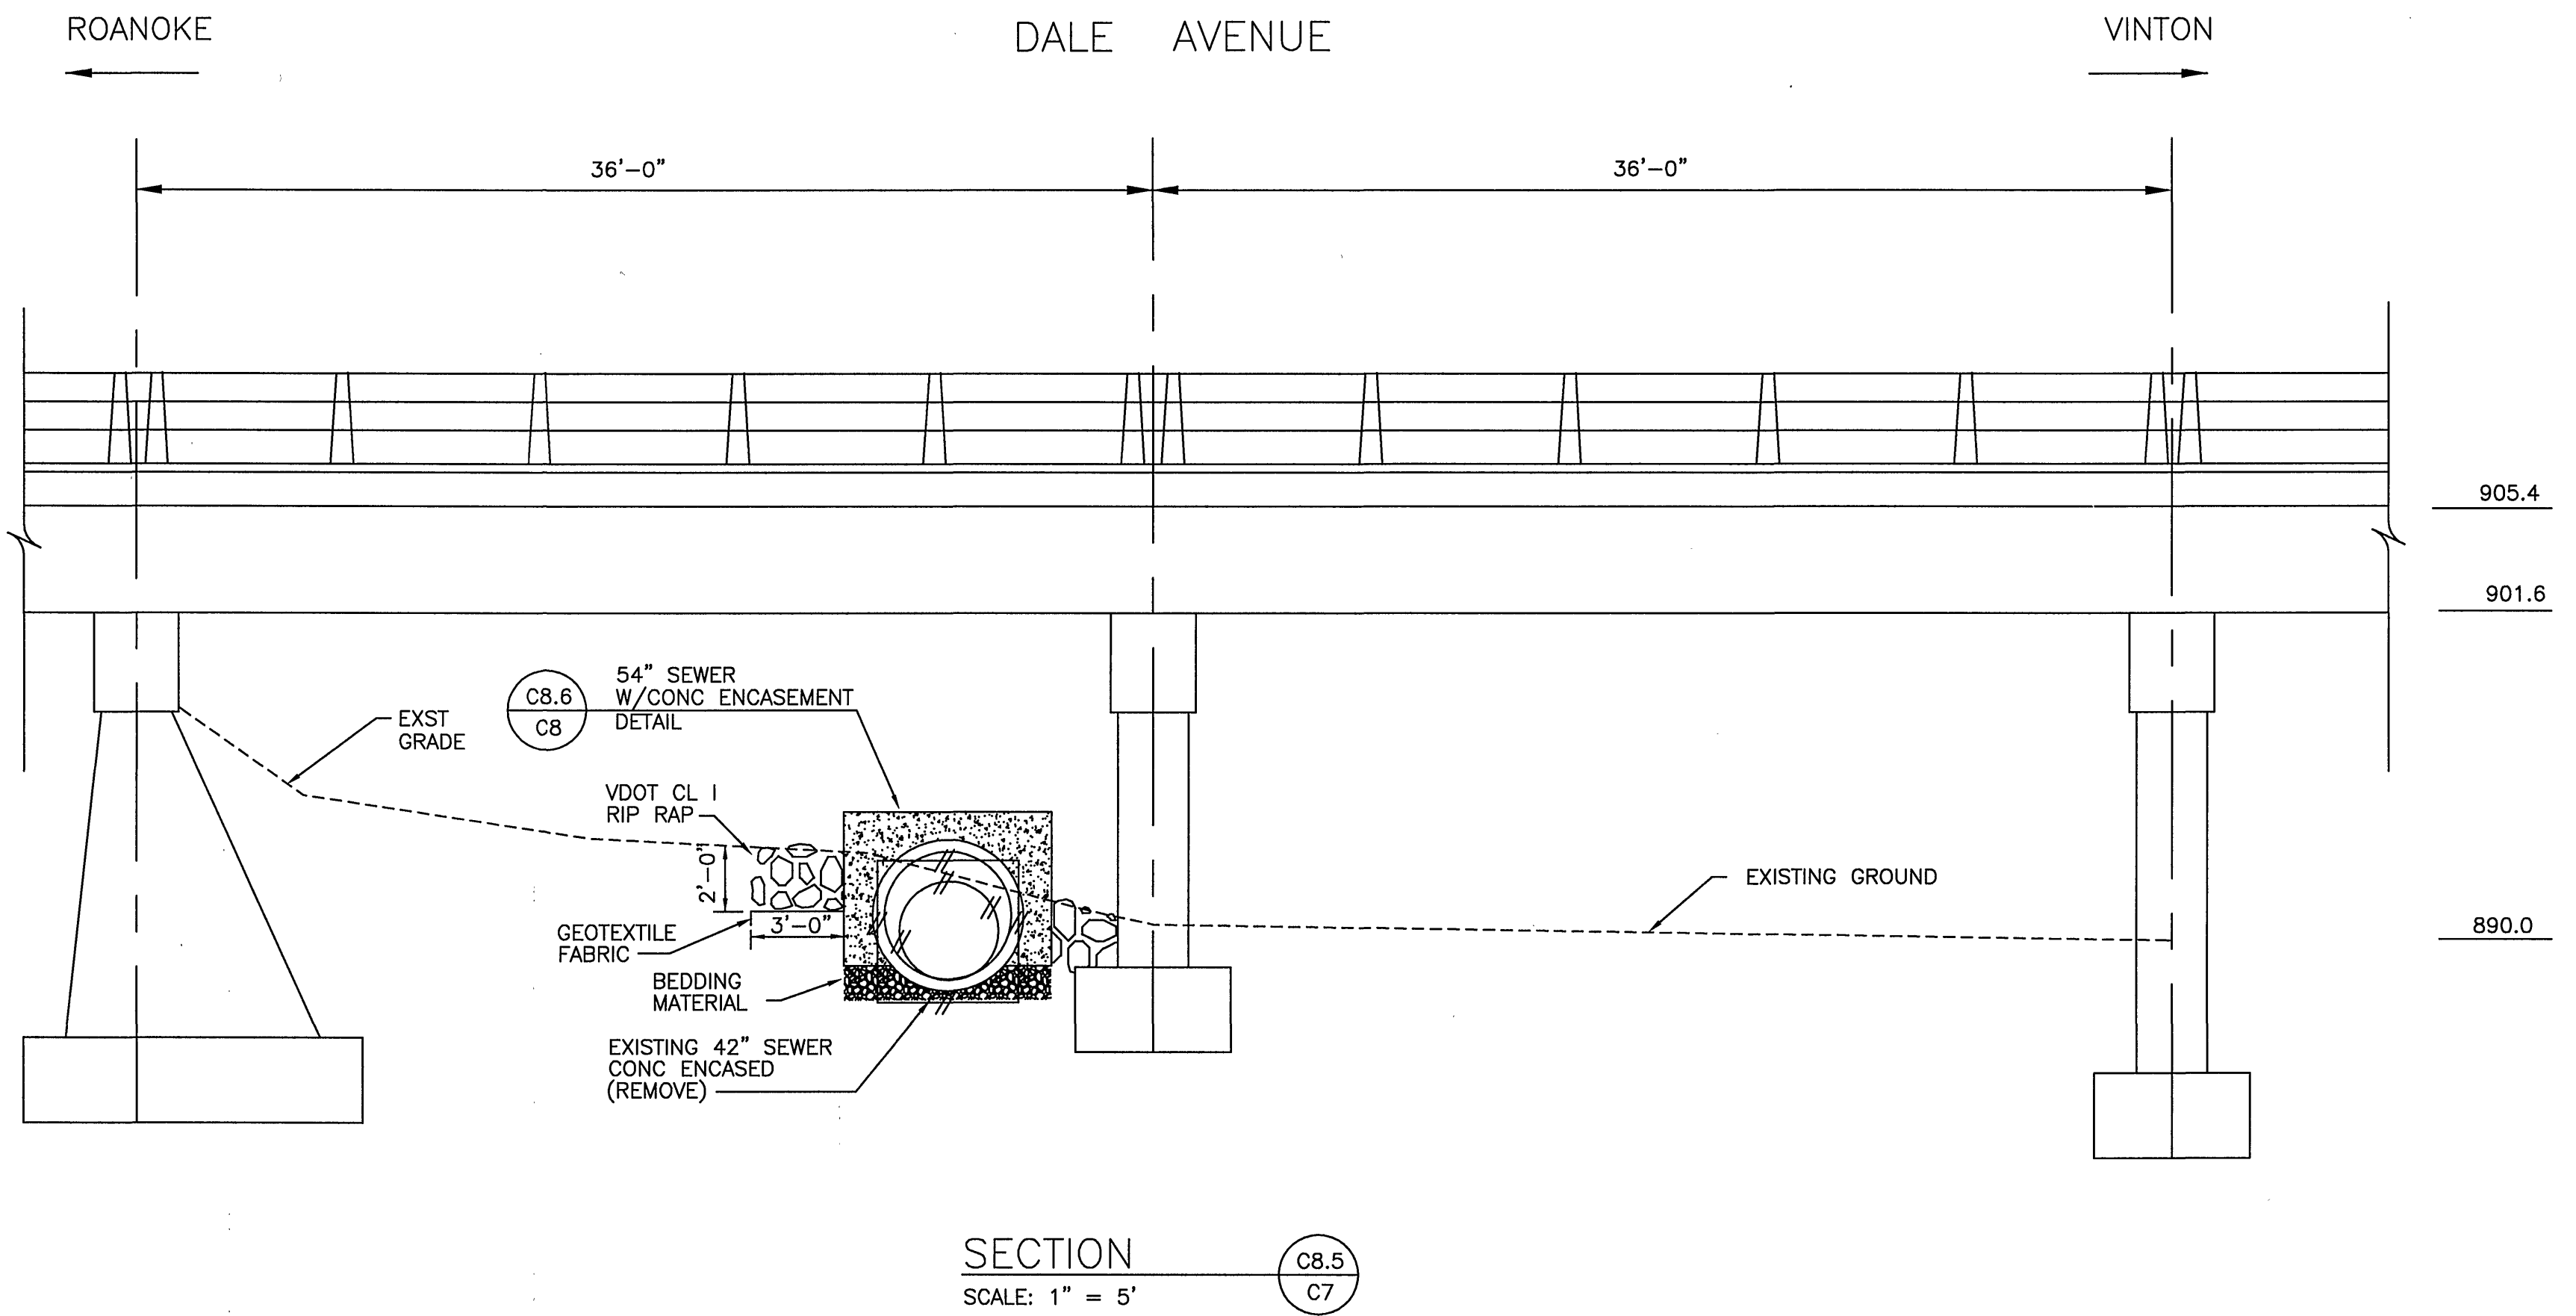
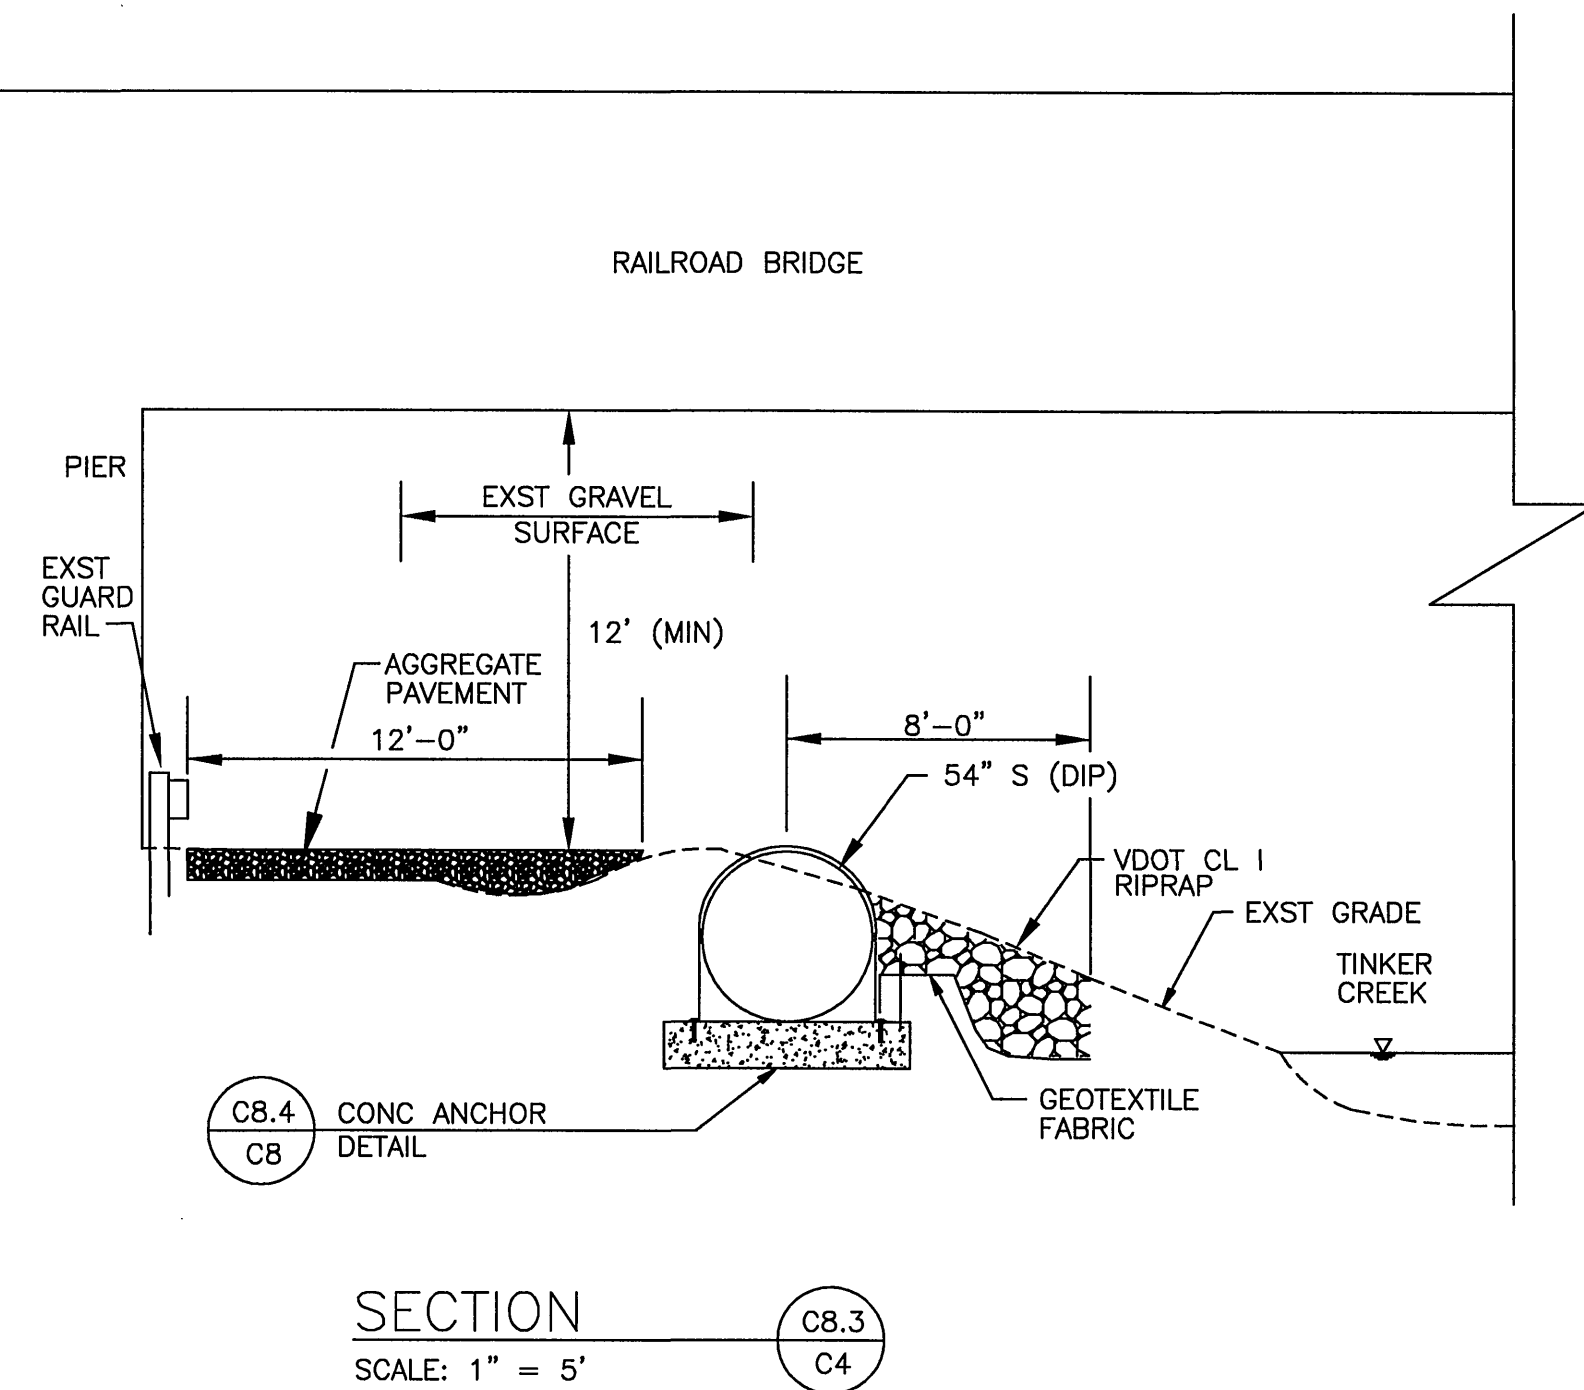
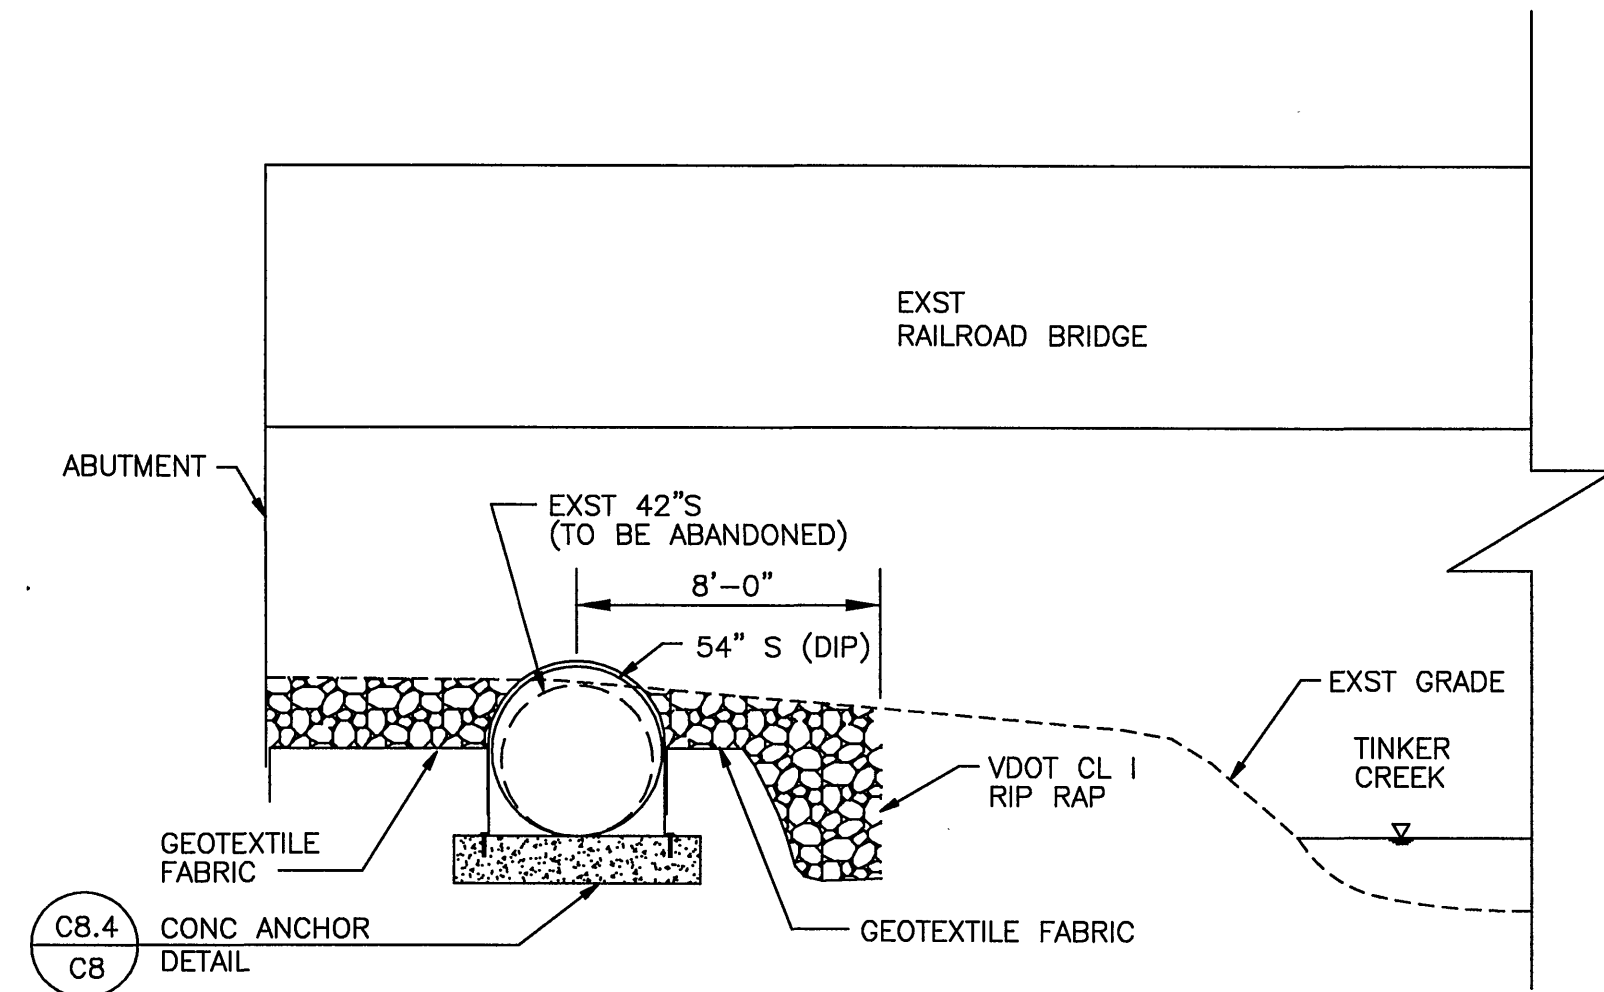


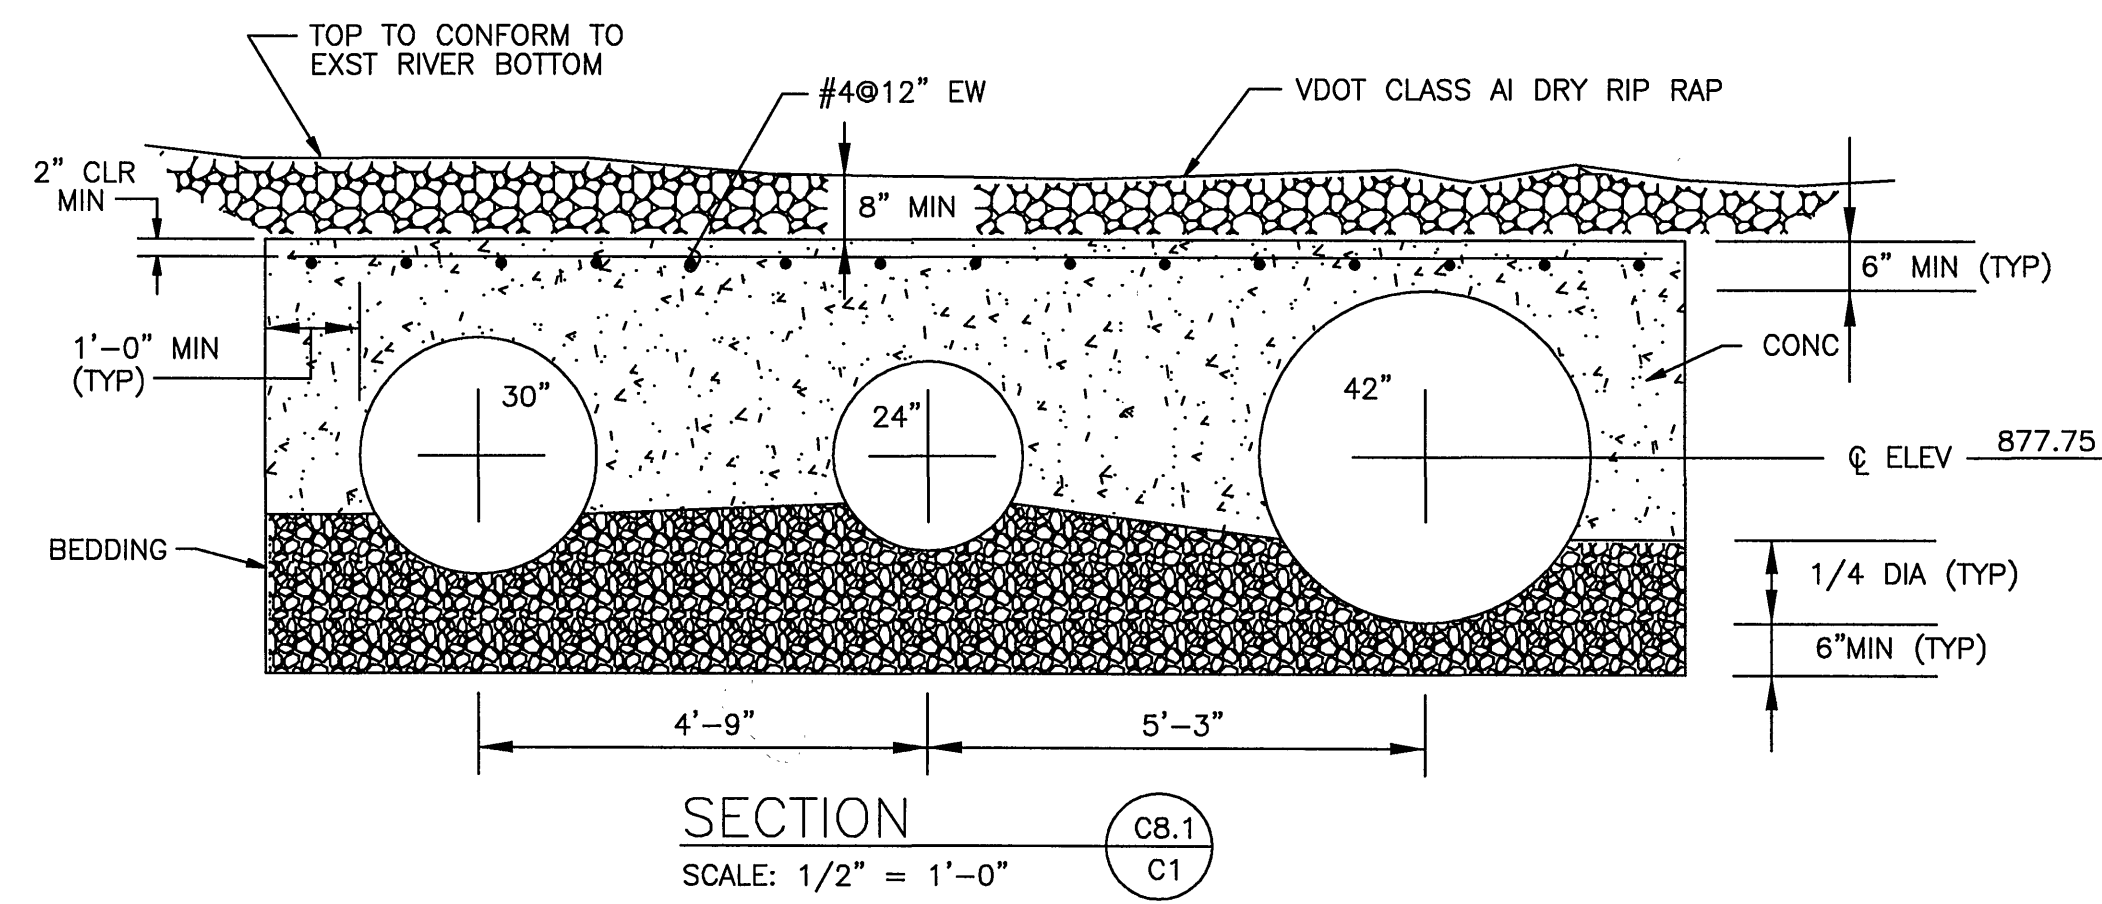

HAYES, SEAY, MATTERN & MATTERN, INC.  
ARCHITECTS/ENGINEERS/PLANNERS  
ROANOKE, VIRGINIA

| DESIGNED: DMH | DATE     | BY  | REVISIONS                             |
|---------------|----------|-----|---------------------------------------|
|               | 10/15/98 | MNH | RECORD DRAWINGS SEE SHEET G1 FOR NOTE |
| DRAWN: MHL    |          |     |                                       |
| CHECKED:      |          |     |                                       |
| APPROVED:     |          |     |                                       |

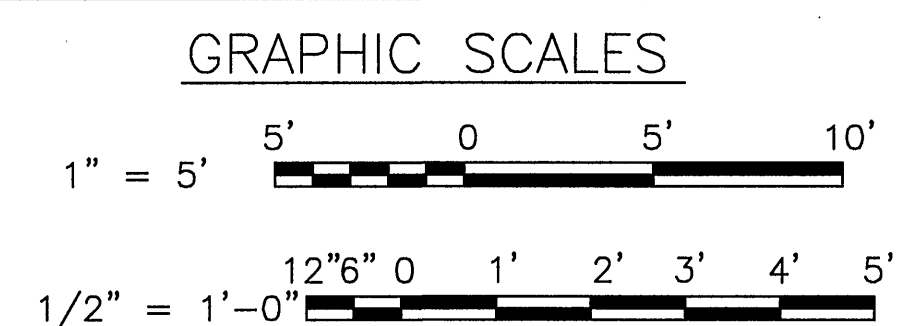

|                                                             |                 |                    |
|-------------------------------------------------------------|-----------------|--------------------|
| TINKER CREEK INTERCEPTOR SEWER<br>CITY OF ROANOKE, VIRGINIA |                 |                    |
| DETAILS AND SECTIONS                                        |                 |                    |
| COMM. NO.: 7211                                             | SCALE: AS NOTED | DATE: MAY 17, 1996 |

|                         |
|-------------------------|
| PROJECT NO.: 6317       |
| CONTRACT A<br>SHEET NO. |
| C8                      |
| RECORD DRAWINGS         |