

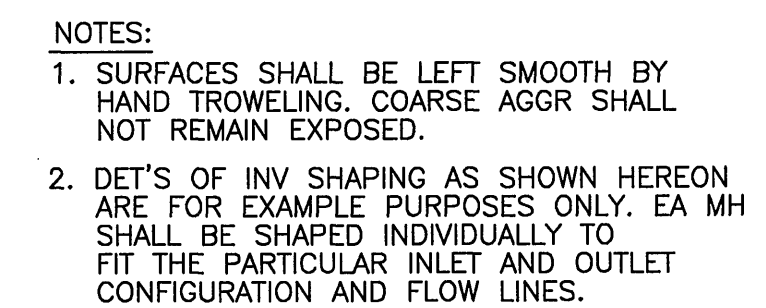
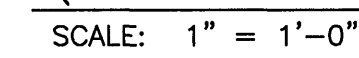
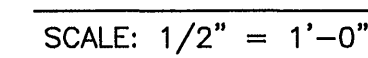
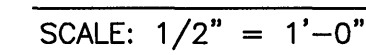
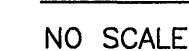


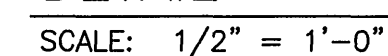

NO SCALE

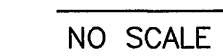

SCALE: 1" = 1'-0"

RECORD DRAWINGS