




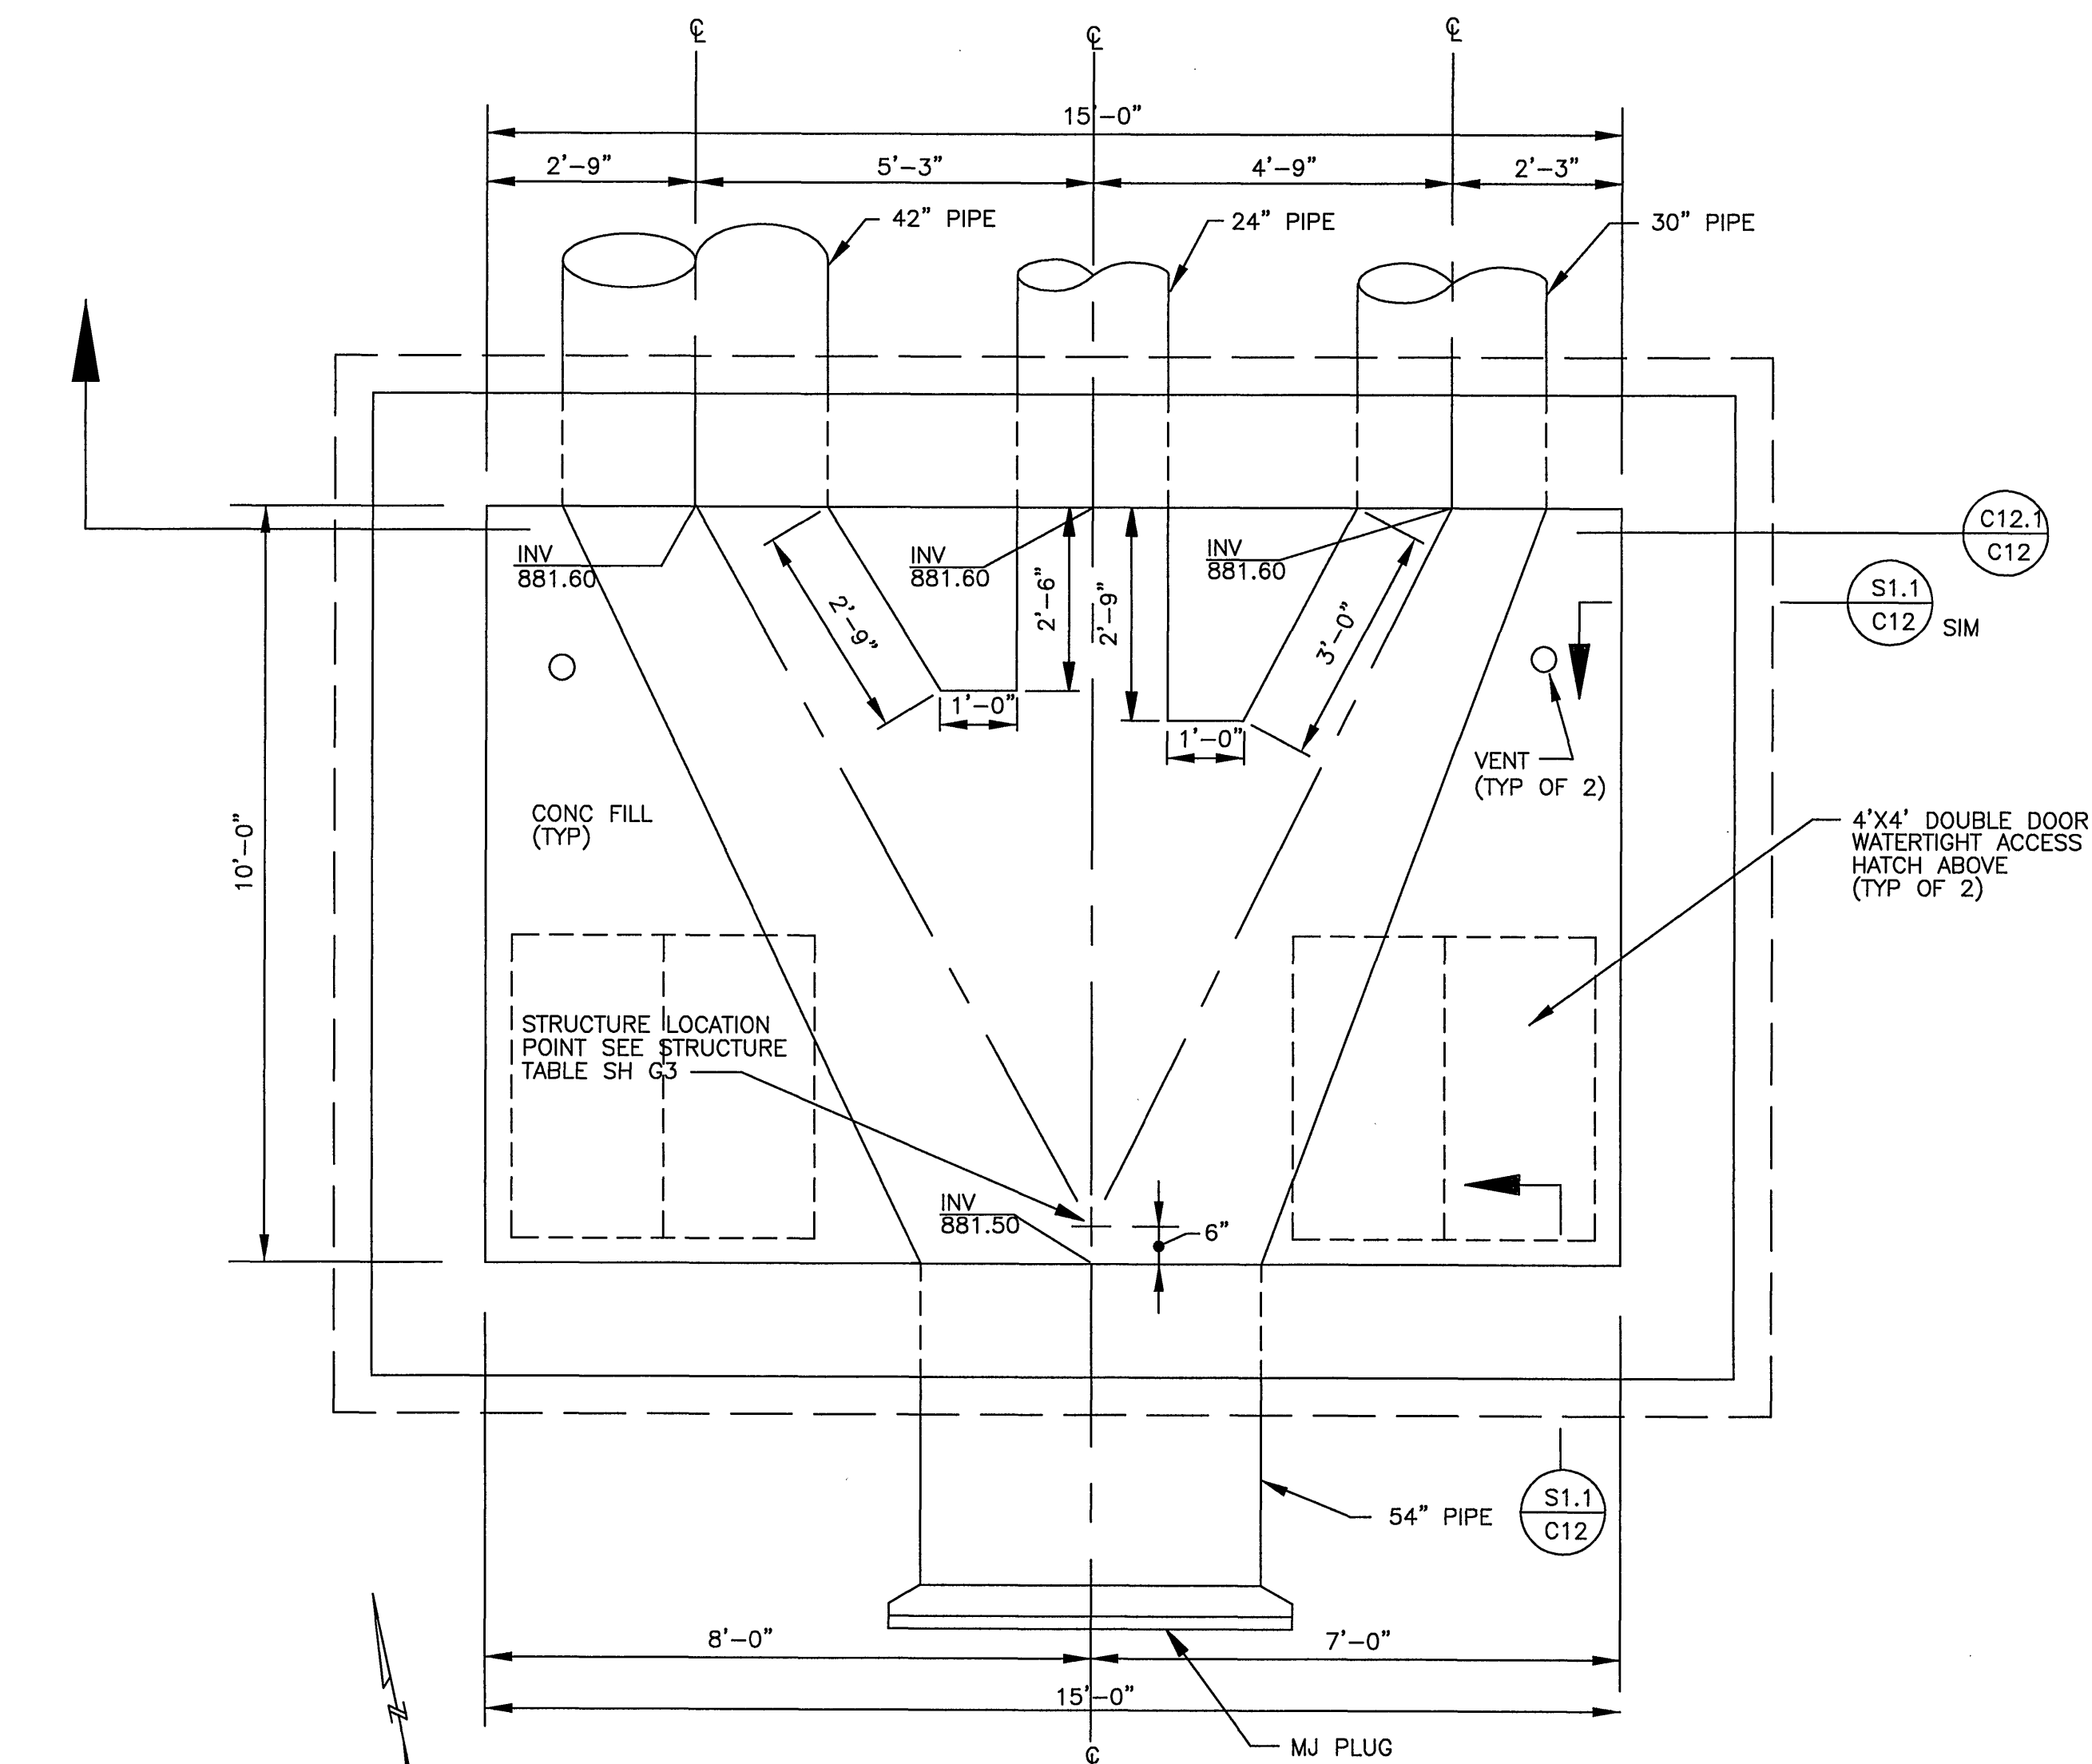

JUNCTION BOX S1
SCALE: 1/2" = 1'-0"

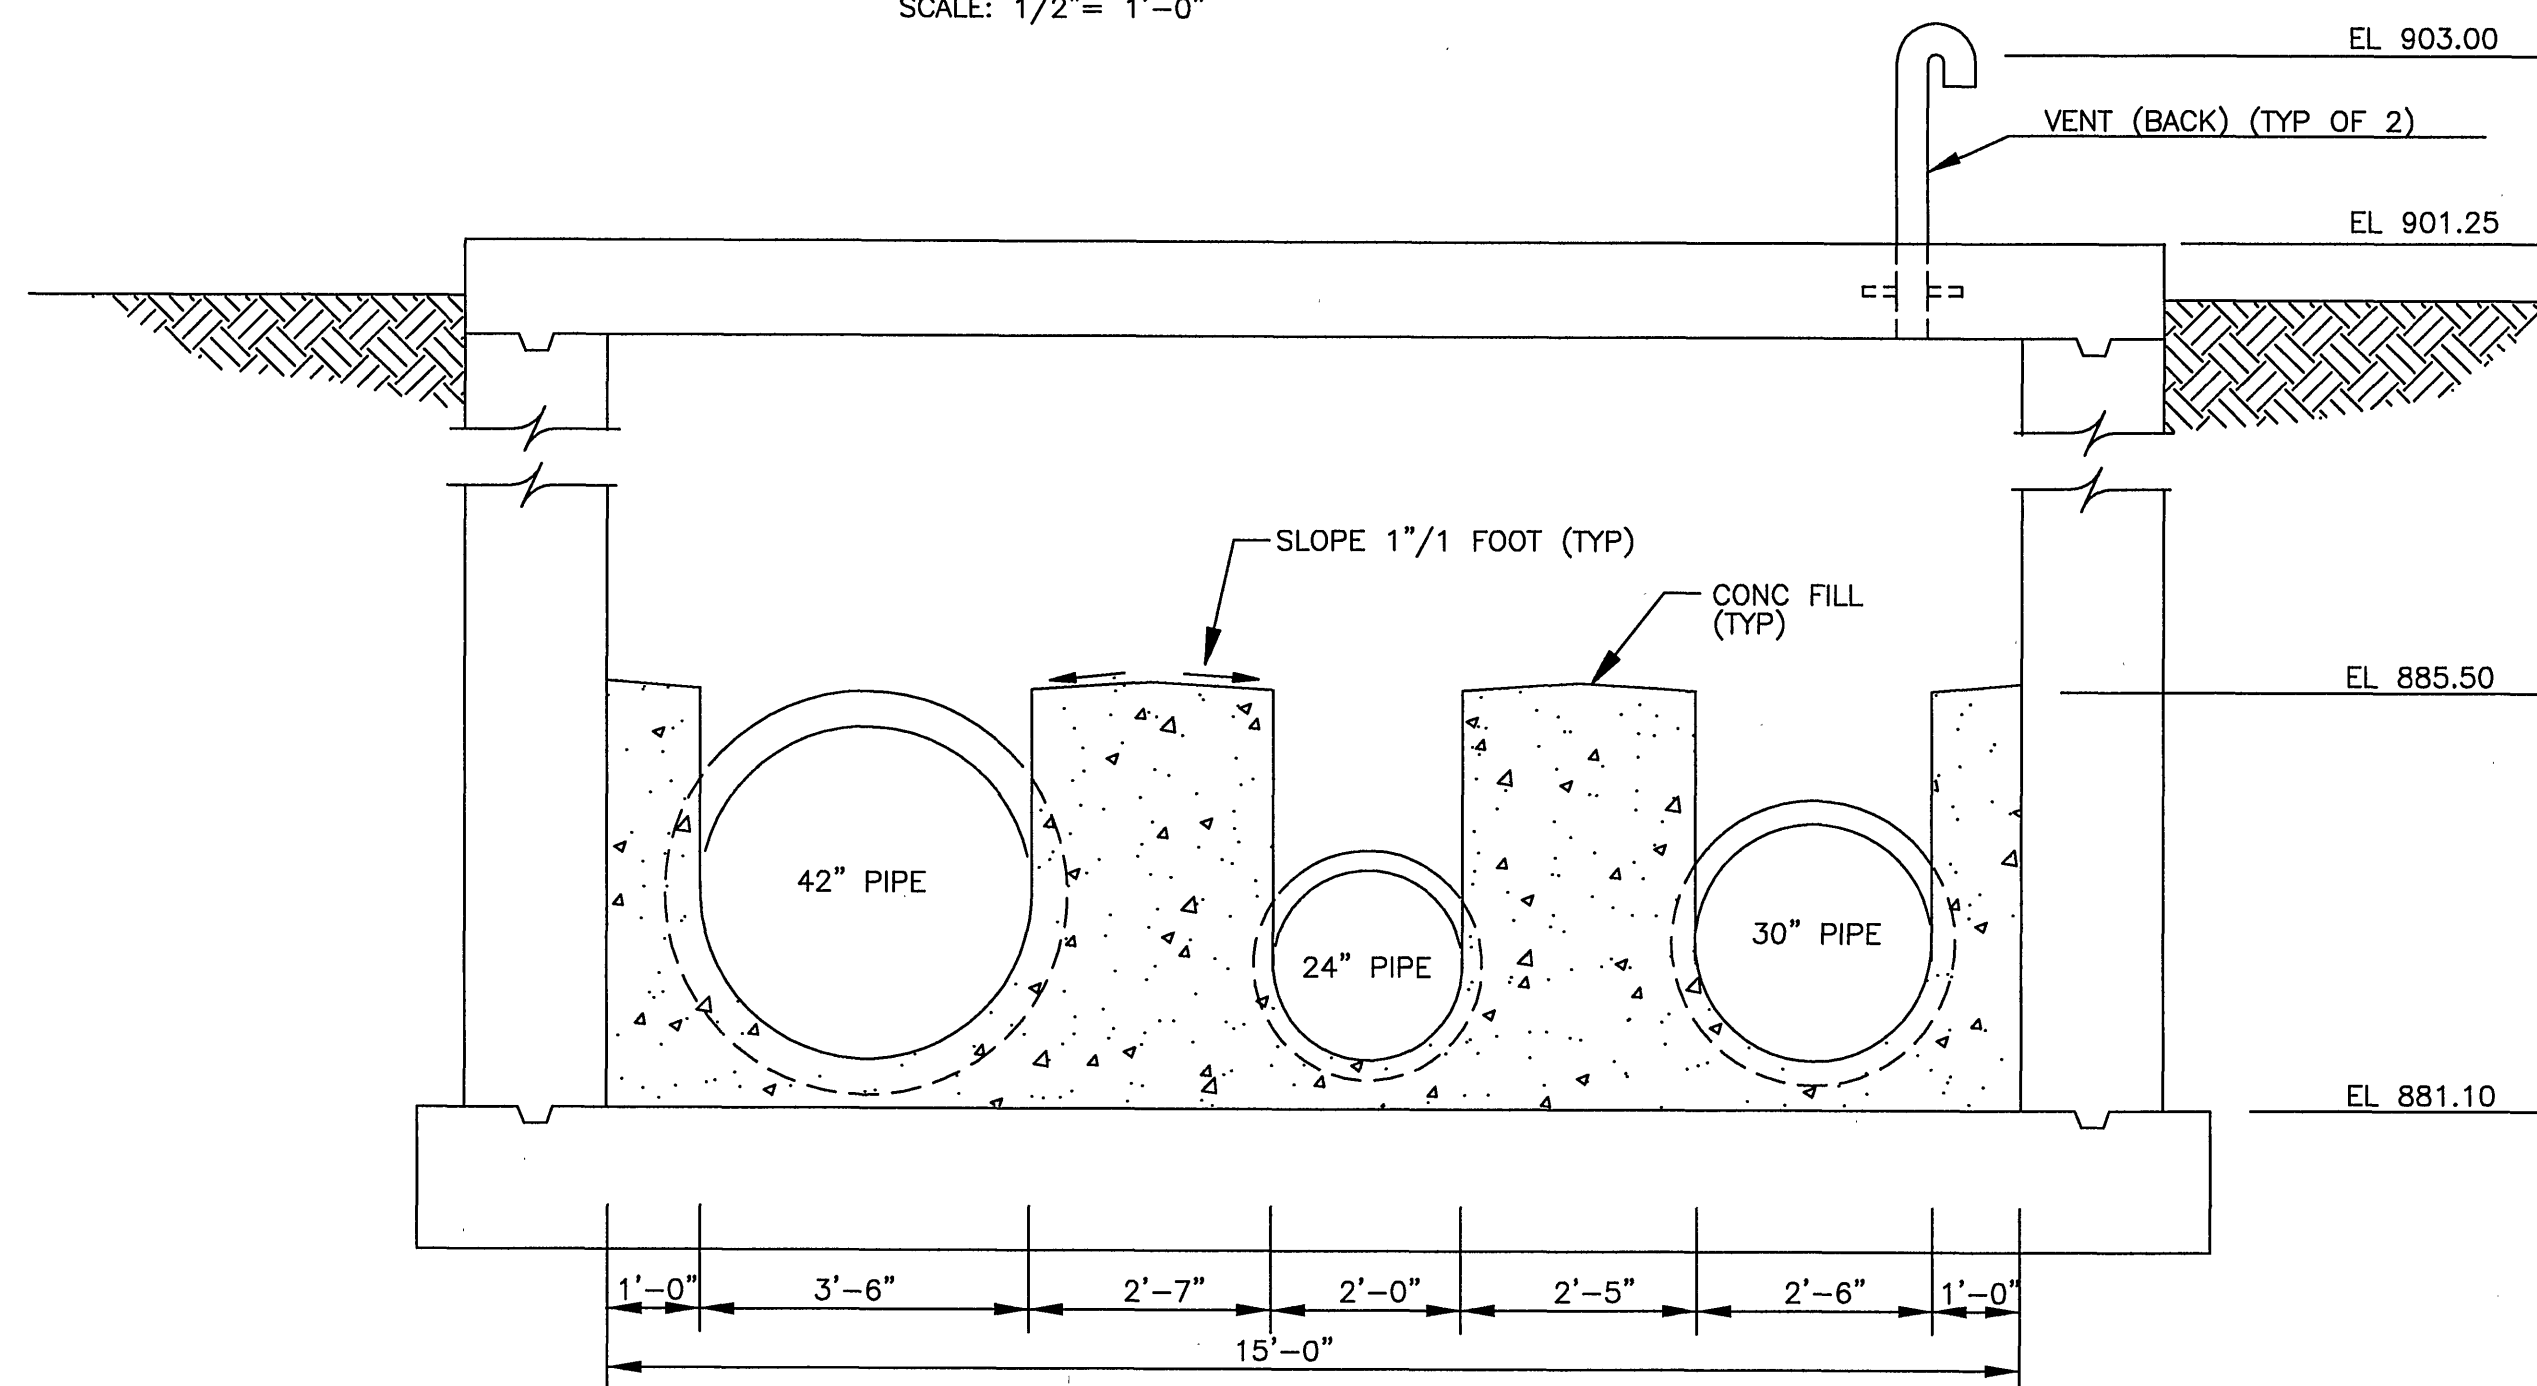

SECTION JB S1
SCALE: 1/2" = 1'-0"

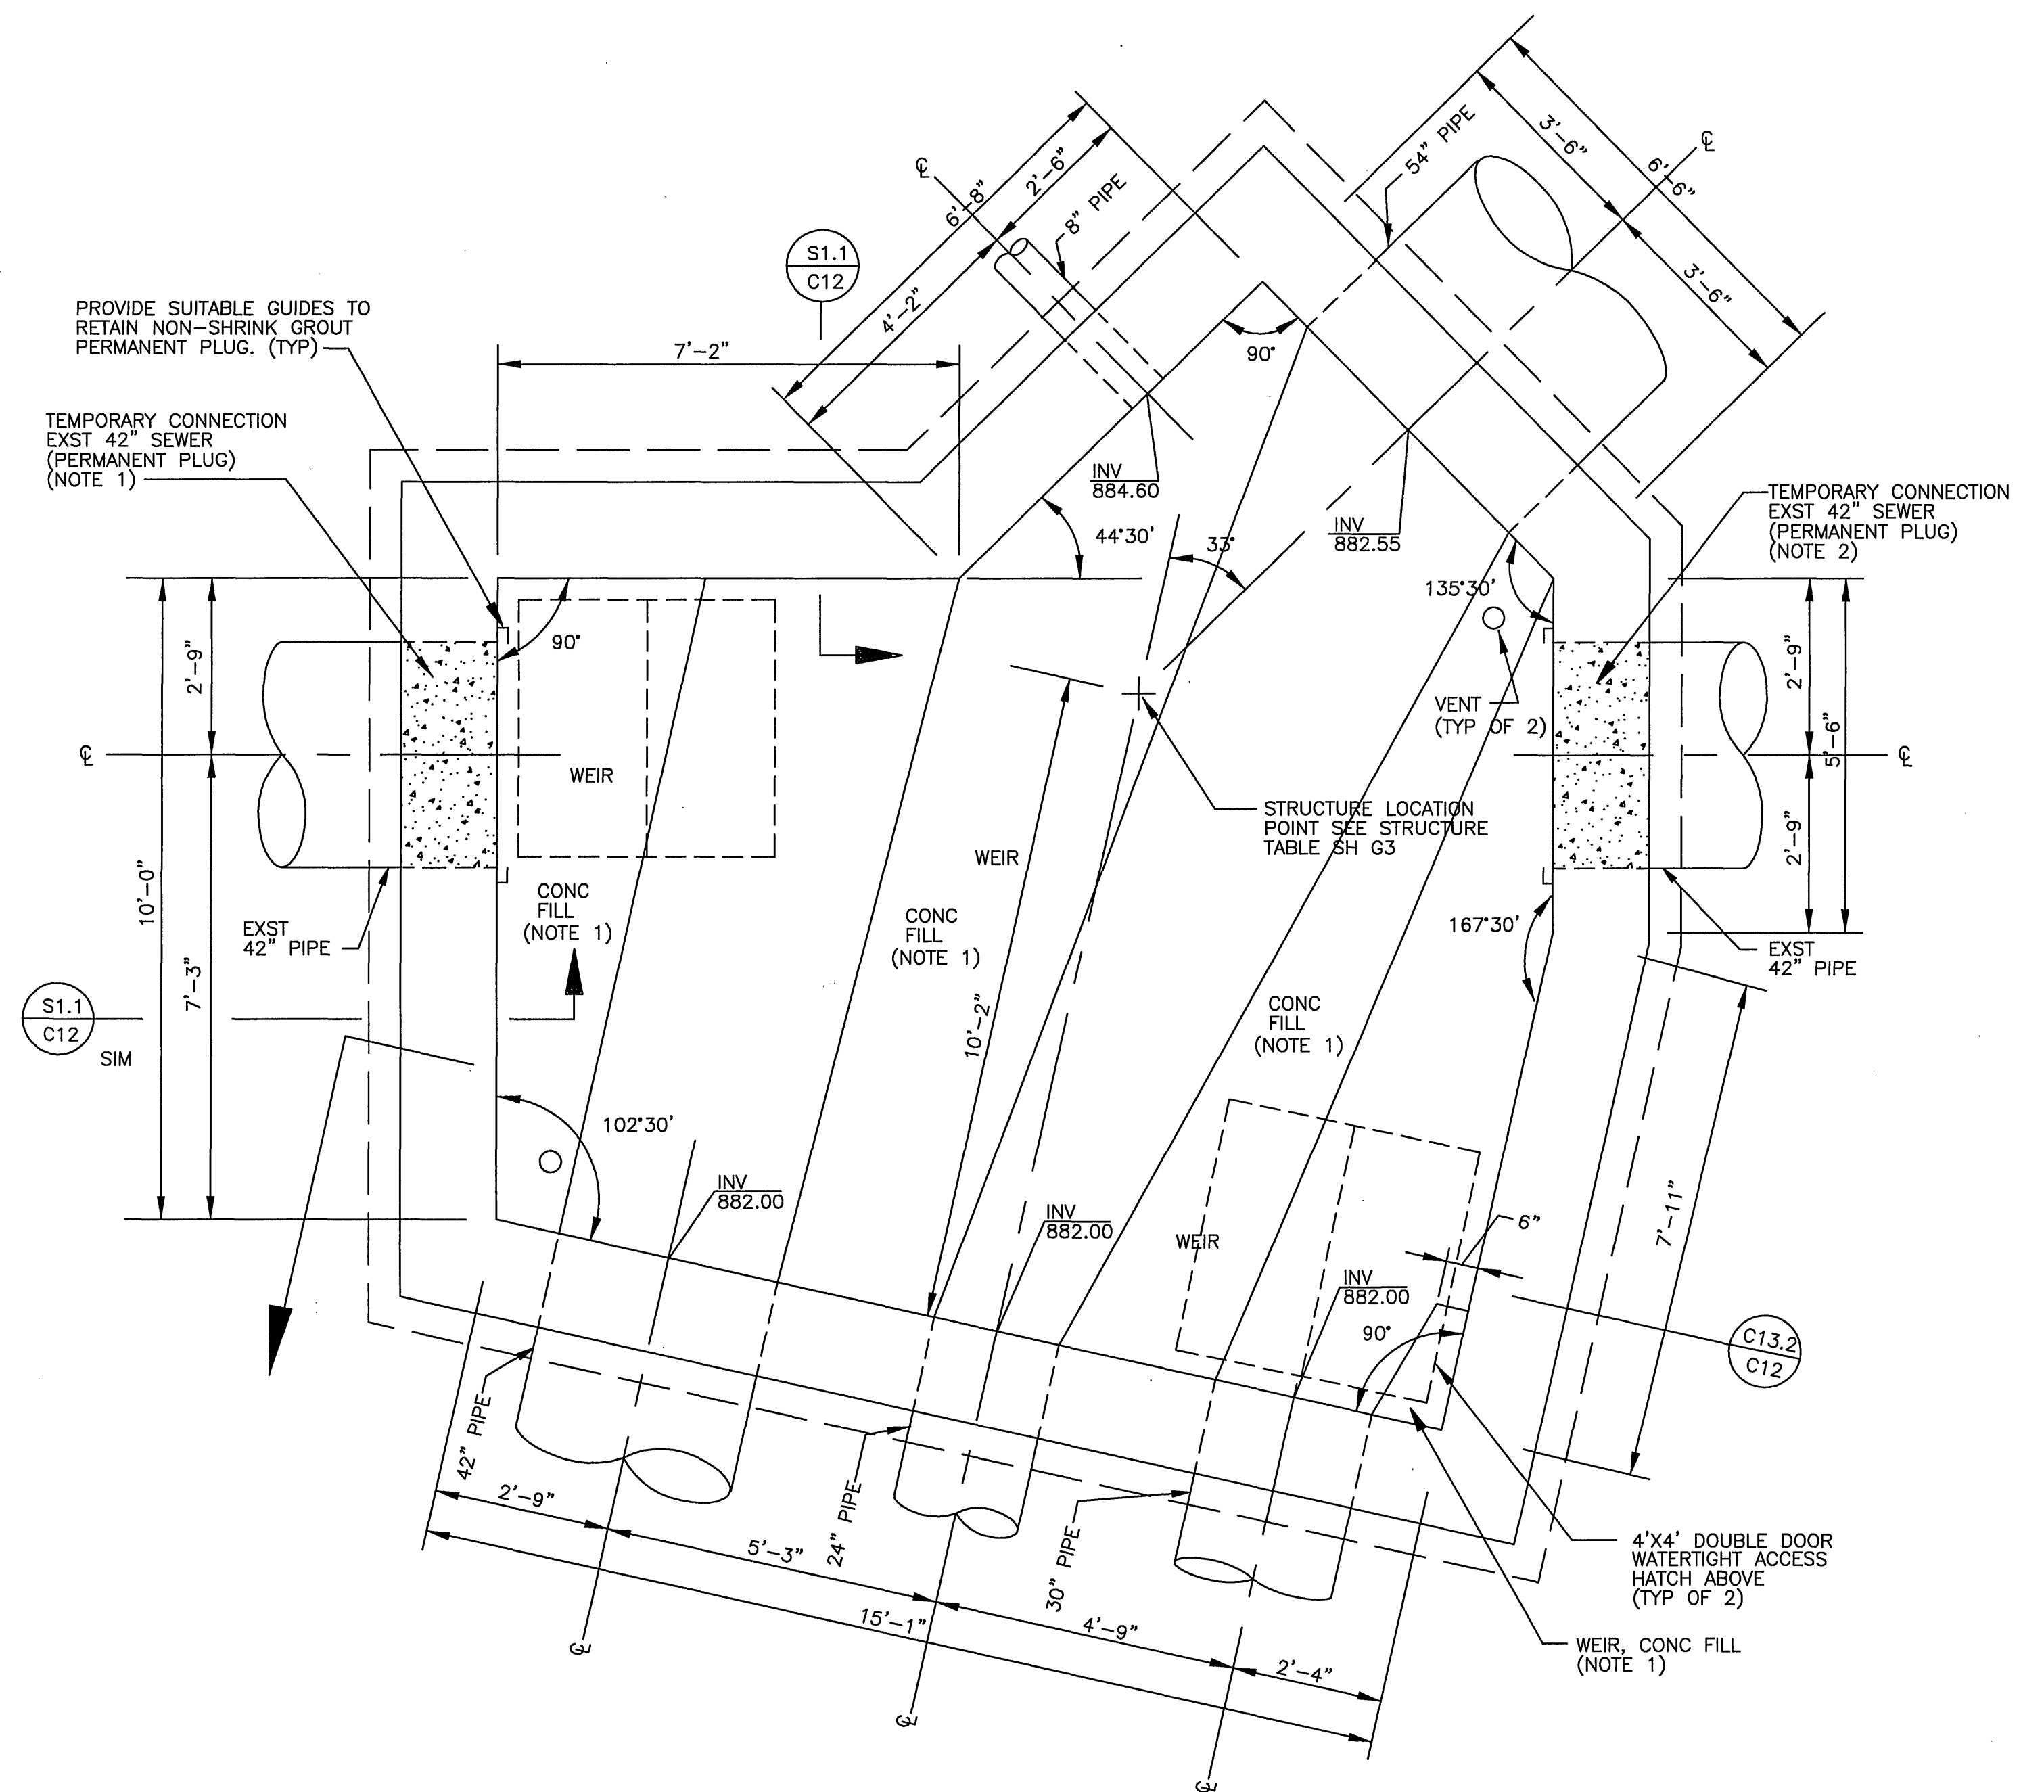

JUNCTION BOX S2
SCALE: 1/2" = 1'-0"

- NOTES:
1. CONSTRUCT S2, EXCEPT DO NOT PROVIDE INTERIOR CONC FILL. INSTALL TEMPORARY INFLATABLE PIPE PLUGS IN THE 42", 30" AND 24" DIA OUTLET PIPES. MAINTAIN SEWAGE FLOW THROUGH THE EXISTING 42" DIA OUTLET PIPE. THE EXISTING 42" DIA OUTLET PIPE WILL BE PERMANENTLY PLUGGED AND THE INTERIOR CONC FILL WILL BE PROVIDED, BY OTHERS, WHEN STRUCTURE S1 IS CONNECTED TO THE HEAD OF THE WATER POLLUTION CONTROL PLANT.
 2. SEE PERMANENT PLUG OF TEMPORARY CONNECTIONS DETAIL ON SH C11.
 3. CONCRETE FILL IS CLASS A CONCRETE. CONCRETE FILL MUST ATTAIN A COMPRESSIVE STRENGTH OF 3000 PSI PRIOR TO DIVERTING FLOW THROUGH A STRUCTURE.

HAYES, SEAY, MATTERN & MATTERN, INC.
ARCHITECTS/ENGINEERS/PLANNERS
ROANOKE, VIRGINIA

DESIGNED: DMH	REVISIONS		DESCRIPTION
	DATE	BY	
DRAWN: MHL	10/15/98	MNH	RECORD DRAWINGS SEE SHEET G1 FOR NOTE
CHECKED:			
APPROVED:			

GRAPHIC SCALE

1/2" = 1'-0" 12" 6" 0 1' 2' 3' 4' 5'

TINKER CREEK INTERCEPTOR SEWER
CITY OF ROANOKE, VIRGINIA

JUNCTION BOX S1, PLAN AND SECTION;
JUNCTION BOX S2, PLAN

COMM. NO.: 7211

SCALE: AS NOTED

DATE: MAY 17, 1996

PROJECT NO.: 6317

CONTRACT A
SHEET NO.

C12

RECORD DRAWINGS