



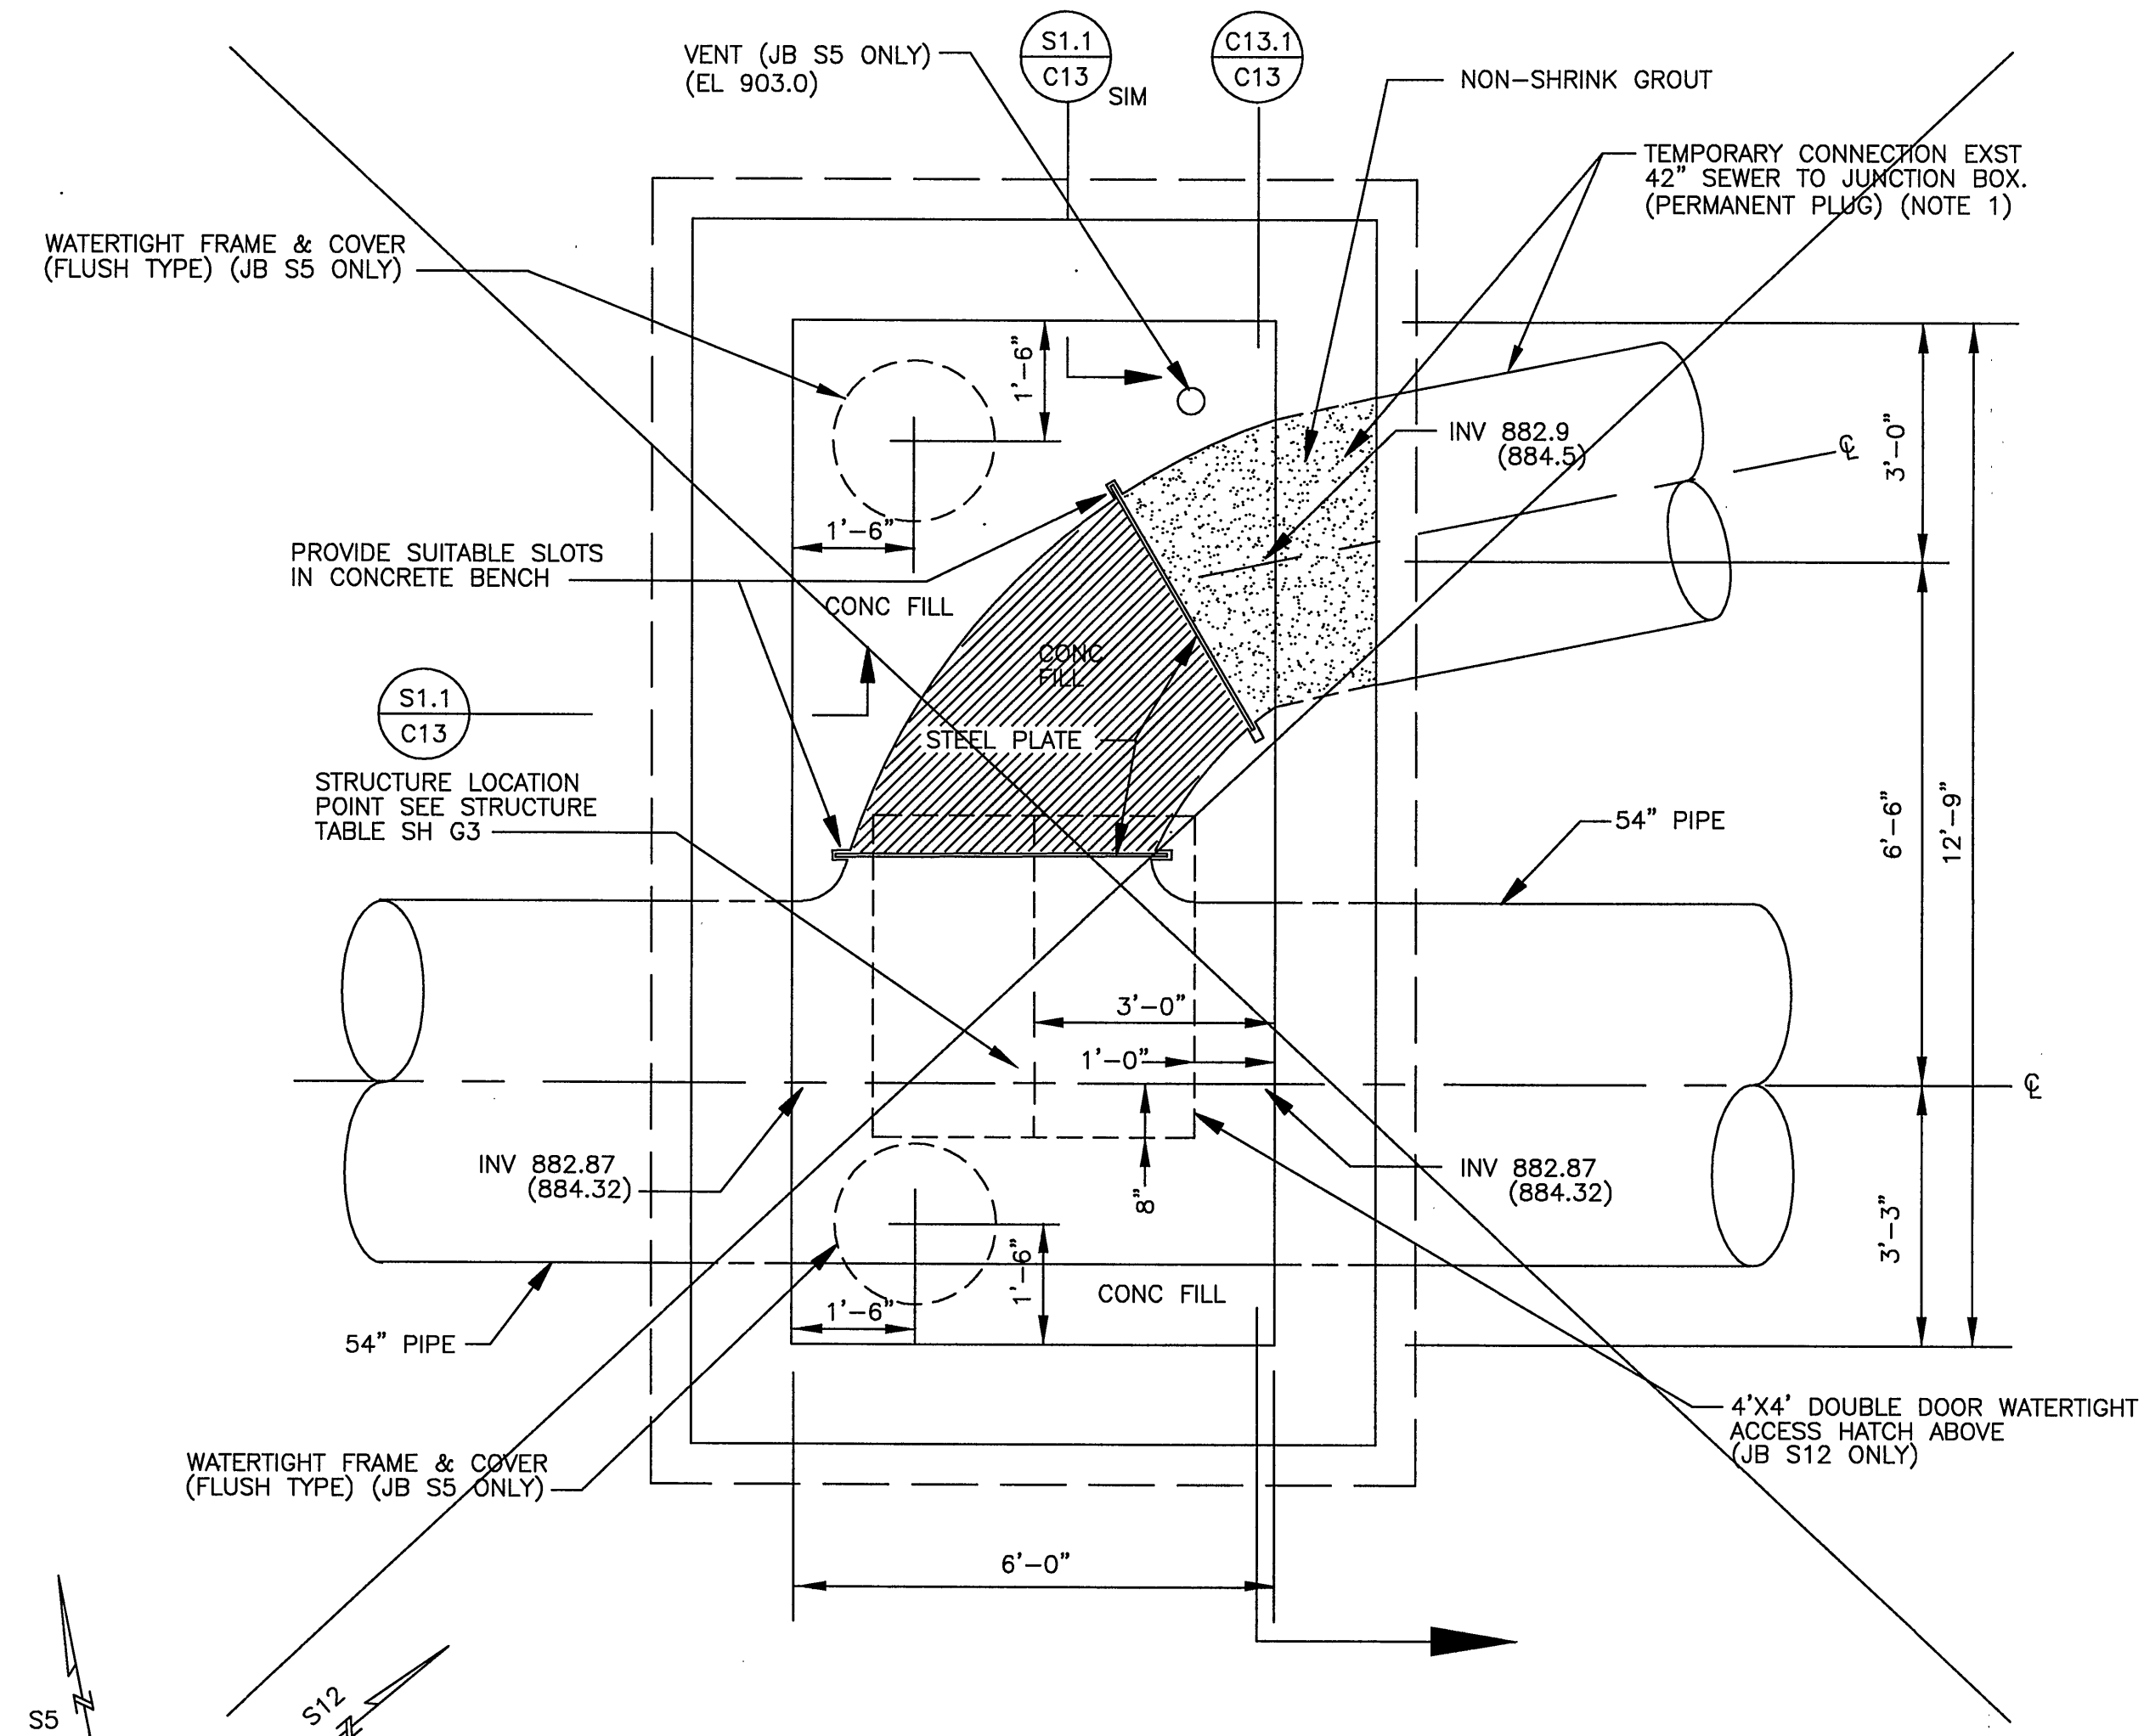


NOTE: 1. SEE PERMANENT PLUG OF TEMPORARY CONNECTION DETAIL ON SH C11.
2. ELEVATIONS ARE FOR S5. ELEVATIONS IN PARENTHESIS ARE FOR S12.

JUNCTION BOX S5 & S12
SCALE: 1/2" = 1'-0"
SEE SHEET G3

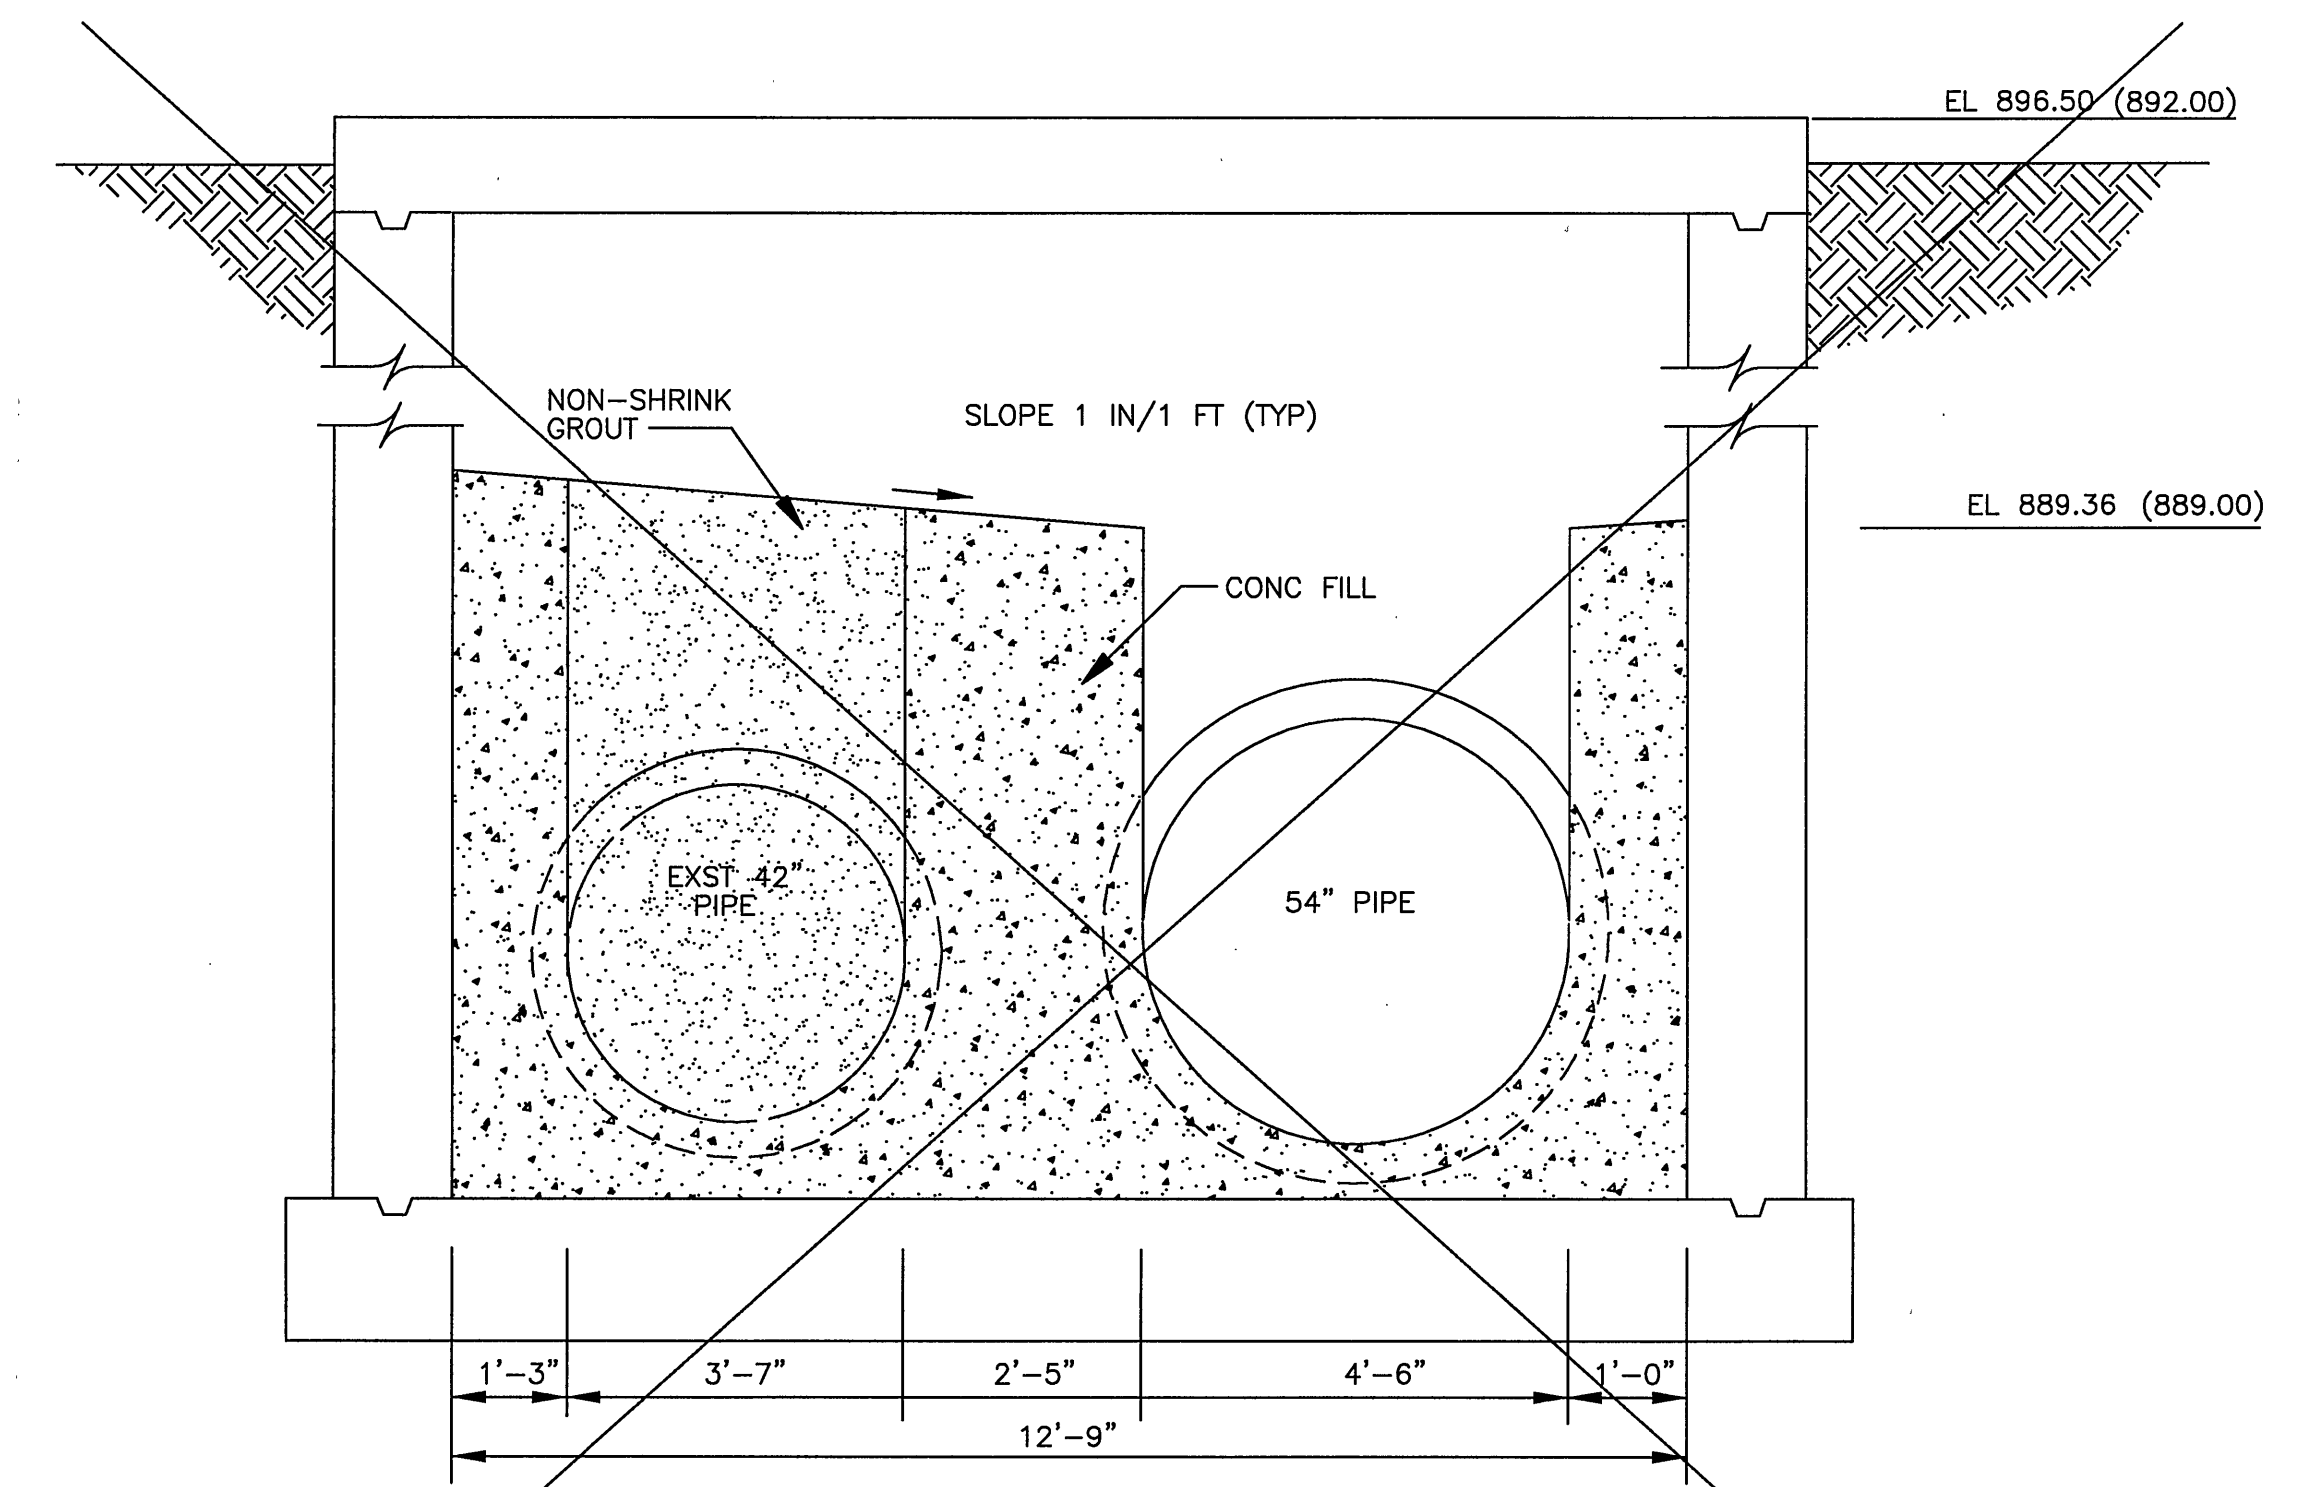

NOTE: 1. ELEVATIONS ARE FOR S5. ELEVATIONS IN PARENTHESIS ARE FOR S12.

SECTION JB S5 & S12
SCALE: 1/2" = 1'-0" (JB S5)
NOT TO SCALE (JB S12)
SEE SHEET G3

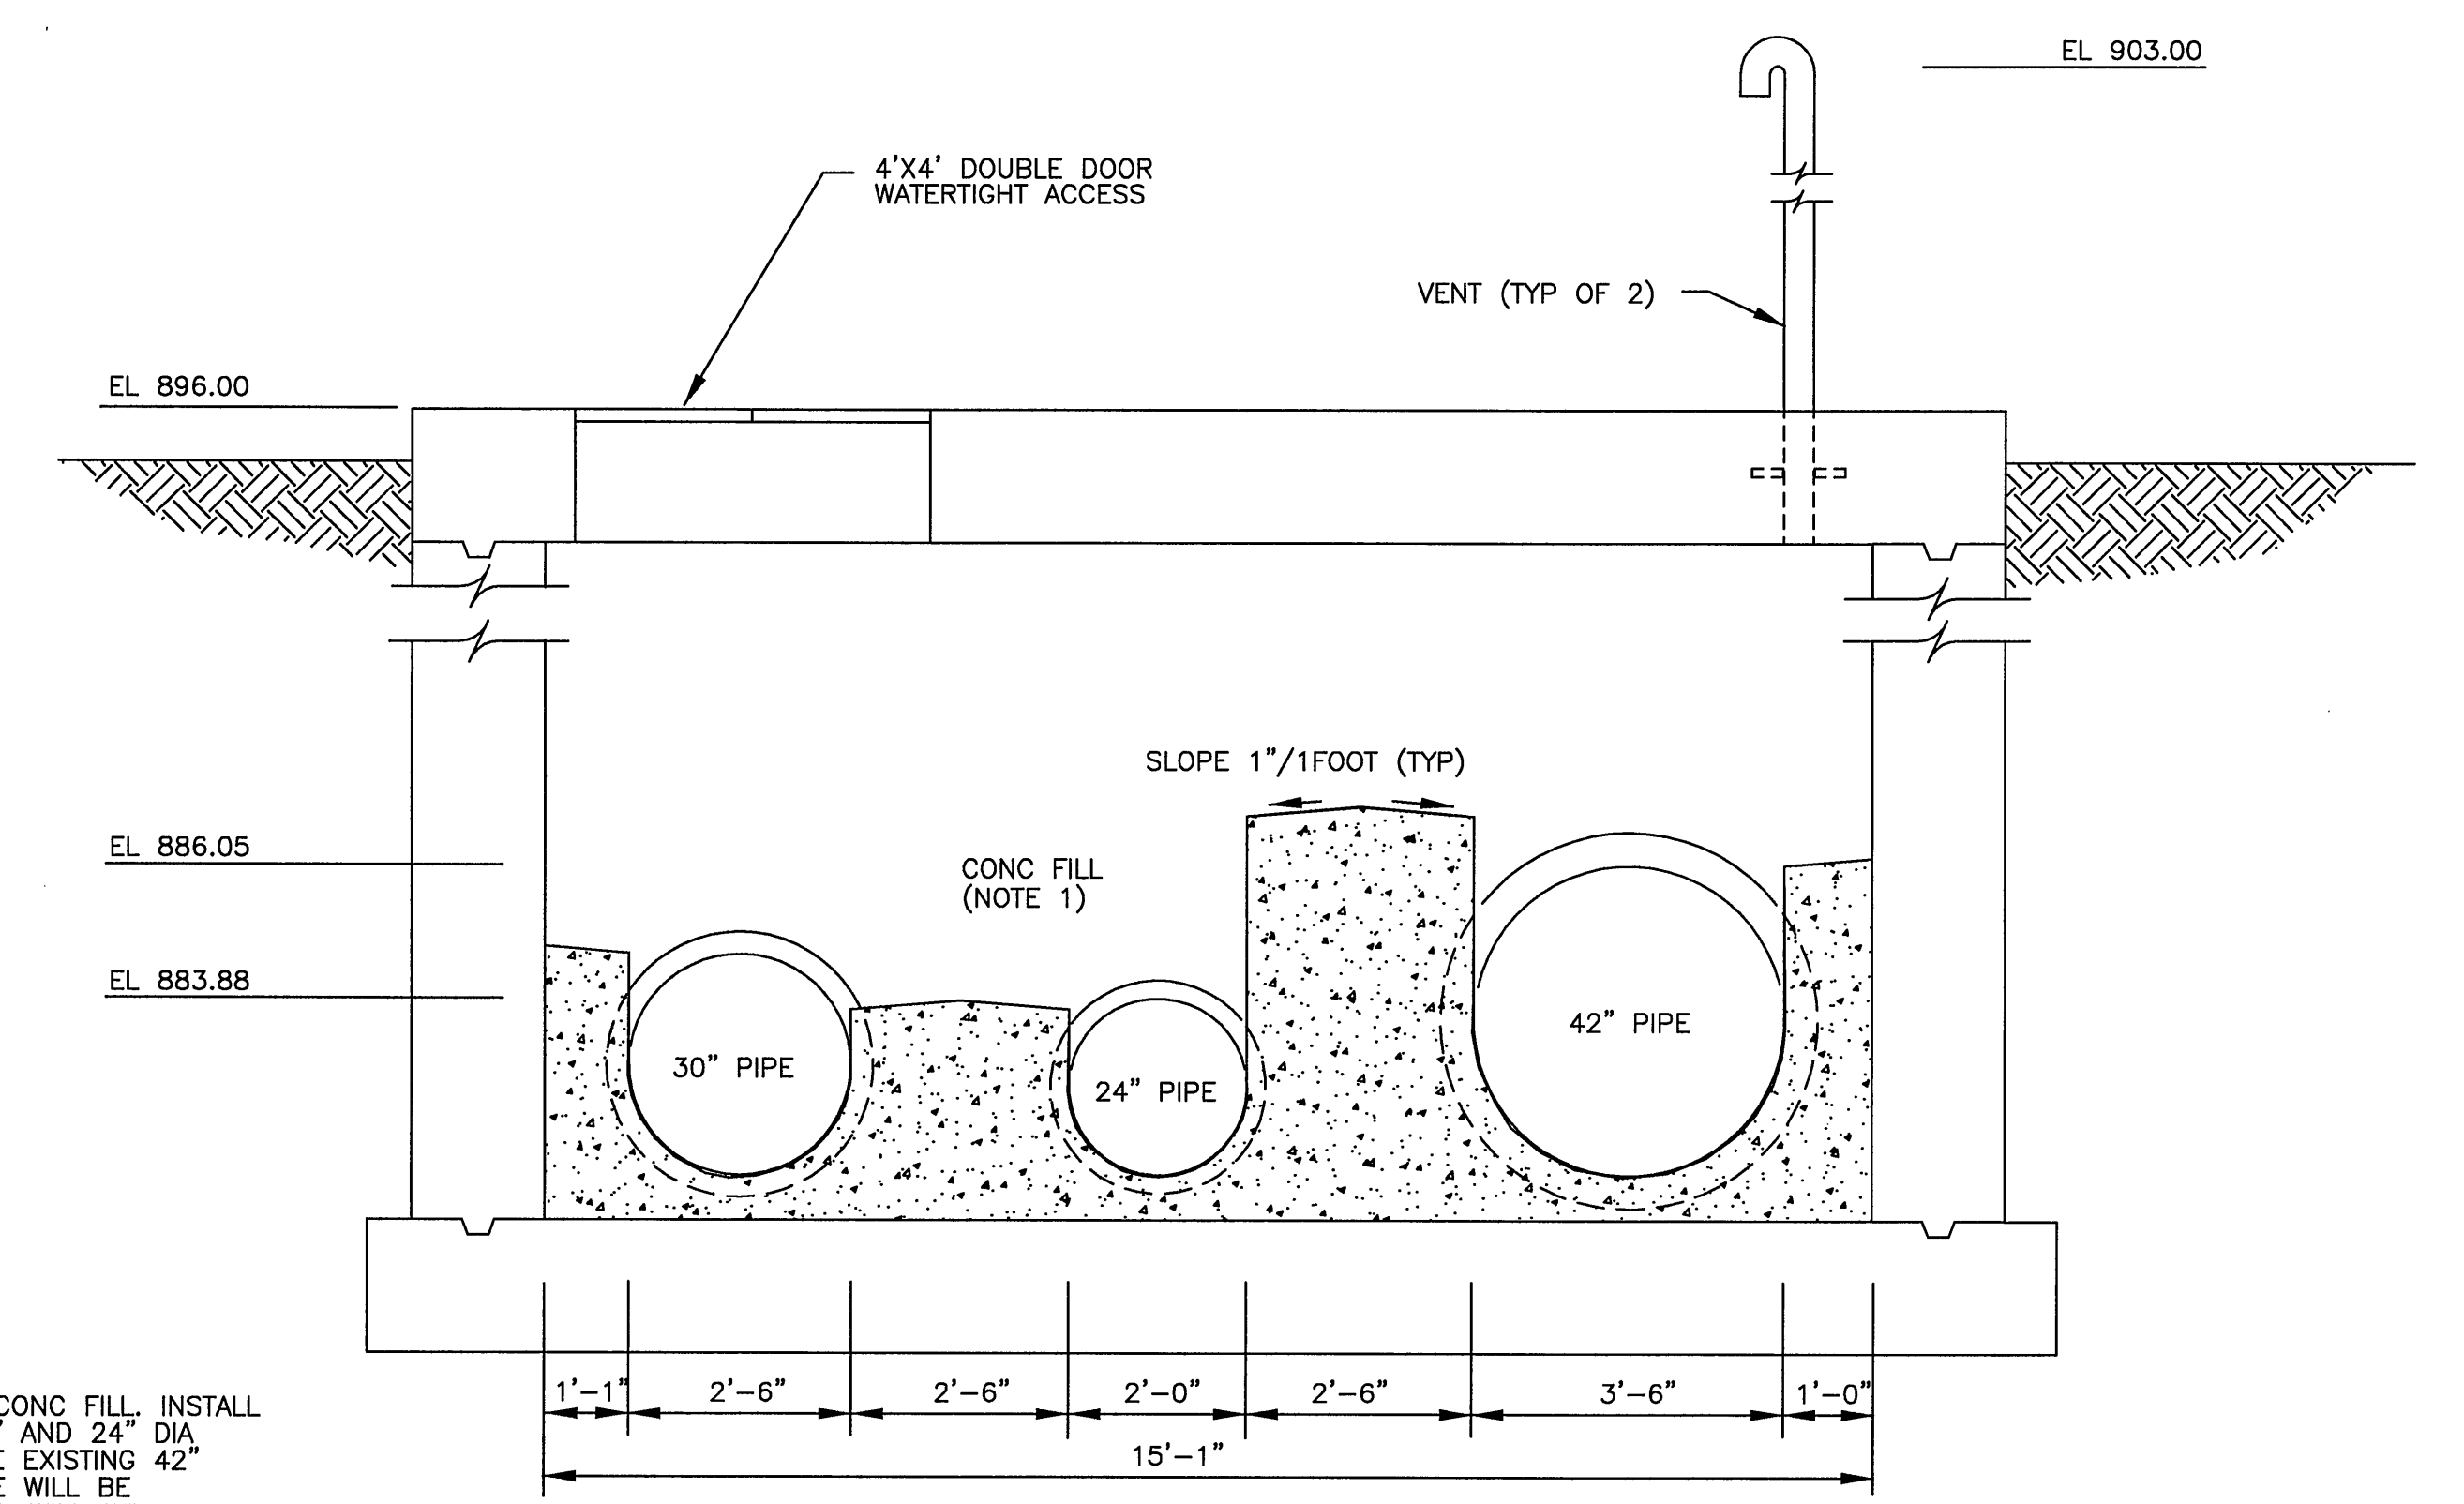


SECTION JB S2
SCALE: 1/2" = 1'-0"

- NOTES:
- CONSTRUCT S2, EXCEPT DO NOT PROVIDE INTERIOR CONC FILL. INSTALL TEMPORARY INFLATABLE PIPE PLUGS IN THE 42", 30" AND 24" DIA. OUTLET PIPES. MAINTAIN SEWAGE FLOW THROUGH THE EXISTING 42" DIA. OUTLET PIPE. THE EXISTING 42" DIA. OUTLET PIPE WILL BE PERMANENTLY PLUGGED AND THE INTERIOR CONC FILL WILL BE PROVIDED, BY OTHERS, WHEN STRUCTURE S1 IS CONNECTED TO THE HEAD OF THE WATER POLLUTION CONTROL PLANT.
 - CONCRETE FILL IS CLASS A CONCRETE. CONCRETE FILL MUST ATTAIN A COMPRESSIVE STRENGTH OF 3000 PSI PRIOR TO DIVERTING FLOW THROUGH A STRUCTURE.

HAYES, SEAY, MATTERN & MATTERN, INC.
ARCHITECTS/ENGINEERS/PLANNERS
ROANOKE, VIRGINIA

DESIGNED: DMH	REVISIONS		
	DATE	BY	DESCRIPTION
DRAWN: MHL	10/15/98	MNH	RECORD DRAWINGS SEE SHEET G1 FOR NOTE
CHECKED:			
APPROVED:			

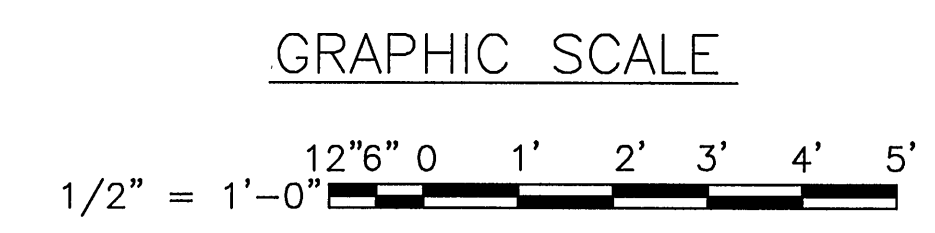

TINKER CREEK INTERCEPTOR SEWER CITY OF ROANOKE, VIRGINIA			PROJECT NO.: 6317
JUNCTION BOXES S5 & S12, PLAN AND SECTION; JUNCTION BOX S2, SECTION			CONTRACT A SHEET NO. C13
COMM. NO.: 7211	SCALE: AS NOTED	DATE: MAY 17, 1996	RECORD DRAWINGS