




ENLARGED DETAIL SANITARY SEWER CROSSING CULVERT AT DALE AVE. SCALE: 1"=5"

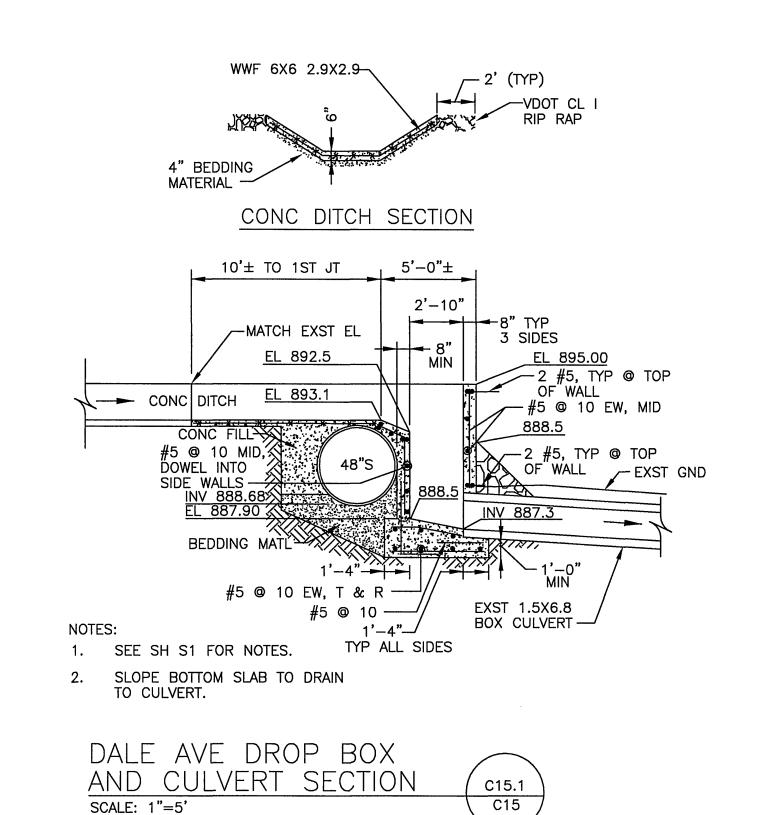


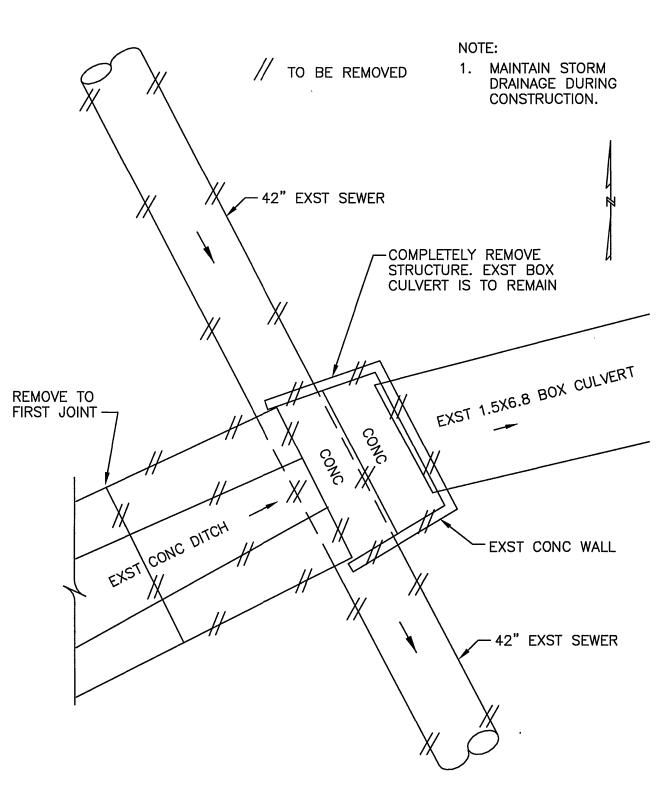

DEMOLITION PLAN SCALE: 1"=5'

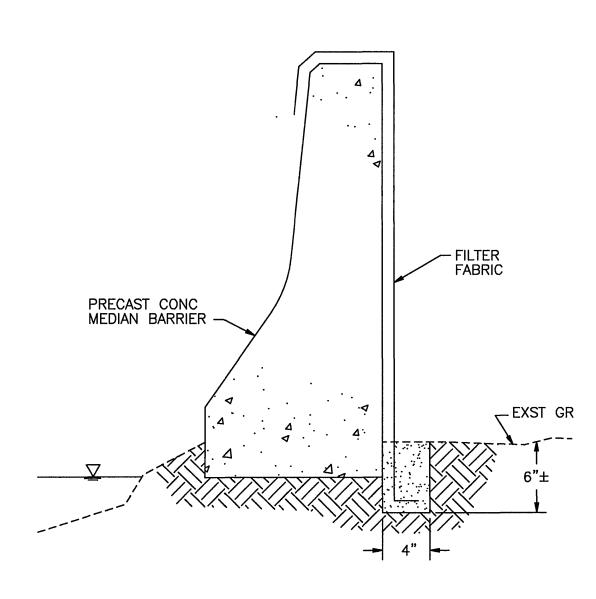

SILT FENCE CLOSE TO STREAMS SCALE:  $1 \frac{1}{2} = 1' - 0"$ 

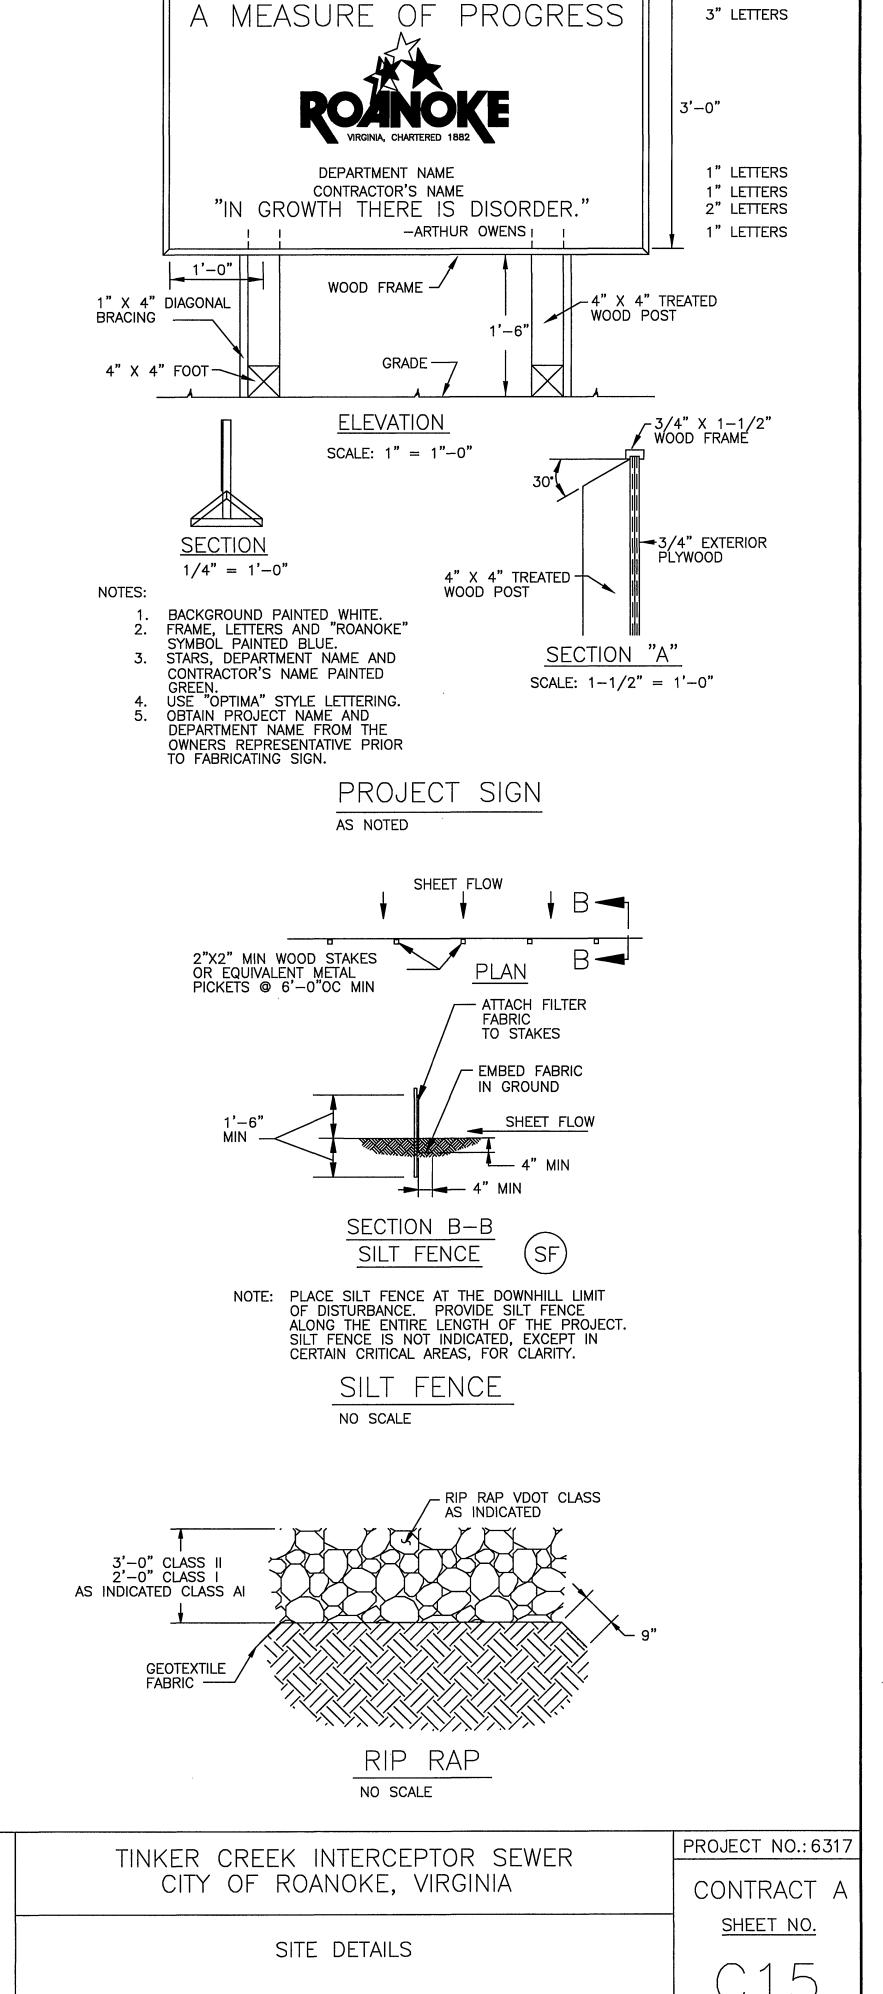

SCALE: AS NOTED

COMM. NO.: 7211

DATE: MAY 17, 1996

RECORD DRAWINGS

5'-0"

"PROJECT NAME"

2" LETTERS

HAYES, SEAY, MATTERN & MATTERN, INC. ARCHITECTS/ENGINEERS/PLANNERS ROANOKE, VIRGINIA

DESIGNED:	DMH			REVISIONS
		DATE	BY	DESCRIPTION
		10/15/98	MNH	RECORD DRAWINGS SEE SHEET G1 FOR NOTE
DRAWN:	MHL			
CHECKED:				
APPROVED:				

SCALE: 1"=5"