
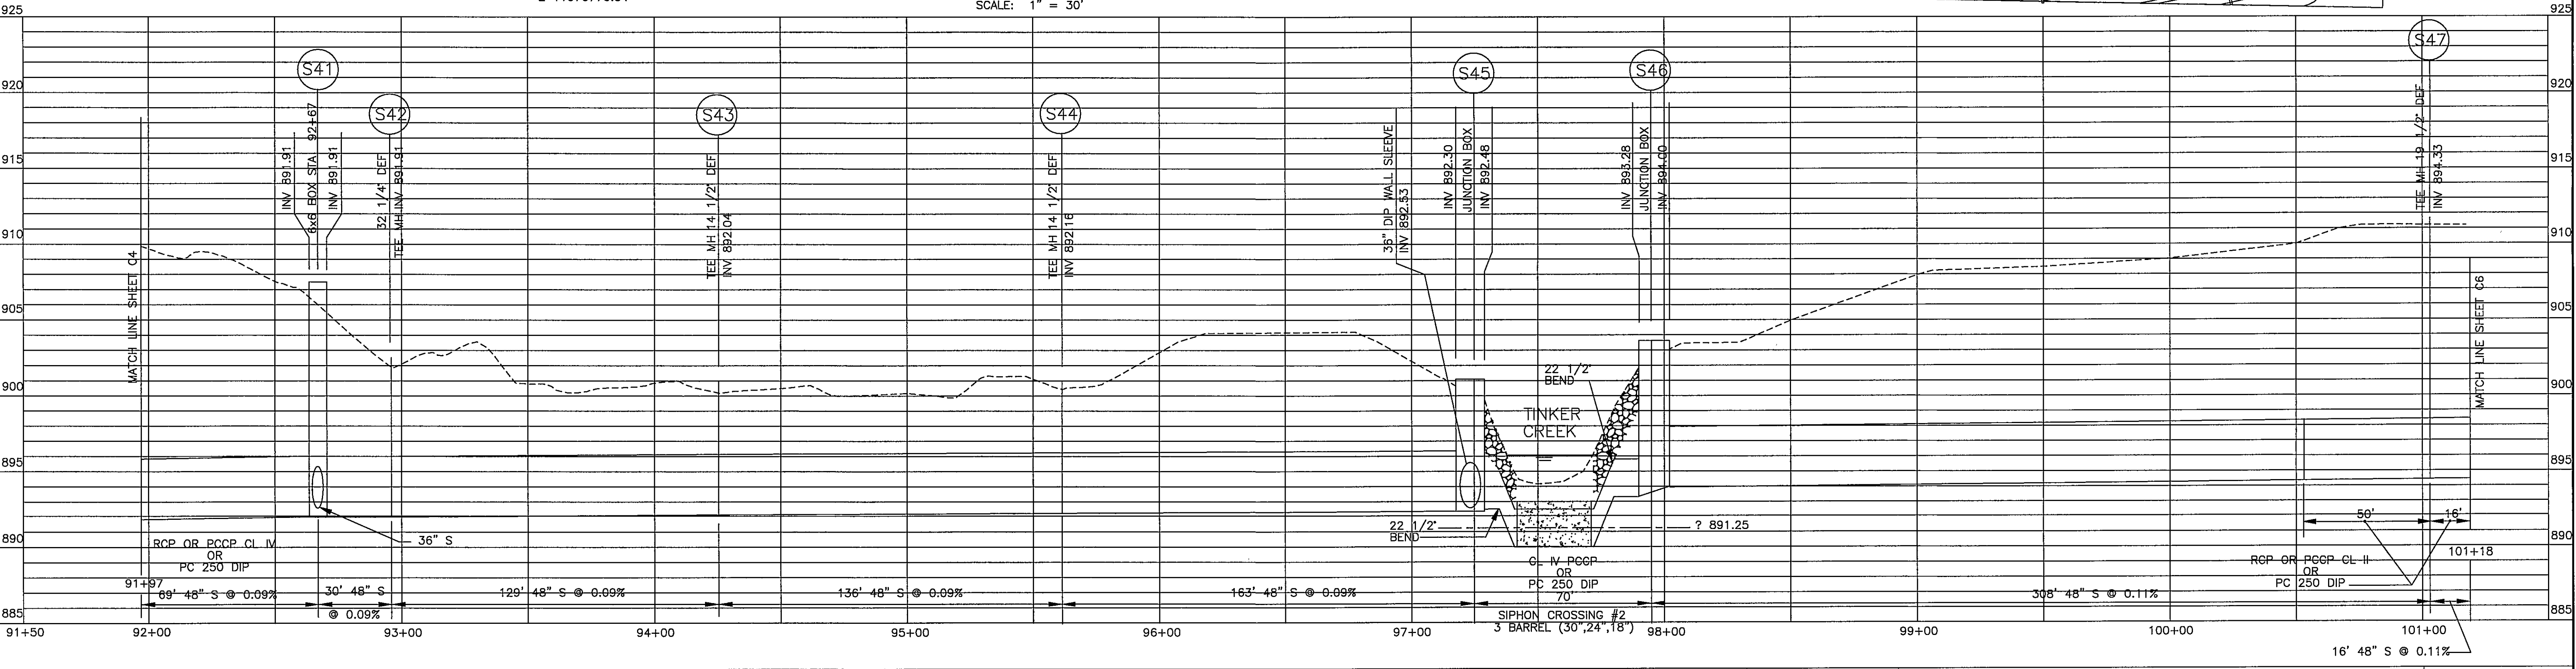


- NOTE:
- SEE SHEET G3 FOR STRUCTURE INFORMATION.
 - PROVIDE TEMPORARY CONSTRUCTION FENCE AT LIMIT OF CONSTRUCTION ON REDEVELOPMENT AND HOUSING AUTHORITY PROPERTY.
 - CONTRACTOR ACCESS FROM INDIAN VILLAGE DRIVE
 - COORDINATE ANY TEMPORARY REMOVAL OF FENCING WITH THE REDEVELOPMENT AND HOUSING AUTHORITY. MAINTAIN SECURITY FOR THE EXISTING STORAGE AREA.

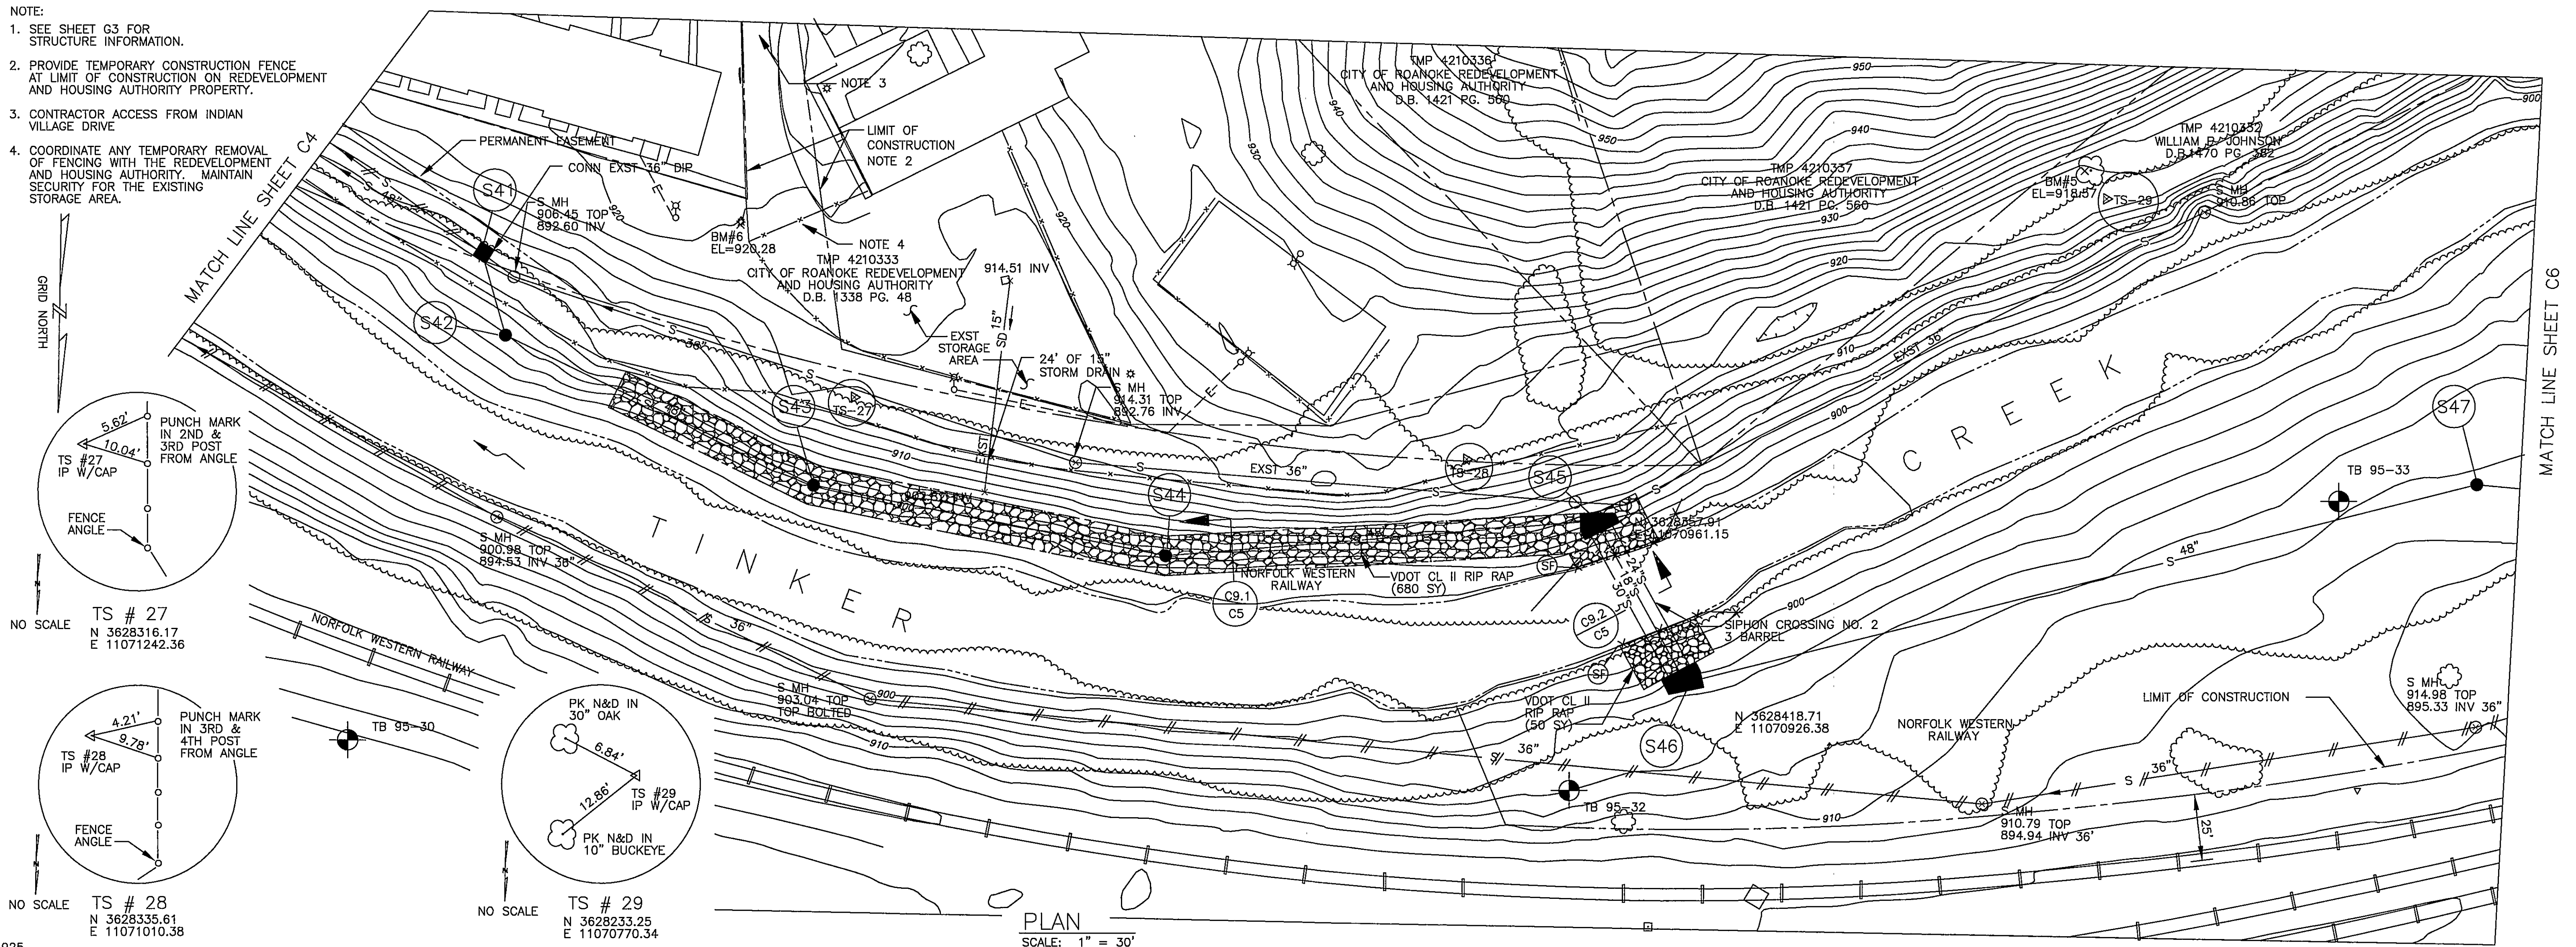

HAYES, SEAY, MATTERN & MATTERN, INC. ARCHITECTS/ENGINEERS/PLANNERS ROANOKE, VIRGINIA	DESIGNED: DMH	DATE: 10/15/98	BY: MNH	REVISIONS	GRAPHIC SCALES VERTICAL 1" = 5' HORIZONTAL 1" = 30'	TINKER CREEK INTERCEPTOR SEWER CITY OF ROANOKE, VIRGINIA PLAN AND PROFILE STA 91+97 TO STA 101+18	PROJECT NO.: 6317 CONTRACT B SHEET NO. C5
	DRAWN: MHL			RECORD DRAWINGS SEE SHEET G1 FOR NOTE			
	CHECKED:						
	APPROVED:						
						COMM. NO.: 7211	SCALE: AS NOTED
						DATE: MAY 17, 1996	RECORD DRAWINGS