

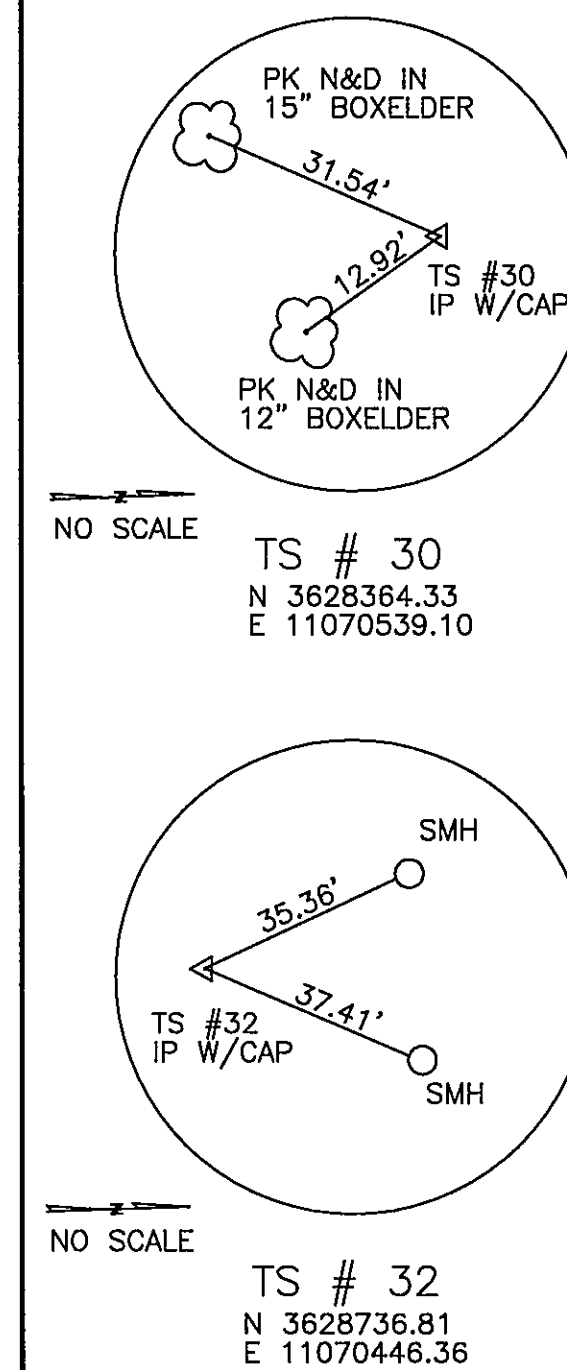


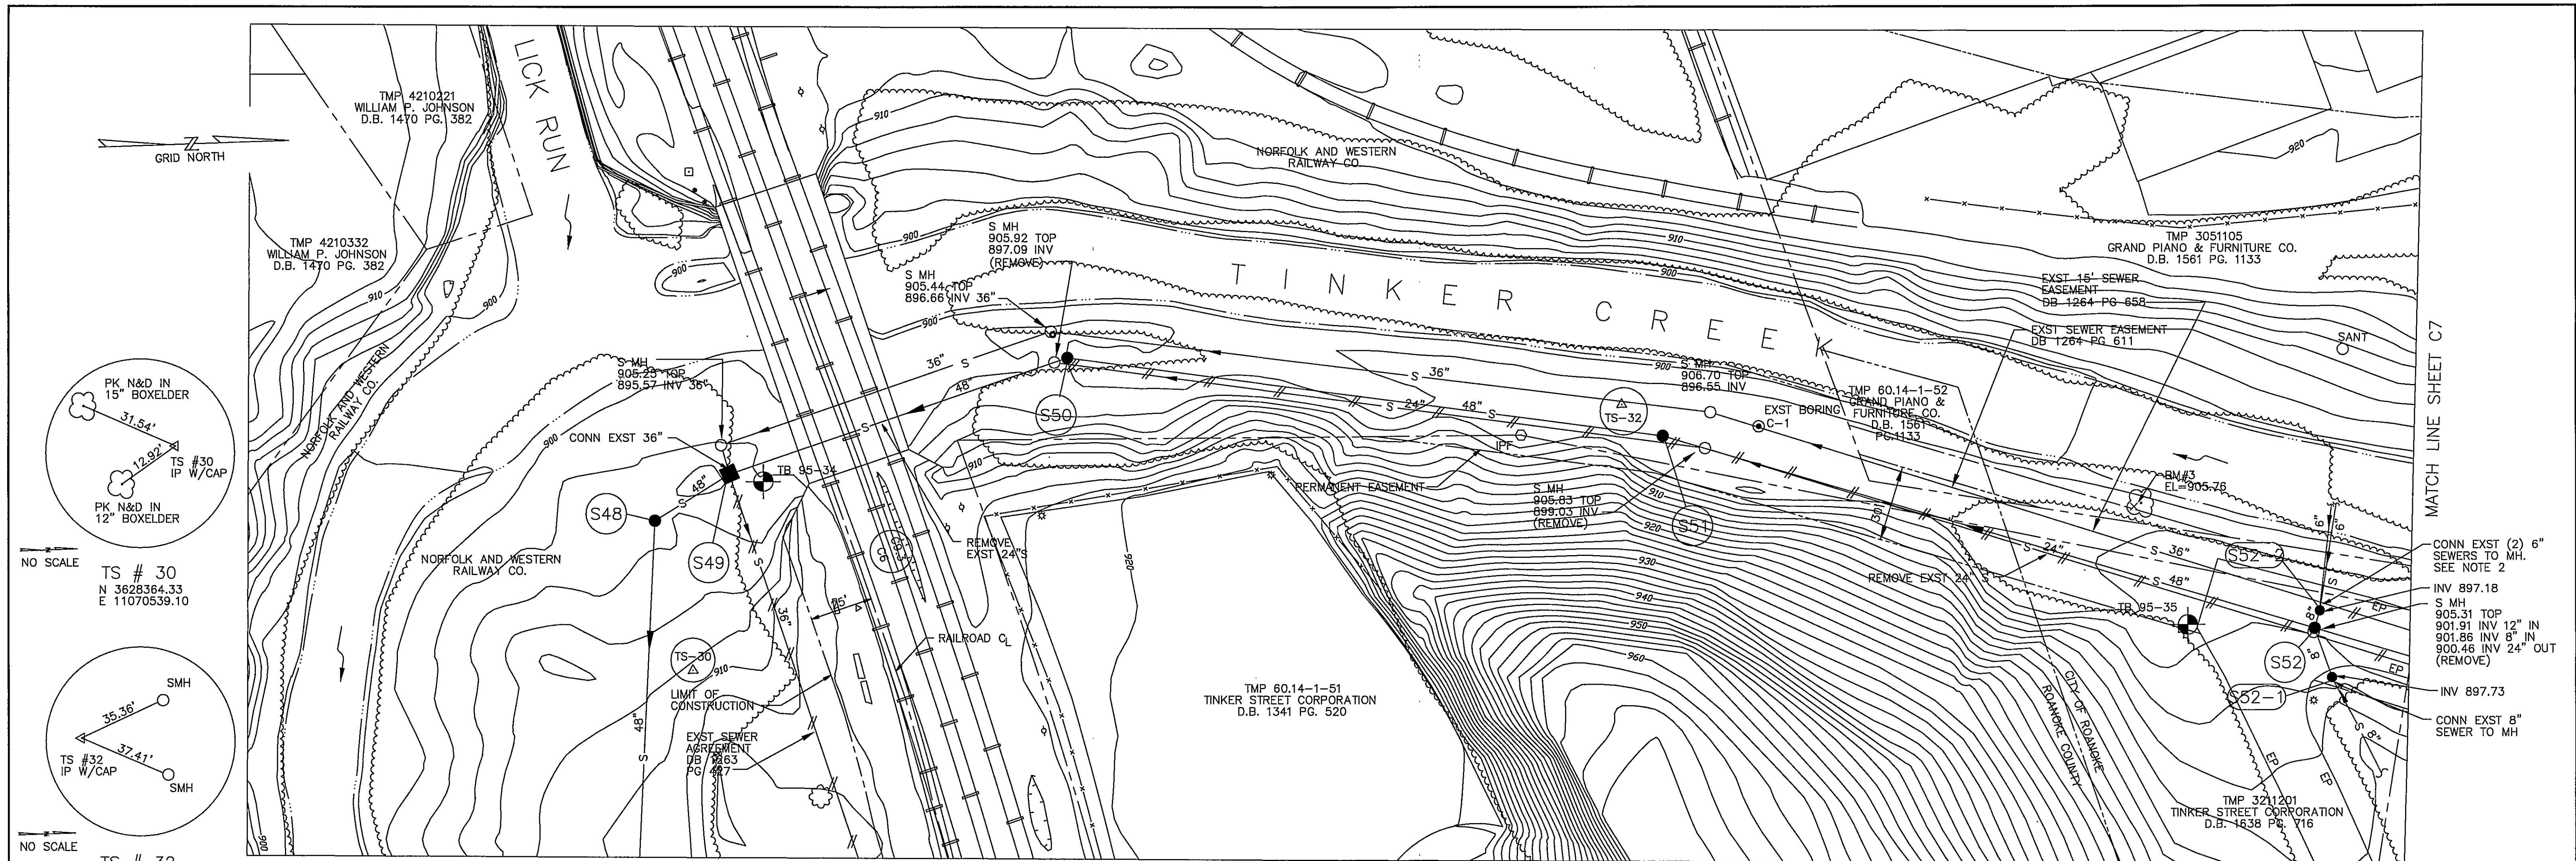

PLAN
SCALE: 1" = 30'

- NOTE:
- SEE SHEET G3 FOR STRUCTURE INFORMATION.
 - ONE 6" S CONNECTED WITH OUTSIDE DROP. THE OTHER 6" S IS CONNECTED WITH INSIDE DROP.

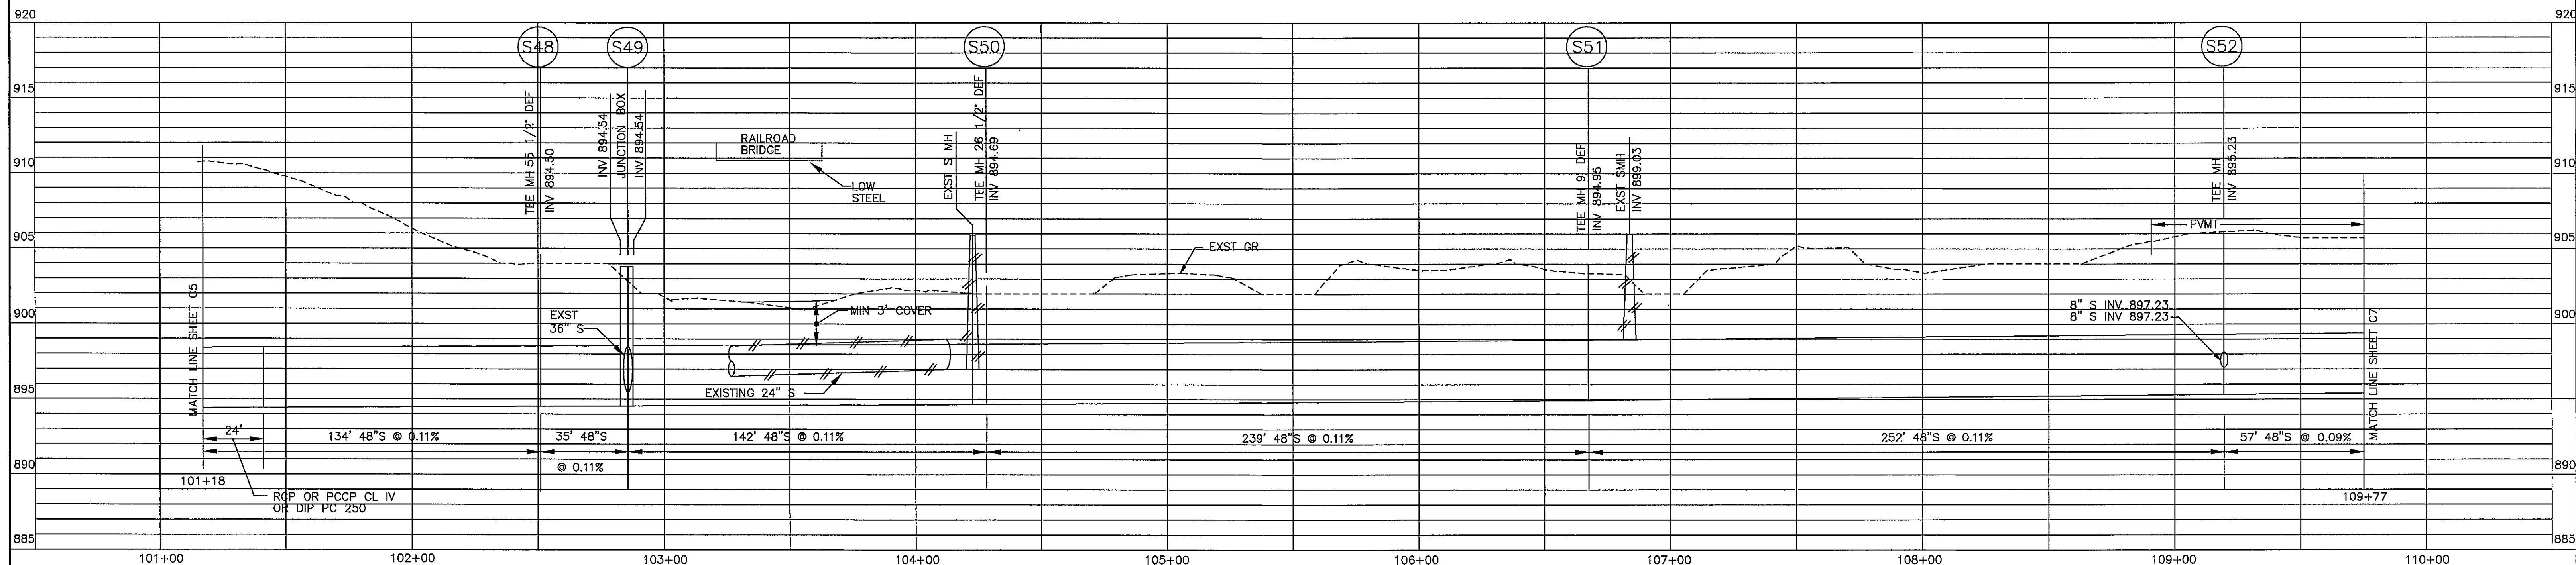

HAYES, SEAY, MATTERN & MATTERN, INC. ARCHITECTS/ENGINEERS/PLANNERS ROANOKE, VIRGINIA	DESIGNED: DMH	DATE	BY	REVISIONS		GRAPHIC SCALES VERTICAL 1" = 5'  HORIZONTAL 1" = 30' 	TINKER CREEK INTERCEPTOR SEWER CITY OF ROANOKE, VIRGINIA			PROJECT NO.: 6317
	DRAWN: MHL	10/15/98	MNH	RECORD DRAWINGS SEE SHEET G1 FOR NOTE			CONTRACT B			
	CHECKED:						SHEET NO.			
	APPROVED:						C6			
							RECORD DRAWINGS			
						COMM. NO.: 7211	SCALE: AS NOTED	DATE: MAY 17, 1996		