
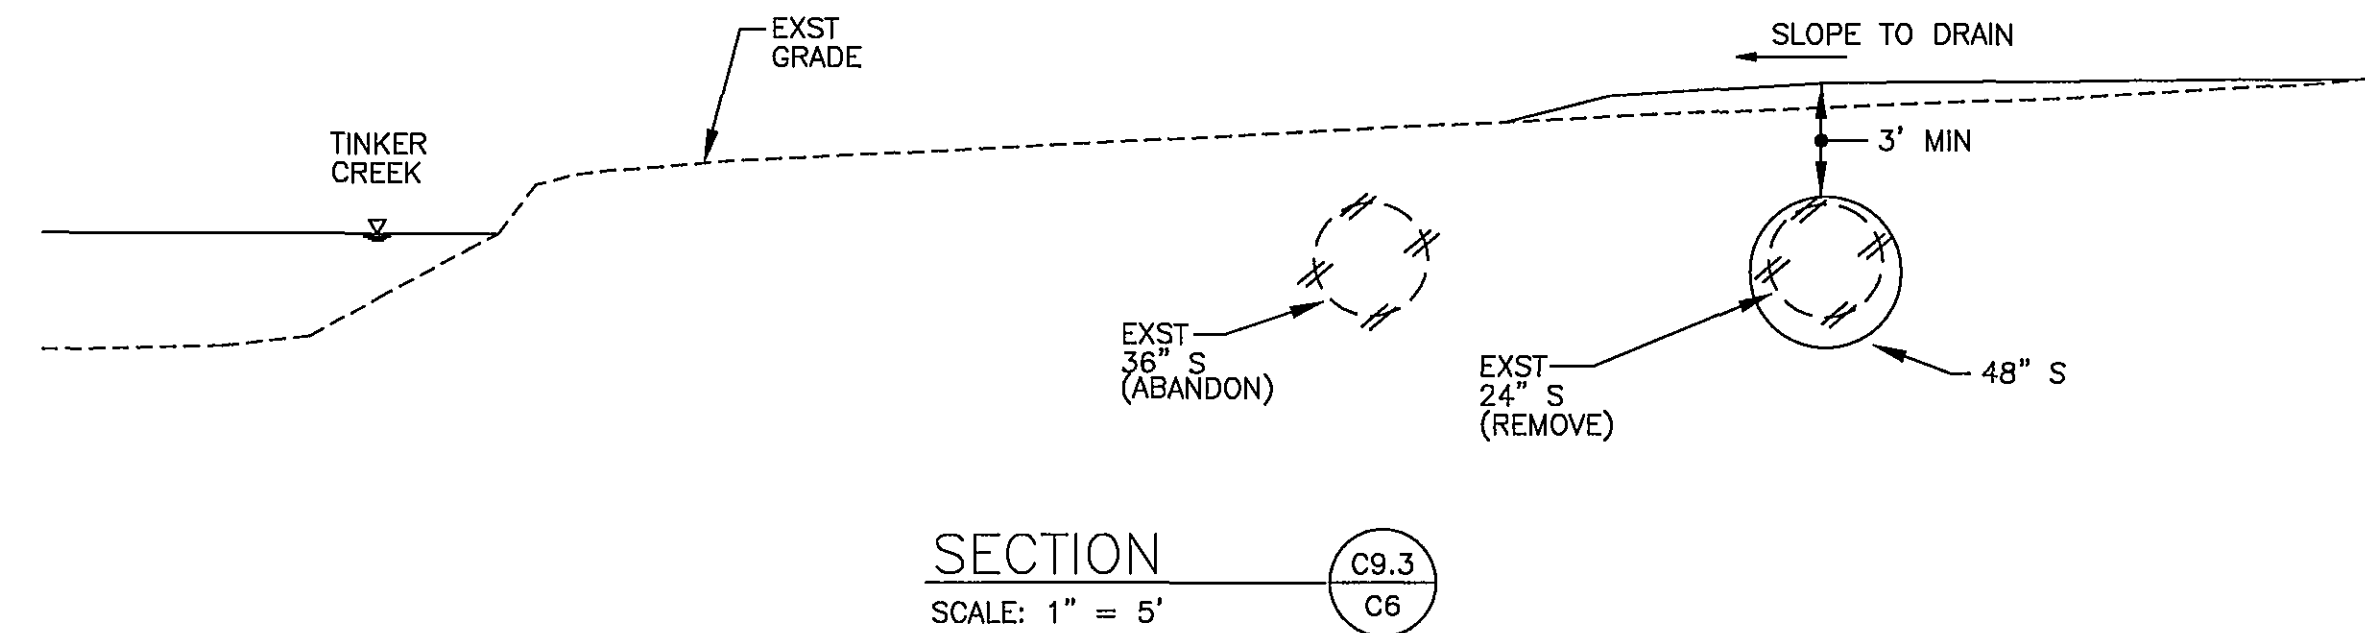
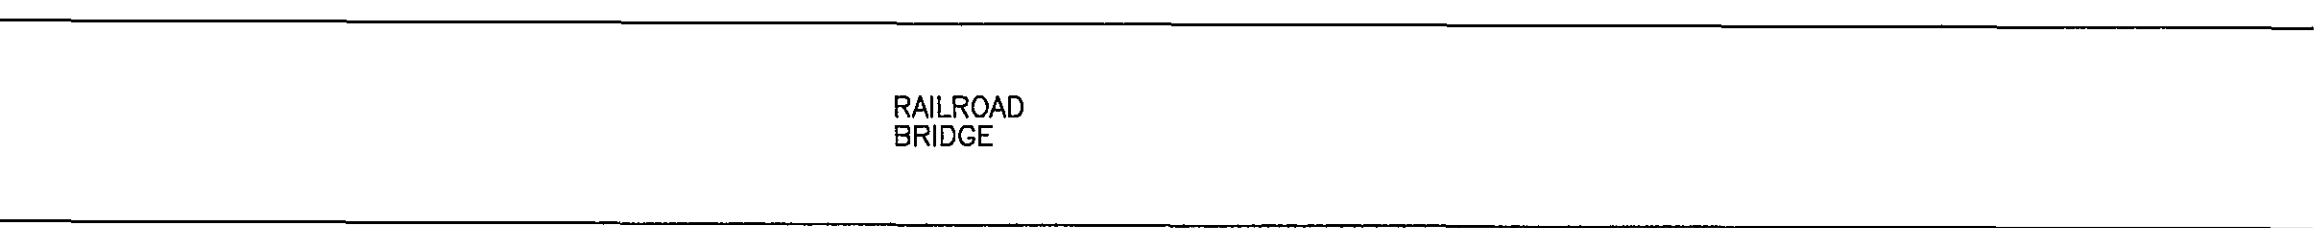
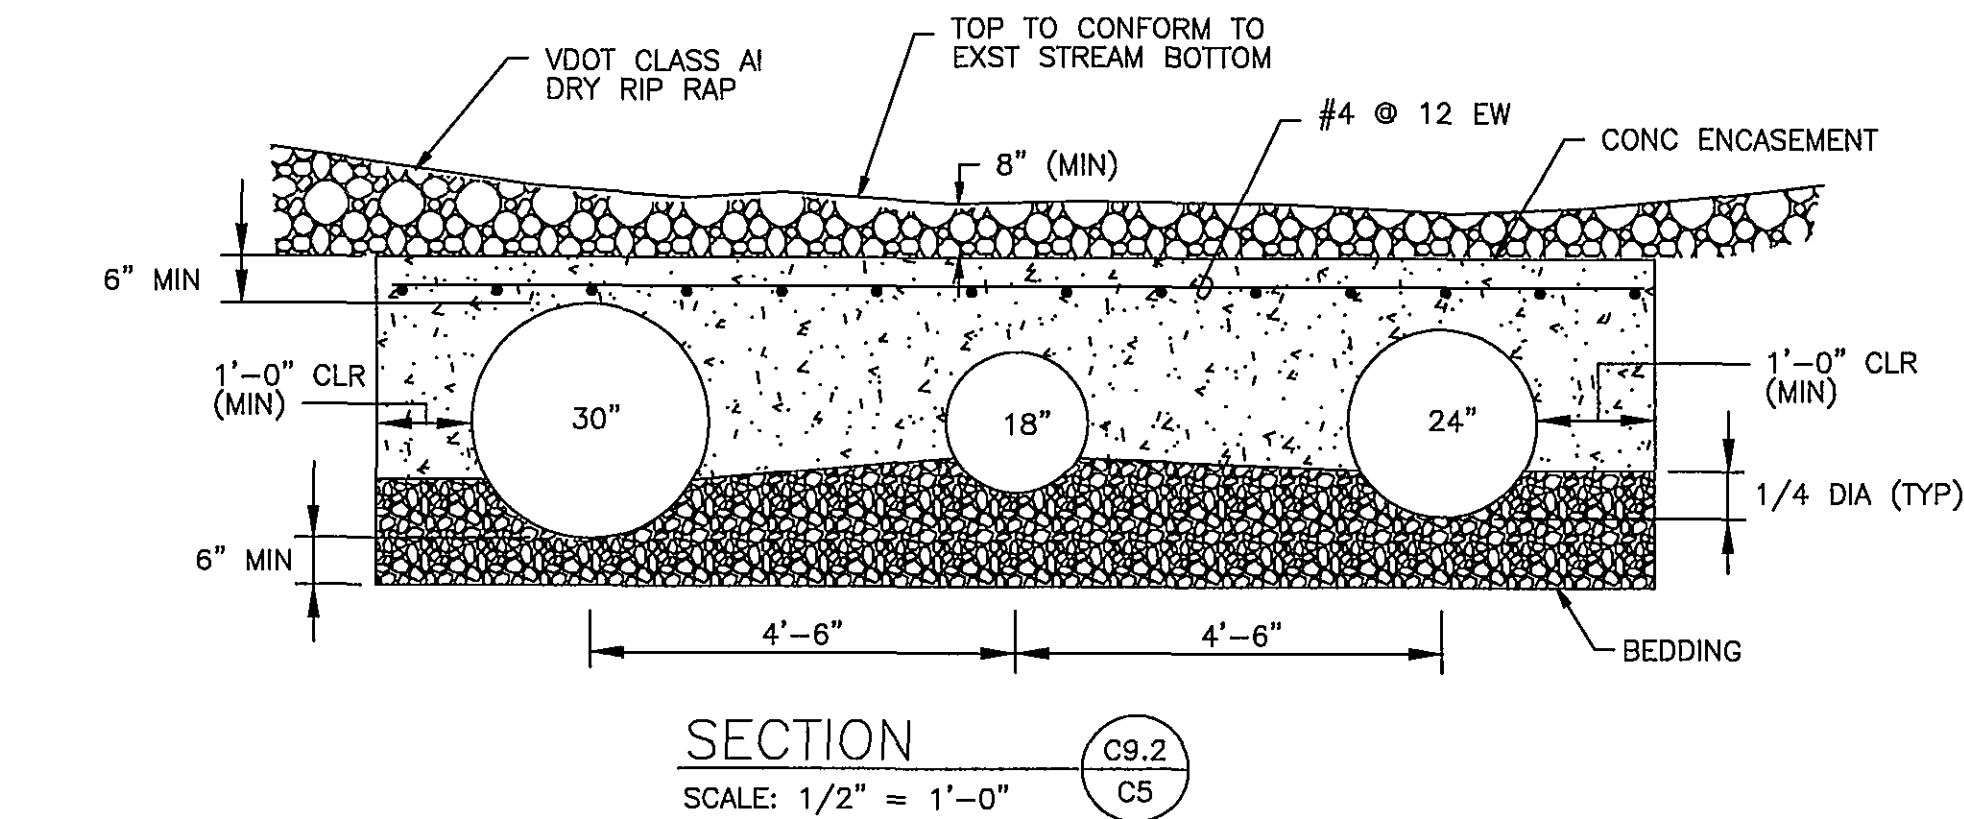



NOTES:

- EXISTING GRADES AND ELEVATIONS VARY. PROVIDE TEMPORARY AGGREGATE WORK PAD AS REQUIRED FOR THE WORK. LIMIT ENCROACHMENT ON STREAM CHANNEL. PROVIDE SILT FENCE AT EDGE OF STREAM AND WORK PAD.
- STABILIZE DISTURBED AREA AS THE WORK PROGRESSES. ANCHOR SILT FENCE ALONG EDGE OF STREAM TO SECTIONS OF PRECAST CONCRETE TRAFFIC BARRIER, VDOT STD MB 7A PC, OR EQUIVALENT SUPPORTS TO PRECLUDE TEARING OR OTHER FAILURE OF THE SILT FENCE. REMOVE SOIL MATERIAL DAILY FROM SILT FENCE LOCATED ALONG EDGE OF STREAM.

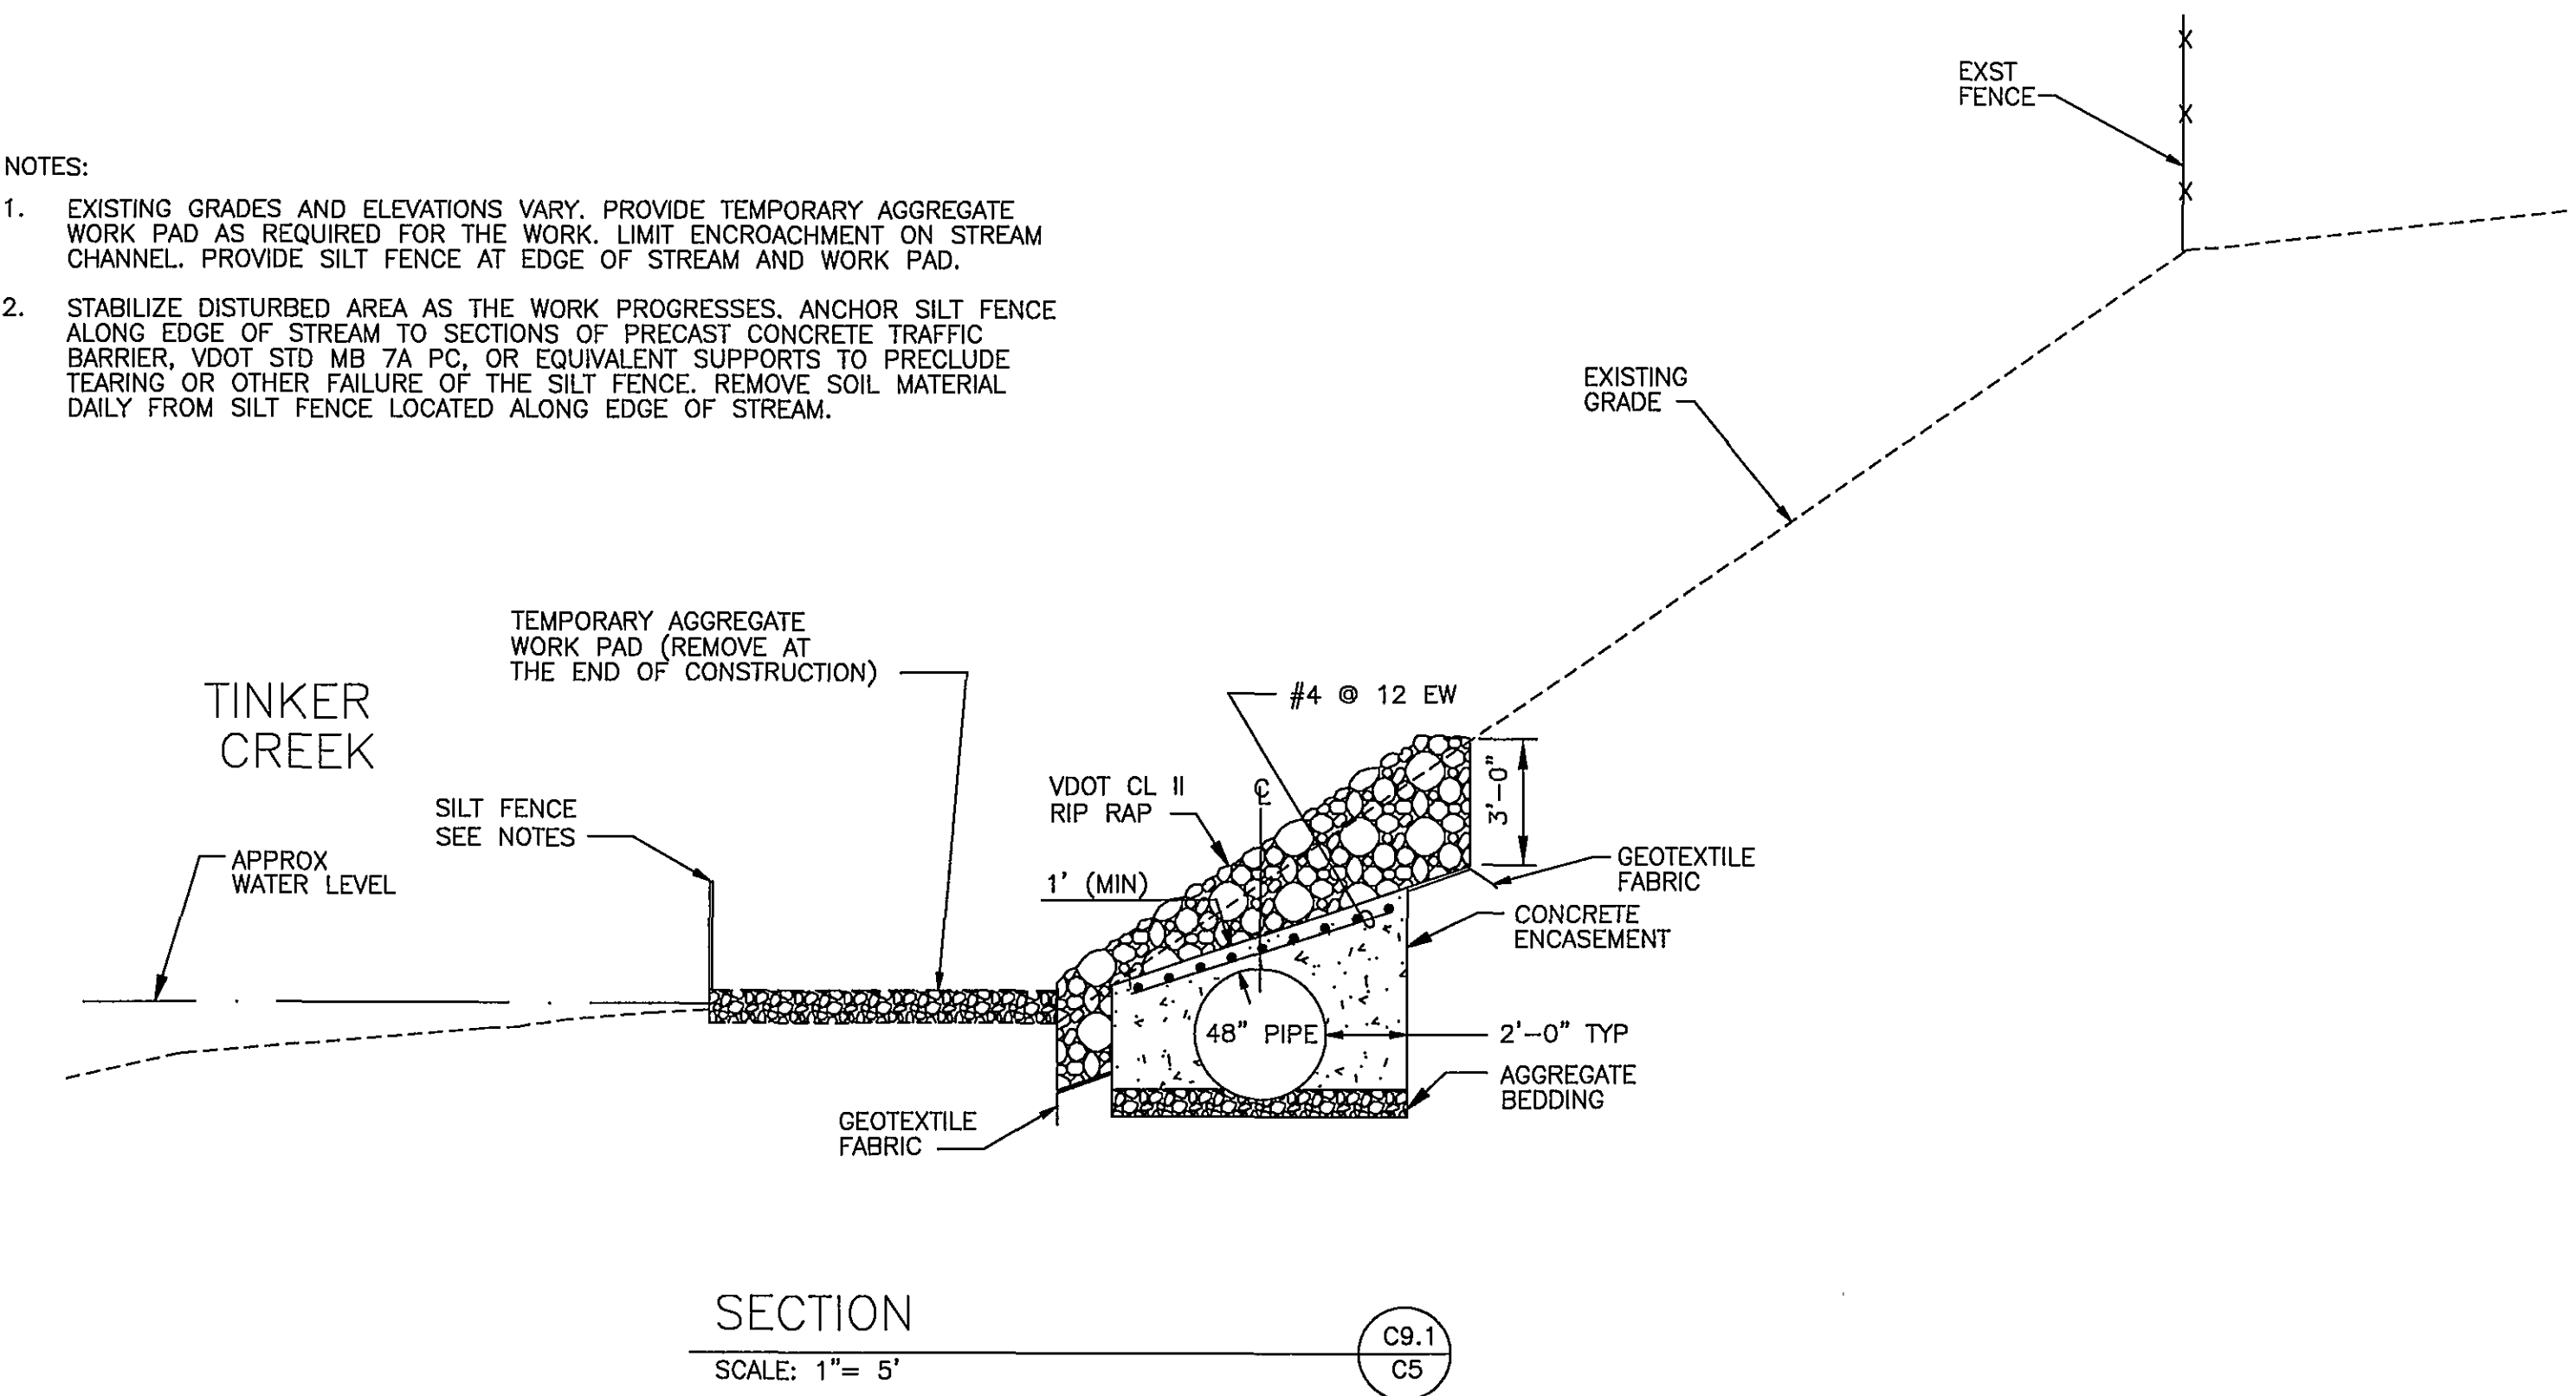

HAYES, SEAY, MATTERN & MATTERN, INC.
ARCHITECTS/ENGINEERS/PLANNERS
ROANOKE, VIRGINIA

DESIGNED: DMH	DATE	BY	REVISIONS	
			DESCRIPTION	
DRAWN: MHL	10/15/98	MNH	RECORD DRAWINGS SEE SHEET G1 FOR NOTE	
CHECKED:				
APPROVED:				

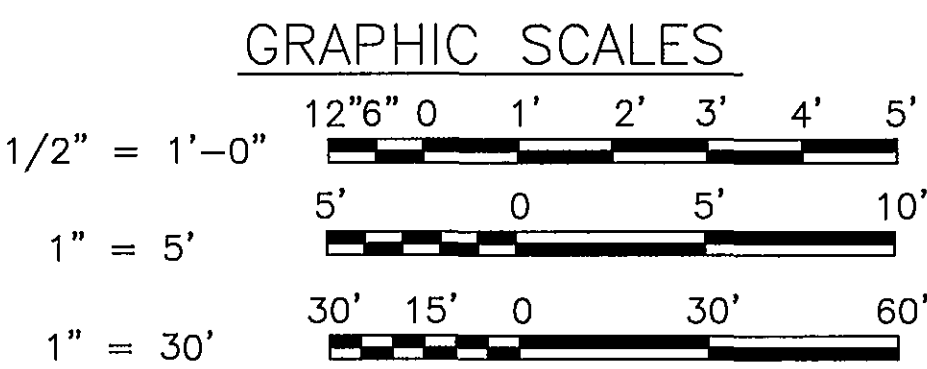

TINKER CREEK INTERCEPTOR SEWER CITY OF ROANOKE, VIRGINIA			PROJECT NO.: 6317
SECTIONS AND PROFILES			CONTRACT B SHEET NO. C9
COMM. NO.: 7211	SCALE: AS NOTED	DATE: MAY 17, 1996	RECORD DRAWINGS