



SECTION
NO SCALE

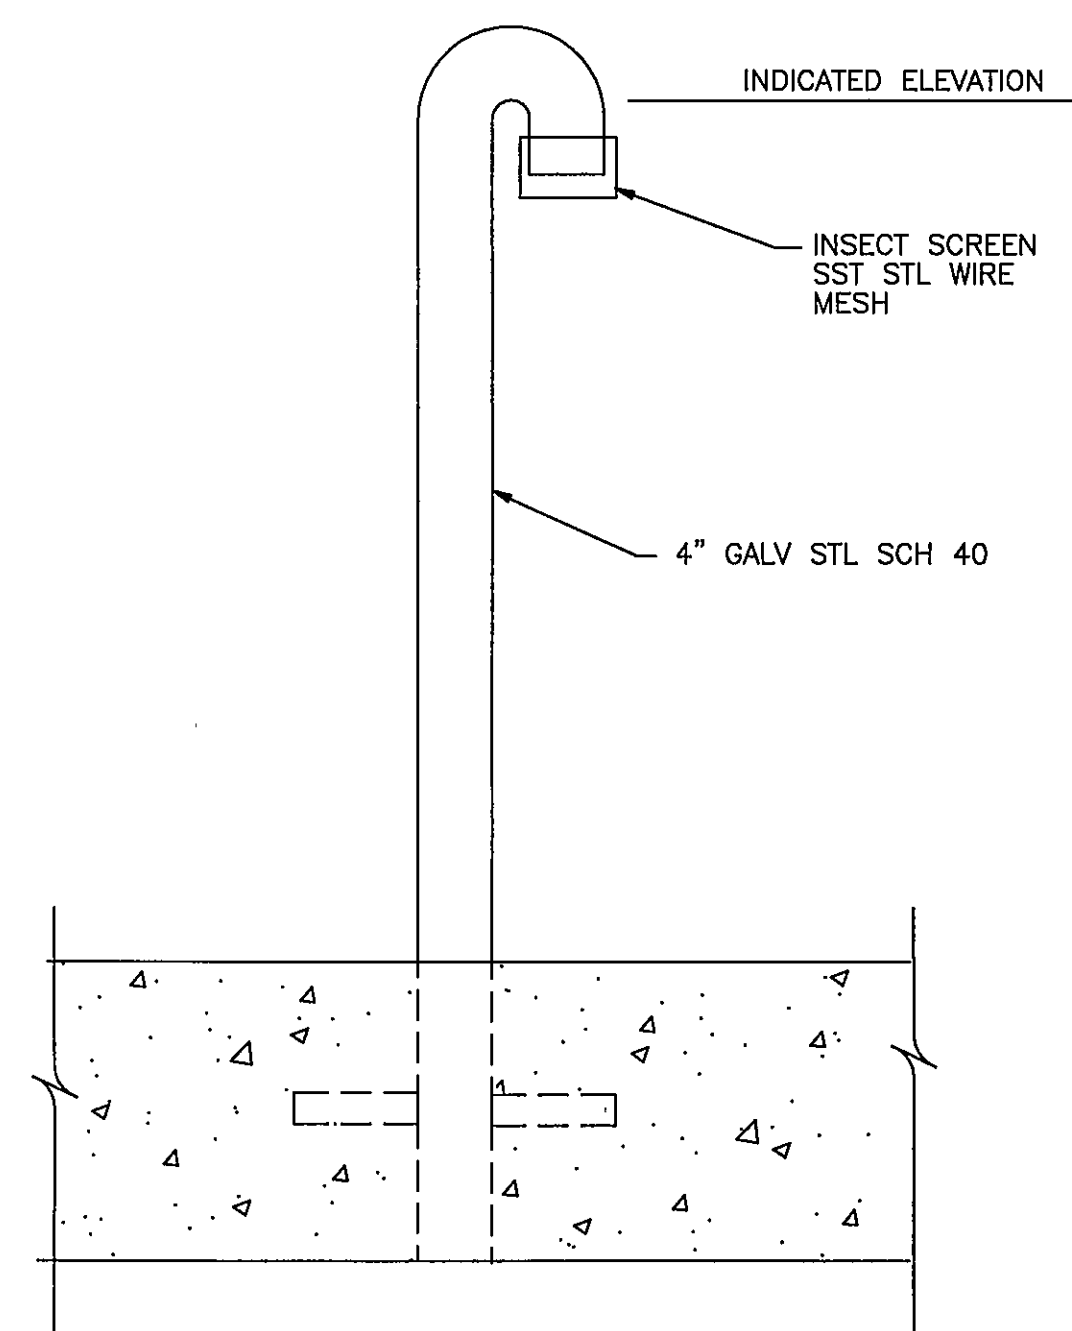

VENT DETAIL
NO SCALE

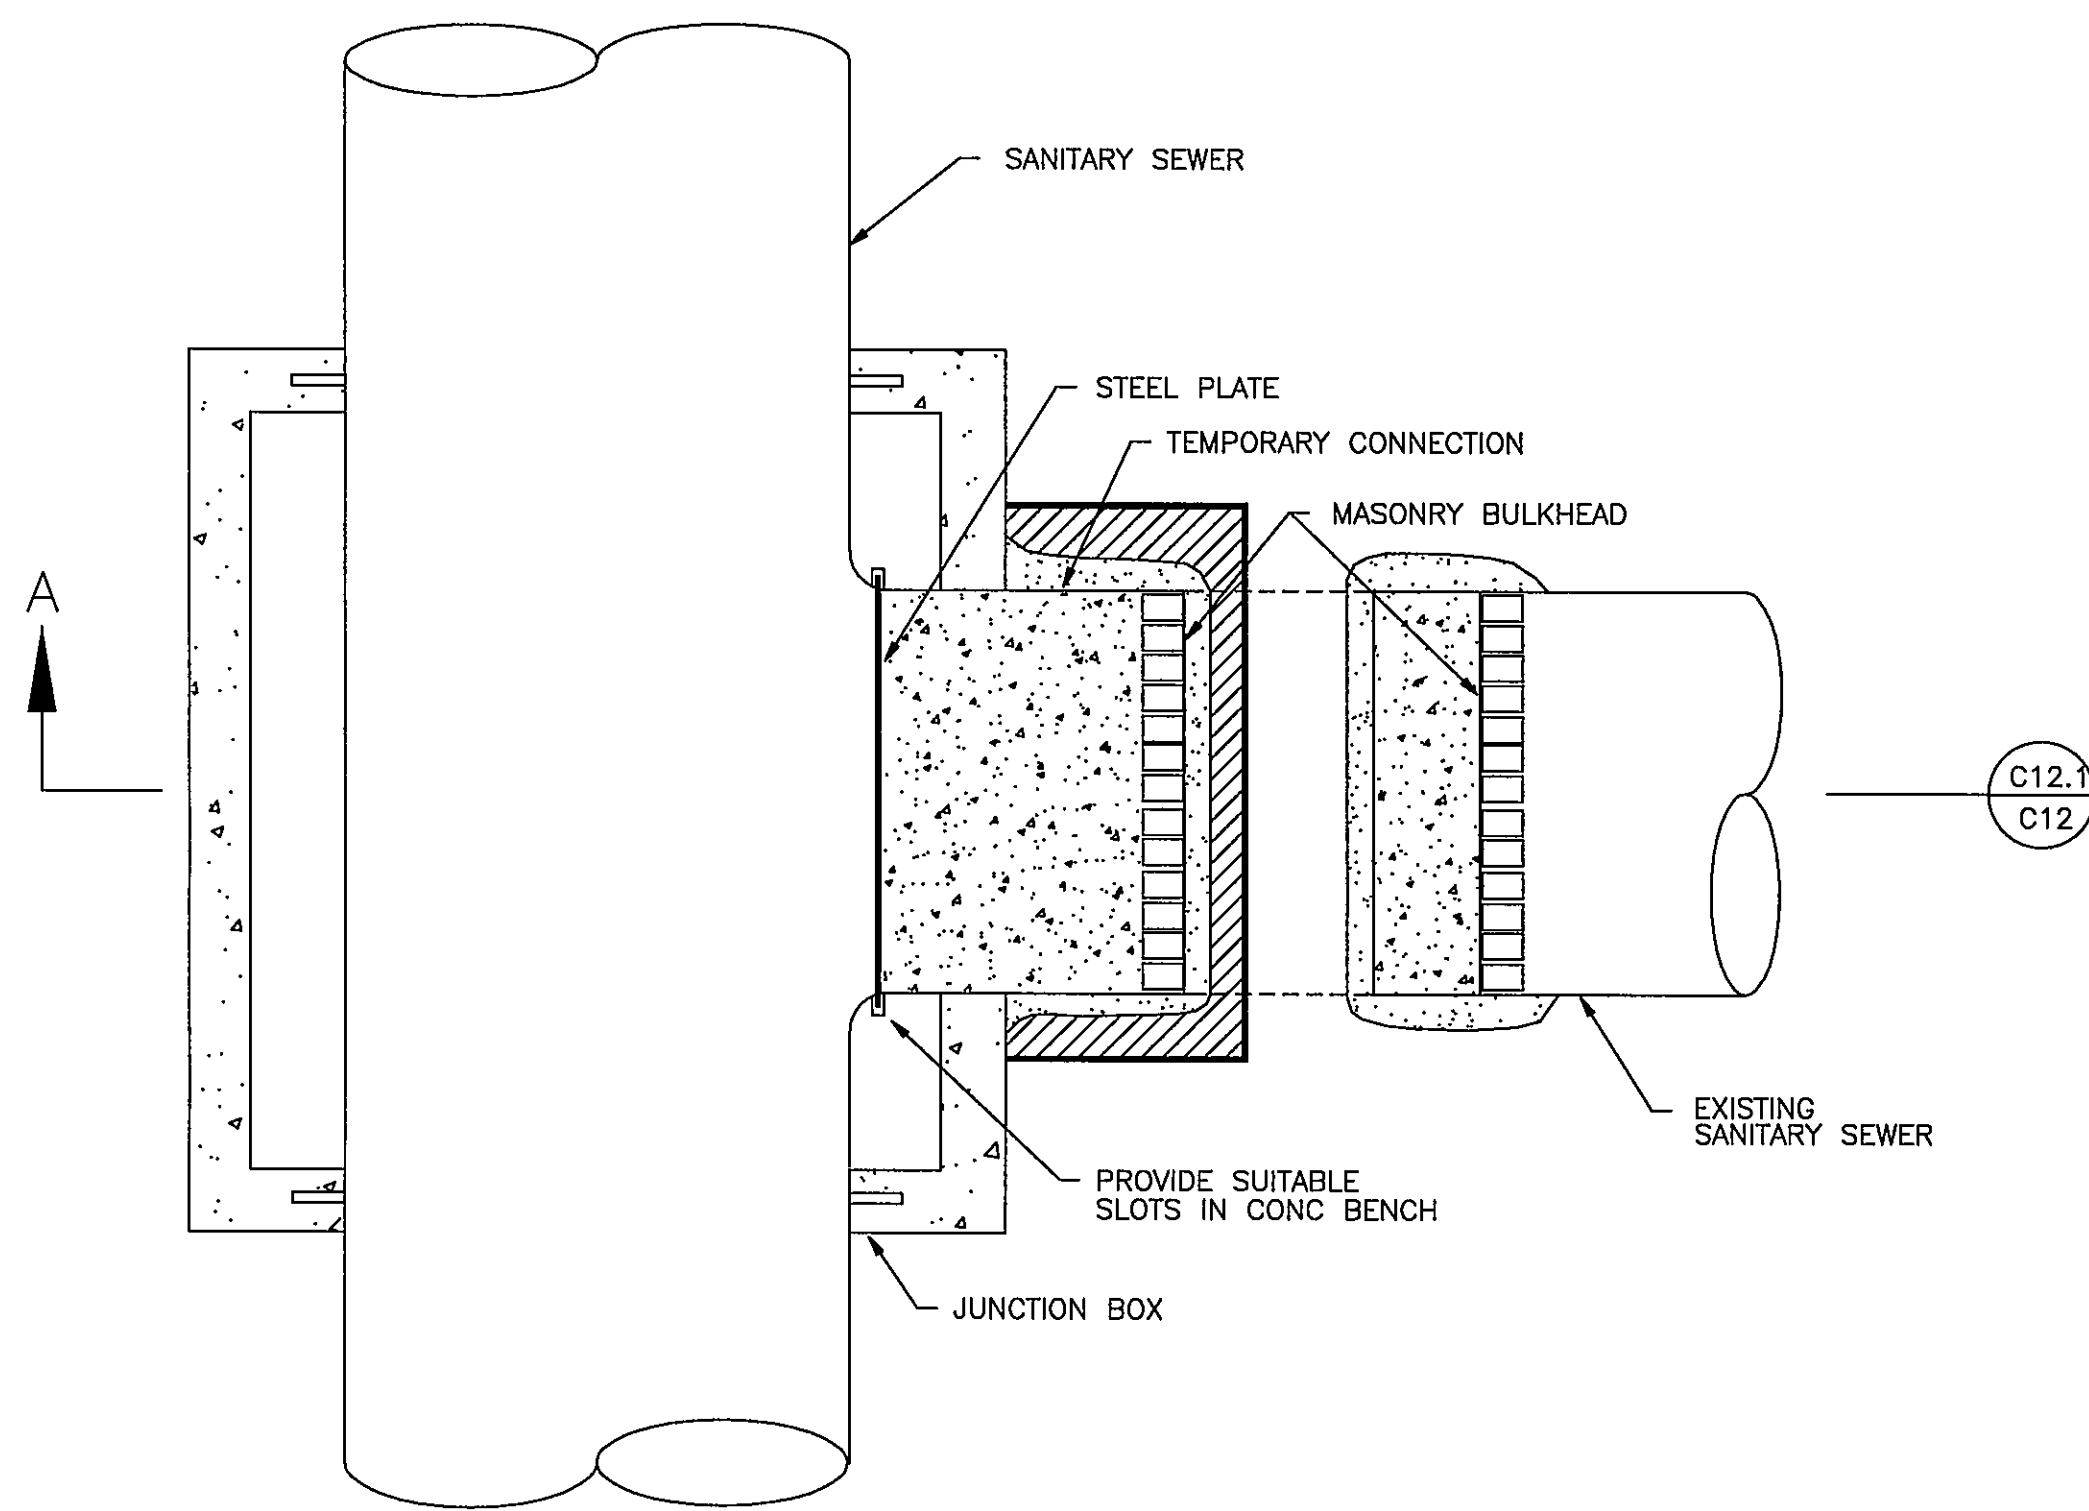


PLAN
NO SCALE

NOTE:

1. TEMPORARY CONNECTIONS ARE INDICATED FOR STRUCTURES S28, S32, S38 AND S49. THESE TEMPORARY CONNECTIONS ARE PROVIDED FOR THE CONTRACTOR'S CONVENIENCE AND CAN BE OMITTED IF NOT REQUIRED DUE TO THE SEQUENCE OF CONSTRUCTION EMPLOYED BY THE CONTRACTOR. REMOVE TEMPORARY CONNECTIONS AT SUCH TIME THAT THE SECTION OF EXISTING SANITARY SEWER CAN BE ABANDONED.

PERMANENT PLUG OF TEMPORARY CONNECTION
NO SCALE

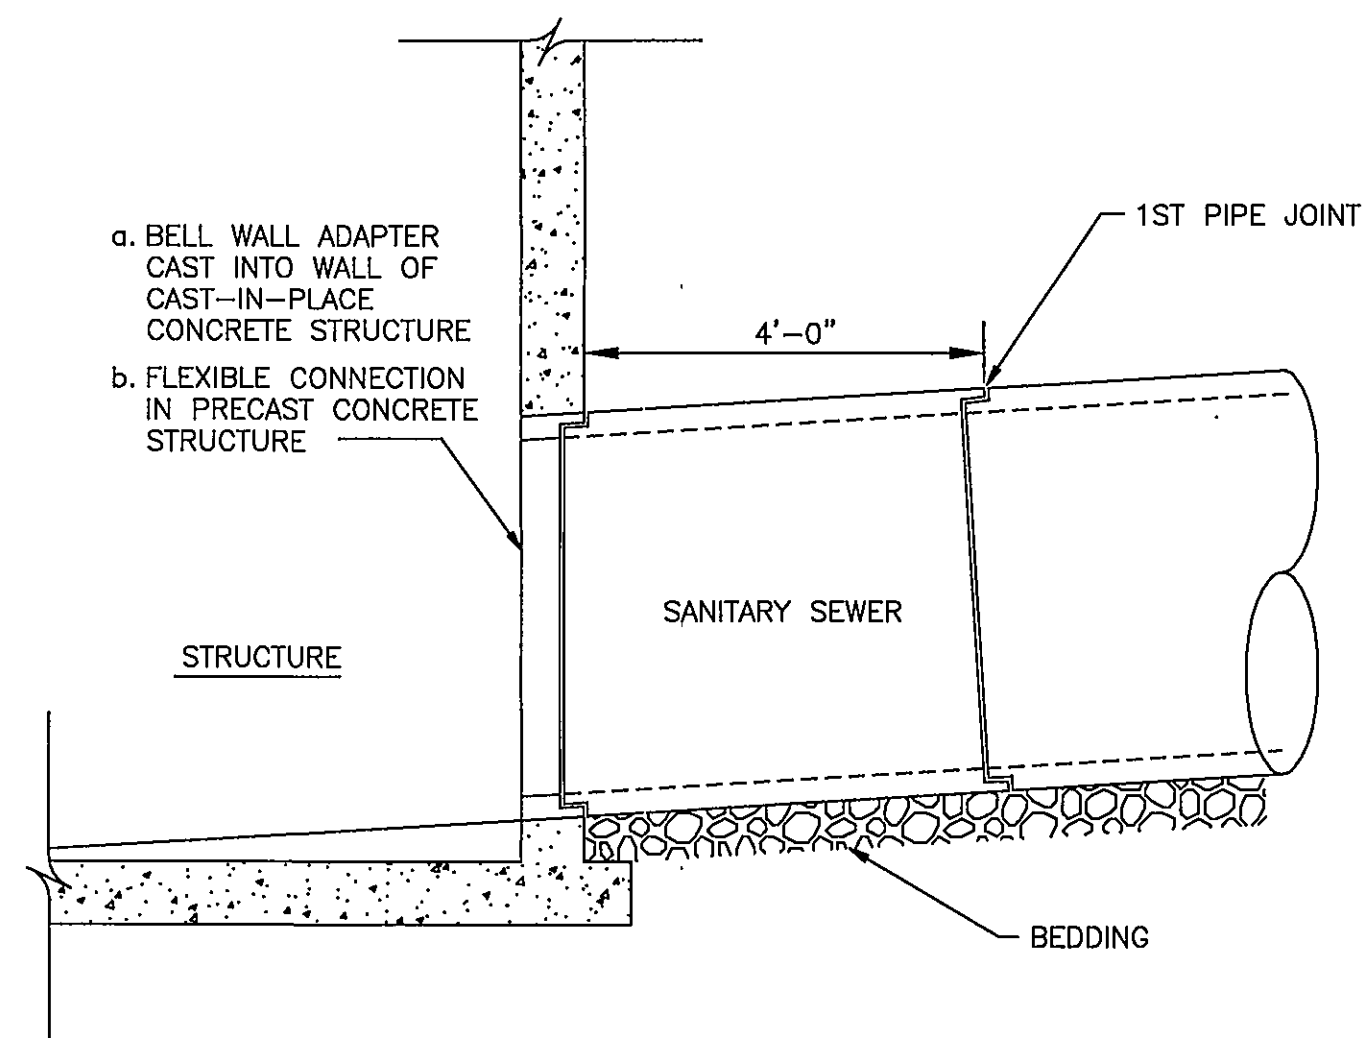

36" AND LARGER SANITARY SEWER CONNECTION
TO MANHOLES AND JUNCTION BOXES
NO SCALE

HAYES, SEAY, MATTERN & MATTERN, INC.
ARCHITECTS/ENGINEERS/PLANNERS
ROANOKE, VIRGINIA

DESIGNED: DMH	DATE	BY	REVISIONS	
			DESCRIPTION	
DRAWN: MHL	10/15/98	MNH	RECORD DRAWINGS SEE SHEET G1 FOR NOTE	
CHECKED:				
APPROVED:				

TINKER CREEK INTERCEPTOR SEWER
CITY OF ROANOKE, VIRGINIA

DETAILS

PROJECT NO.: 6317

CONTRACT B
SHEET NO.

C12

RECORD DRAWINGS

COMM. NO.: 7211

SCALE: AS NOTED

DATE: MAY 17, 1996