



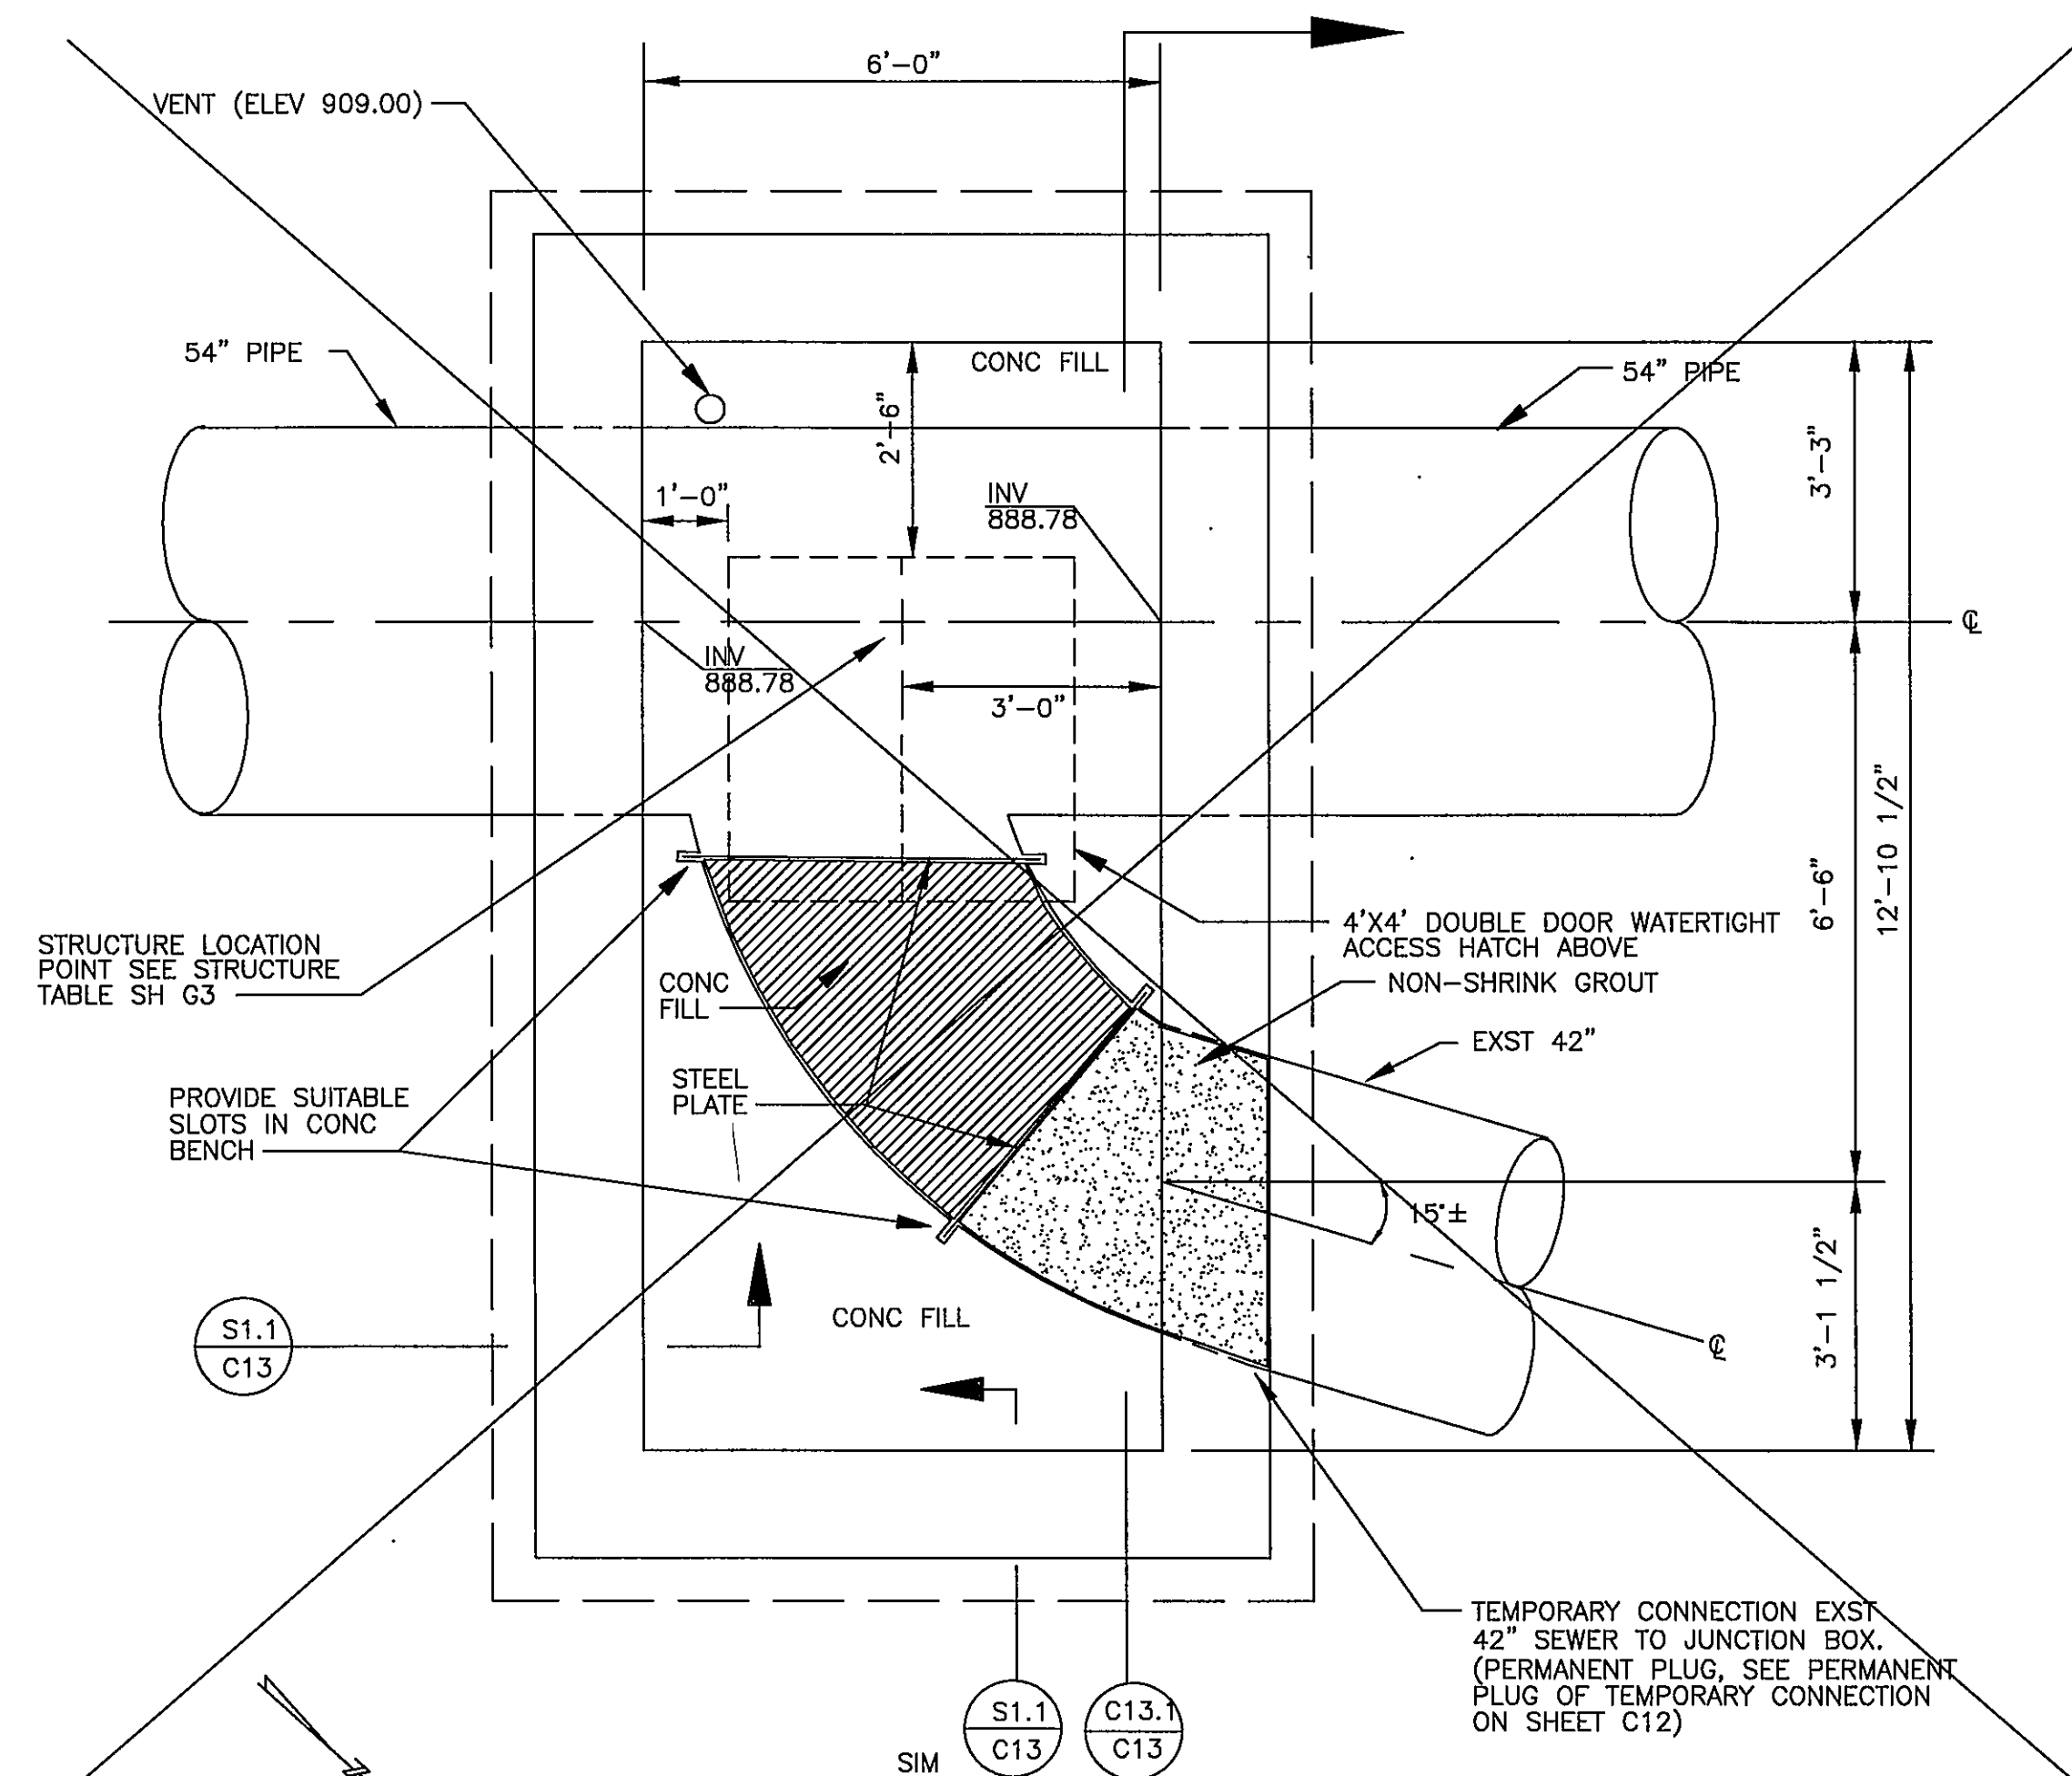


JUNCTION BOX S28
SCALE: 1/2" = 1'-0"

DELETED FROM PROJECT

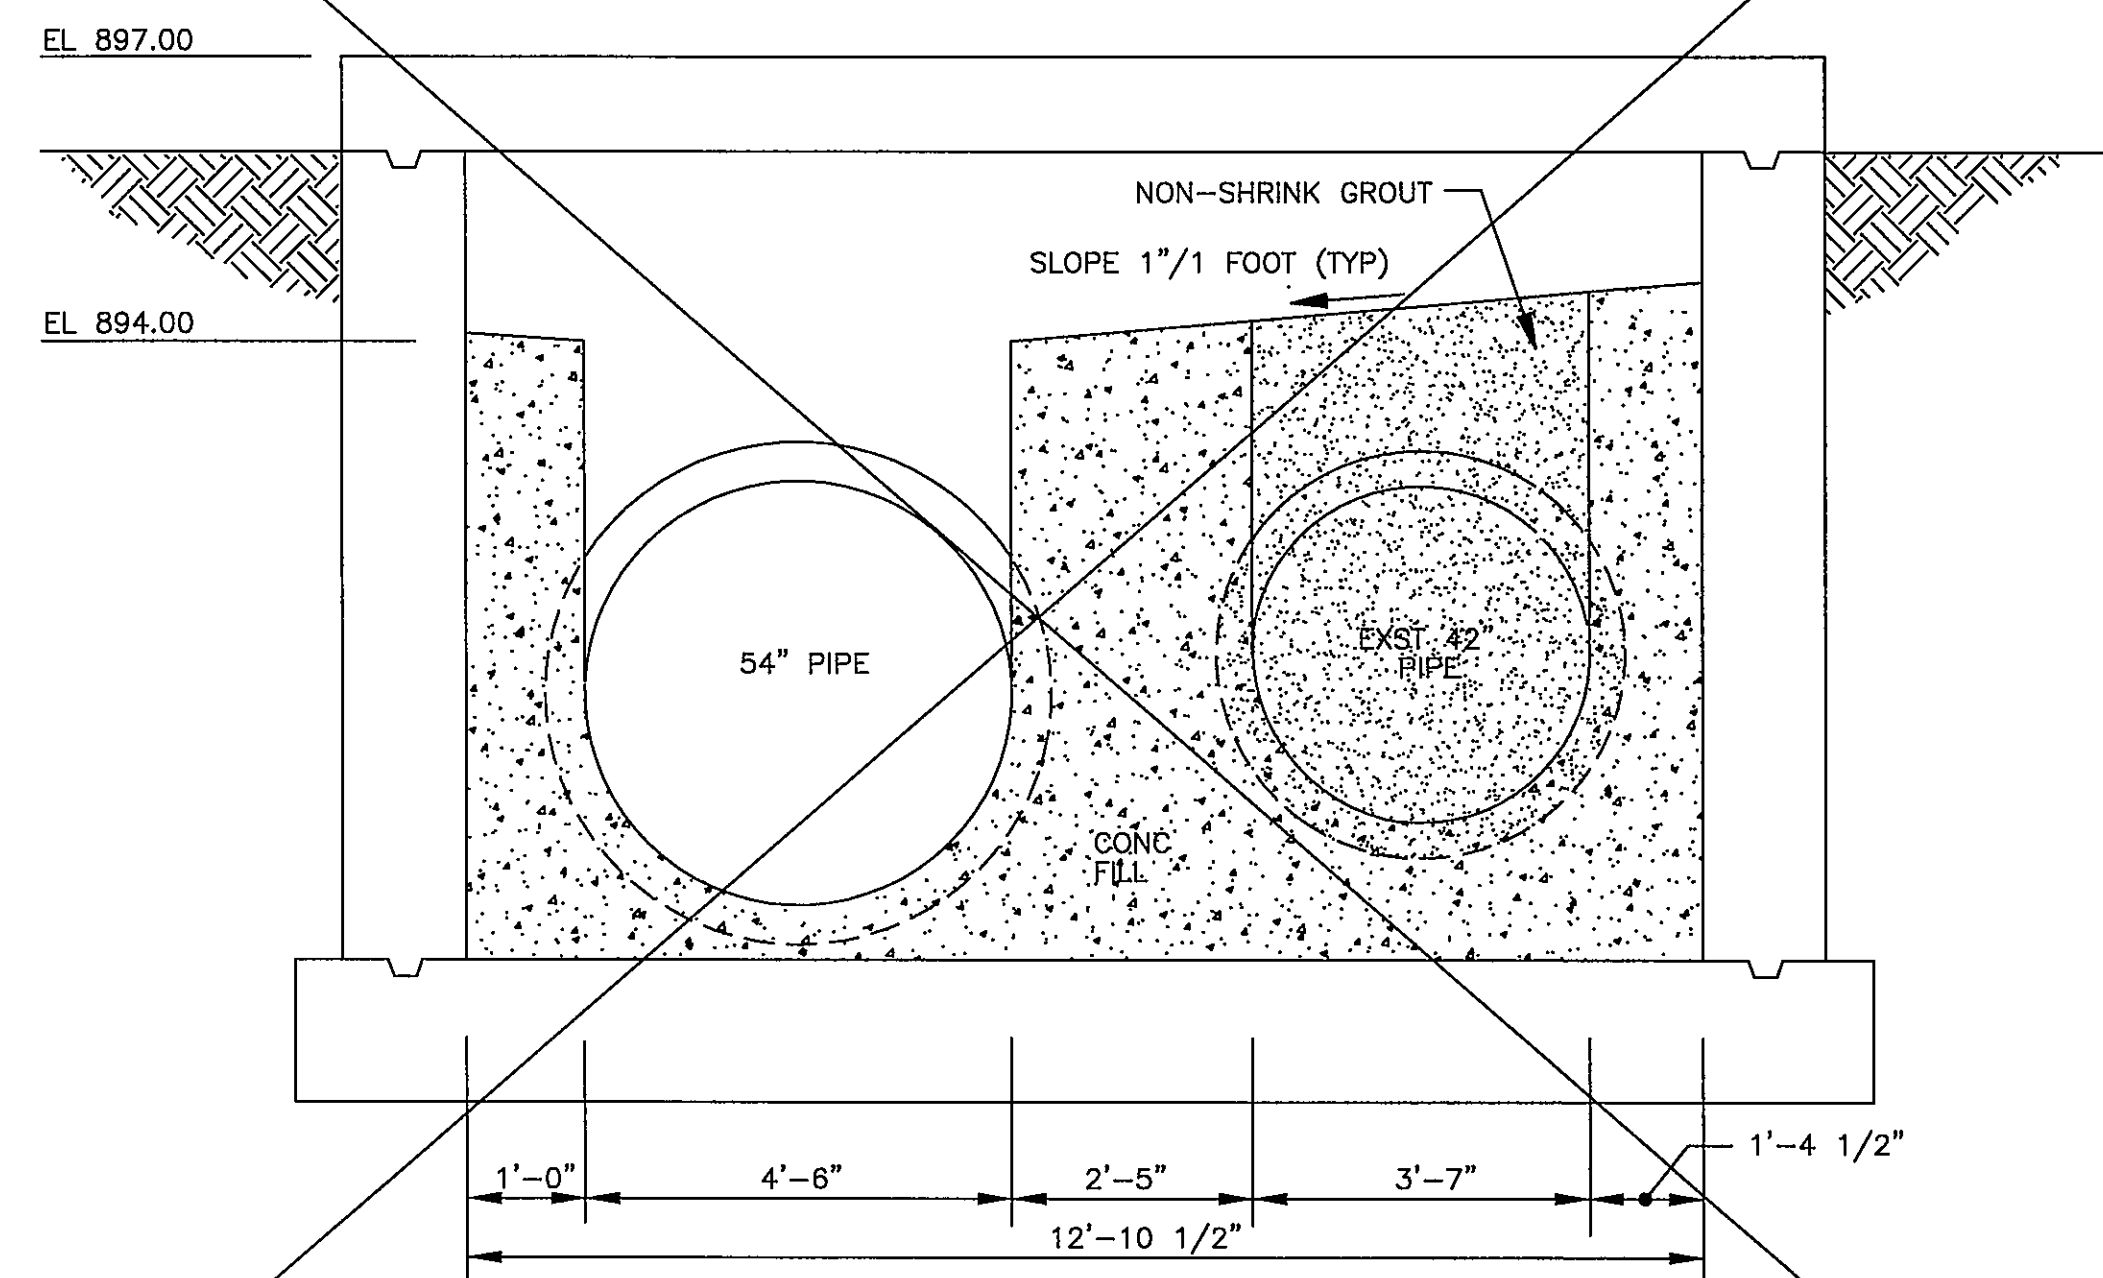


SECTION JB S28
SCALE: 1/2" = 1'-0"

C13.1
C13

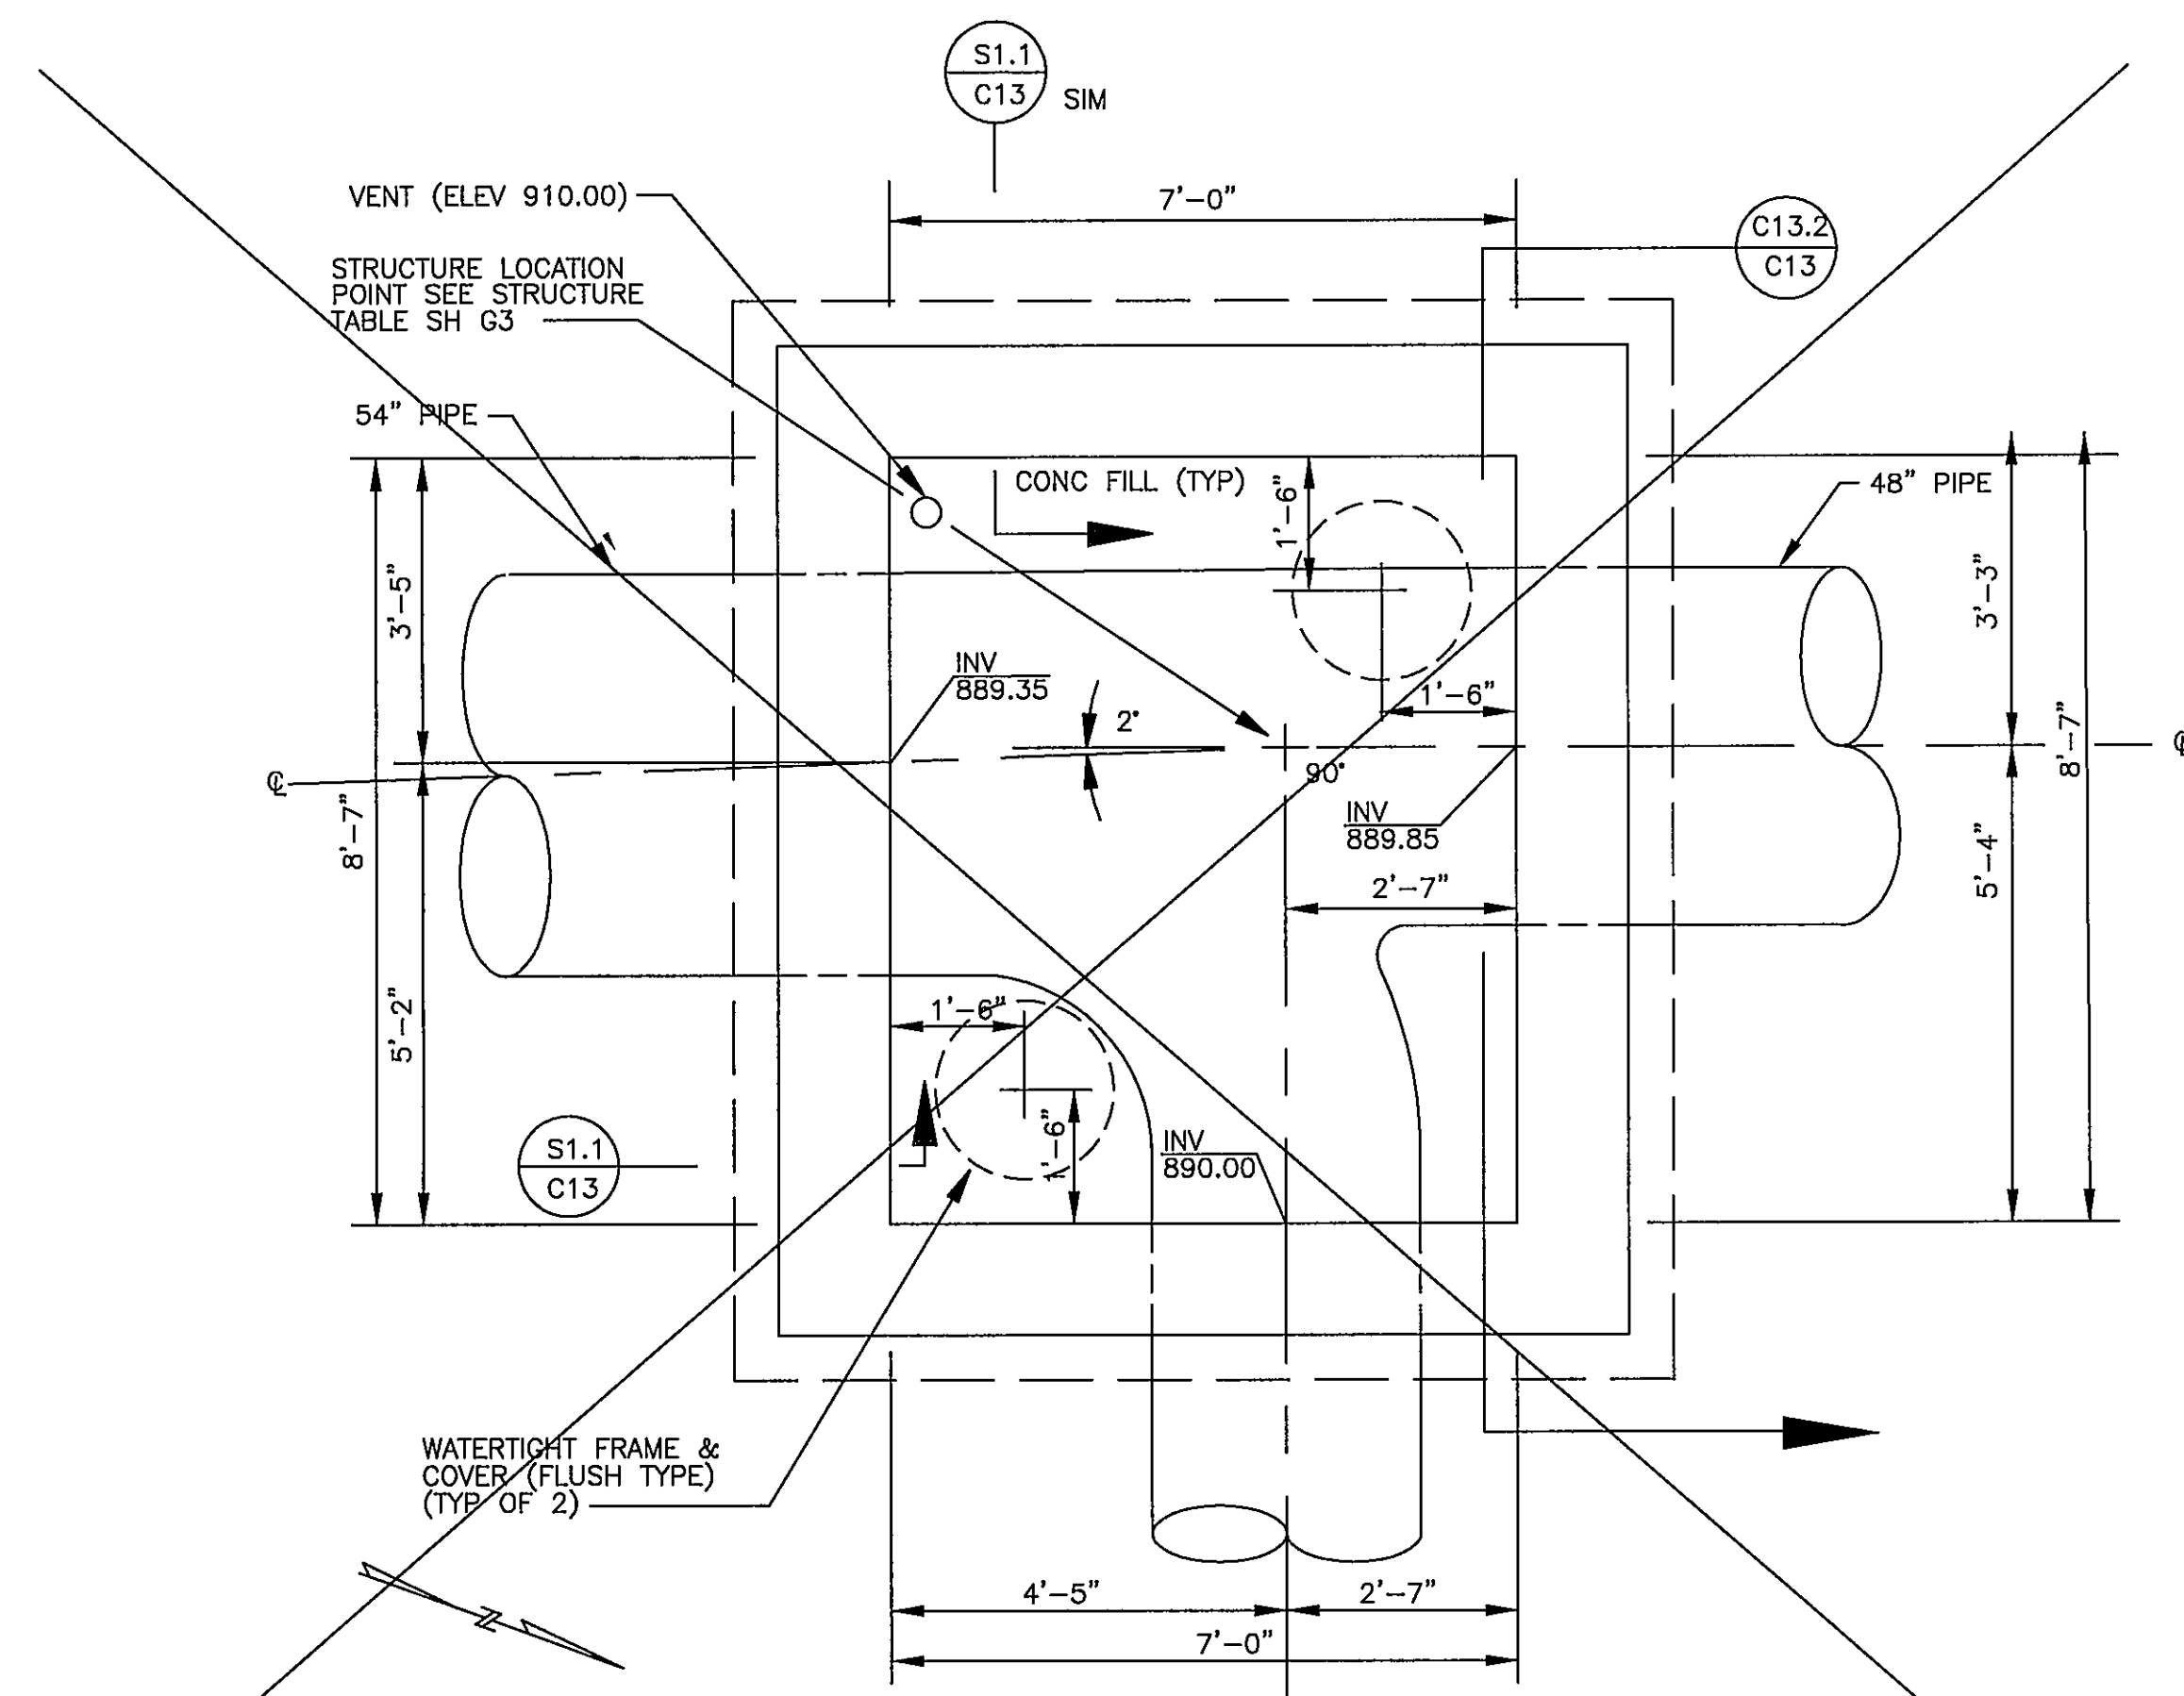

JUNCTION BOX S30
SCALE: 1/2" = 1'-0"
SEE SHEET G3

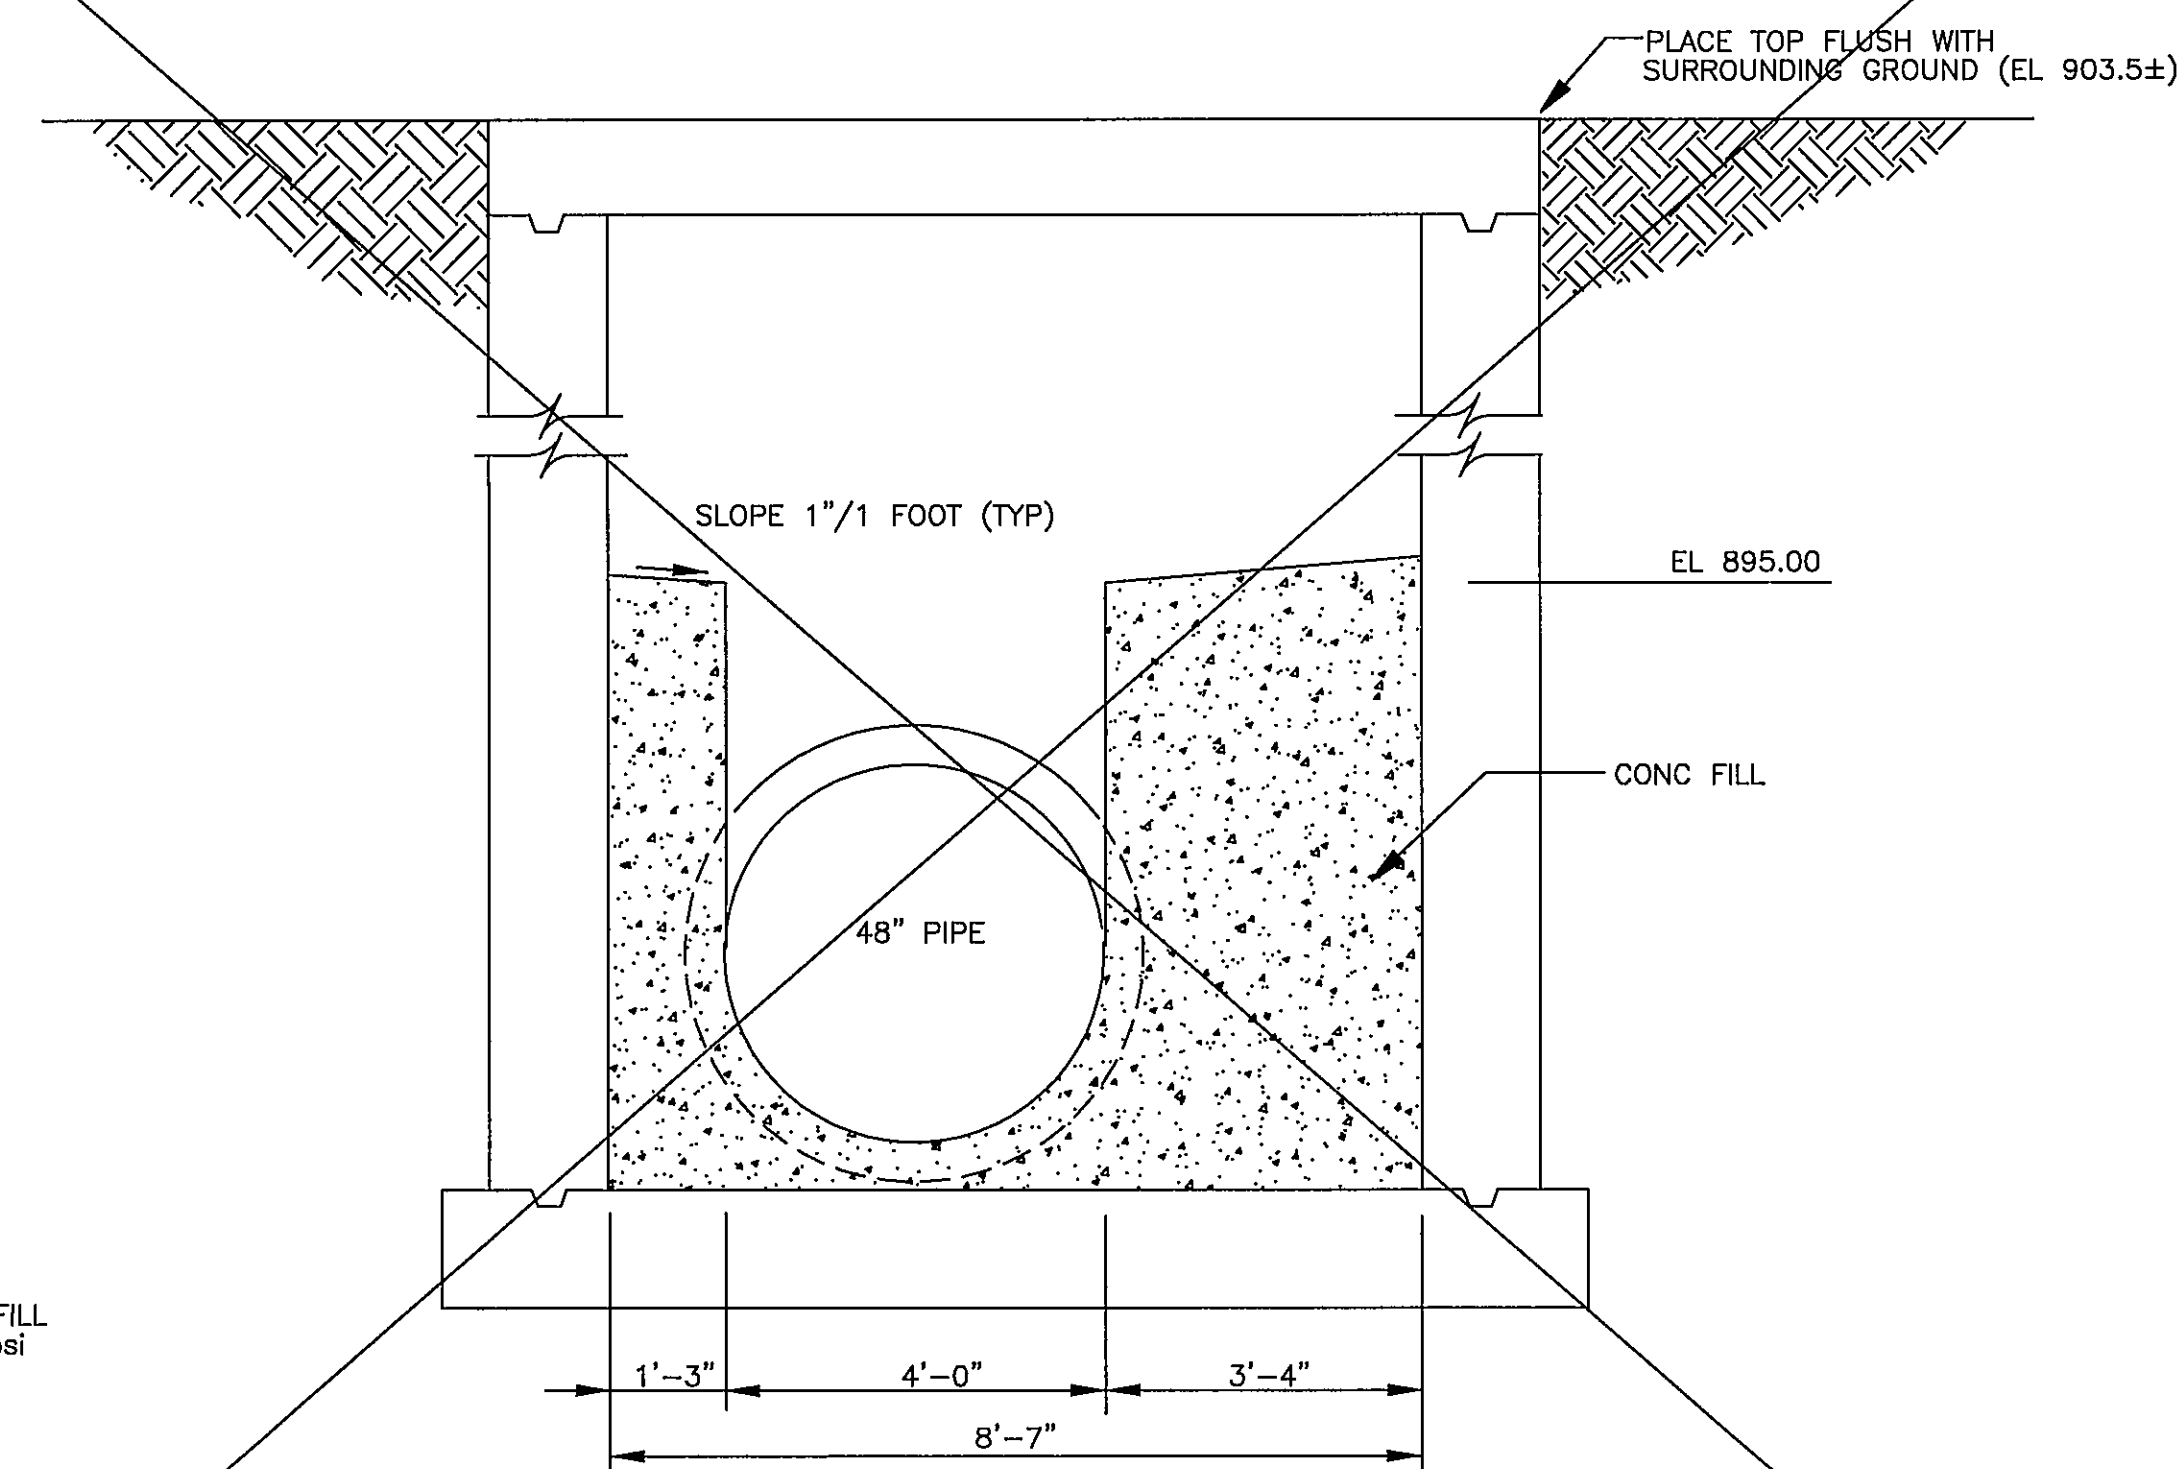

SECTION JB S30
SCALE: 1/2" = 1'-0"

C13.2
C13

NOTE:
CONCRETE FILL IS CLASS A CONCRETE. CONCRETE FILL MUST ATTAIN A COMPRESSIVE STRENGTH OF 3000 psi PRIOR TO DIVERTING FLOW THROUGH A STRUCTURE.

GRAPHIC SCALE

1/2" = 1'-0"

12" 6" 0' 1' 2' 3' 4' 5'

HAYES, SEAY, MATTERN & MATTERN, INC.
ARCHITECTS/ENGINEERS/PLANNERS
ROANOKE, VIRGINIA

DESIGNED: DMH	DATE	BY	REVISIONS	
			DESCRIPTION	
DRAWN: MHL	10/15/98	MNH	RECORD DRAWINGS SEE SHEET G1 FOR NOTE	
CHECKED:				
APPROVED:				

TINKER CREEK INTERCEPTOR SEWER
CITY OF ROANOKE, VIRGINIA

JUNCTION BOXES S28 & S30,
PLAN AND SECTION

COMM. NO.: 7211

SCALE: AS NOTED

DATE: MAY 17, 1996

PROJECT NO.: 6317

CONTRACT B
SHEET NO.

C13

RECORD DRAWINGS