




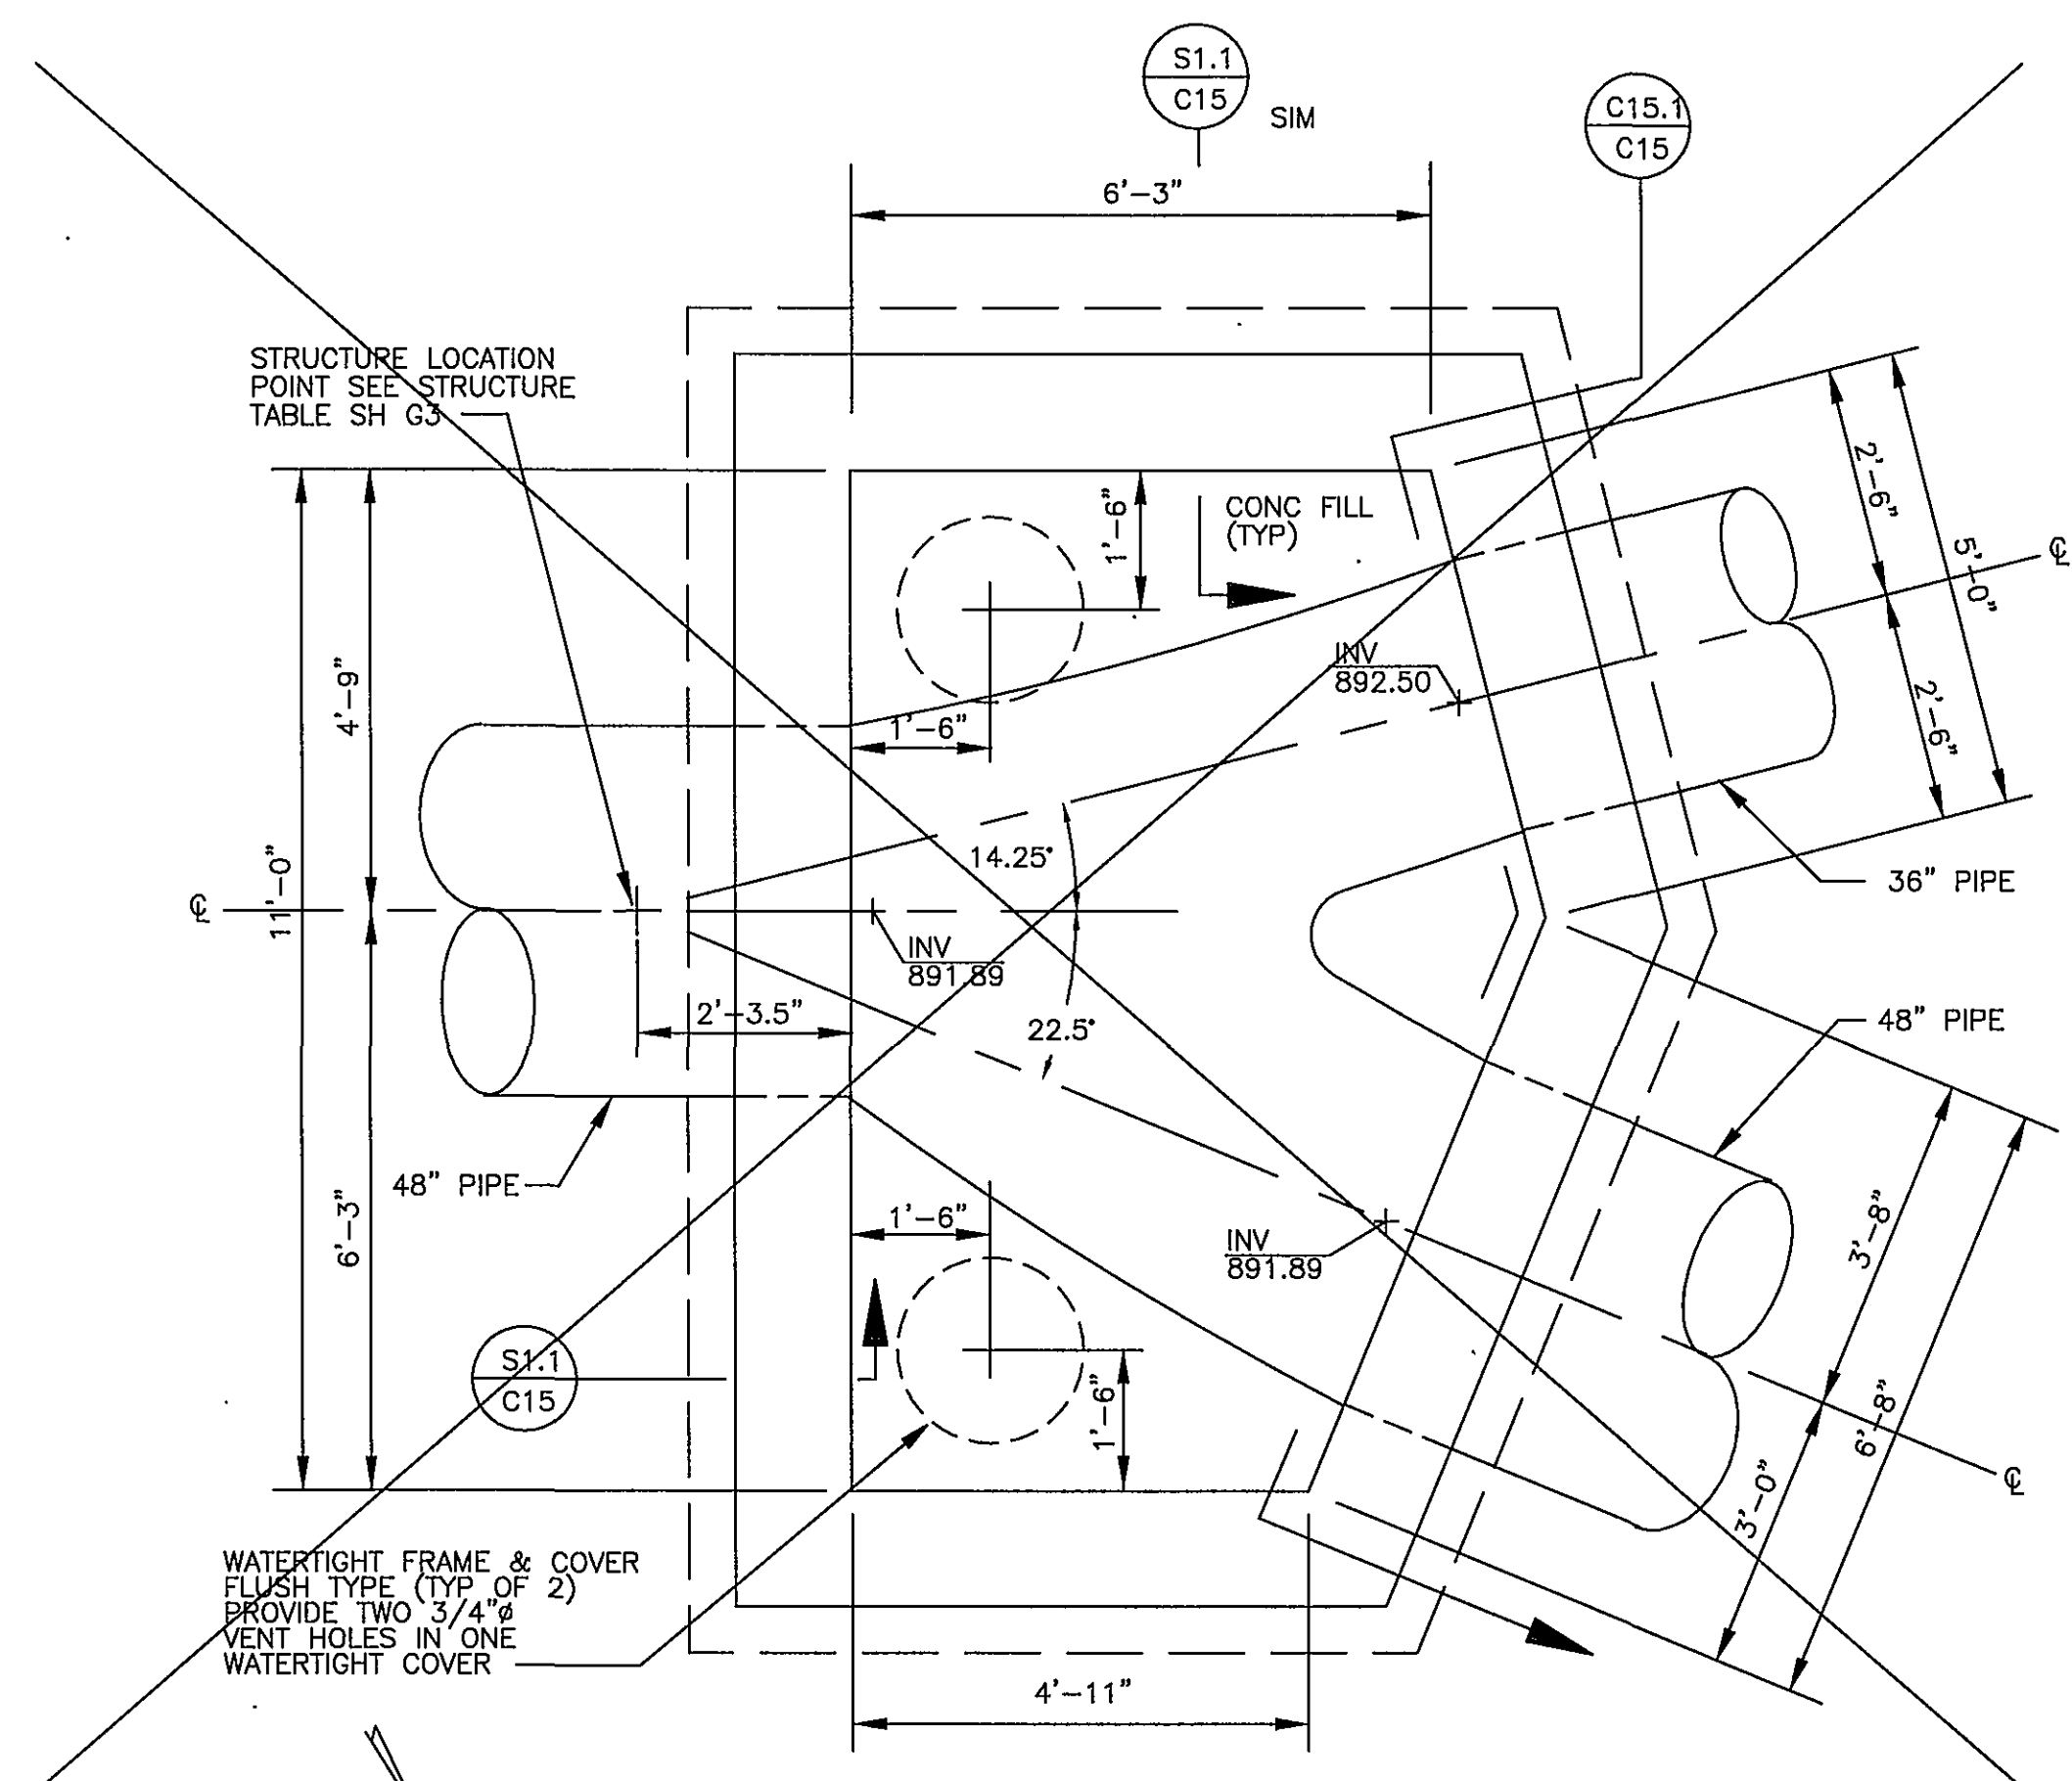


JUNCTION BOX S41
SCALE: 1/2" = 1'-0"
SEE SHEET G3

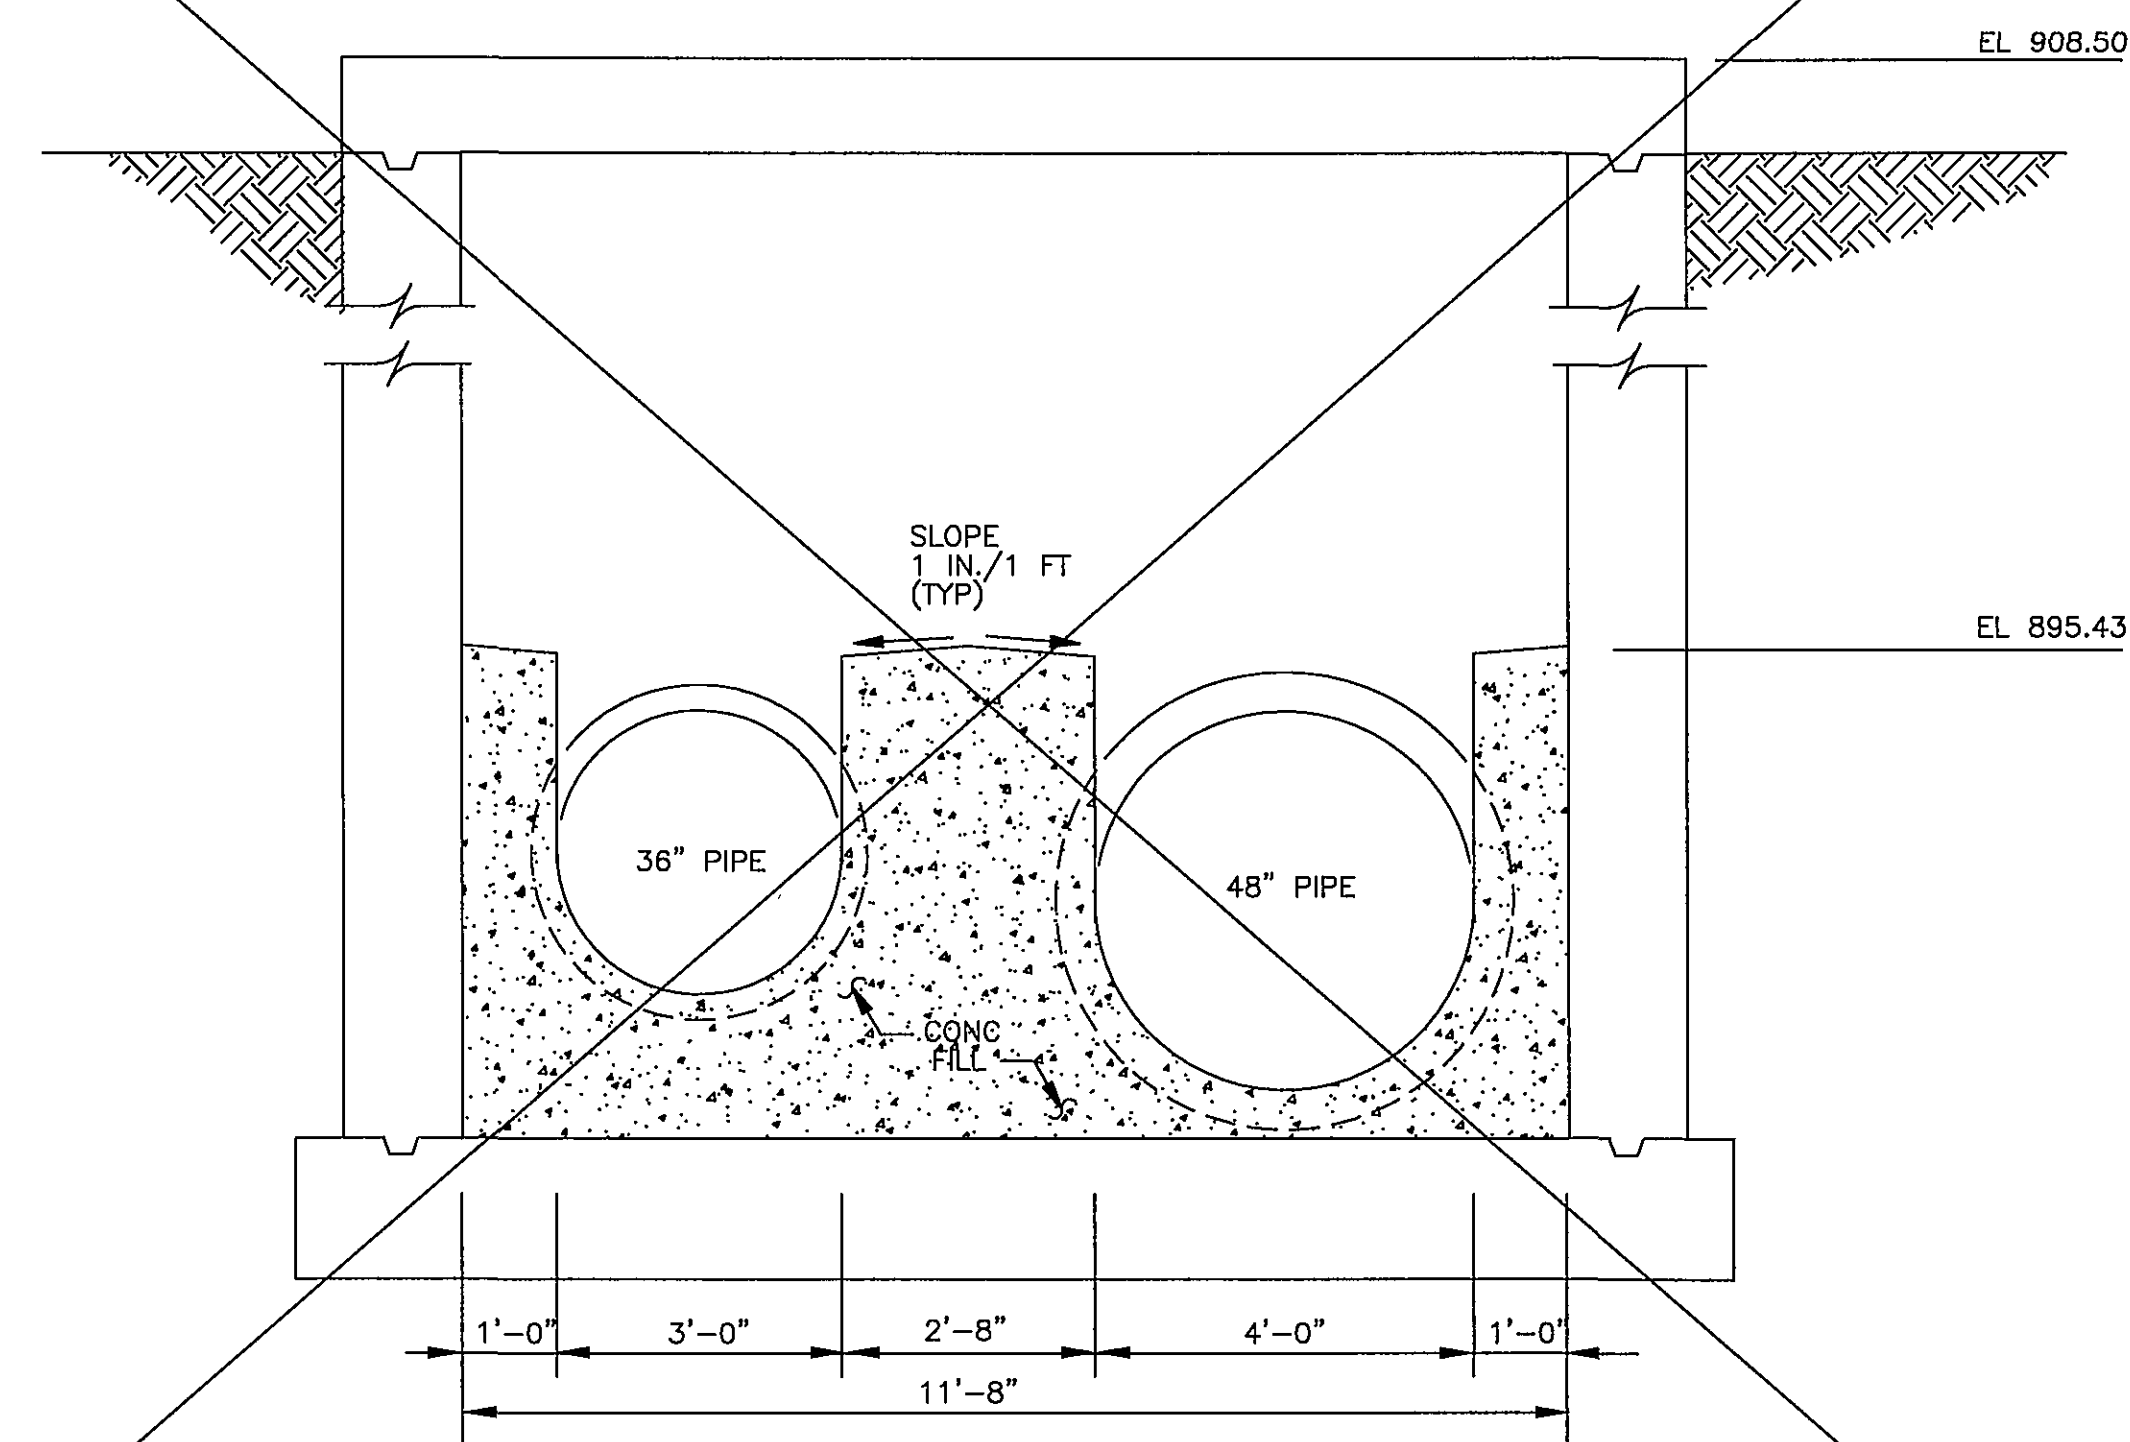

SECTION JB S41
SCALE: 1/2" = 1'-0"

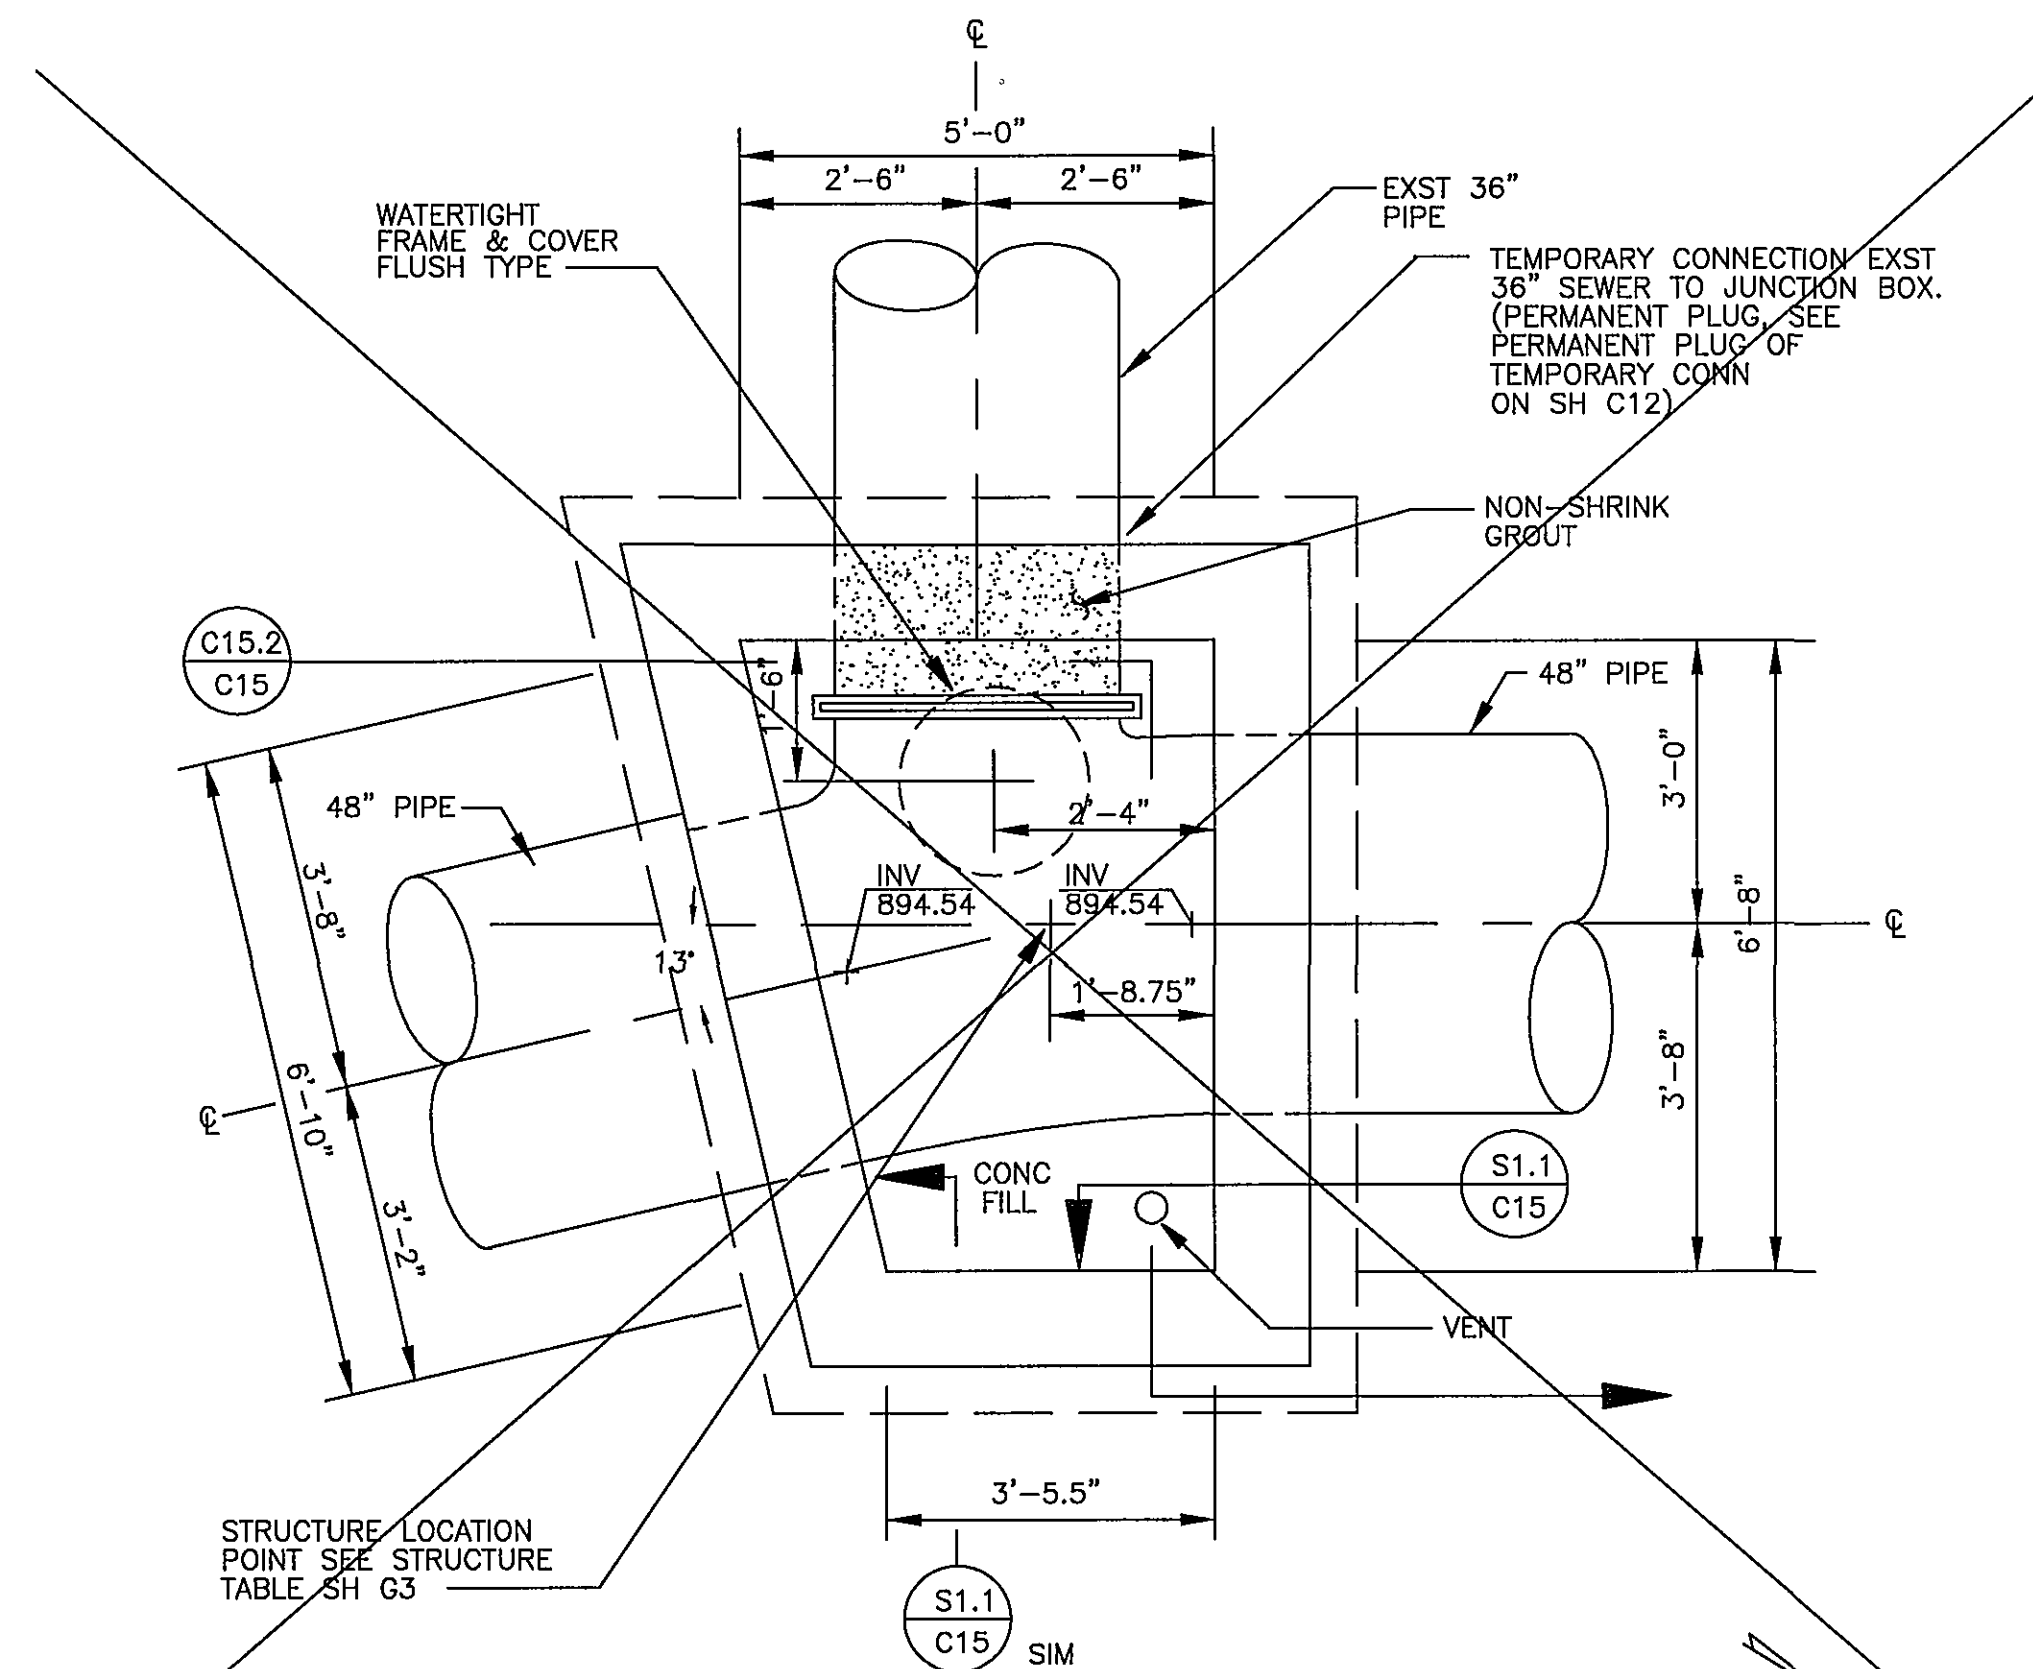

JUNCTION BOX S49
SCALE: 1/2" = 1'-0"
SEE SHEET G3

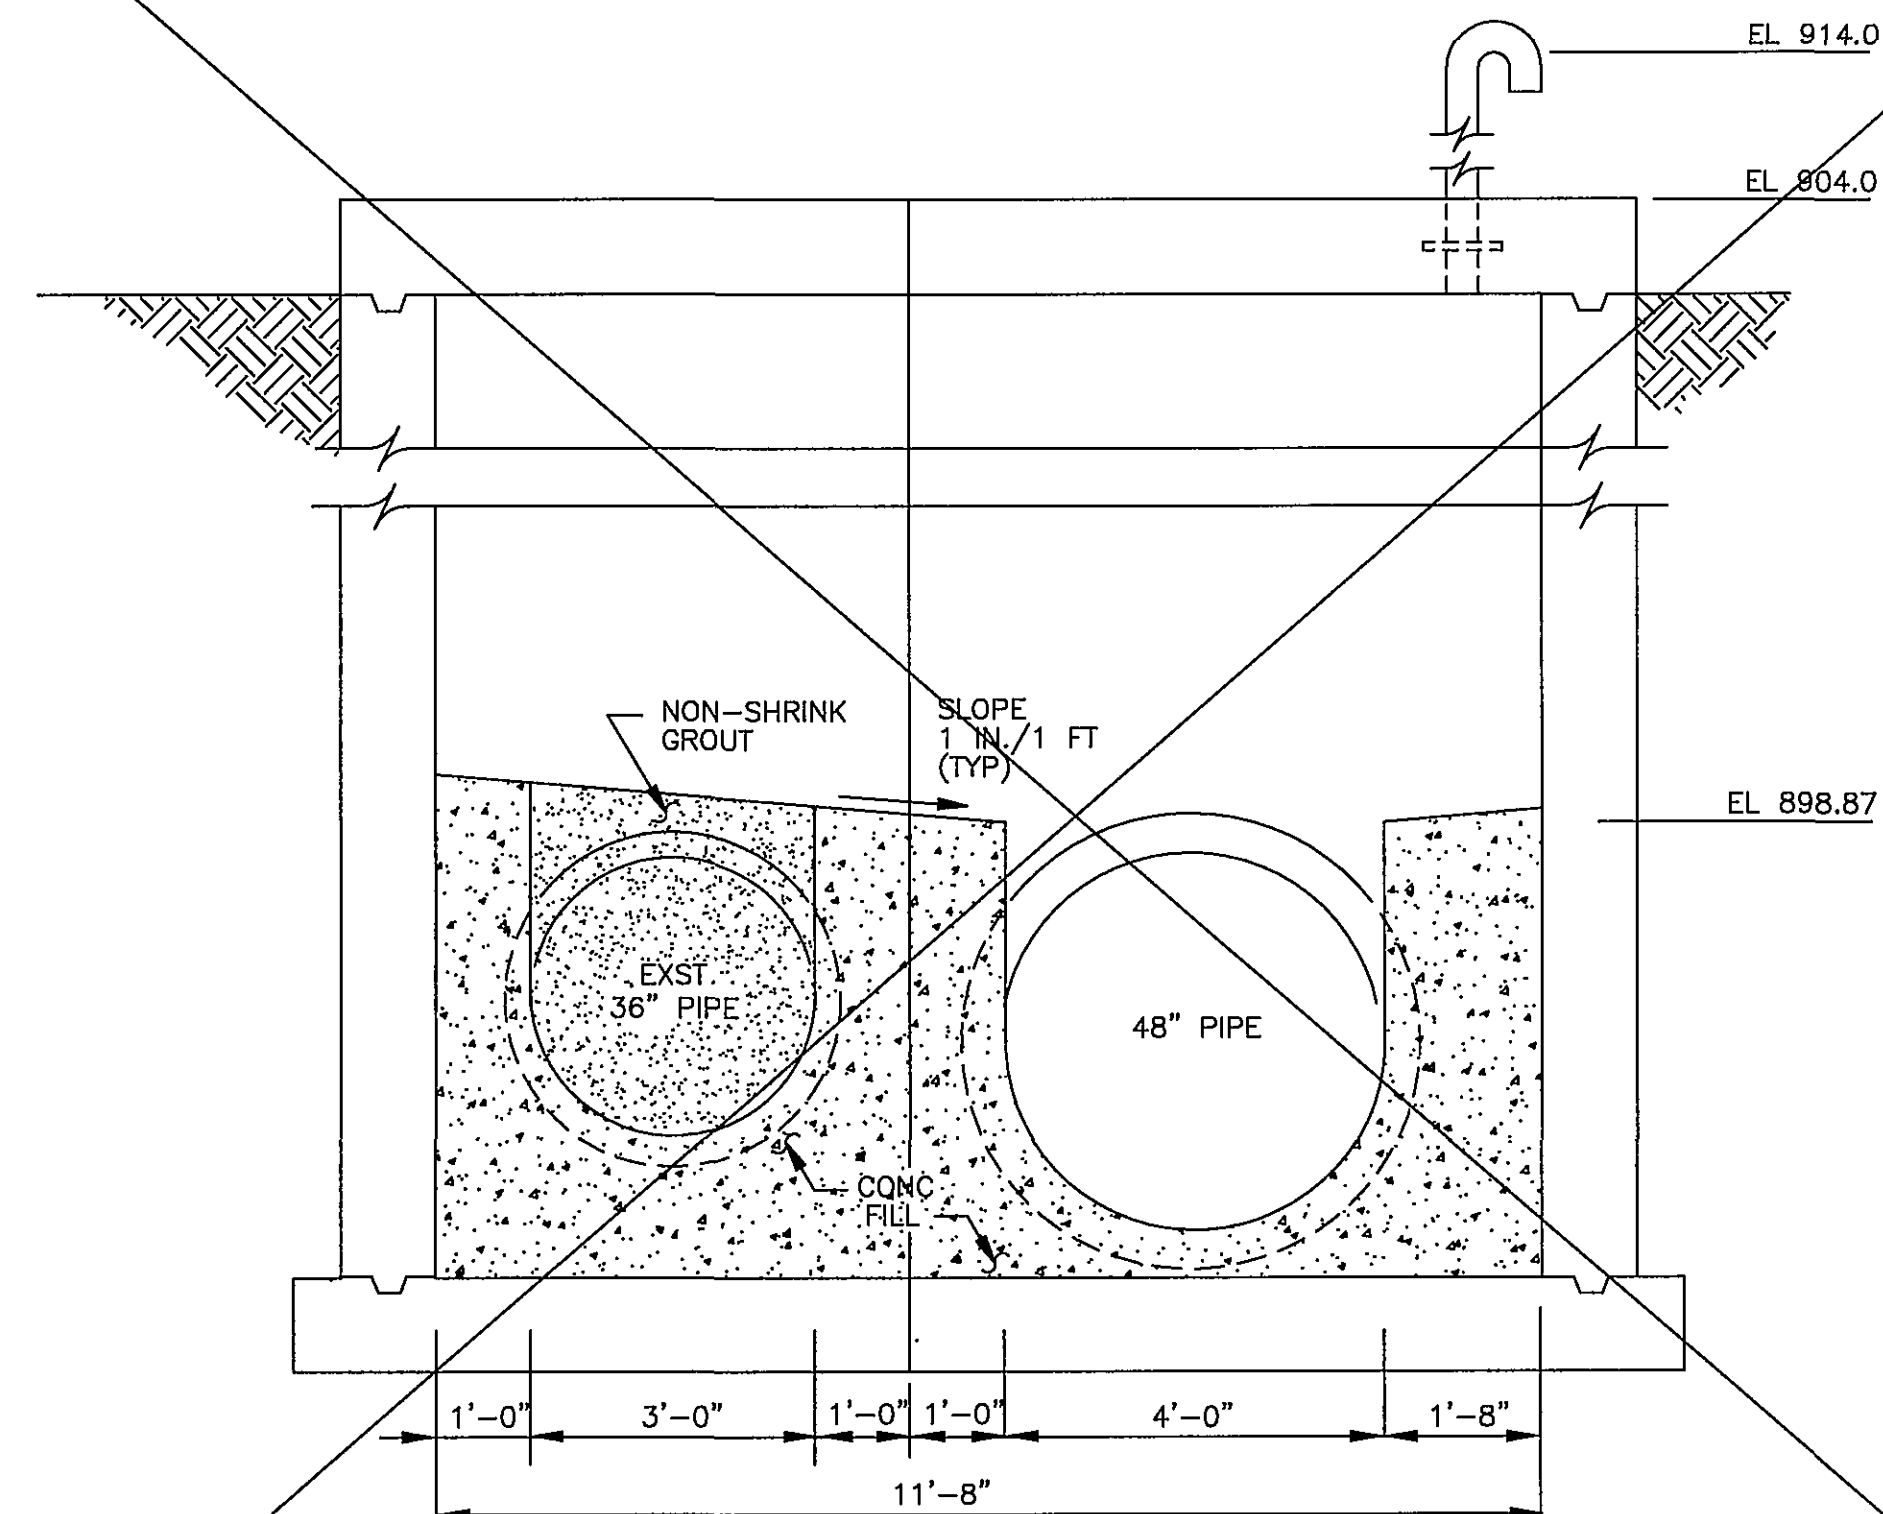

SECTION JB S49
SCALE: 1/2" = 1'-0"

NOTE:
CONCRETE FILL IS CLASS A CONCRETE. CONCRETE FILL MUST ATTAIN A COMPRESSIVE STRENGTH OF 3000 psi PRIOR TO DIVERTING FLOW THROUGH A STRUCTURE.

HAYES, SEAY, MATTERN & MATTERN, INC.
ARCHITECTS/ENGINEERS/PLANNERS
ROANOKE, VIRGINIA

DESIGNED: DMH
DRAWN: MHL
CHECKED:
APPROVED:

REVISIONS			
DATE	BY	DESCRIPTION	
10/15/98	MNH	RECORD DRAWINGS SEE SHEET G1 FOR NOTE	

GRAPHIC SCALE
1/2" = 1'-0"
12" 6" 0 1' 2' 3' 4' 5'

TINKER CREEK INTERCEPTOR SEWER
CITY OF ROANOKE, VIRGINIA

JUNCTION BOXES S41 & S49,
PLAN AND SECTION

COMM. NO.: 7211

SCALE: AS NOTED

DATE: MAY 17, 1996

PROJECT NO.: 6317
CONTRACT B
SHEET NO.
C15
RECORD DRAWINGS