


GRAPHIC SCALE

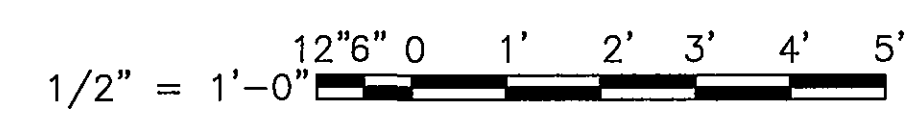

DESIGNED: DMH			REVISIONS
	DATE	BY	DESCRIPTION
	10/15/98	MNH	RECORD DRAWINGS SEE SHEET G1 FOR NOTE
DRAWN: MHL			
CHECKED:			
APPROVED:			

7211C16B C7211 21OCT98 REV. D ACAD MNH PLOT SCALE: 1=24 XREF: NONE