
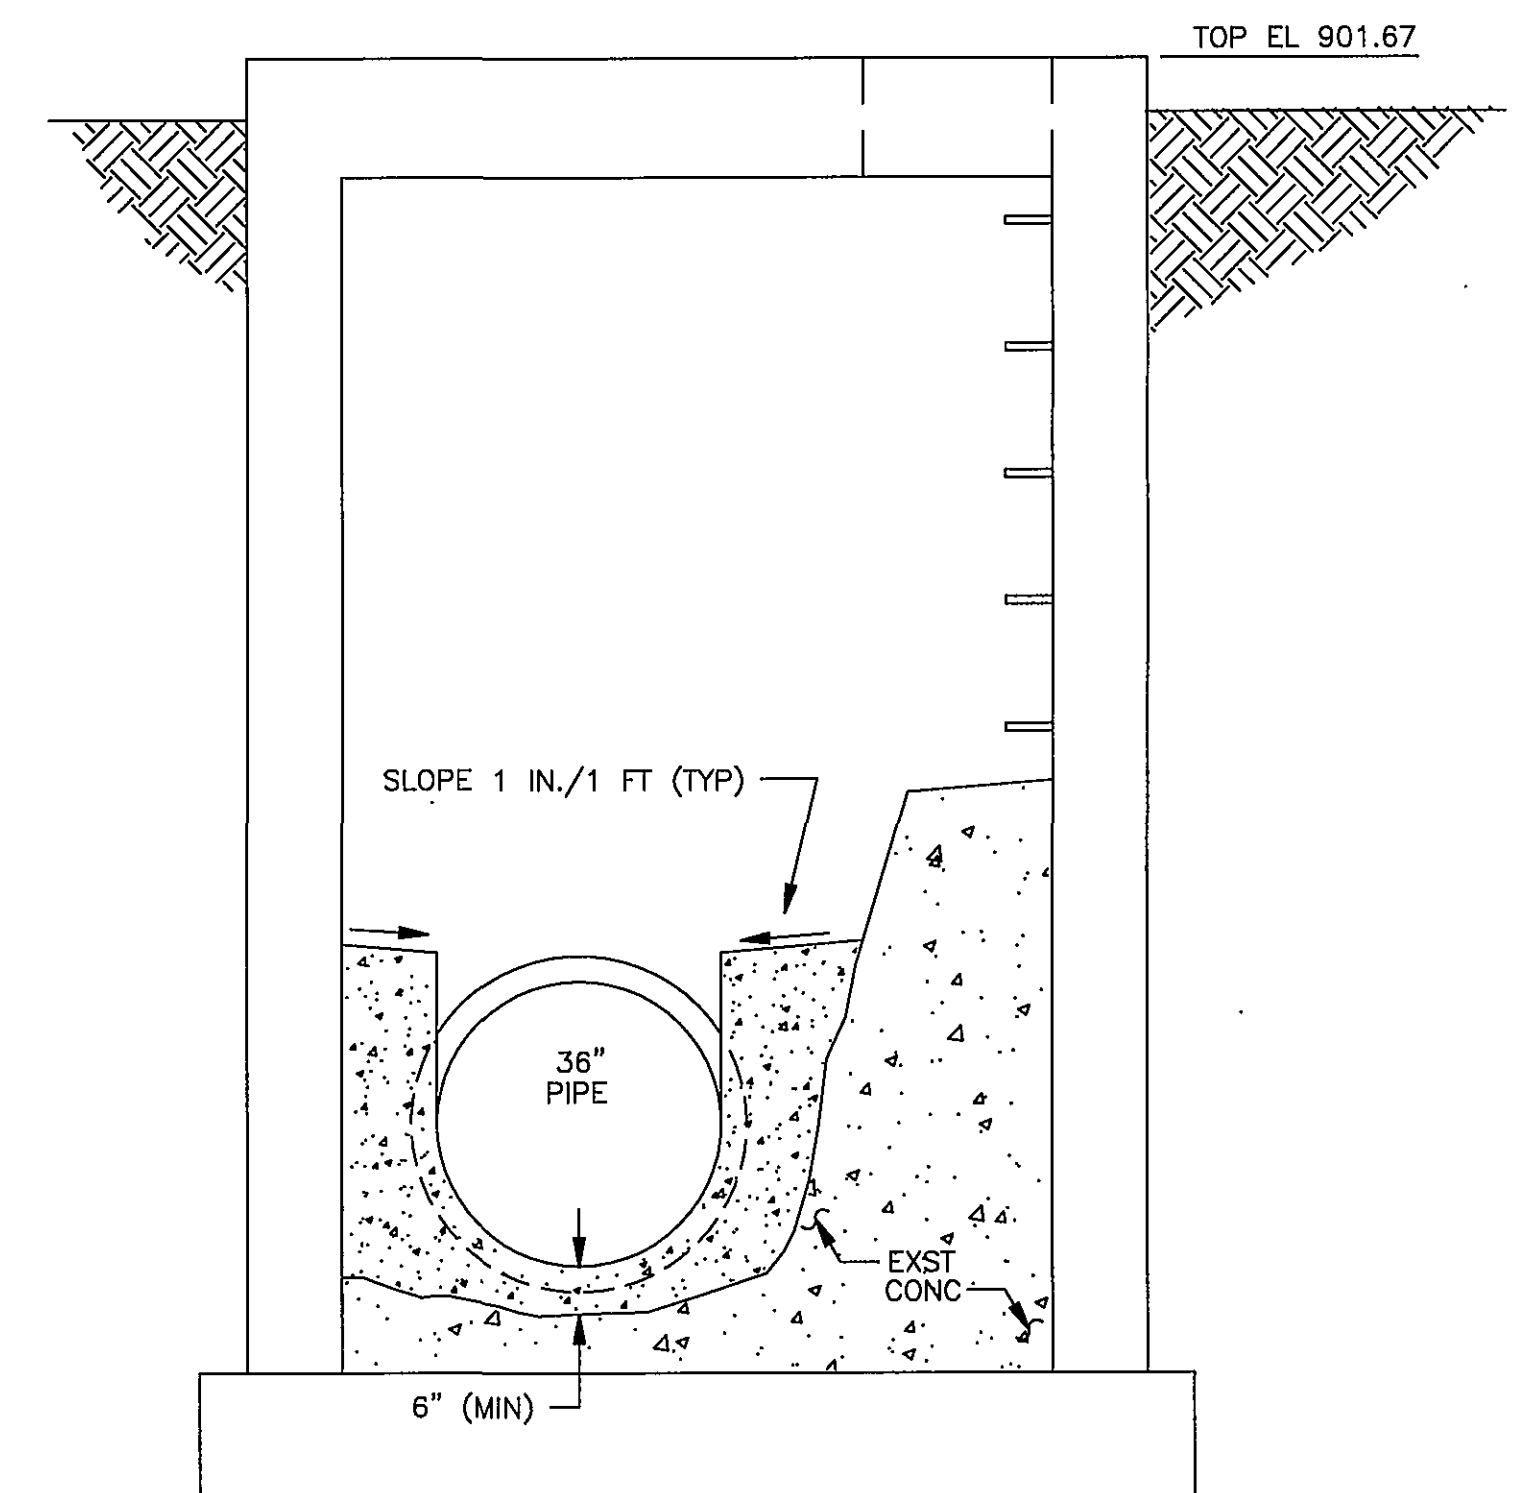


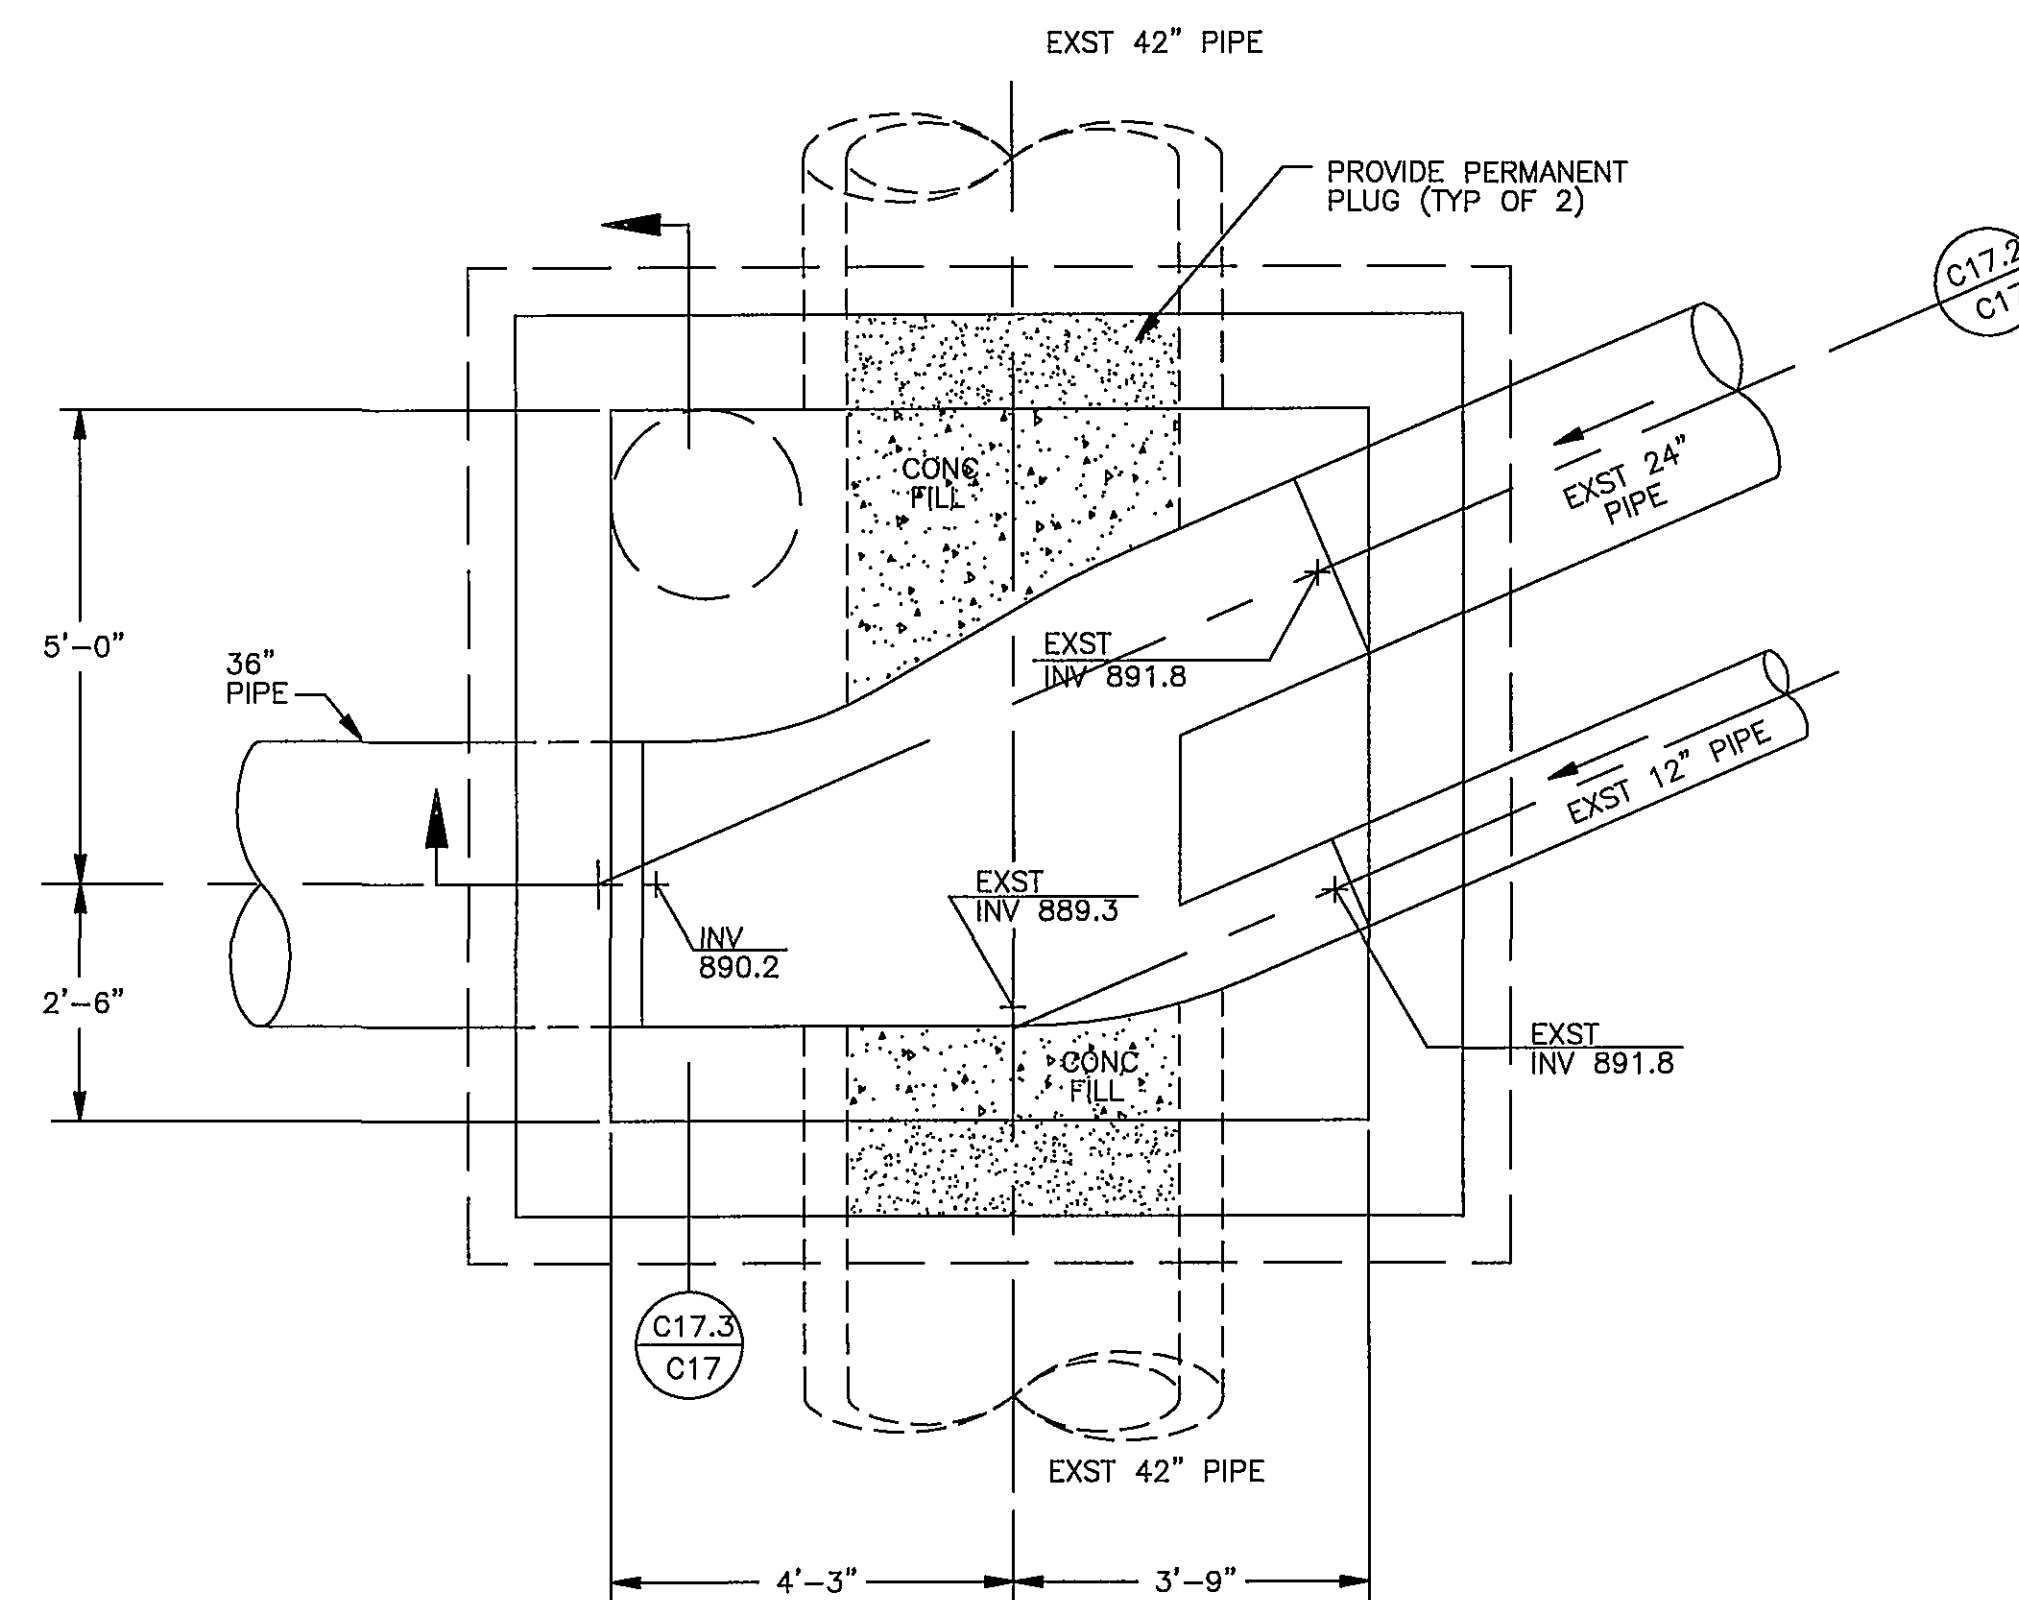


EXST JB S30-1

SECTION
EXST JB S30-1

SCALE: $1/2" = 1'-0"$

C17.3
C17

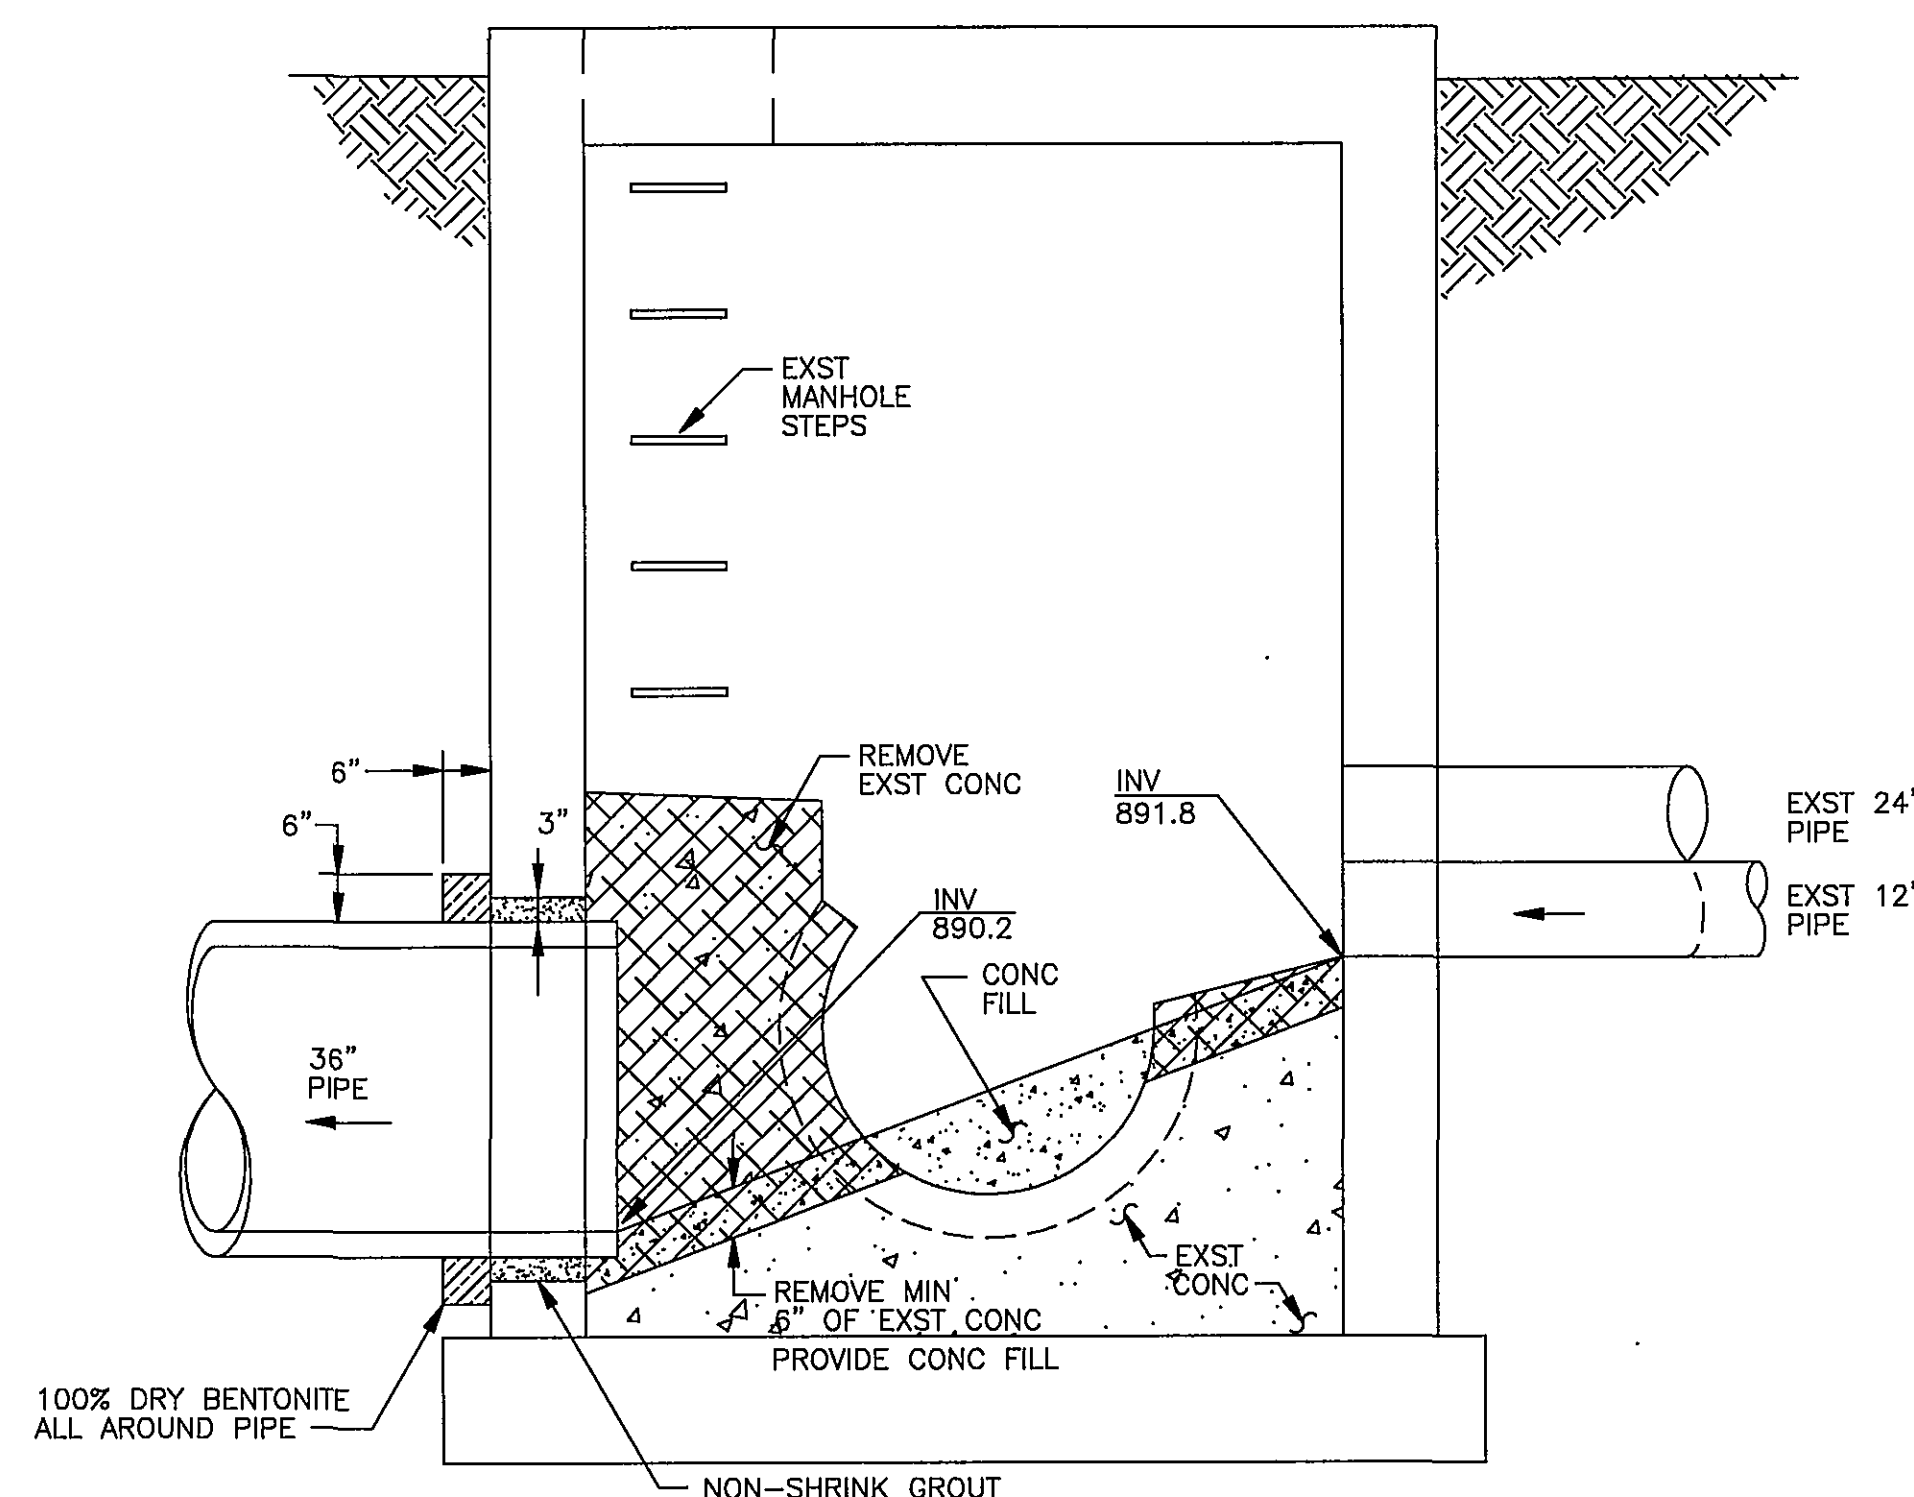

SECTION
EXST JB S30-1

NO SCALE

C17.2
C17

1. PROVIDE PROVISIONS TO MAINTAIN SEWAGE FLOWS.
2. CONNECT 36" PIPE TO EXST S30-1.
3. REMOVE INTERIOR CONC. AS REQUIRED, AND PROVIDE CONCRETE FILL TO SHAPE INVERT TO FLOW TO 36" PIPE.
4. PERMANENTLY PLUG EXISTING 2- 42" PIPES. SEE DETAIL ON SHEET C12.
5. REMOVE AND REPLACE TOP SLAB AS REQUIRED.

CONCRETE FILL IS CLASS A CONCRETE. CONCRETE FILL MUST ATTAIN A COMPRESSIVE STRENGTH OF 3000 psi PRIOR TO DIVERTING FLOW THROUGH A STRUCTURE.

1/2" = 1'-0"

DESIGNED: DMH	DATE	BY	REVISIONS
	10/15/98	MNH	DESCRIPTION
DRAWN: MHL			RECORD DRAWINGS SEE SHEET G1 FOR NOTE
CHECKED:			
APPROVED:			

TINKER CREEK INTERCEPTOR SEWER CITY OF ROANOKE, VIRGINIA		PROJECT NO.: 6317
JUNCTION BOX S57, PLAN AND SECTION; EXISTING JUNCTION BOX S30-1, PLAN AND SECTION		CONTRACT B <u>SHEET NO.</u> C17
COMM. NO.: 7211	SCALE: AS NOTED	DATE: MAY 17, 1996 RECORD DRAWINGS