


MARK SINK'S COPY



AS BUILTS
WEDGEWOOD #3

SEWER LINE - - -
6" WATER LINE ~~-----~~
3" WATER LINE m m m

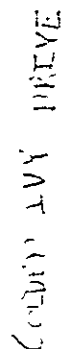