



Contractors
AS-Built
6-11-14
M. L. L.

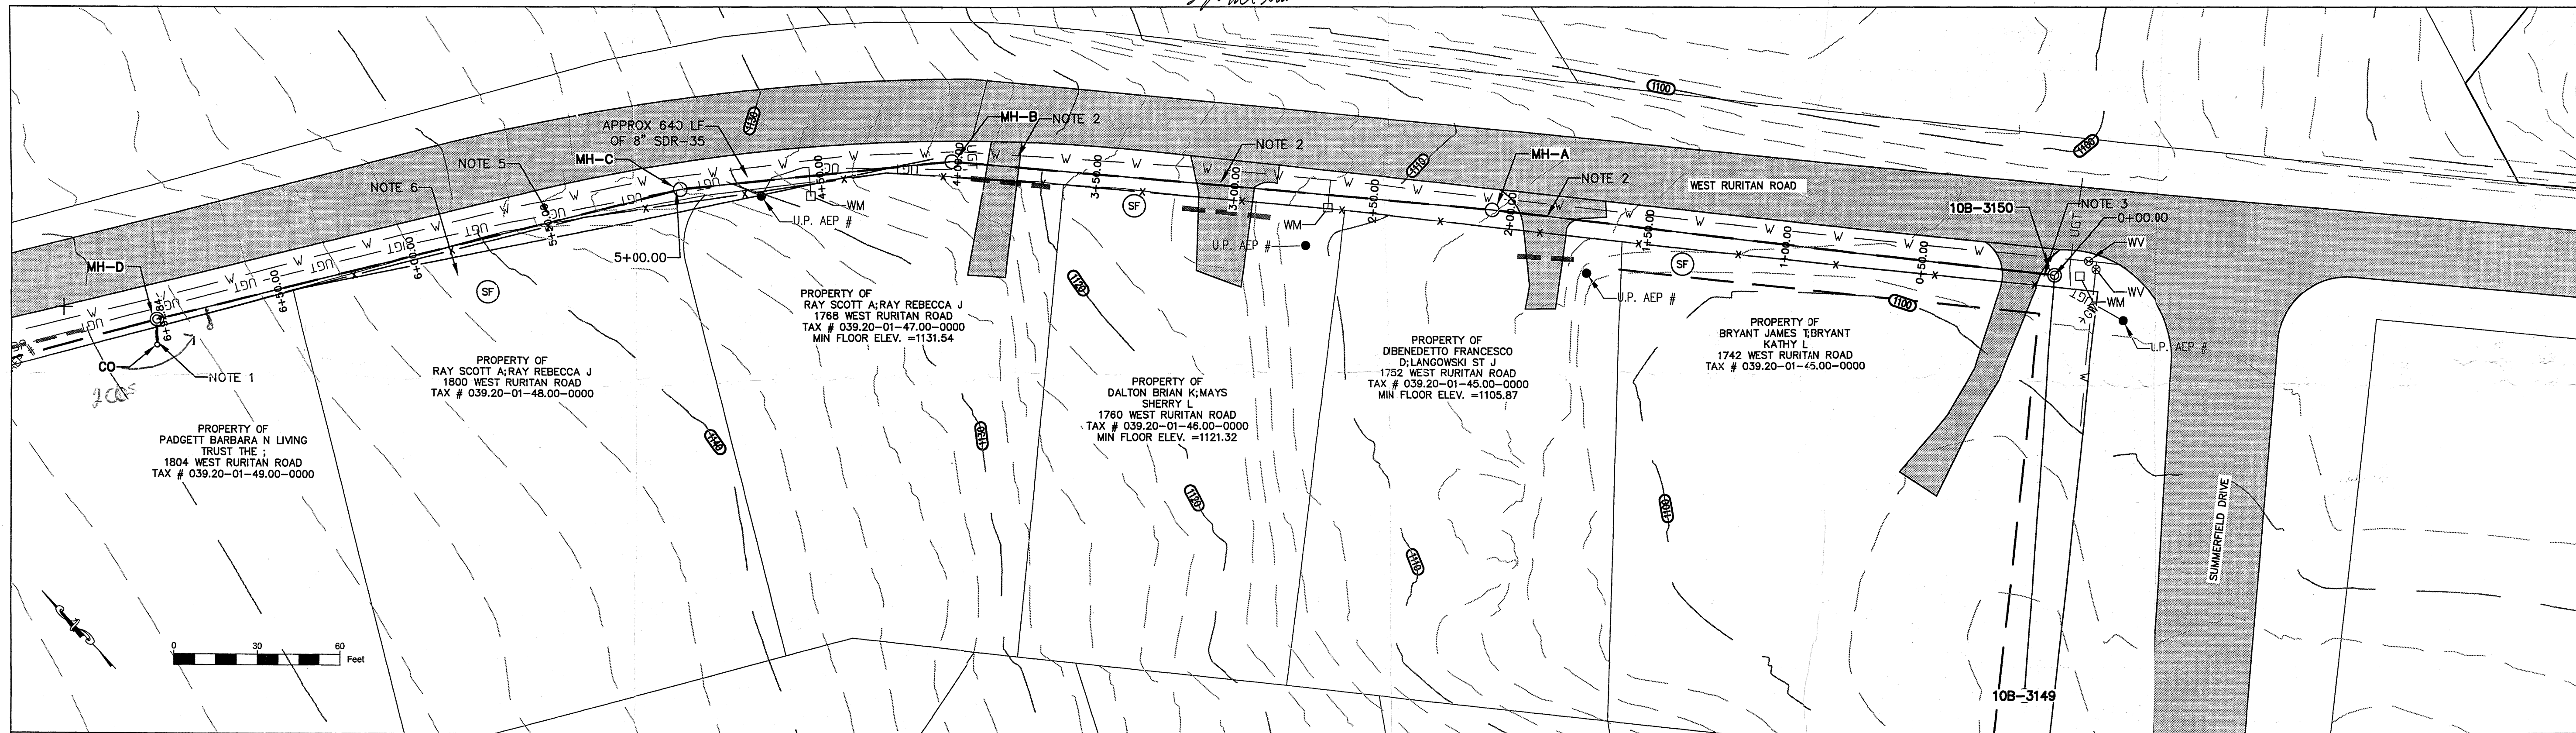

WESTERN VIRGINIA
WATER AUTHORITY
ENGINEERING SERVICES
601 S JEFFERSON ST, SUITE 300
ROANOKE, VA 24011
540-853-5641 or 540-853-5770

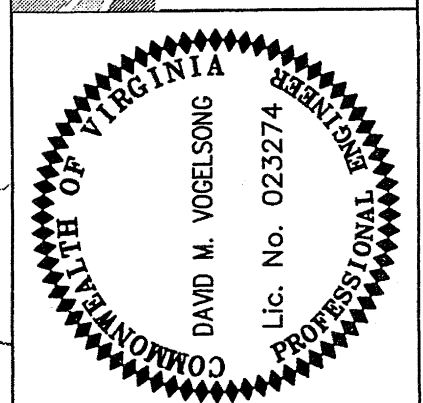

WEST RURITAN SEWER

PLAN & PROFILE

Rev	Description	Date	By
1	DESIGNED BY: AAS	5-12-14	
2	DRAWN BY: AAS	5-13-14	
3	CHECKED BY: DMV		
4	APPROVED BY:		
5	DATE: 4-16-14		
6	PROJECT:		

Designed: AAS
Drawn: AAS
Checked: DMV
Approved:
Date: 4-16-14
Project:

1
Sheet 1 of 1

CONSTRUCTION NOTES

- CONTRACTOR SHALL COORDINATE CLEANOUT LOCATION WITH OWNER'S CONTRACTOR. FINAL INVERT ELEVATION AT PROPERTY LINE MUST BE DETERMINED BY OWNER'S CONTRACTOR. MINIMUM GRADE ON SEWER LATERAL SHALL BE A MINIMUM OF 2%.
- ALL DRIVEWAYS, CULVERTS & MAILBOXES MUST BE RESTORED TO EXISTING CONDITIONS AFTER SEWER LINE INSTALLATION IS COMPLETED. ANY CHANGES TO EXISTING CONDITIONS MUST BE APPROVED BY VDOT AND WWA.
- CONTRACTOR SHALL EXCAVATE EXISTING STUB OUT AT EXISTING MANHOLE 10B-3150. CONTRACTOR TO MAKE CONNECTION TO EXISTING STUB OUT. WWA INSPECTOR MUST VERIFY CONNECTION PRIOR TO BACK FILL.
- ALL UTILITY CROSSINGS MUST MAINTAIN 18" OF VERTICAL CLEARANCE OR ADDITIONAL MEASURES MUST BE TAKEN.
- CONTRACTOR MAY NEED TO ADJUST 600 PAIR COPPER COMMUNICATION LINE AS NEEDED WHEN IN CONFLICT.
- EROSION & SEDIMENT CONTROL MEASURES SHALL BE INSTALLED AS NECESSARY IN ACCORDANCE WITH THE VIRGINIA EROSION AND SEDIMENT CONTROL HANDBOOK, LATEST EDITION. ALL EXISTING AREAS CONTAINING VEGETATIVE COVER SUBJECT TO DISTURBANCE DURING CONSTRUCTION SHALL BE REESTABLISHED AND STABILIZED WITH PERMANENT SEEDING AND MULCHING IN ACCORDANCE WITH THE VIRGINIA EROSION & SEDIMENT CONTROL HANDBOOK, LATEST EDITION.
- TRAFFIC CONTROL SHALL BE MAINTAINED AT ALL TIMES WITH ANY TEMPORARY CLOSURES COORDINATED VDOT, ROANOKE COUNTY, EMERGENCY SERVICES AND ANY AFFECTED PROPERTY OWNERS.

