
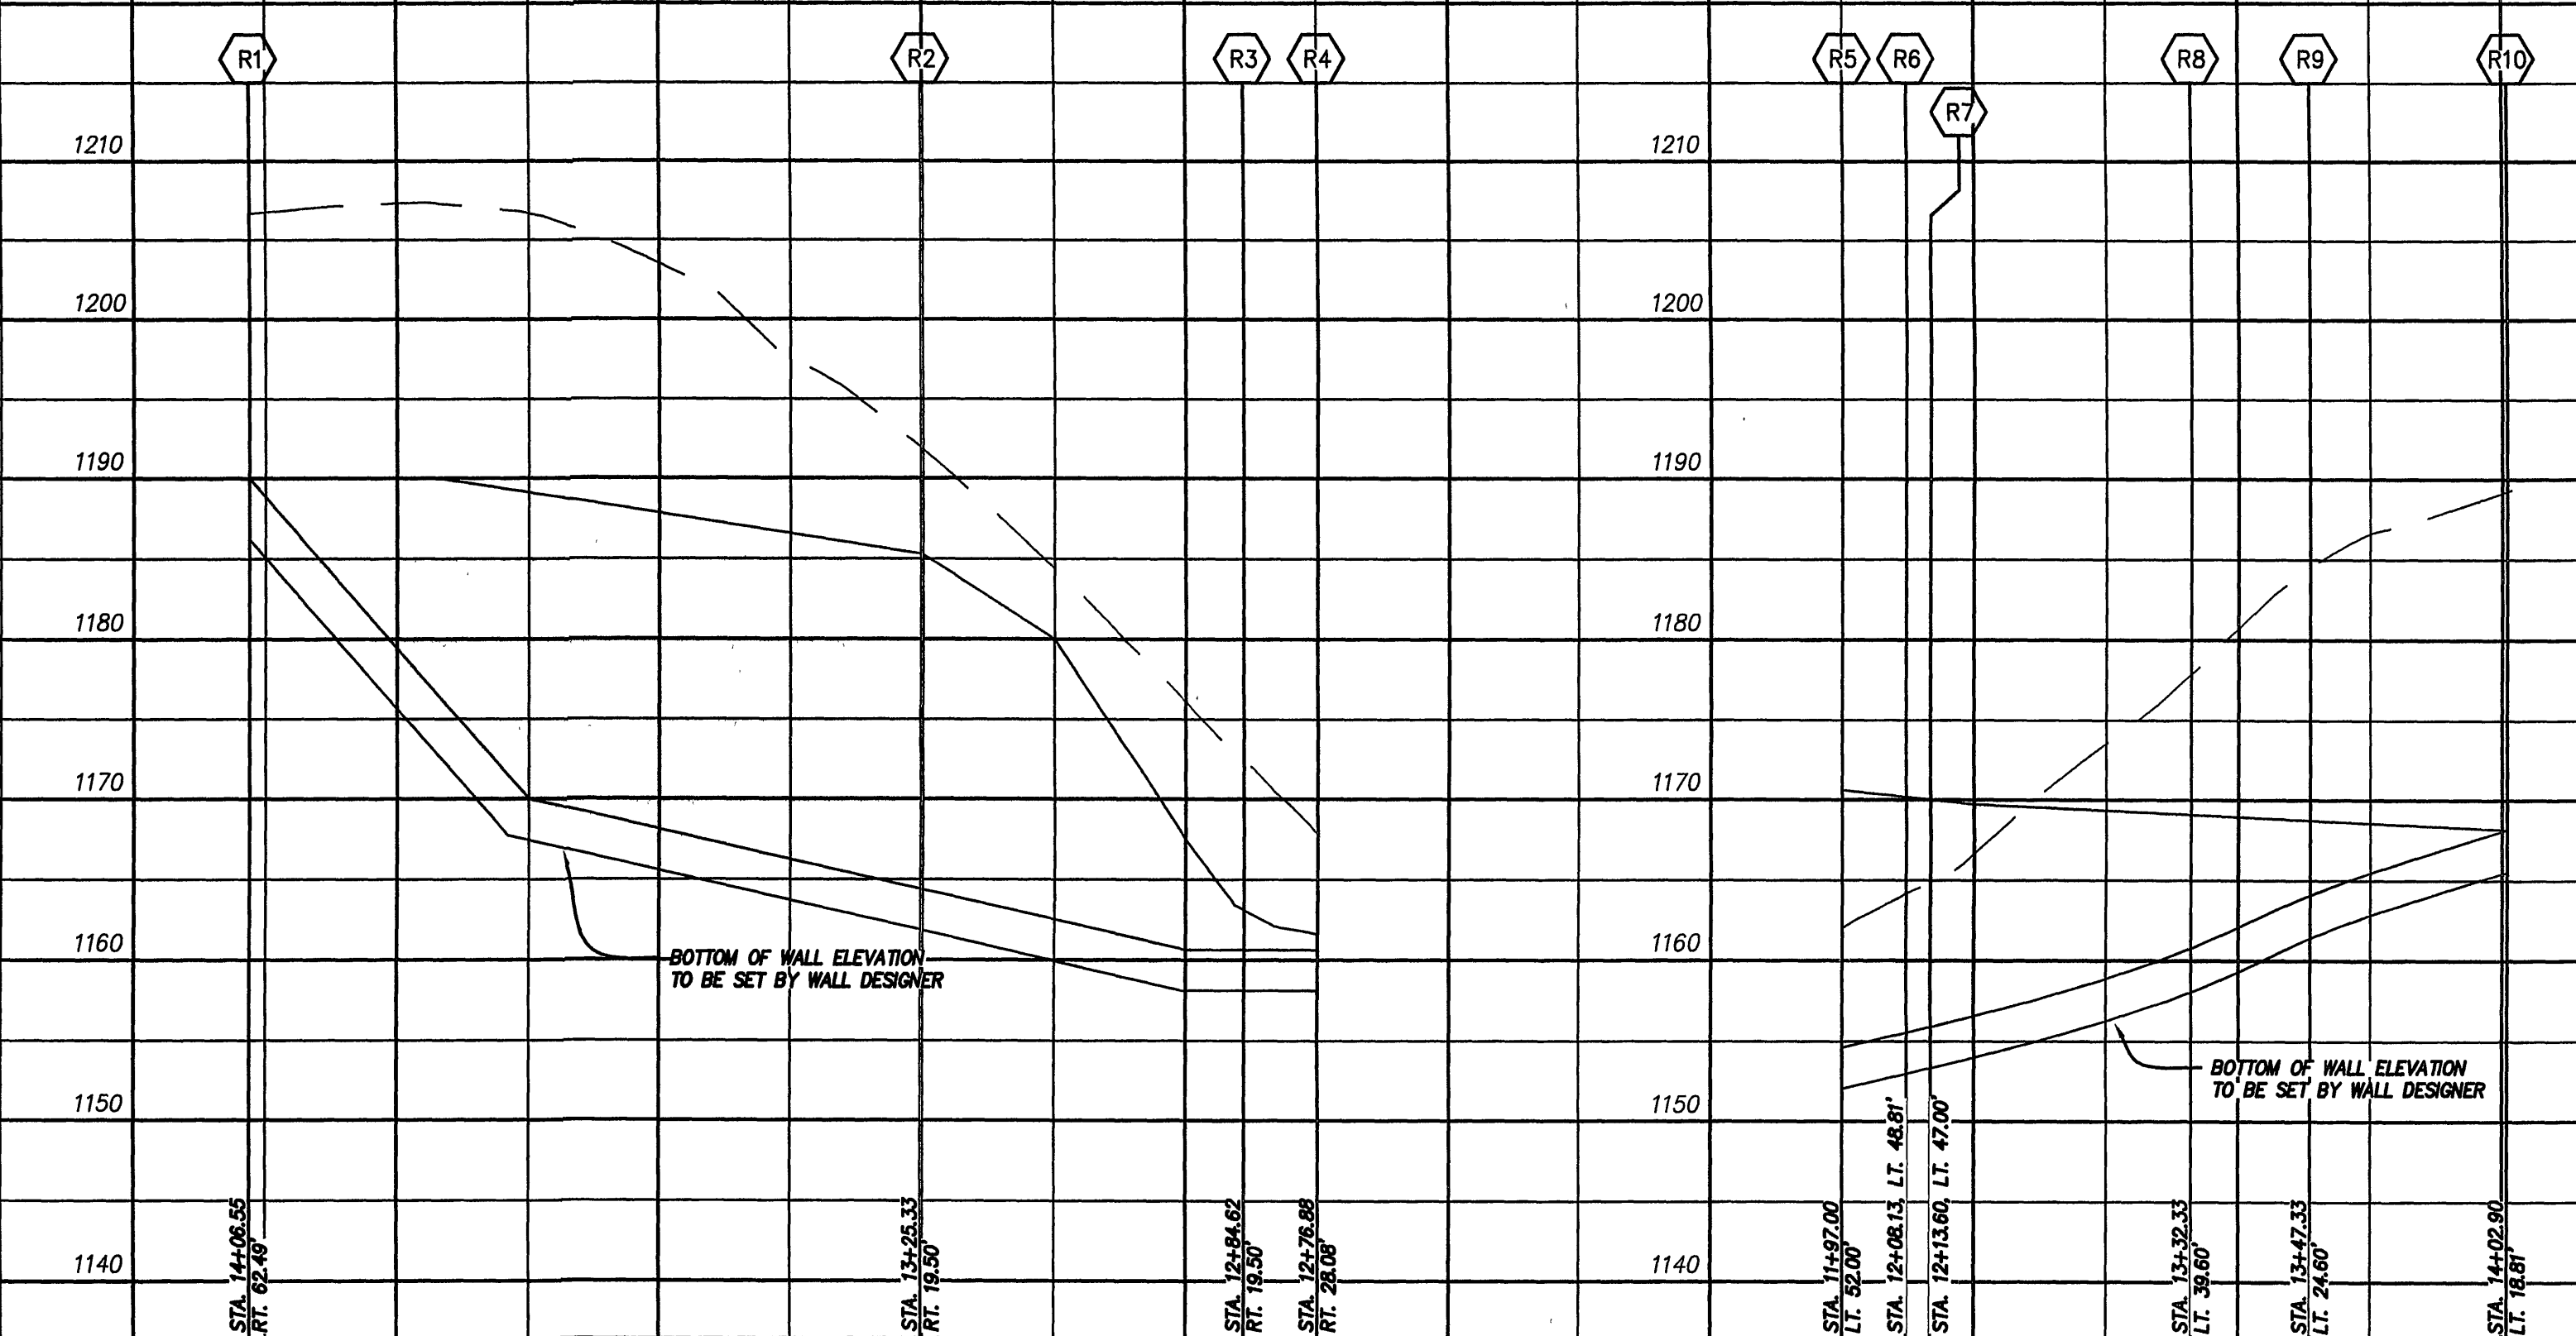
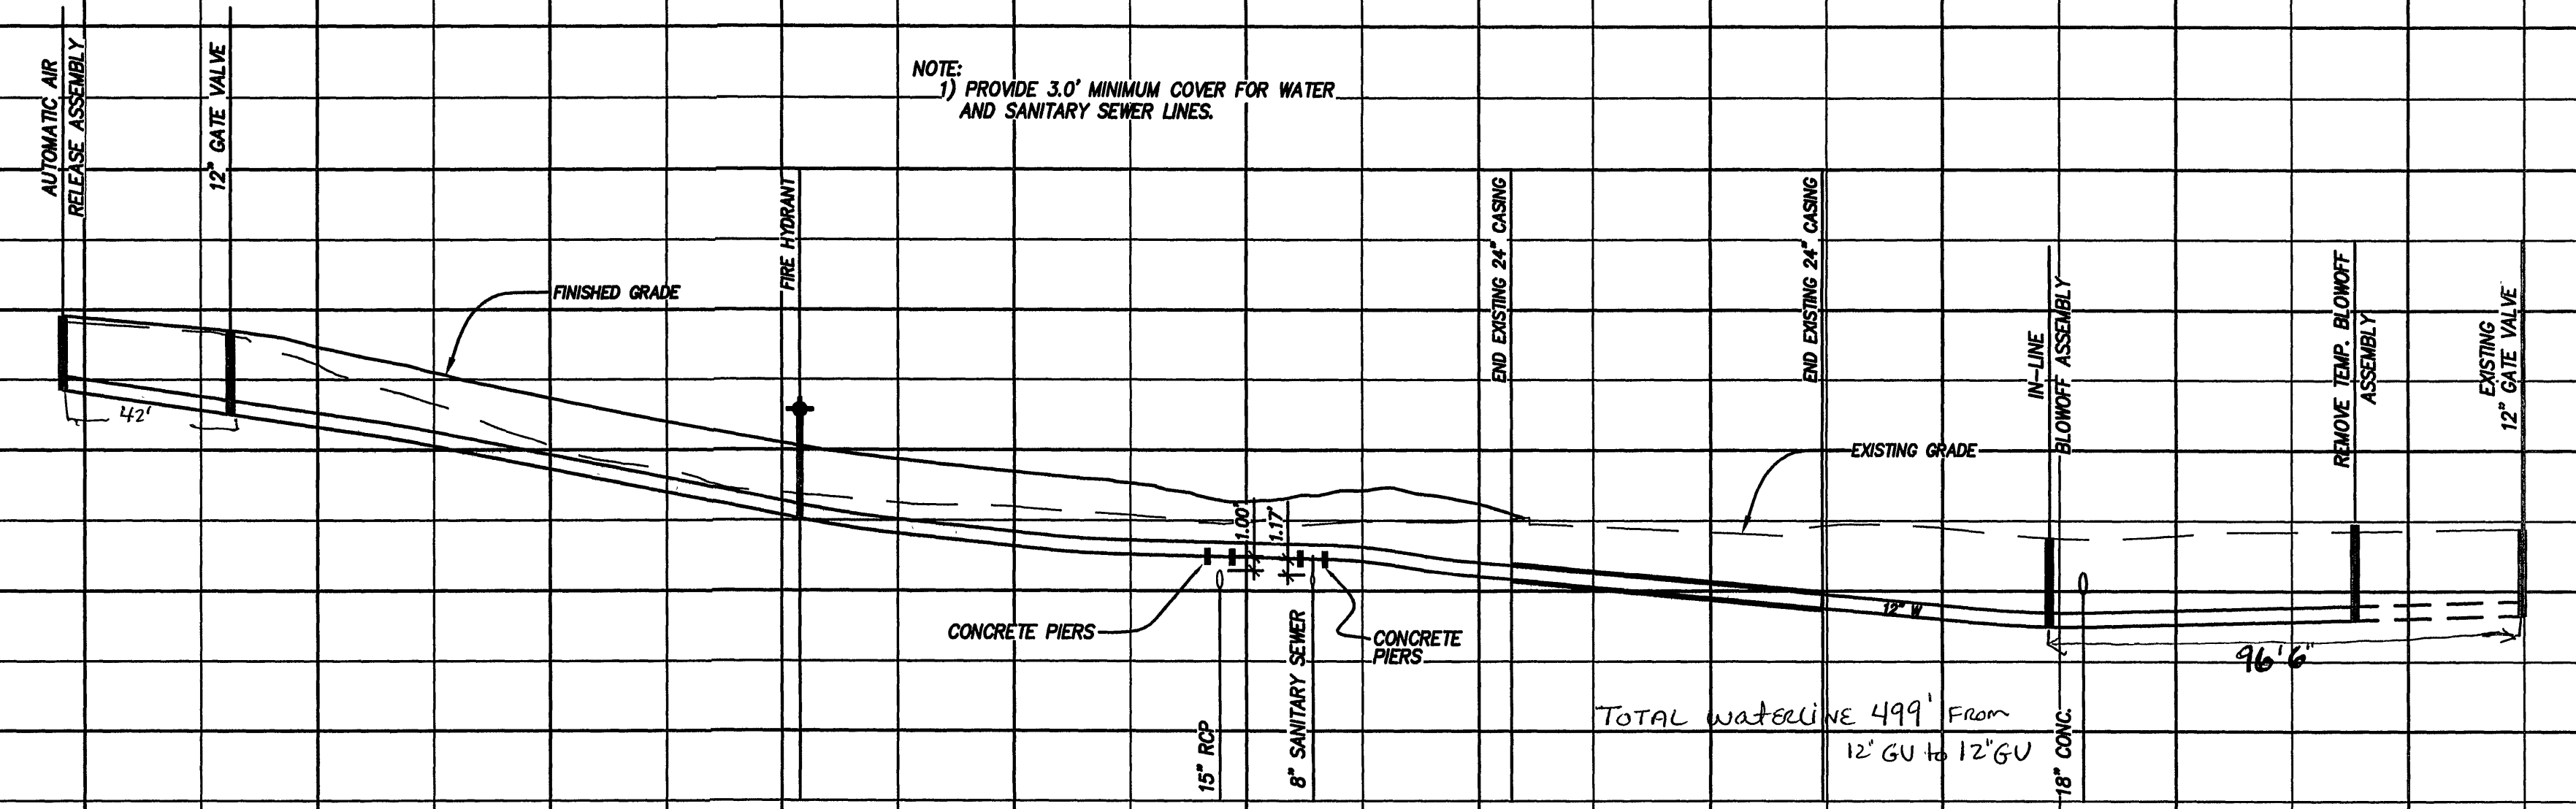


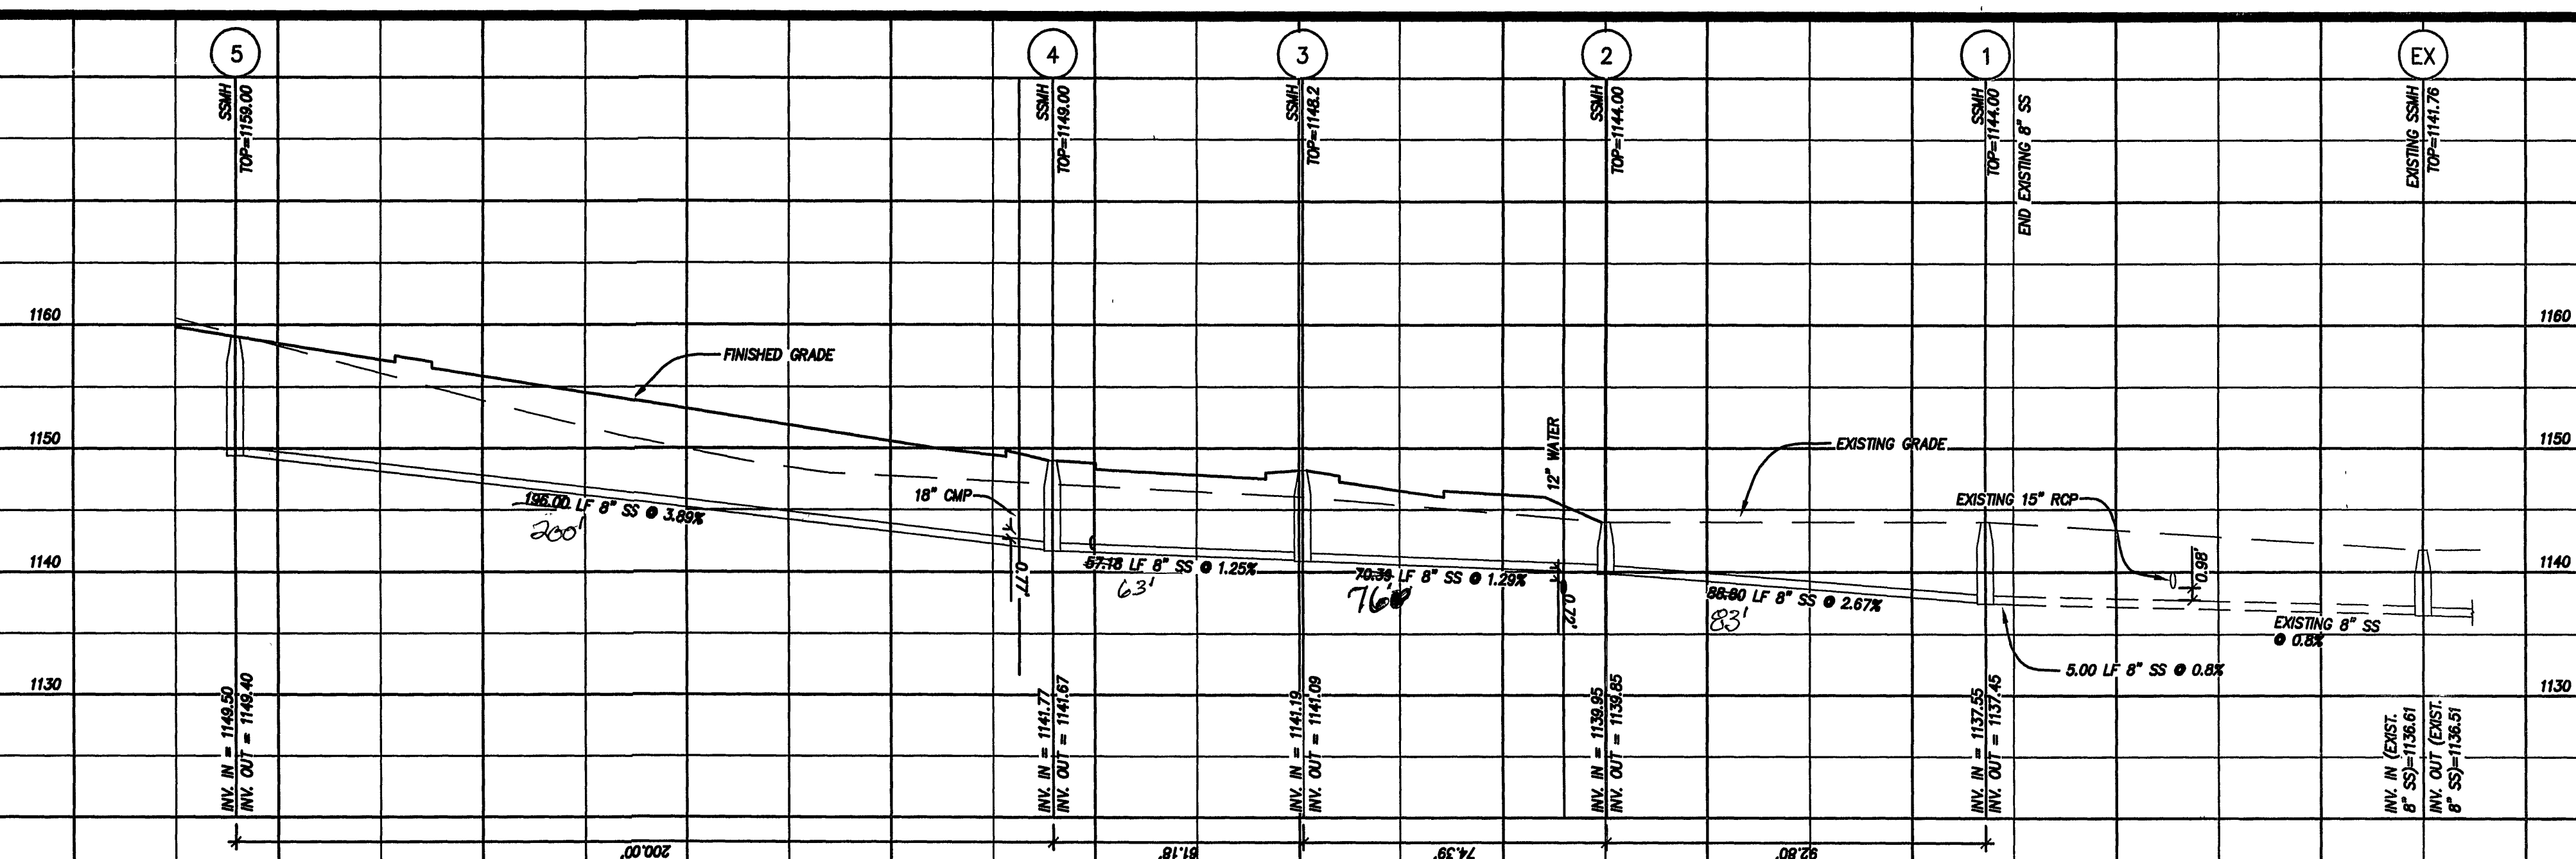

NOTE:
1) PROVIDE 3.0' MINIMUM COVER FOR WATER
AND SANITARY SEWER LINES.

NOTE:
WALL DESIGNER SHALL PROVIDE TO THE OWNER DESIGN DRAWINGS
FOR THE RETAINING WALLS. SUCH DRAWINGS TO INCLUDE TYPE
AND STYLE. DRAWINGS SHALL BE SIGNED AND SEALED BY A
REGISTERED PROFESSIONAL ENGINEER IN THE STATE OF VIRGINIA.
WALL DETAILS AND PROFILES SHOWN IN THESE PLANS ARE FOR
SCHEMATIC DETAIL ONLY.

WEST VILLAGE
PREPARED FOR
WEST VILLAGE, L.L.C.
CAVE SPRING MAGISTERIAL DISTRICT
ROANOKE COUNTY, VIRGINIA

AS-BUILTS
5/4/2006

WVWA ID# 6PFNNM

NO.	DATE	DESCRIPTION
1	10/04/2006	REVISED SANITARY SEWER, STA. 2 THRU 5
2		
3		
4		
5		

DATE: OCTOBER 11, 2004

SCALE:
1"=30'(H), 1"=10'(V)

COMMISSION NO: 03-342

FILE: F:\0303\03342\ENG\03342COMP.DWG

SHEET 7 OF 12

PROFILES

LUMSDEN ASSOCIATES, P.C.
ENGINEERS-SURVEYORS-PLANNERS
ROANOKE, VIRGINIA

4664 BRAMBLETON AVENUE
P.O. BOX 20669
ROANOKE, VIRGINIA 24018

PHONE: (540) 774-4411
FAX: (540) 772-9445
EMAIL: MAIL@LUMSDENPC.COM

COMMONWEALTH OF VIRGINIA
THOMAS C. DALE
No. 033002
10/1/05
PROFESSIONAL ENGINEER