


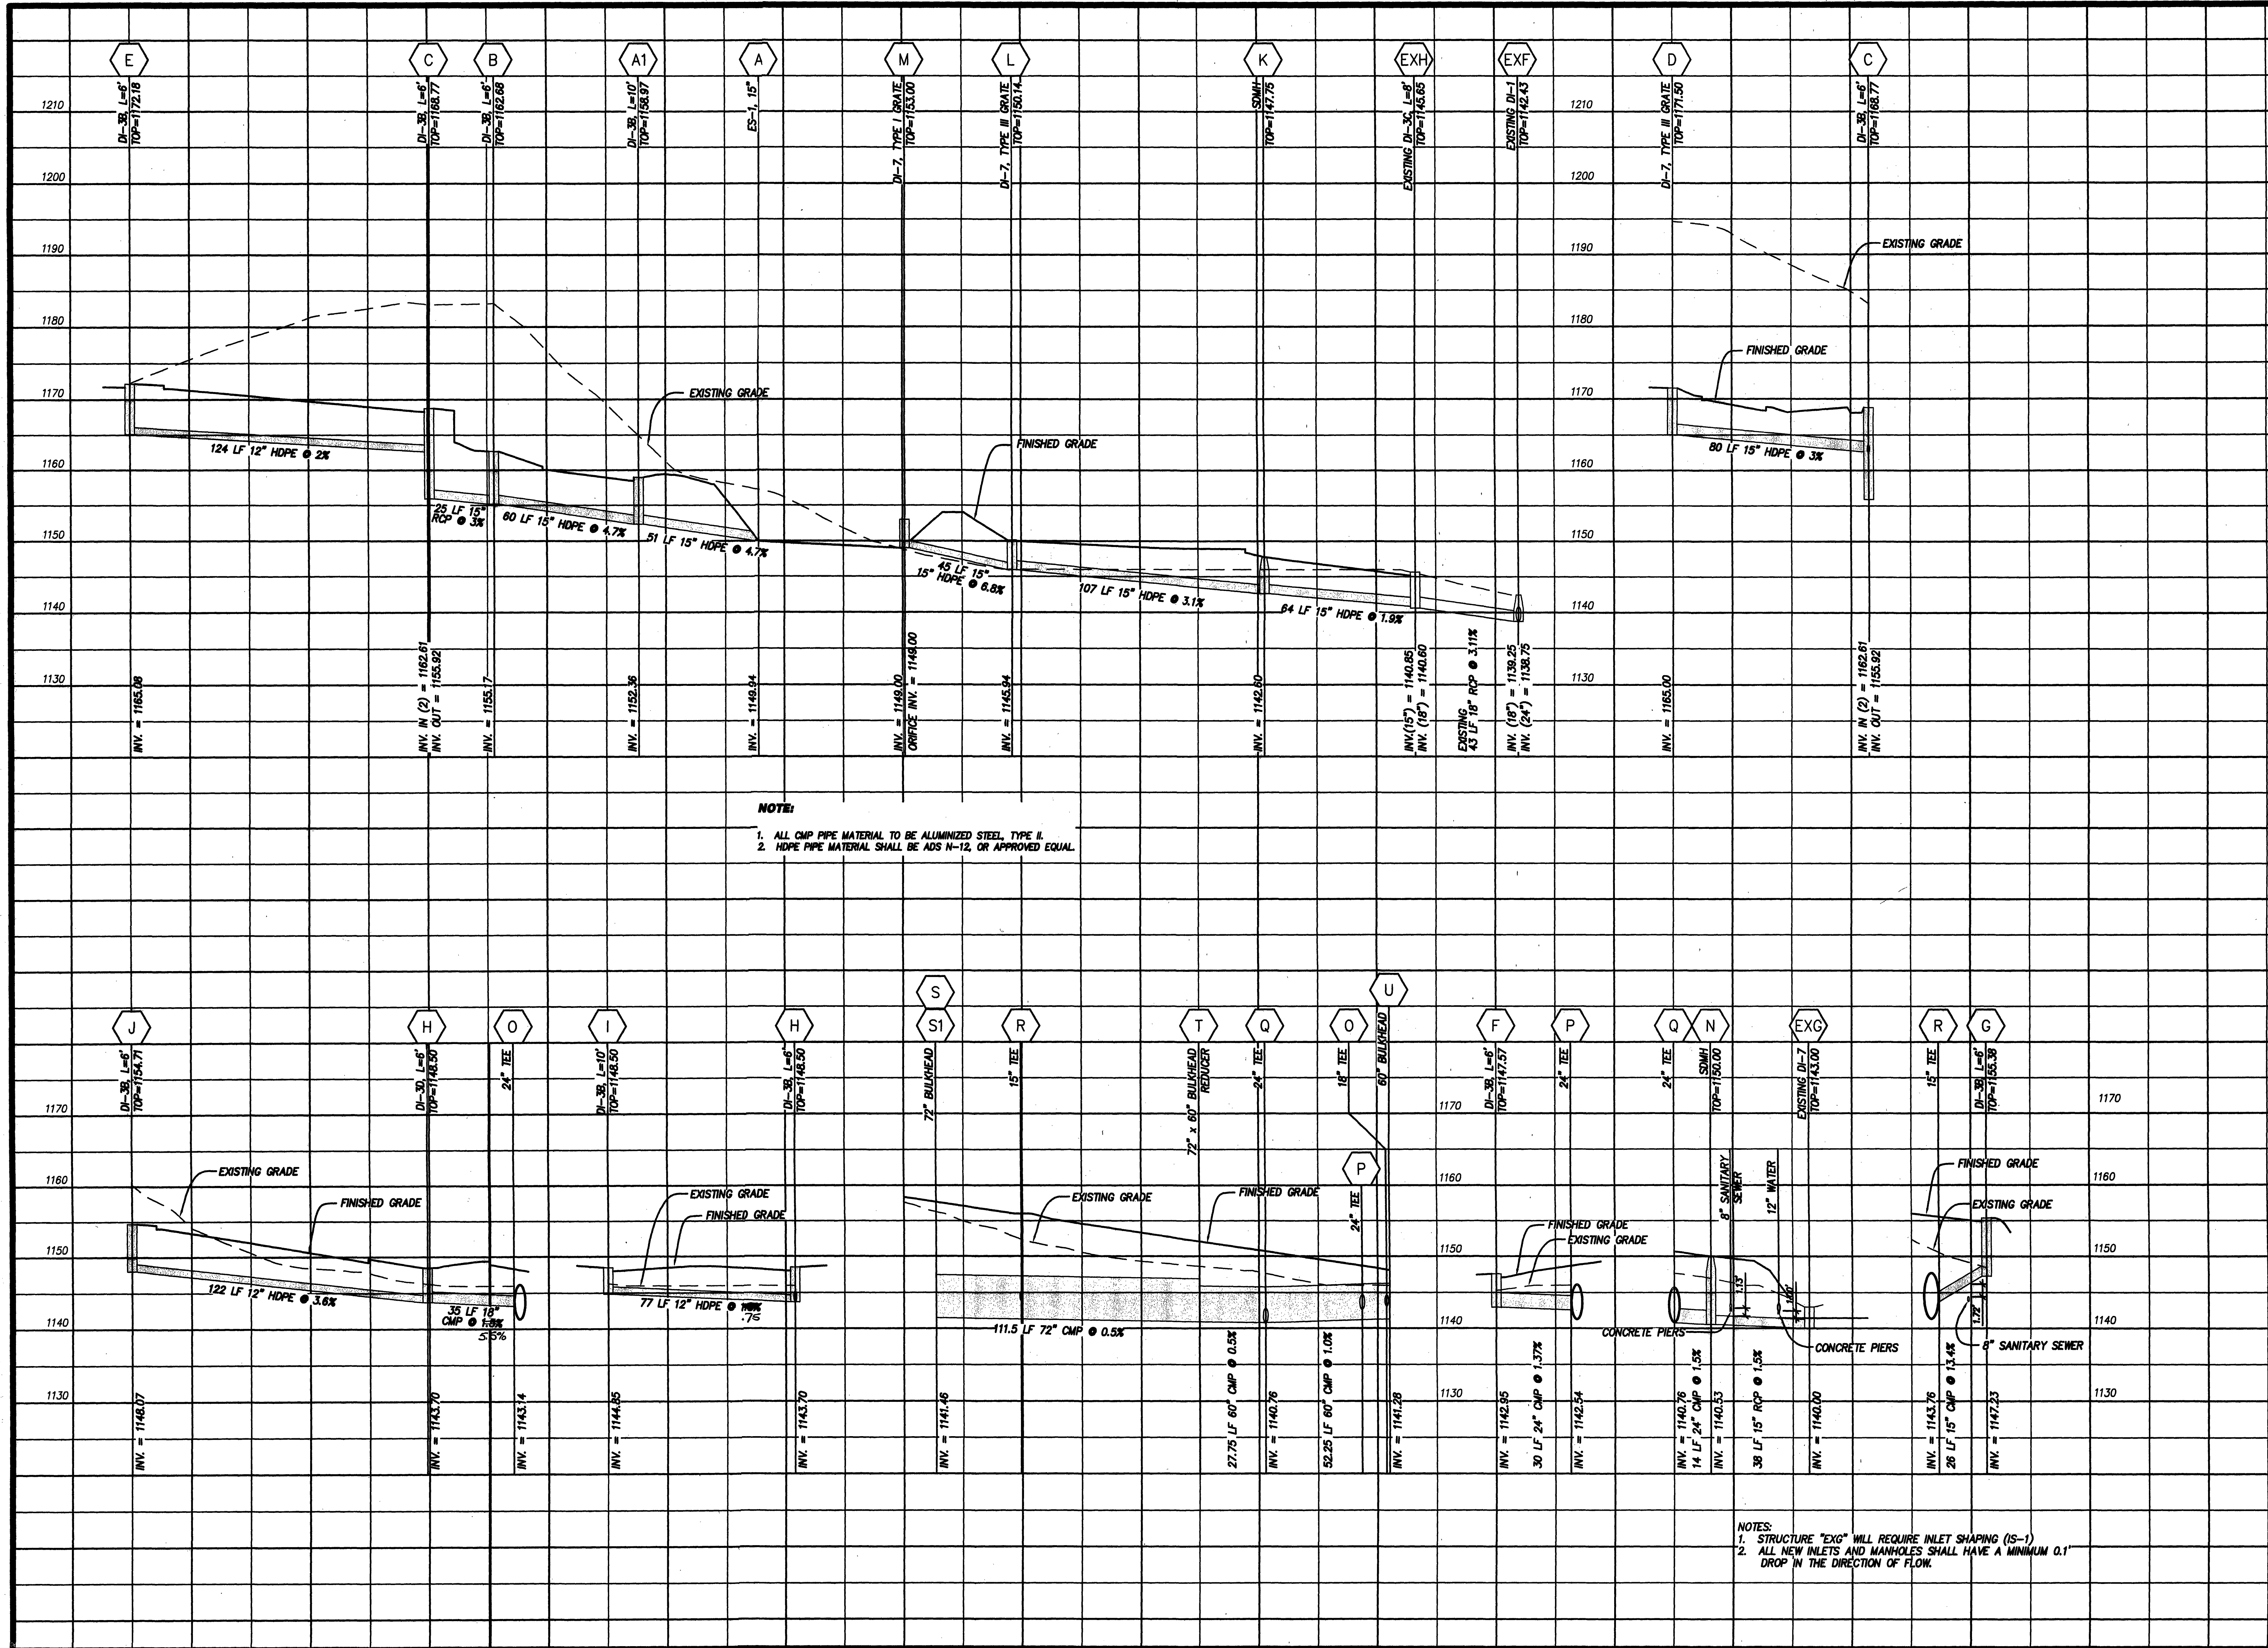

NOTE:
1. ALL CMP PIPE MATERIAL TO BE ALUMINIZED STEEL, TYPE II.
2. HDPE PIPE MATERIAL SHALL BE ADS N-12, OR APPROVED EQUAL.

NOTES:
1. STRUCTURE "EXG" WILL REQUIRE INLET SHAPING (IS-1)
2. ALL NEW INLETS AND MANHOLES SHALL HAVE A MINIMUM 0.1' DROP IN THE DIRECTION OF FLOW.

LUMSDEN ASSOCIATES, P.C.
ENGINEERS-SURVEYORS-PLANNERS
ROANOKE, VIRGINIA

4664 BRAMBLETON AVENUE
P.O. BOX 30669
ROANOKE, VIRGINIA 24018
PHONE (540) 772-4411
FAX (540) 772-9445
E-MAIL: MAIL@LUMSDENPC.COM

THOMAS C. DALE
No. 033002
3/1/05
PROFESSIONAL ENGINEER

PROFILES

WEST VILLAGE
PREPARED FOR
WEST VILLAGE, L.L.C.
CAVE SPRING MAGISTERIAL DISTRICT
ROANOKE COUNTY, VIRGINIA

AS-BUILTS
5/4/2006

WWW.IDP-SPYNNM

NO.	DATE	DESCRIPTION
1	1/16/2006	REVISED PROFILE STRUCTURE "F" AND NOTES
2	3/7/2006	REV. STORM DRAIN STR. TO "X" "DIP" ALSO THE ADD. 1 PARKING SIGN LOCATION
3		
4		
5		

DATE: OCTOBER 11, 2004
SCALE: 1"=30'(H), 1"=10'(V)
COMMISSION NO. 03-342
CADD FILE: F:\3003\03342\ENGIN\03342COMP.DWG
SHEET 8 OF 12