


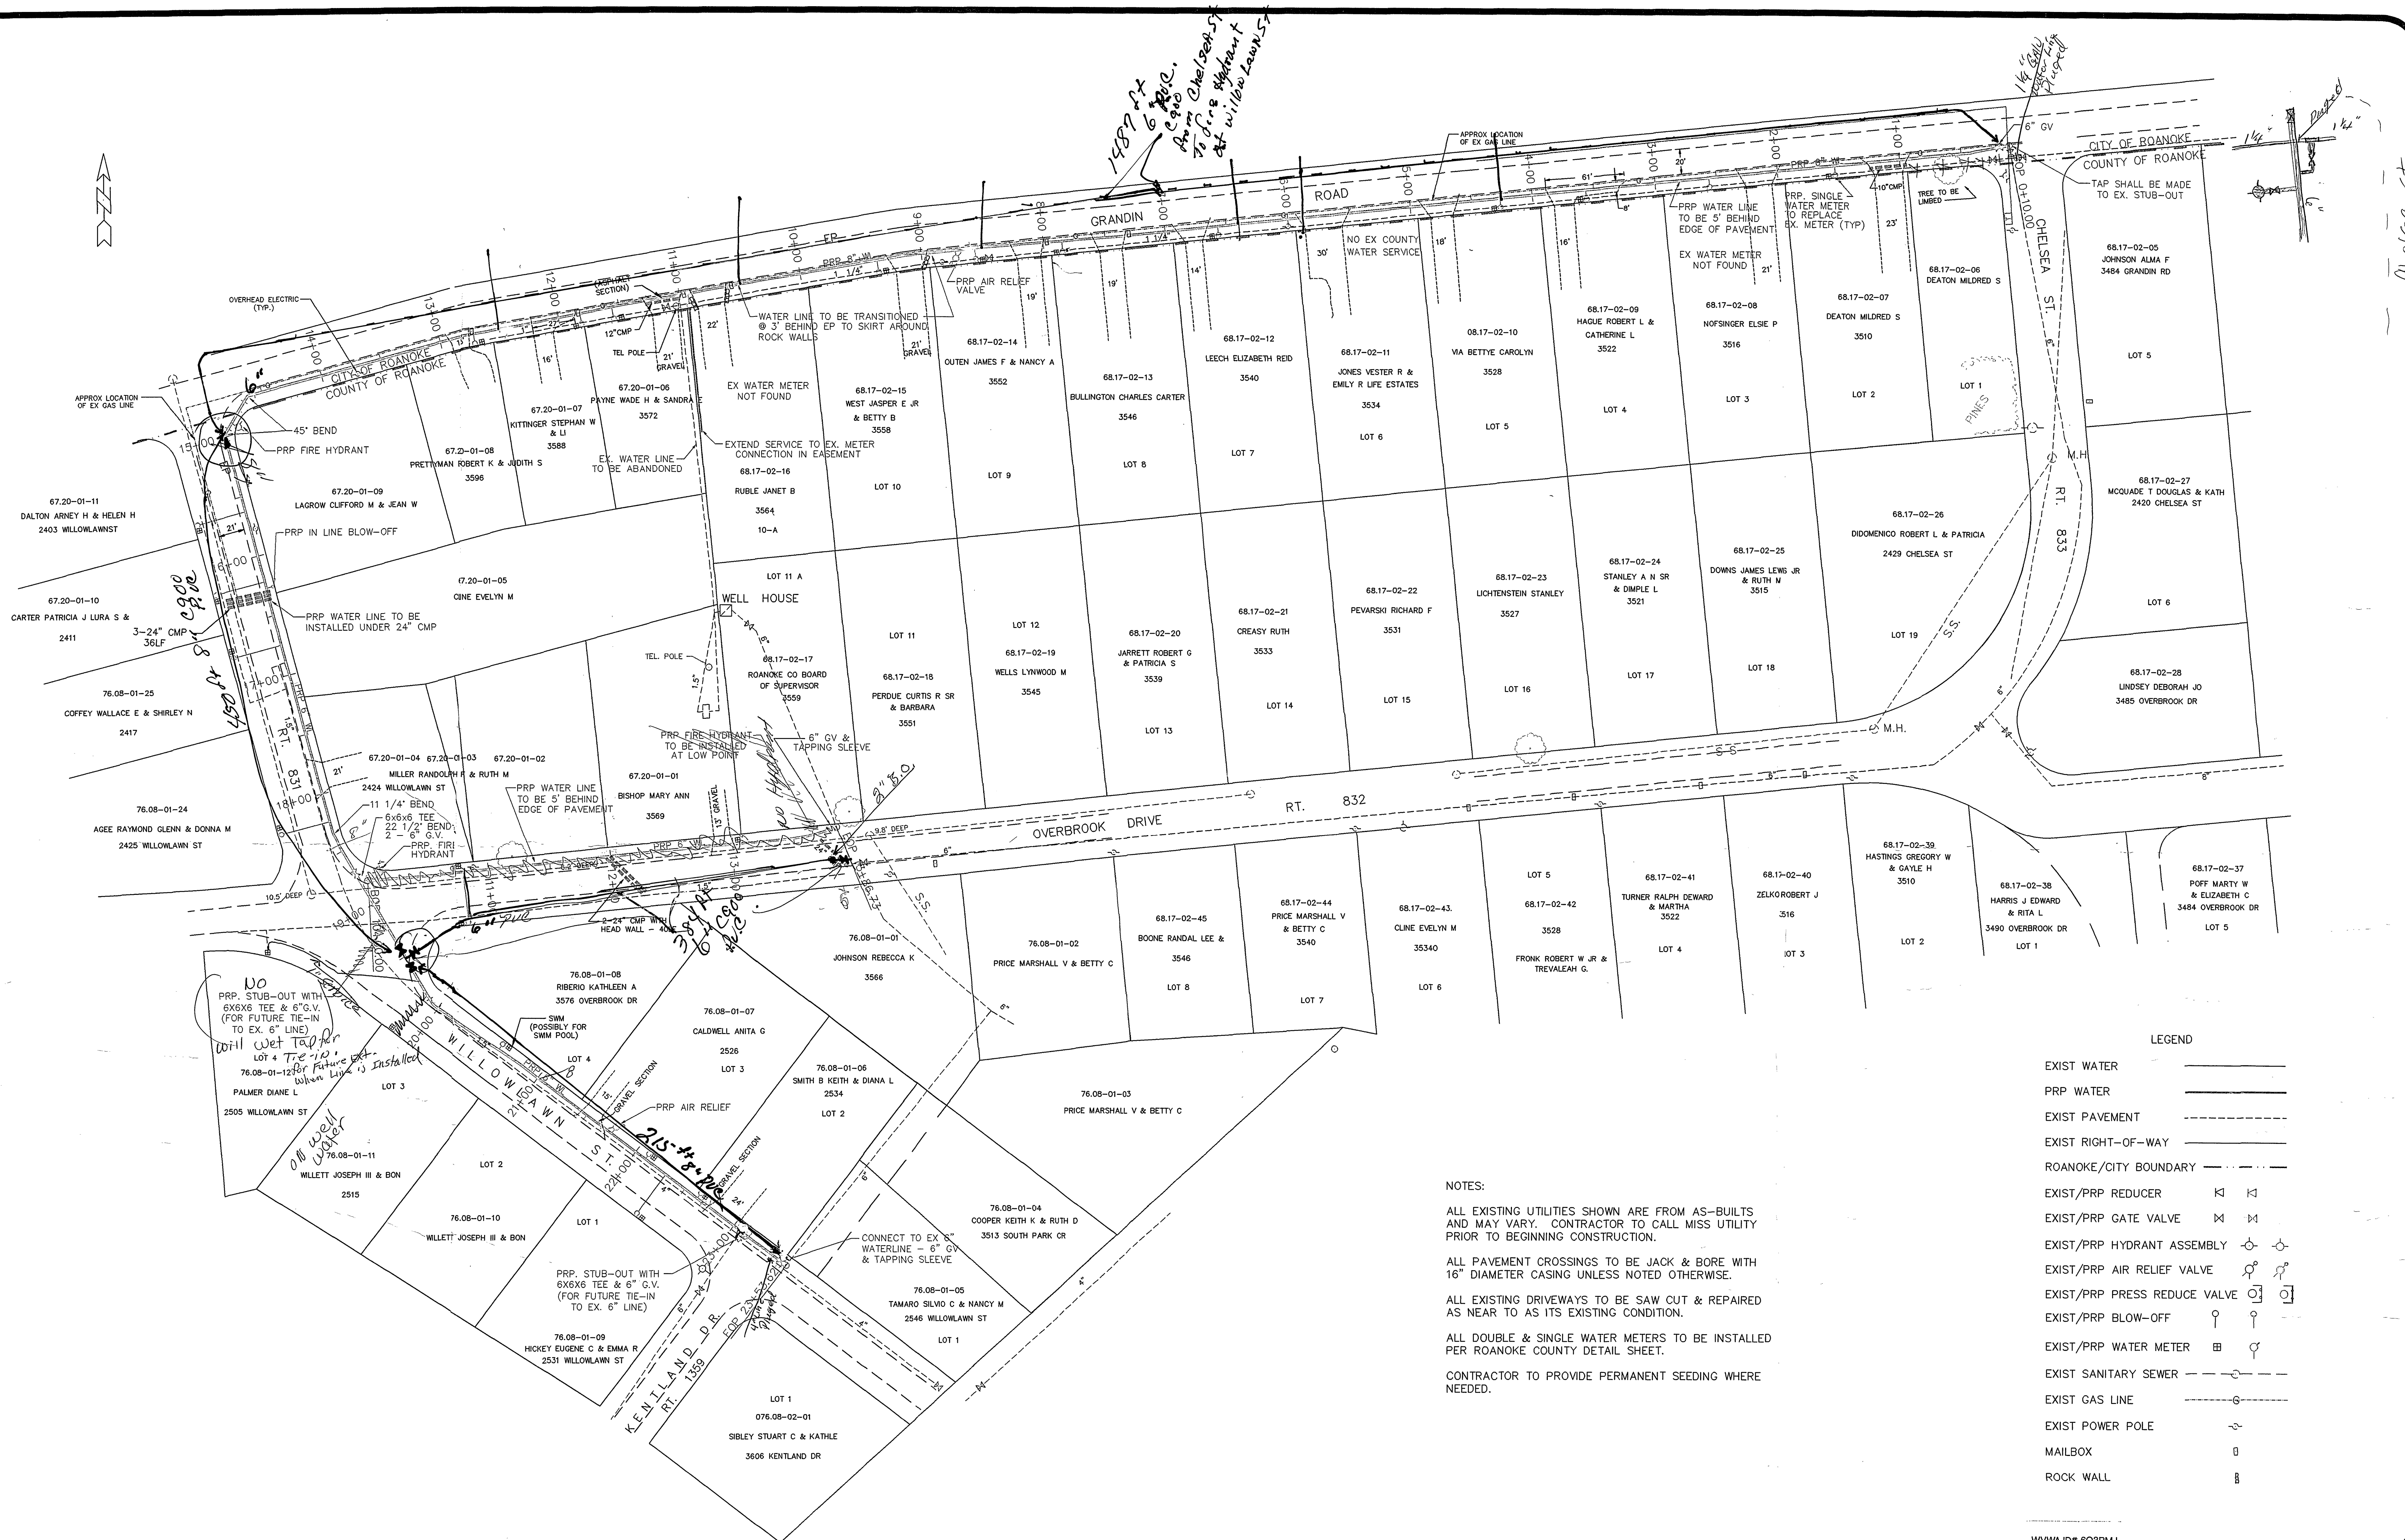

LEGEND

EXIST WATER	---
PRP WATER	---
EXIST PAVEMENT	---
EXIST RIGHT-OF-WAY	---
ROANOKE/CITY BOUNDARY	---
EXIST/PRP REDUCER	⌵ ⌶
EXIST/PRP GATE VALVE	⌵ ⌶
EXIST/PRP HYDRANT ASSEMBLY	⊕ ⊕
EXIST/PRP AIR RELIEF VALVE	⊕ ⊕
EXIST/PRP PRESS REDUCE VALVE	⊕ ⊕
EXIST/PRP BLOW-OFF	⊕ ⊕
EXIST/PRP WATER METER	⊕ ⊕
EXIST SANITARY SEWER	---
EXIST GAS LINE	---
EXIST POWER POLE	---
MAILBOX	⊕
ROCK WALL	⊕

NOTES:

ALL EXISTING UTILITIES SHOWN ARE FROM AS-BUILTS AND MAY VARY. CONTRACTOR TO CALL MISS UTILITY PRIOR TO BEGINNING CONSTRUCTION.

ALL PAVEMENT CROSSINGS TO BE JACK & BORE WITH 16" DIAMETER CASING UNLESS NOTED OTHERWISE.

ALL EXISTING DRIVEWAYS TO BE SAW CUT & REPAIRED AS NEAR TO AS ITS EXISTING CONDITION.

ALL DOUBLE & SINGLE WATER METERS TO BE INSTALLED PER ROANOKE COUNTY DETAIL SHEET.

CONTRACTOR TO PROVIDE PERMANENT SEEDING WHERE NEEDED.



DEPARTMENT OF
ENGINEERING
AND INSPECTIONS

1		09/20/96
2		
3		
4		
5		
6		
NO.	REVISIONS	DATE

WESTERN HILLS WATER LINE REPLACEMENT

DATE: 08/21/96
SCALE: 1"=60'
DRAWING BY: CLN,AMF
DESIGNED BY: SRB
APPROVED BY: GWS

WATER PLAN

SHEET
2
OF
3