


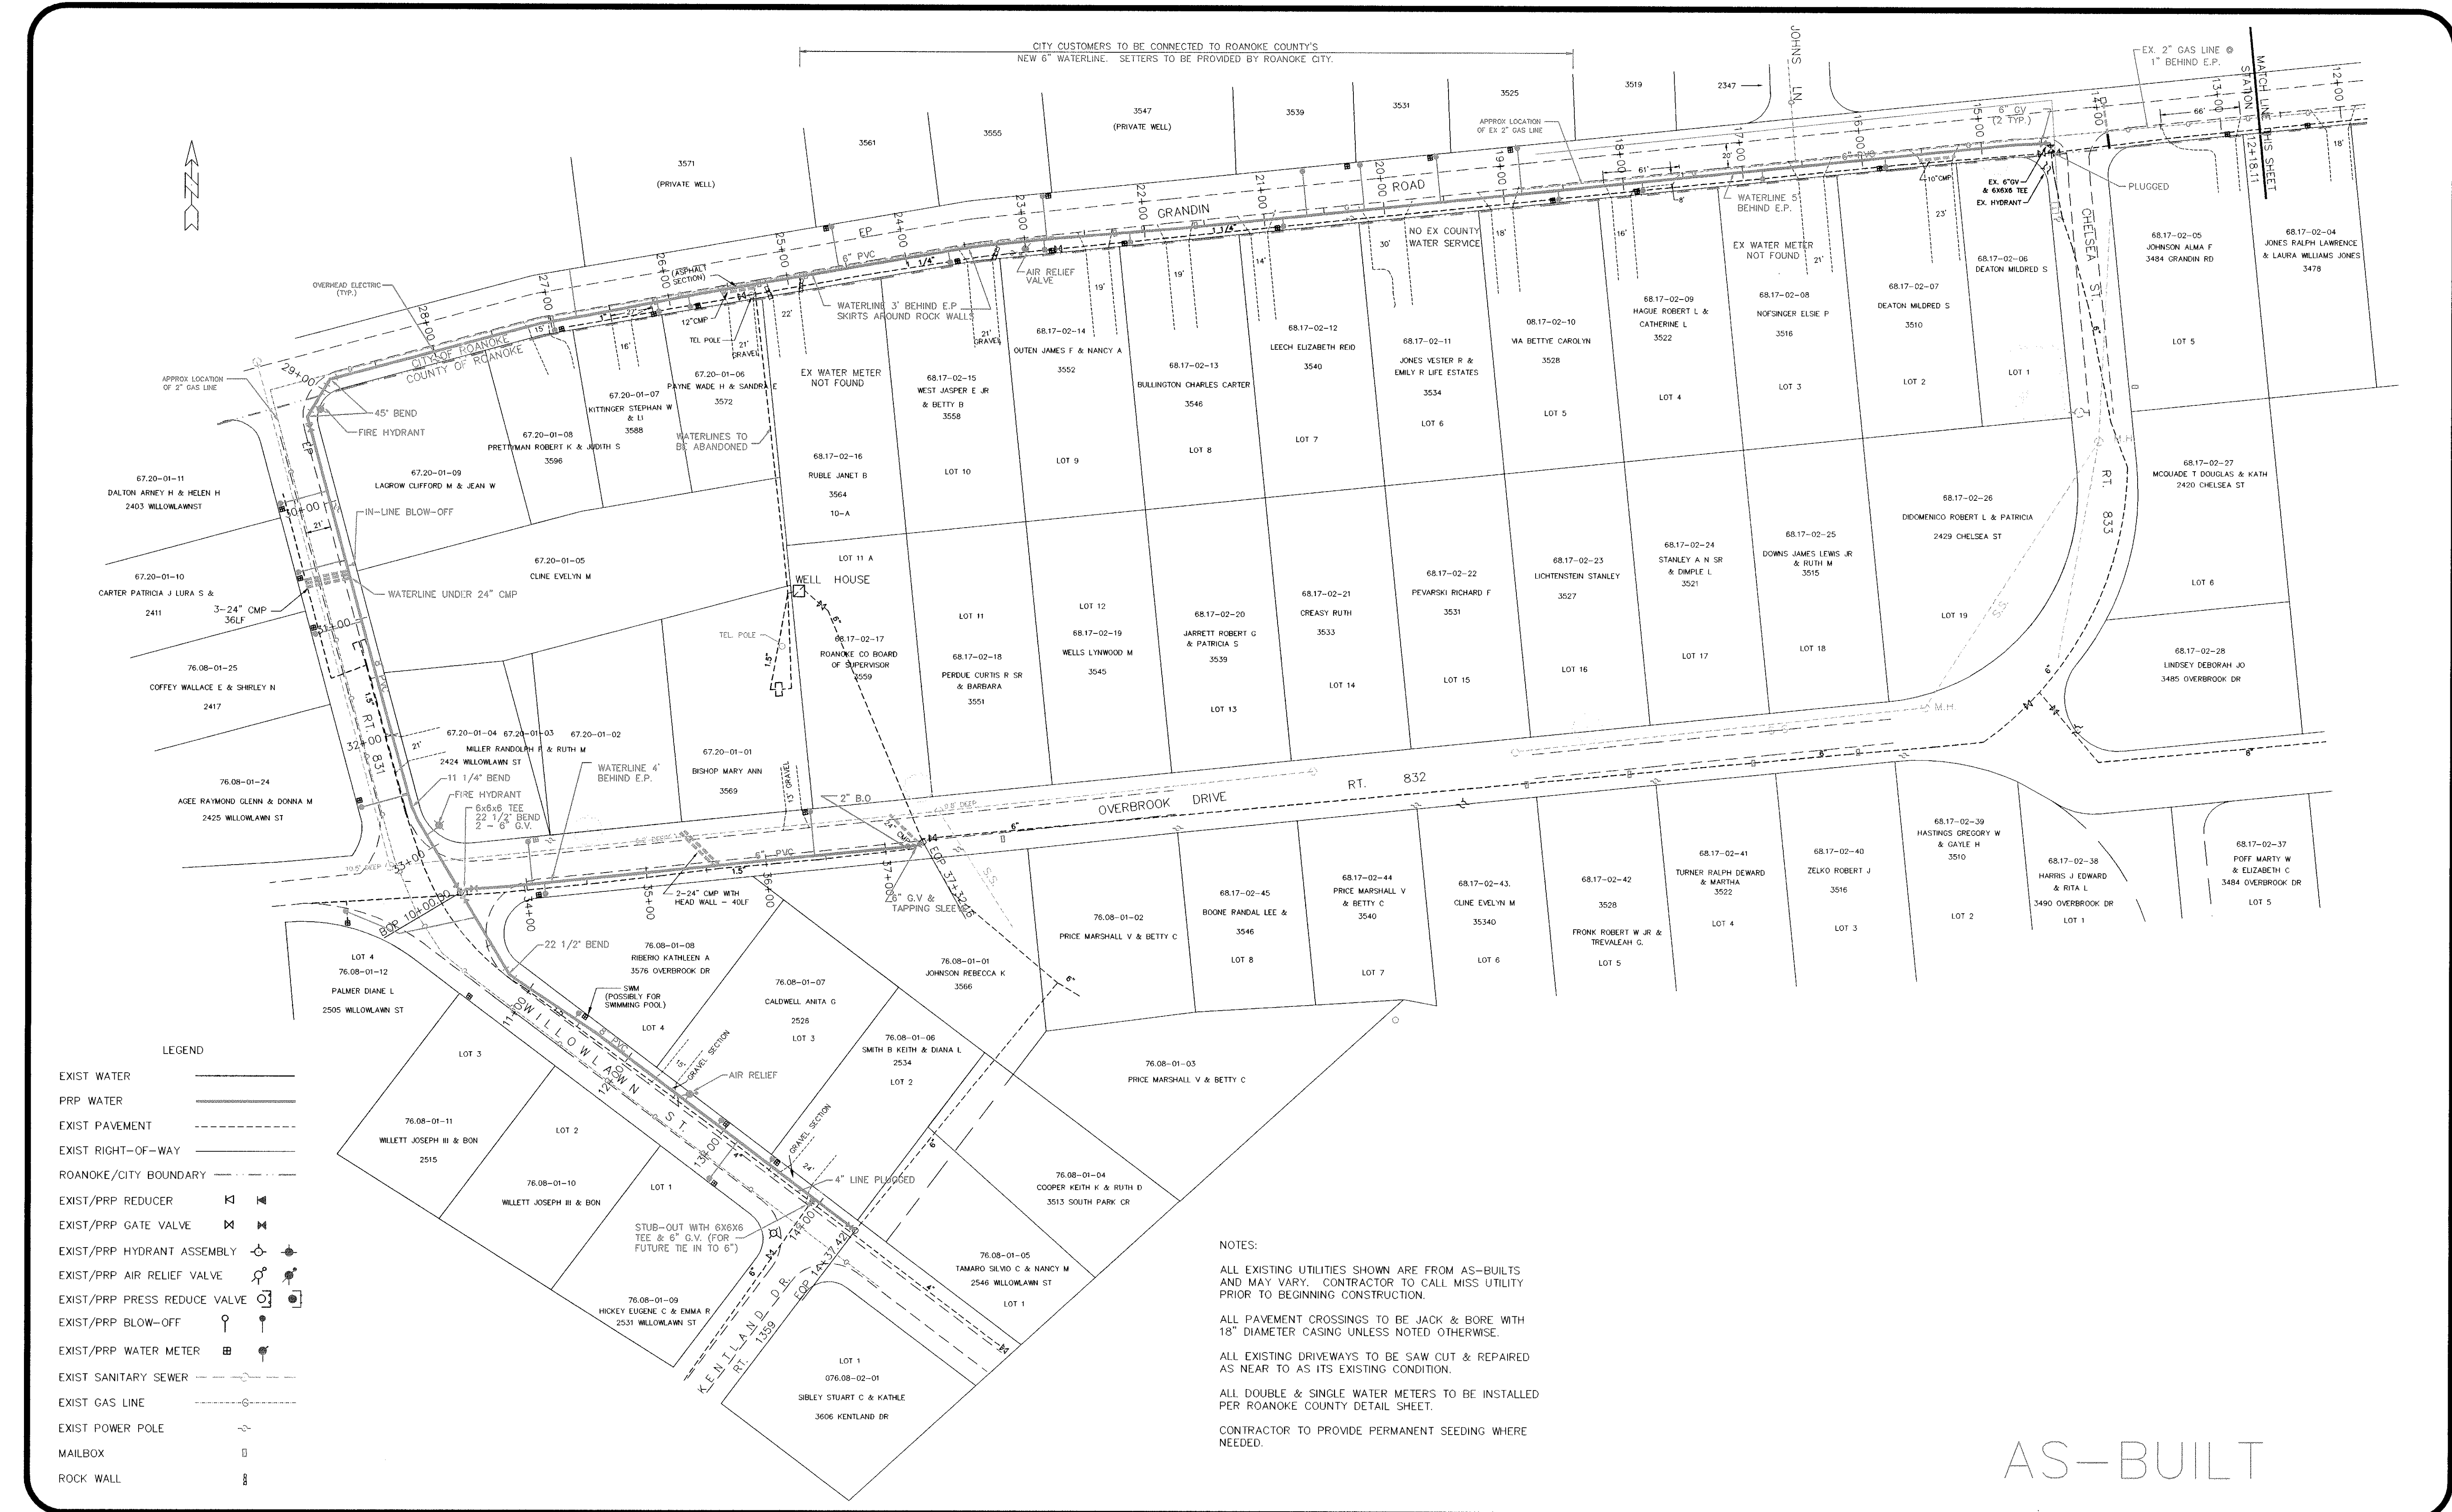

- LEGEND
- EXIST WATER
 - PRP WATER
 - EXIST PAVEMENT
 - EXIST RIGHT-OF-WAY
 - ROANOKE/CITY BOUNDARY
 - EXIST/PRP REDUCER
 - EXIST/PRP GATE VALVE
 - EXIST/PRP HYDRANT ASSEMBLY
 - EXIST/PRP AIR RELIEF VALVE
 - EXIST/PRP PRESS REDUCE VALVE
 - EXIST/PRP BLOW-OFF
 - EXIST/PRP WATER METER
 - EXIST SANITARY SEWER
 - EXIST GAS LINE
 - EXIST POWER POLE
 - MAILBOX
 - ROCK WALL

NOTES:

ALL EXISTING UTILITIES SHOWN ARE FROM AS-BUILTS AND MAY VARY. CONTRACTOR TO CALL MISS UTILITY PRIOR TO BEGINNING CONSTRUCTION.

ALL PAVEMENT CROSSINGS TO BE JACK & BORE WITH 18" DIAMETER CASING UNLESS NOTED OTHERWISE.

ALL EXISTING DRIVEWAYS TO BE SAW CUT & REPAIRED AS NEAR TO AS ITS EXISTING CONDITION.

ALL DOUBLE & SINGLE WATER METERS TO BE INSTALLED PER ROANOKE COUNTY DETAIL SHEET.

CONTRACTOR TO PROVIDE PERMANENT SEEDING WHERE NEEDED.

AS-BUILT



DEPARTMENT OF
ENGINEERING
AND INSPECTIONS

1		09/20/96
2		09/30/96
3		
4		
5		
6		
NO.	REVISIONS	DATE

WESTERN HILLS
WATERLINE REPLACEMENT

DATE: 08/21/96
SCALE: 1"=60'
DRAWING BY: CLN,AMF
DESIGNED BY: SRB
APPROVED BY: GWS

WATER PLAN

SHEET
2
OF
3

W/C - 00 92