


WATER AND SEWER NOTES:

- GENERAL NOTES:
- ALL CONSTRUCTION METHODS AND MATERIALS SHALL CONFORM TO THE LATEST EDITIONS OF THE STANDARD SPECIFICATIONS FOR THE CONSTRUCTION OF HIGHWAYS, BRIDGES, AND STRUCTURES, WESTERN VIRGINIA WATER AUTHORITY IN WRITING AT LEAST THREE (3) DAYS PRIOR TO ANY CONSTRUCTION. PLEASE REFER TO THE SPECIFICATIONS FOR THE LATEST EDITIONS.
 - ALL WORK SHALL BE SUBJECT TO INSPECTION BY THE WESTERN VIRGINIA WATER AUTHORITY.
 - FIELD CORRECTIONS SHALL BE APPROVED BY THE WESTERN VIRGINIA WATER AUTHORITY PRIOR TO SUCH CONSTRUCTION.
 - THE CONTRACTOR SHALL MAINTAIN A MINIMUM OF 18" CLEARANCE OF ALL UTILITIES AND STRUCTURES FROM THE EXISTING OR PROPOSED CONSTRUCTION OF ANY OTHER UTILITIES, WHERE SANITARY SEWER PROVISIONS OF ANY OTHER UTILITIES, WHERE CONFLICTS WITH WMA STANDARDS SHALL BE ENDORSED.
 - ANY EXISTING APPURTENANCES SHALL BE ADJUSTED TO PROTECT AND NEW FRAME AND COVER INSTALLED WHERE REQUIRED.
 - IT IS THE CONTRACTOR'S RESPONSIBILITY TO MAKE ALL EXISTING UTILITIES LOCATED AND IDENTIFIED TO VERIFY THE LOCATION OF ANY UTILITIES AND TO AVOID ANY EXISTING UTILITIES LOCATED DURING CONSTRUCTION.
- SEWER NOTES:
- ALL SANITARY SEWER CONNECTIONS TO EXISTING PUBLIC LINES SHALL BE COORDINATED WITH AND PERFORMED BY THE WMA.
 - ALL WATER AND SANITARY SEWER FACILITIES ARE TO BE CONSTRUCTED ACCORDING TO THE WMA DESIGN AND CONSTRUCTION STANDARDS.
- WATER NOTES:
- ALL WATER CONNECTIONS TO EXISTING PUBLIC LINES SHALL BE COORDINATED WITH AND PERFORMED BY THE WMA.
 - ALL WATER AND SANITARY SEWER FACILITIES ARE TO BE CONSTRUCTED ACCORDING TO THE WMA DESIGN AND CONSTRUCTION STANDARDS.
 - ALL FIRE HYDRANTS SHALL HAVE THE BARREL PAINTED SILVER AND THE CAPS TO BE COLOR CODED PER NFPA TO INDICATE WATER FLOW AT EACH PARTICULAR HYDRANT.

Water Info:
 Pipe: 8" DPC PVC C900 DR14
 6" National and NAFCO PVC C900 DR14
 Service Lines: 1" Educt HDPE SDR-9
 Values: 8" AVK
 6" AVK

Sewer Info:
 Pipe: 8" Diamond SDR-35 PVC
 6" Diamond SDR-26 PVC
 4" National SDR-41 PVC
 Manholes: CP-40 Pre-cast
 Frame & Cover: Exact Jorday
 Iron Works

DI-4 Pipe is delayed due to the pandemic, so B Whitehead approved 1/2" steel casing pipe.

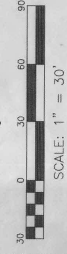

APPROVAL BLOCK

FRANKLIN COUNTY DEPARTMENT OF PLANNING & COMMUNITY DEVELOPMENT
 DATE: 7/28/2022
 Phase 1A: Inspectors As-Built K. Winslow 11.1.22

This is actually Phase 1A: on existing 12" deep
 Phase 1B:

SANITARY AND WATERLINE IMPROVEMENTS IN THIS AREA ARE TO BE CONSTRUCTED WITH PHASE 1B IMPROVEMENTS.