


PROPOSED SANITARY SEWER SCHEDULE

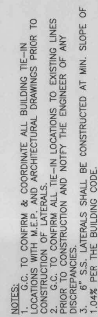

(VERTICAL)

SCALE: 1" = 10'

APPROVAL BLOCK

FRANKLIN COUNTY DEPARTMENT OF PLANNING & COMMUNITY DEVELOPMENT	DATE
--	------

Ph. 1A Inspectors As-Built's K.Winslow 11.1.22

C1C 04190116

PROJECT NO. 04190116

WESTLAKE VILL
PHASE 1
SANITARY PROFILES

DATE	BY	REVISIONS
7/11/2019		
6/30/2019		
10/30/2019		
12/01/2019		
3/24/2020		
9/28/2020		

BALZEF
& ASSOCIATE
 PLANNERS / ARCHITECTS
 ENGINEERS / SURVEYORS
 Round Lake / Richmond
 New River Valley / Staunton
 Harrisonburg / Lynchburg
 www.balzef.cc
 1208 Corporate Circle
 Round Lake, VA 24018
 540.772.8580