



Roanoke / Richmond
New River Valley / Staunton
Harrisonburg / Lynchburg
www.balzer.cc



CHRISTOPHER P. BURNS
LLC. No. 47336
6/18/2021

OFF-SITE S.S. EXTENSION

 

GILTS CREEK DISTRICT
FRANKLIN COUNTY, VIRGINIA

DRAWN BY	CPB
DESIGNED BY	CPB
CHECKED BY	BTC
DATE	4/30/2019
SCALE	AS NOTED



7/11/2019	
8/30/2019	
10/30/2019	
12/31/2019	
3/24/2020	
9/28/2020	
5/18/2021	

C11

PROJECT NO. 04190116.00

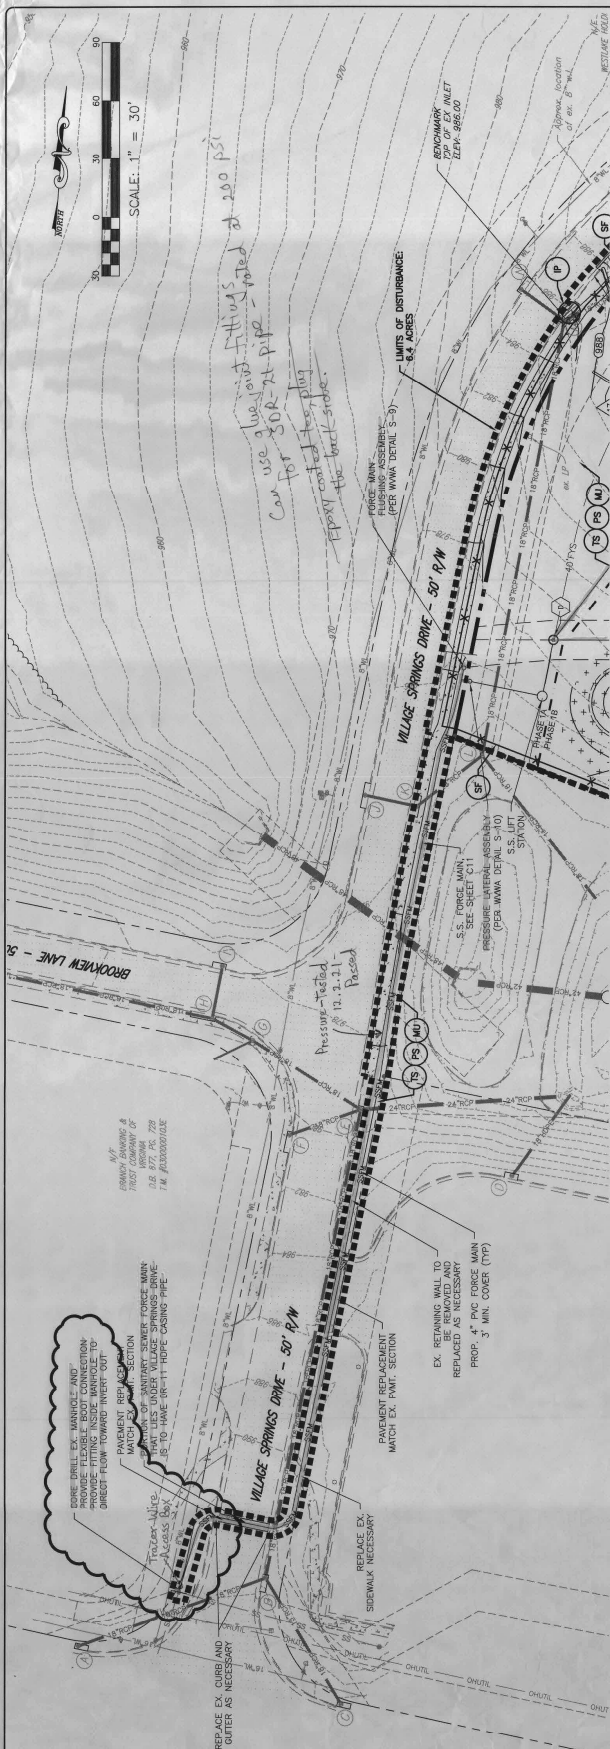

PROFILE SCALES:

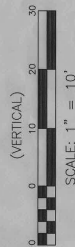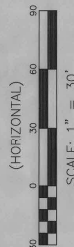

APPROVAL BLOCK

FRANKLIN COUNTY DEPARTMENT OF PLANNING & COMMUNITY DEVELOPMENT	DATE
--	------

Ph. 1A Inspector's As-Built K. Winslow U.I.22