



WESTOVER WATER / SEWER REPLACEMENT AS-BUILTS

WATERLINE AT INTERSECTION OF WESTOVER AVE. & BURKS ST.

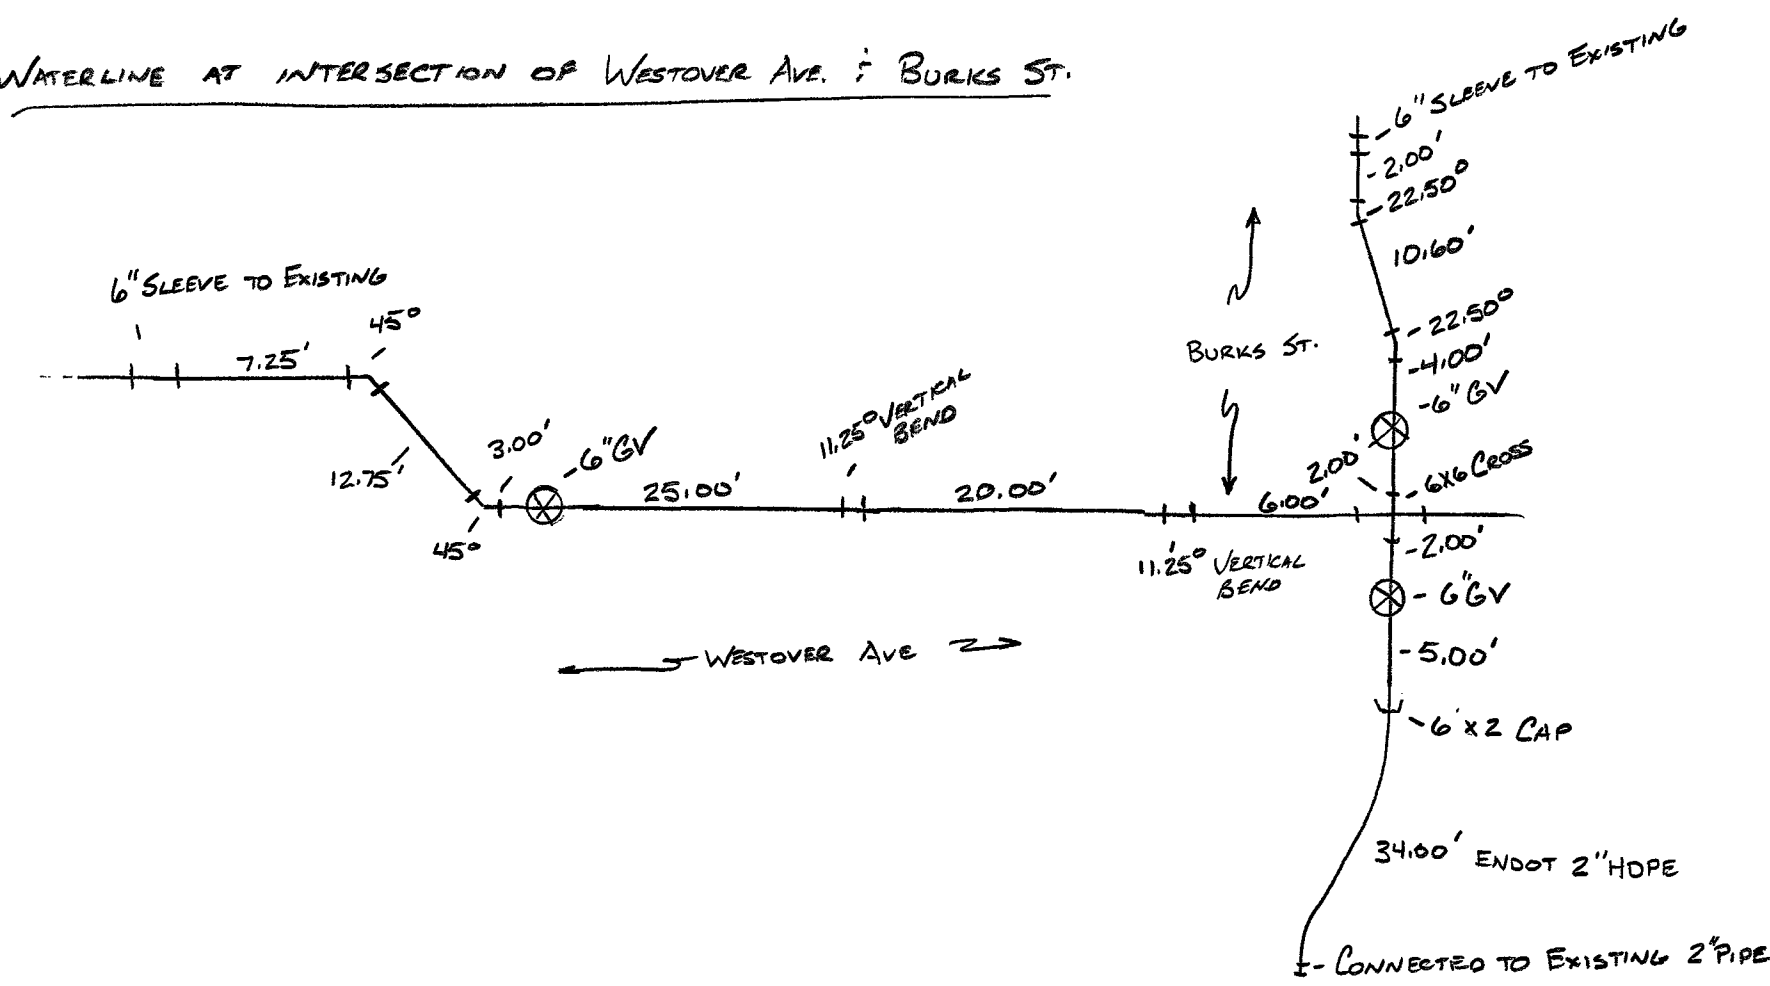

WATERLINE AT INTERSECTION OF WESTOVER AVE. & EDGEWOOD ST.

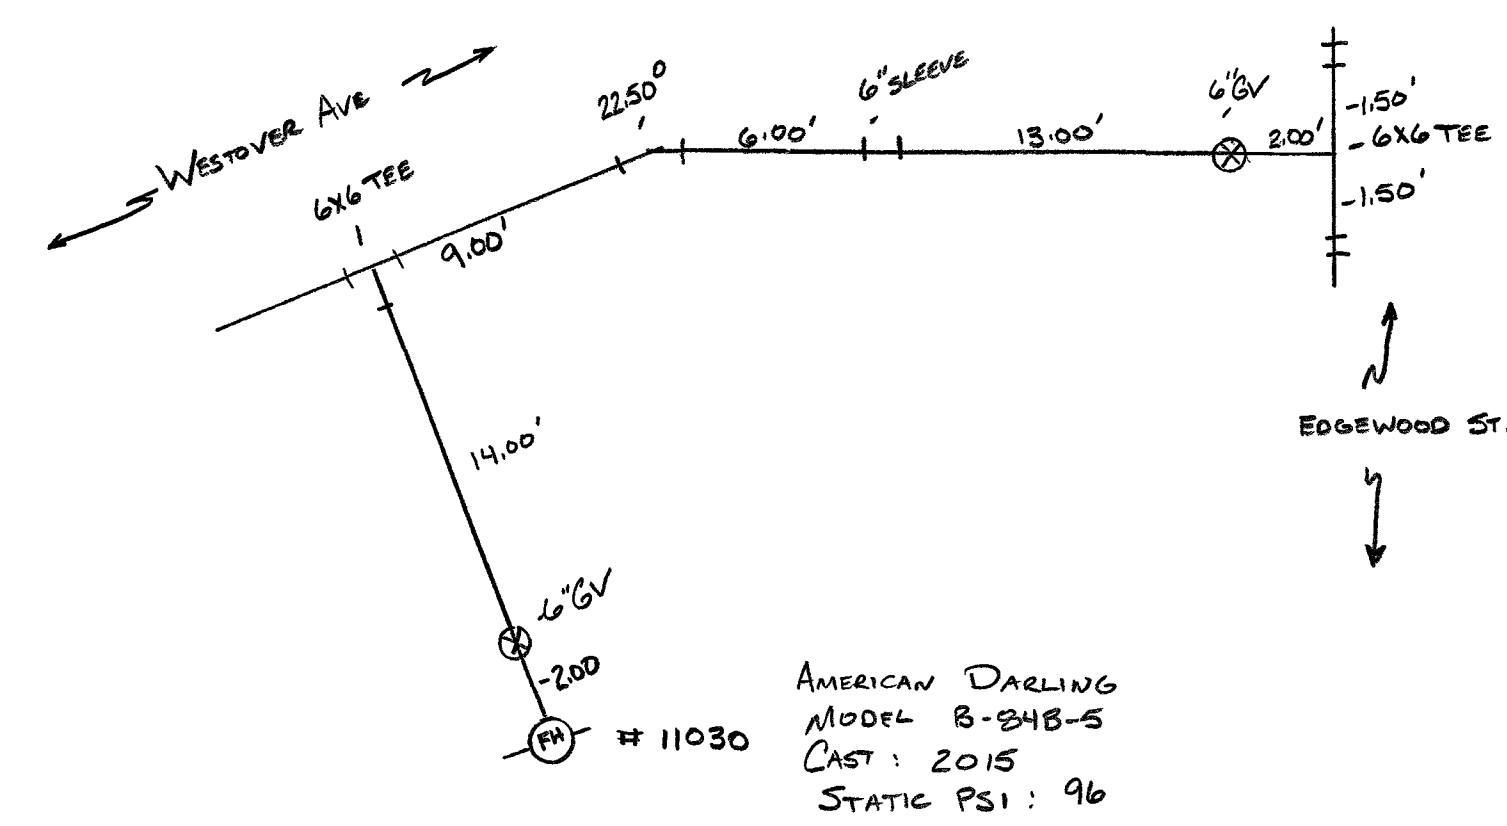

ABANDONMENT OF 2" LINE AND EXISTING FH# 11030 @ EDGEWOOD

