



PLAN	SURVEYED	DATE
	BY	
NOTE BOOK	ALIGNED	
	RT. OF WAY CHECKED	
NO.		

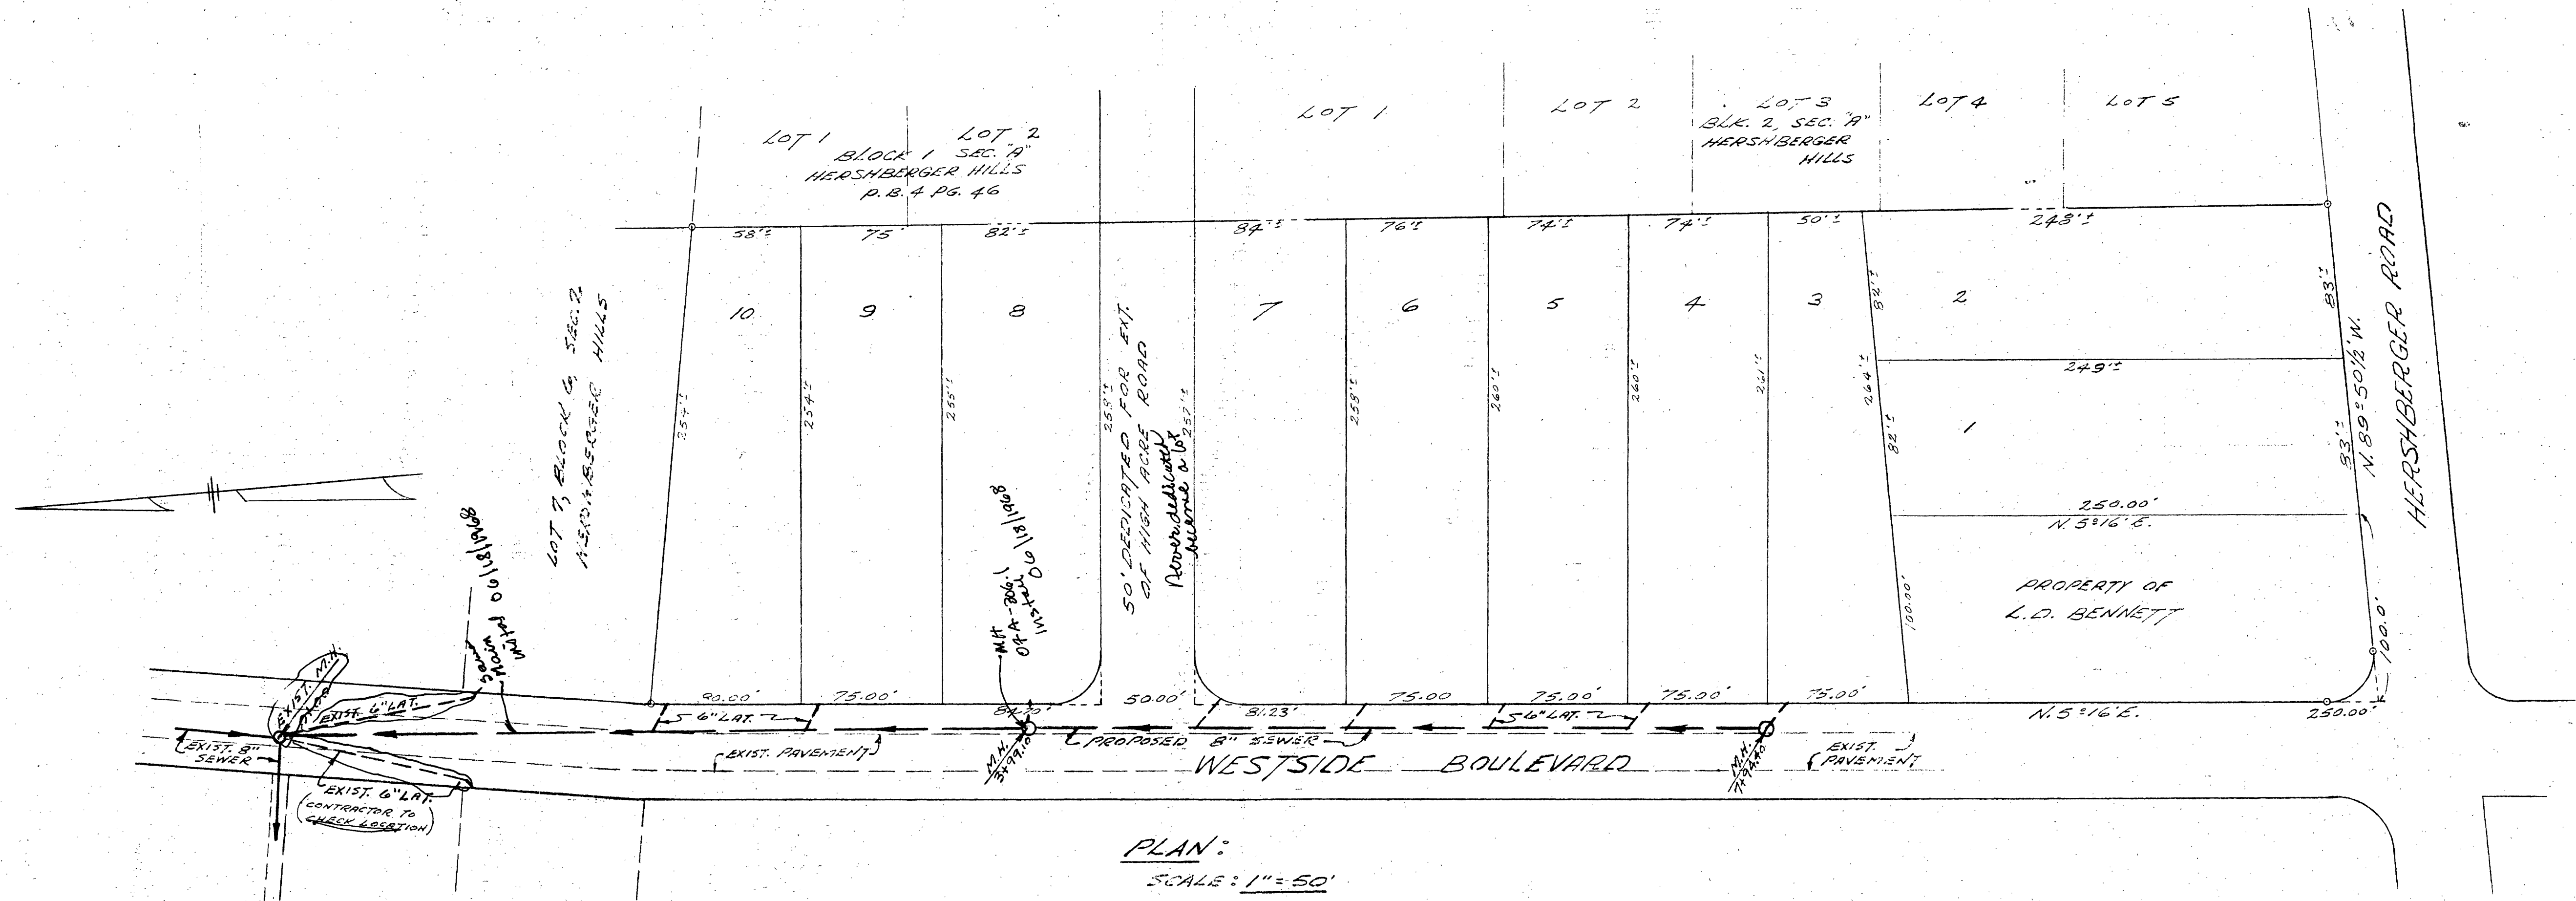



PROFILE	SURVEYED	DATE
	BY	
NOTE BOOK	GRADES CHECKED	
	B. M. NOTED	
NO.		

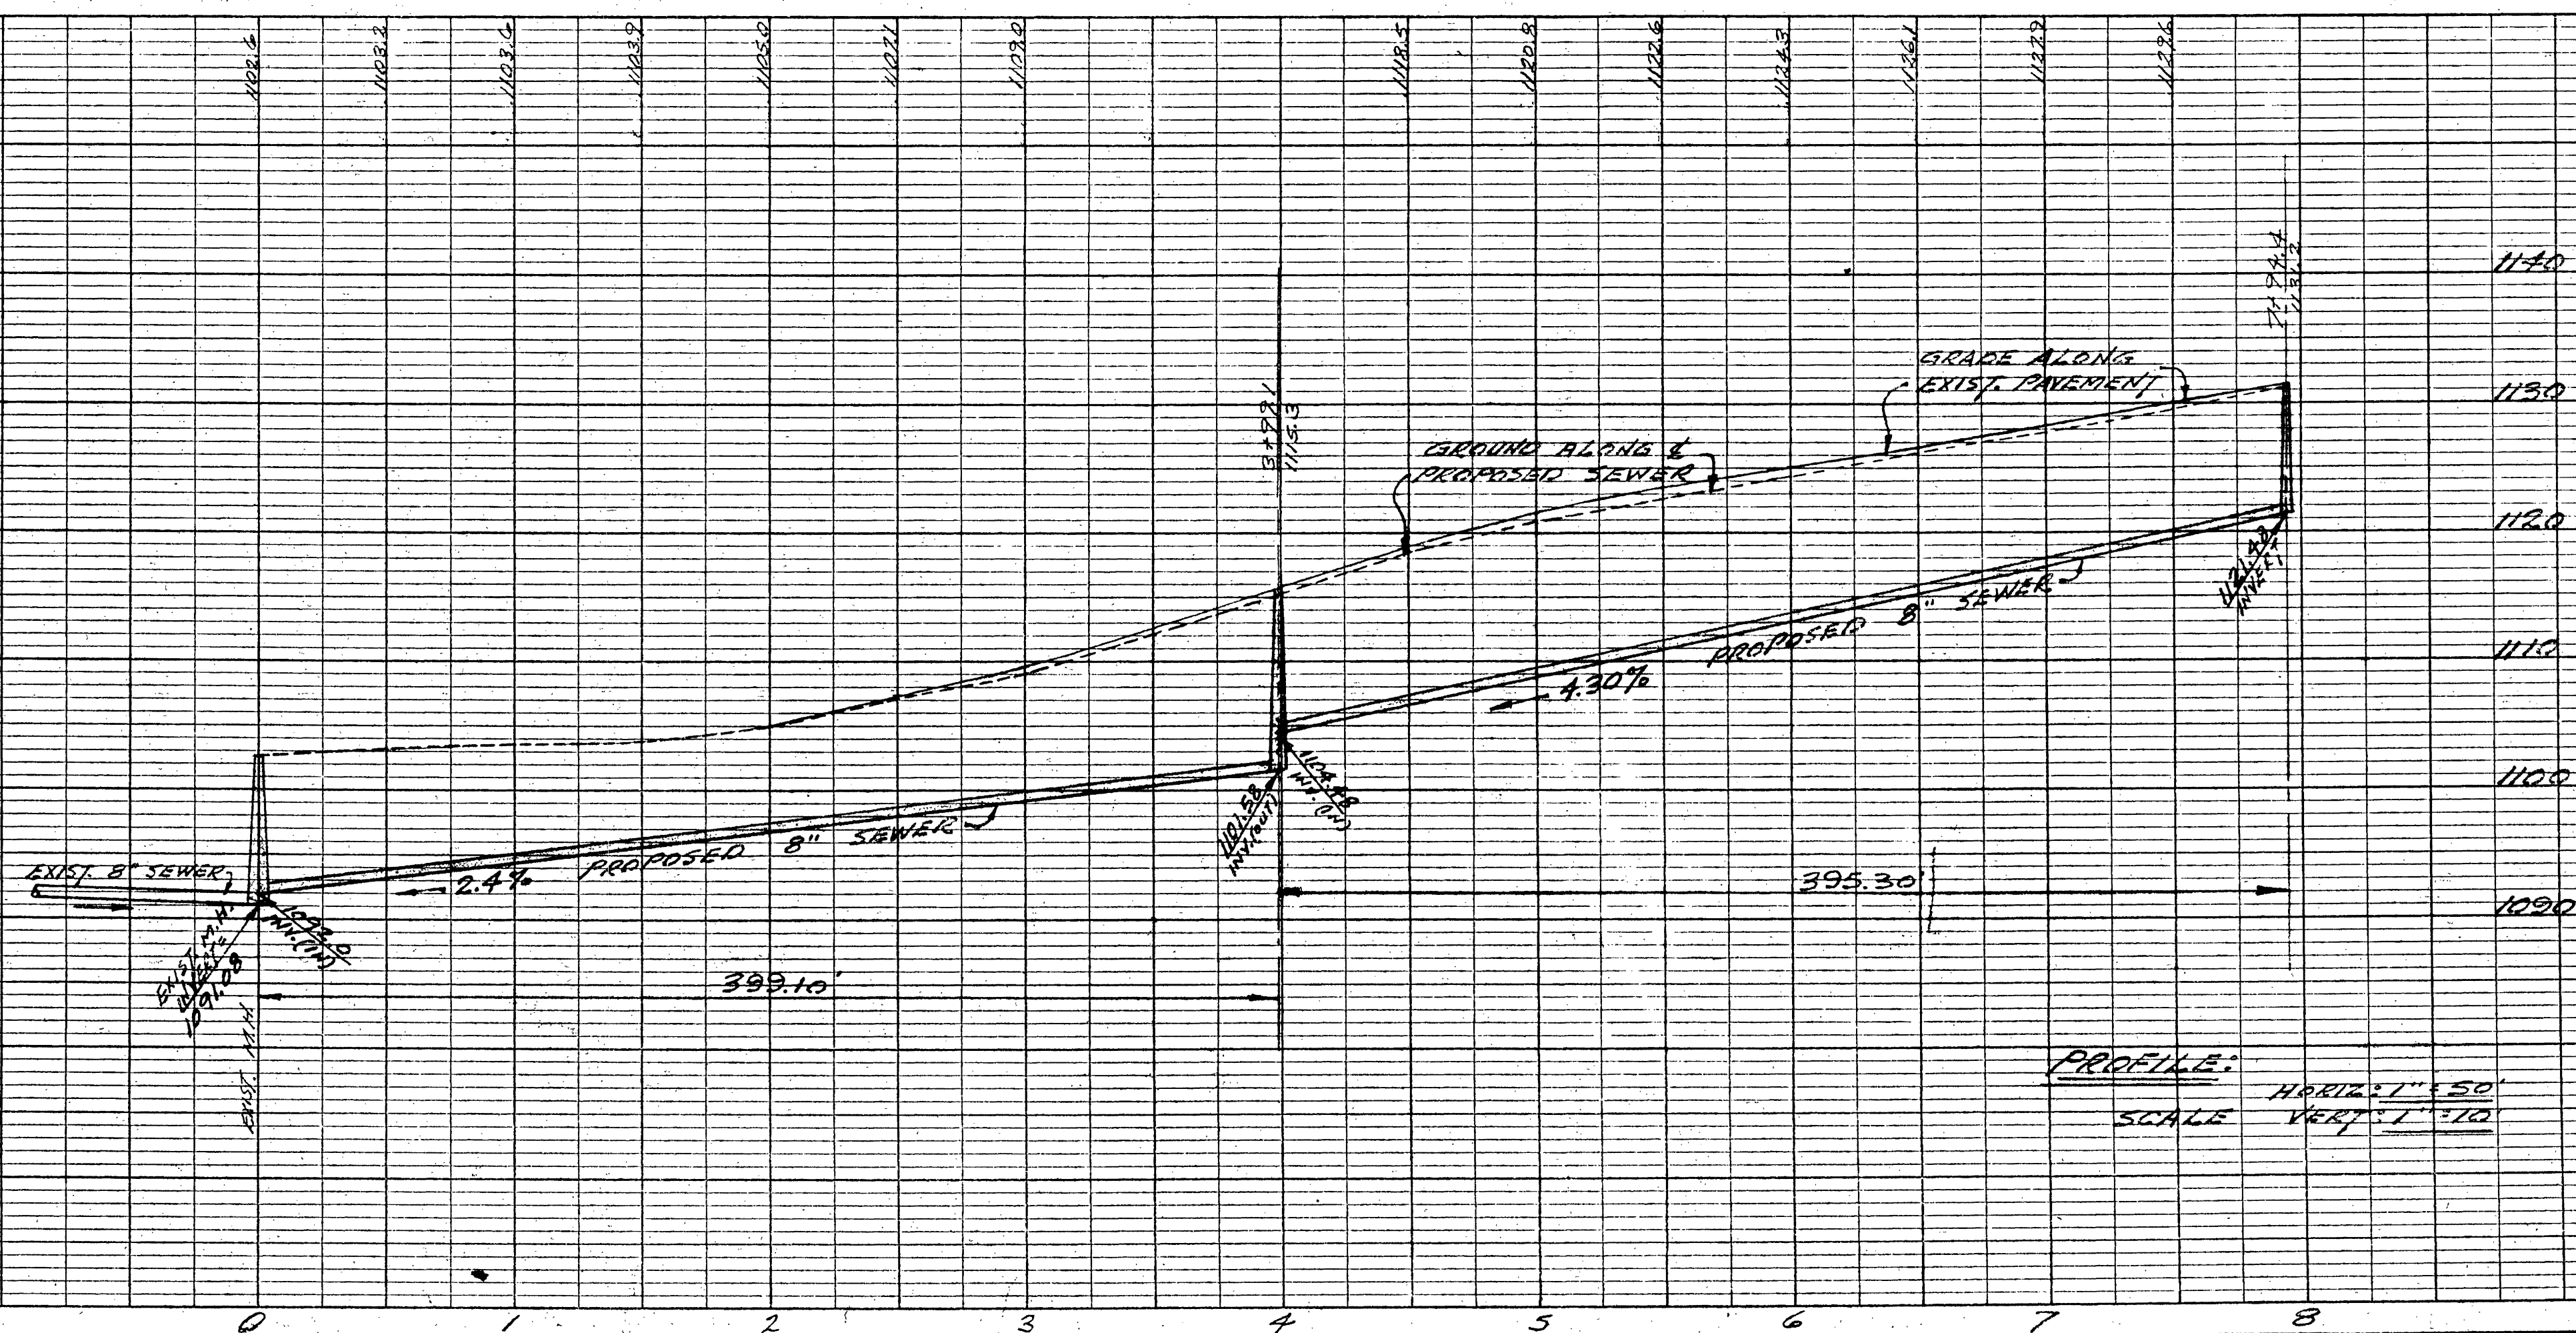

SPECIFICATIONS
SEWER TO BE CONSTRUCTED ACCORDING TO
ROANOKE COUNTY PUBLIC SERVICE AUTHORITY AND
ROANOKE CITY SPECIFICATION REQUIREMENTS
MANHOLE COVERS TO HAVE DIA. PICK HOES IN
CENTER ONLY. ALL SEWER, WATER OR OTHER UNDER-
GROUND UTILITIES TO BE MADE FULLY IN ACCORDANCE
WITH VIRGINIA DEPARTMENT OF HIGHWAYS
SPECIFICATIONS.

APPROVED:

[Signature] DATE: 7-9-68
RESIDENT ENGINEER, VA DEPT. OF HIGHWAYS
[Signature] DATE: 7/8/68
EXEC. DIRECTOR, ROANOKE CO. PUBLIC SERVICE AUTHORITY
[Signature] DATE: 7-16-68
CITY ENGINEER, ROANOKE, VA

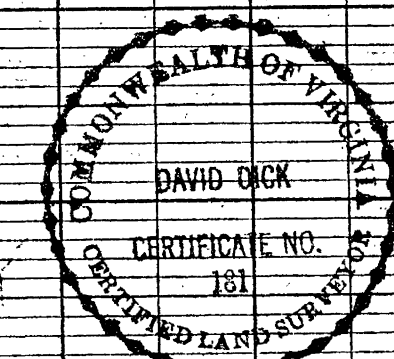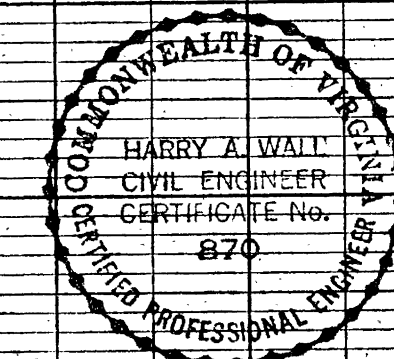

PLAN & PROFILE
SUBDIVISION PROPERTY OF
JAMES CONSTRUCTION CO. OF ROANOKE
ROANOKE CO. VIRGINIA
BY DAVID DICK & HARRY A. WALL
CIVIL ENGINEERS & SURVEYORS
DATE: JUNE 1968 SCALE: AS SHOWN