



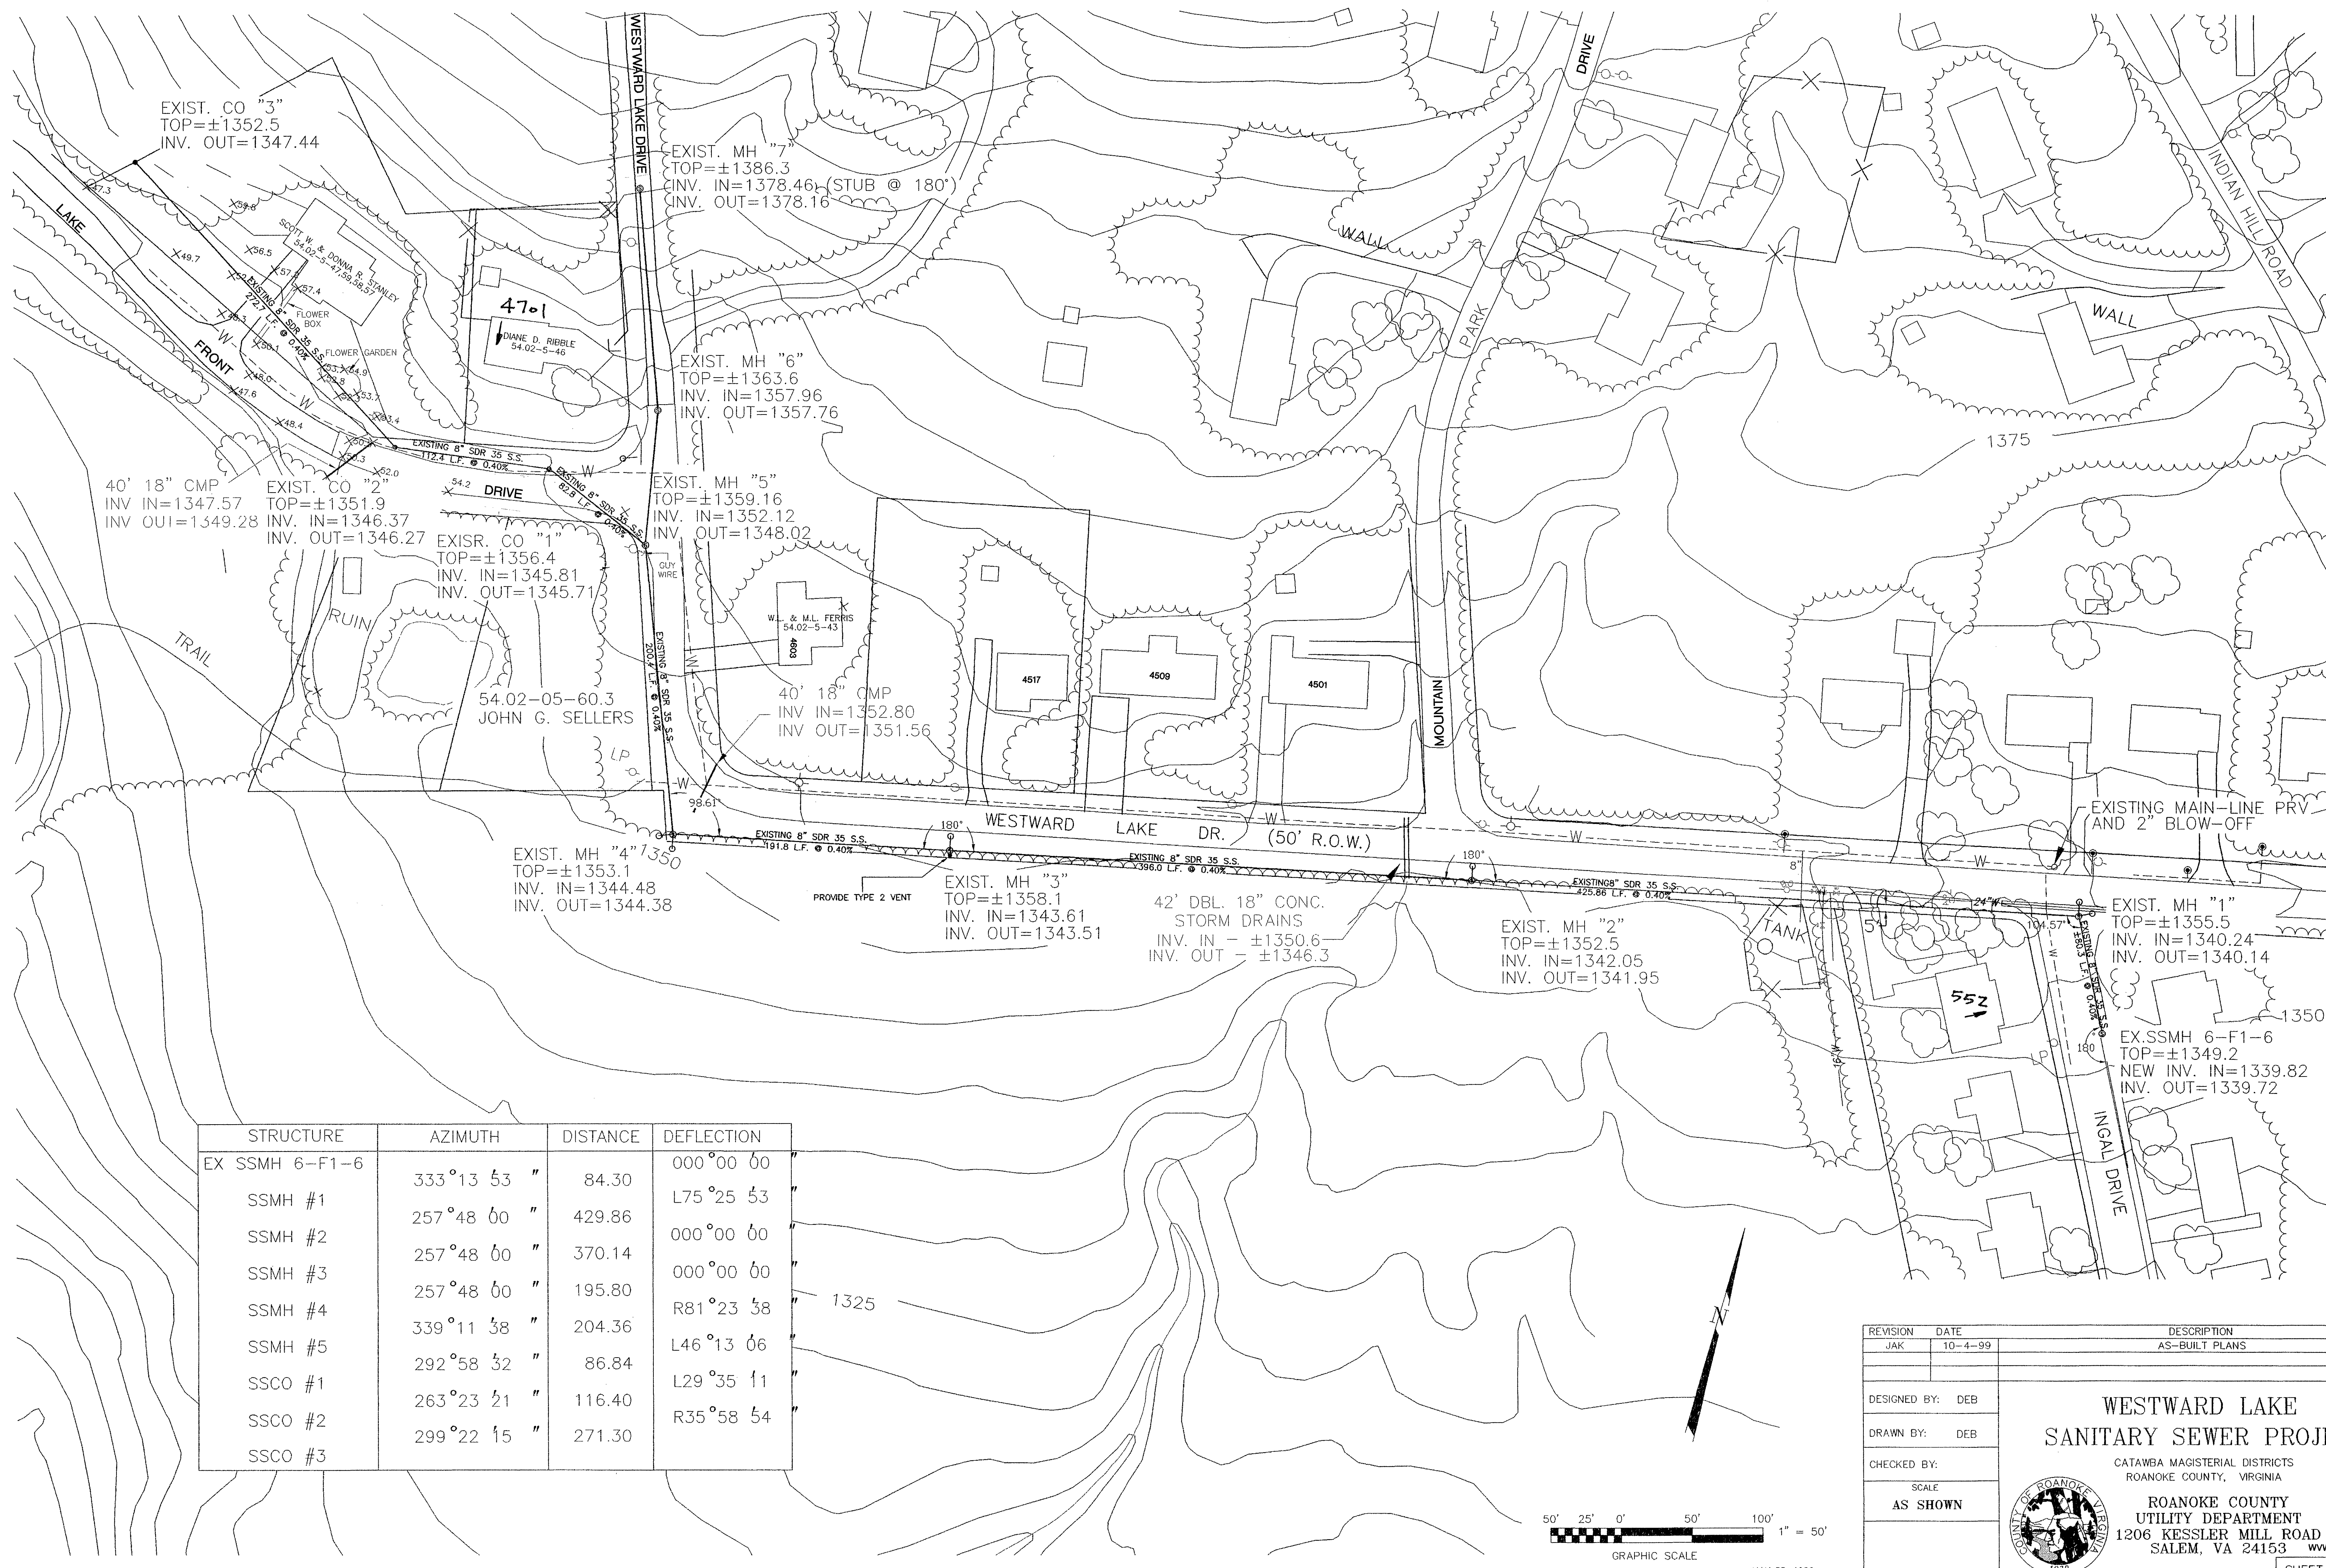

STRUCTURE	AZIMUTH	DISTANCE	DEFLECTION
EX SSMH 6-F1-6	333°13'53"	84.30	000°00'00"
SSMH #1	257°48'00"	429.86	L75°25'53"
SSMH #2	257°48'00"	370.14	000°00'00"
SSMH #3	257°48'00"	195.80	000°00'00"
SSMH #4	339°11'38"	204.36	R81°23'38"
SSMH #5	292°58'32"	86.84	L46°13'06"
SSCO #1	263°23'21"	116.40	L29°35'11"
SSCO #2	299°22'15"	271.30	R35°58'54"
SSCO #3			

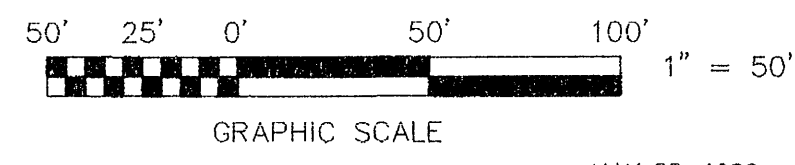

REVISION	DATE	DESCRIPTION
JAK	10-4-99	AS-BUILT PLANS
DESIGNED BY: DEB		
DRAWN BY: DEB		
CHECKED BY:		
SCALE: AS SHOWN		

**WESTWARD LAKE
SANITARY SEWER PROJECT**

CATAWBA MAGISTERIAL DISTRICTS
ROANOKE COUNTY, VIRGINIA

ROANOKE COUNTY
UTILITY DEPARTMENT
1206 KESSLER MILL ROAD
SALEM, VA 24153

WWW.ID# 6RNMV

SHEET 2 of 4

SI 000788
AS BUILT