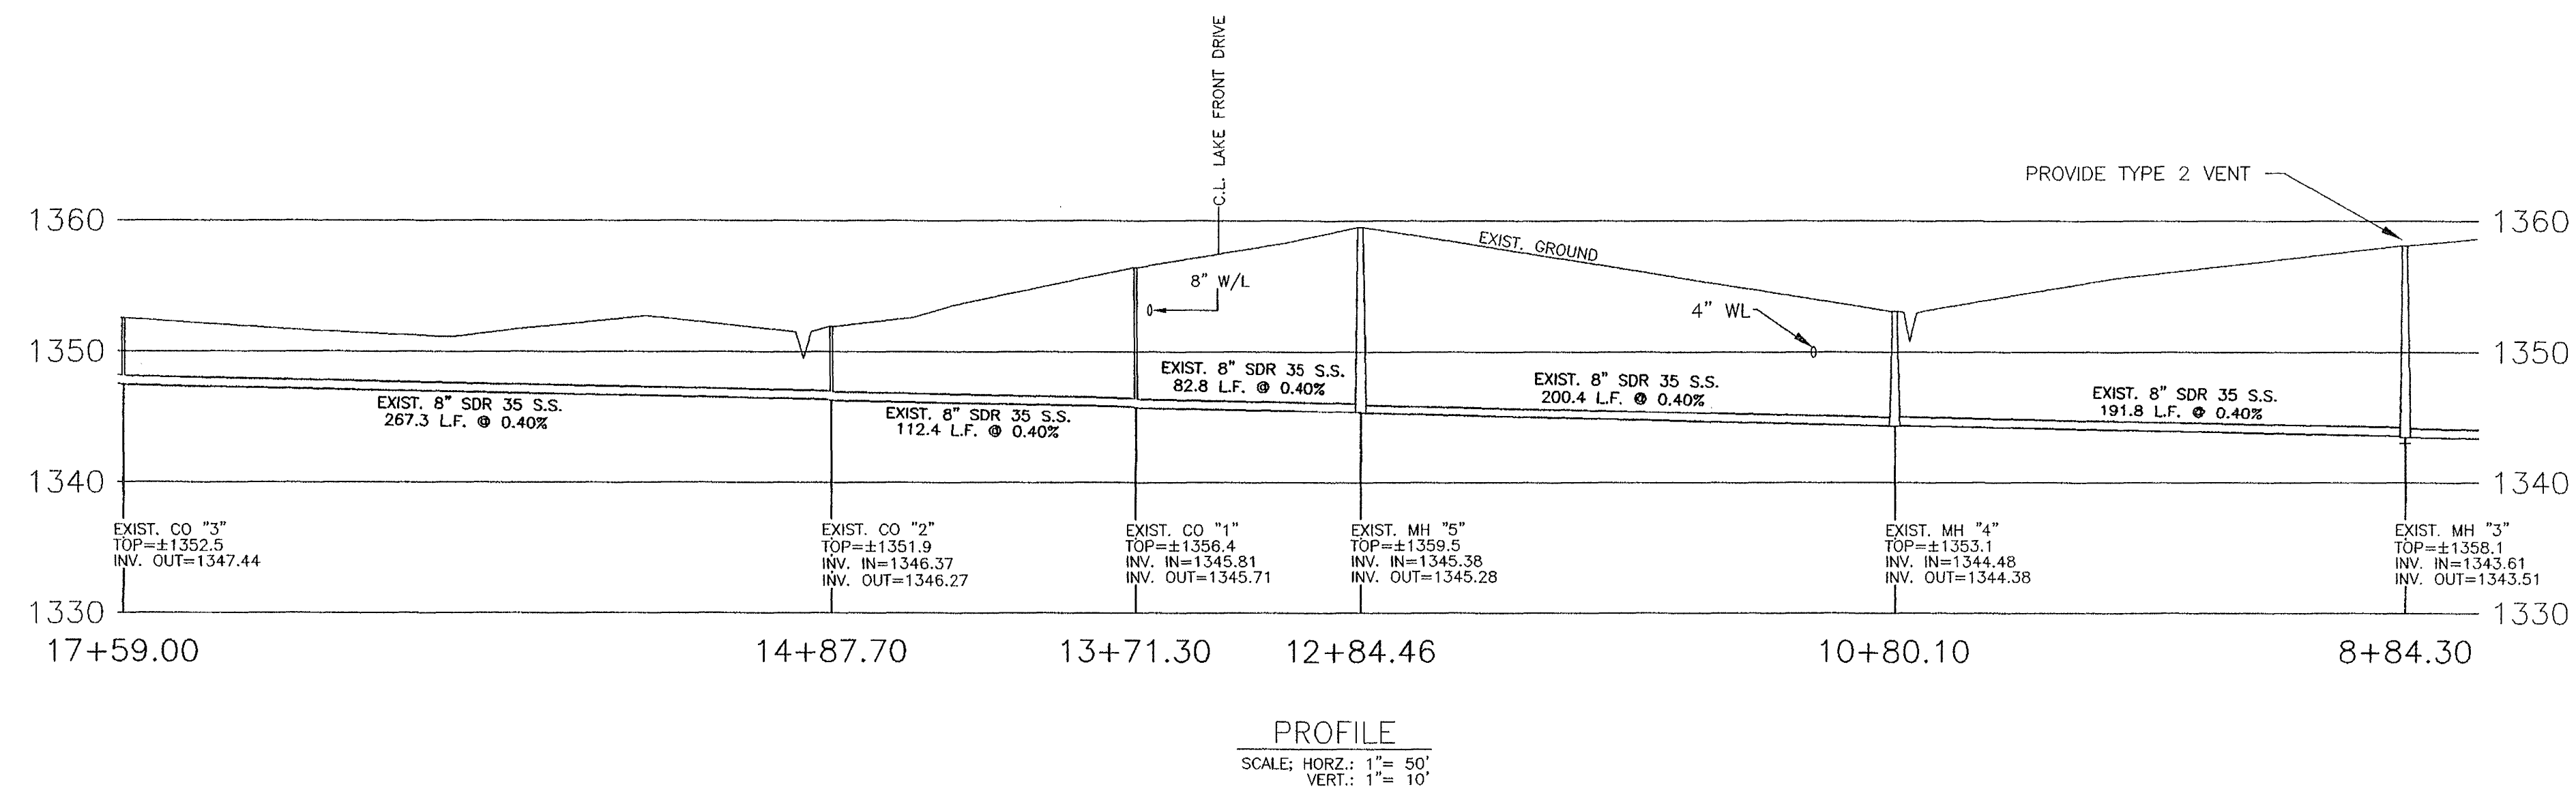
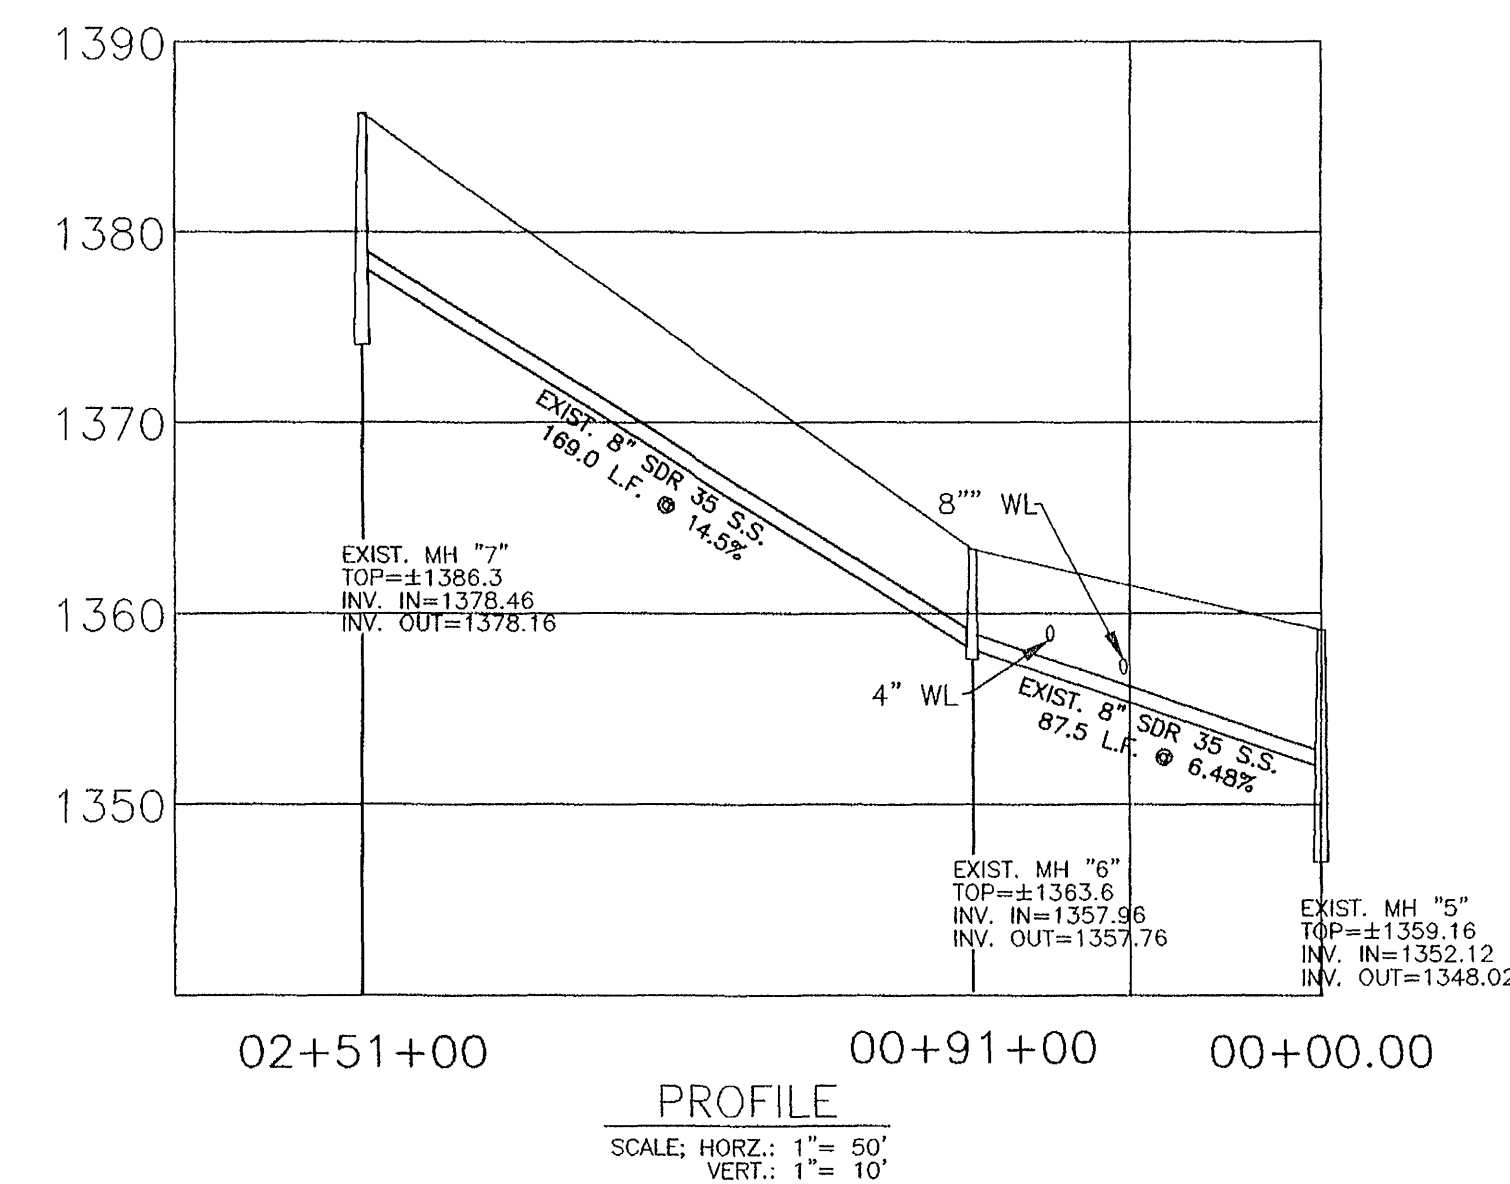
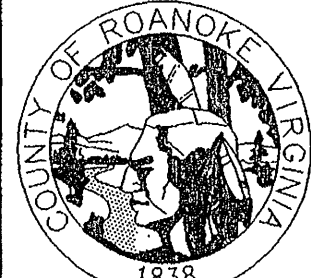


JAK	PROFILE WESTWARD LAKE SANITARY SEWER PROJECT CATAWBA MAGISTERIAL DISTRICT ROANOKE COUNTY, VIRGINIA
10-4-99	
AS-BUILT PLANS	 ROANOKE COUNTY UTILITY DEPARTMENT 1206 KESSLER MILL ROAD SALEM, VA 24153 WWW.ID# 6RNHMY SHEET 3 OF 4
DRAWN BY D.E.B.	
DESIGNED BY D.E.B.	
CHECKED BY	
PROJECT NO.	
SCALE: AS SHOWN	

SI - 22783