
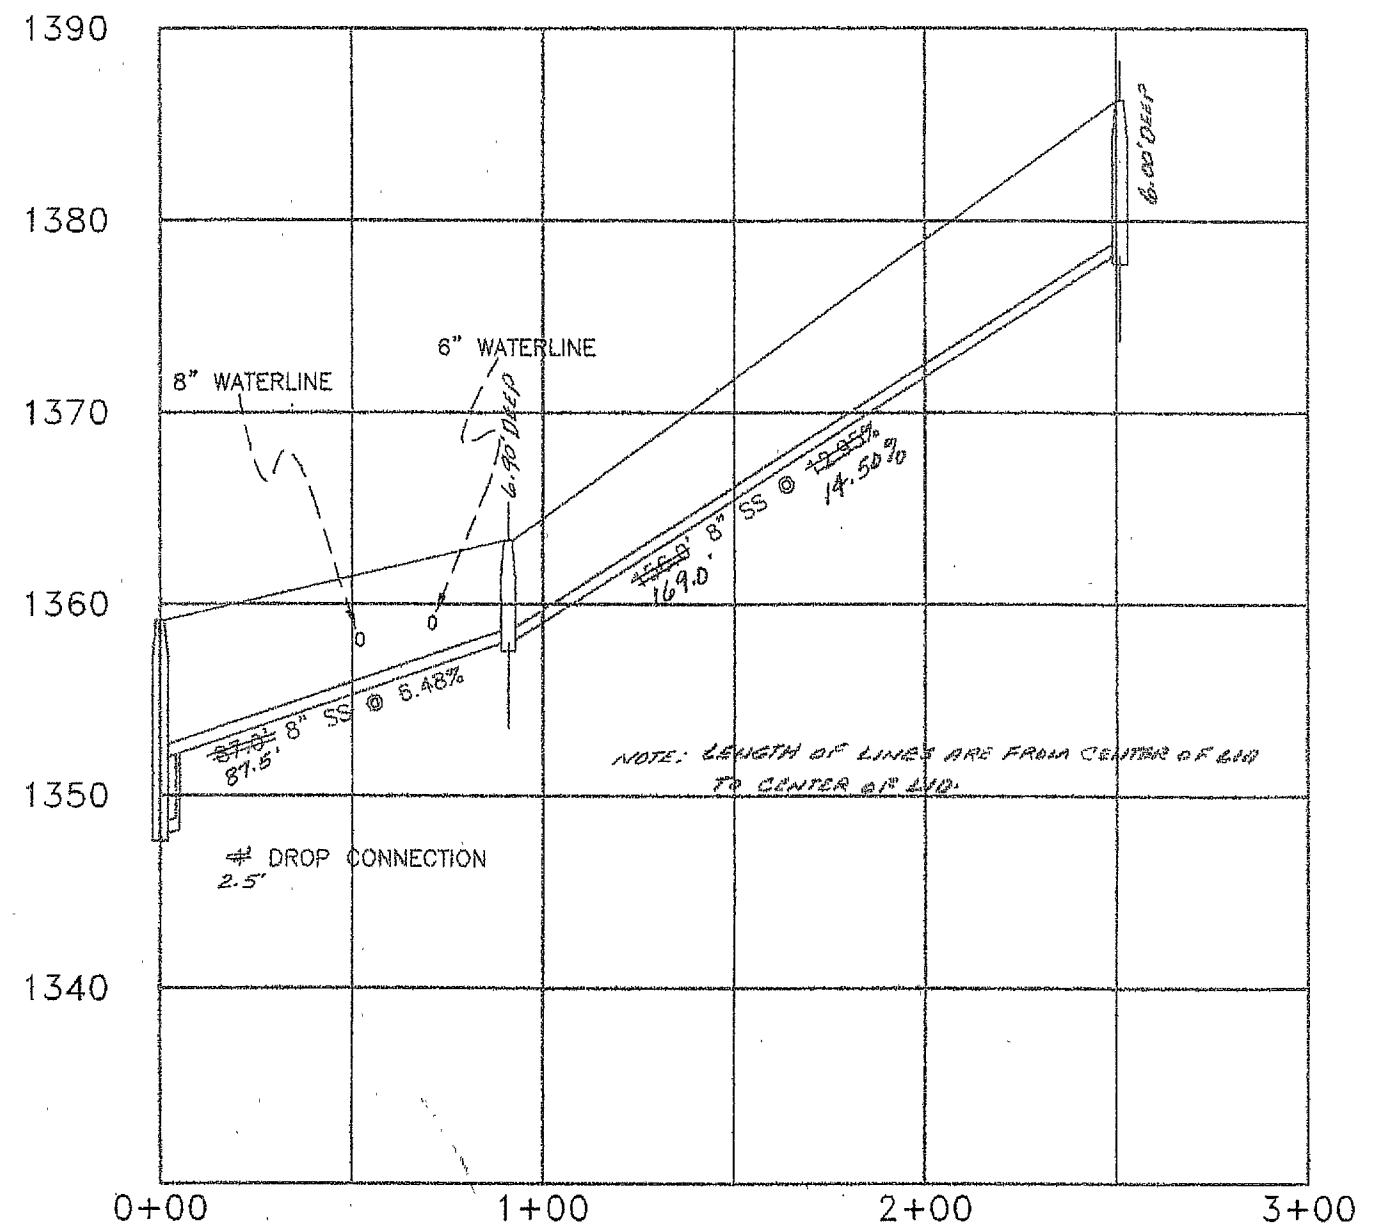


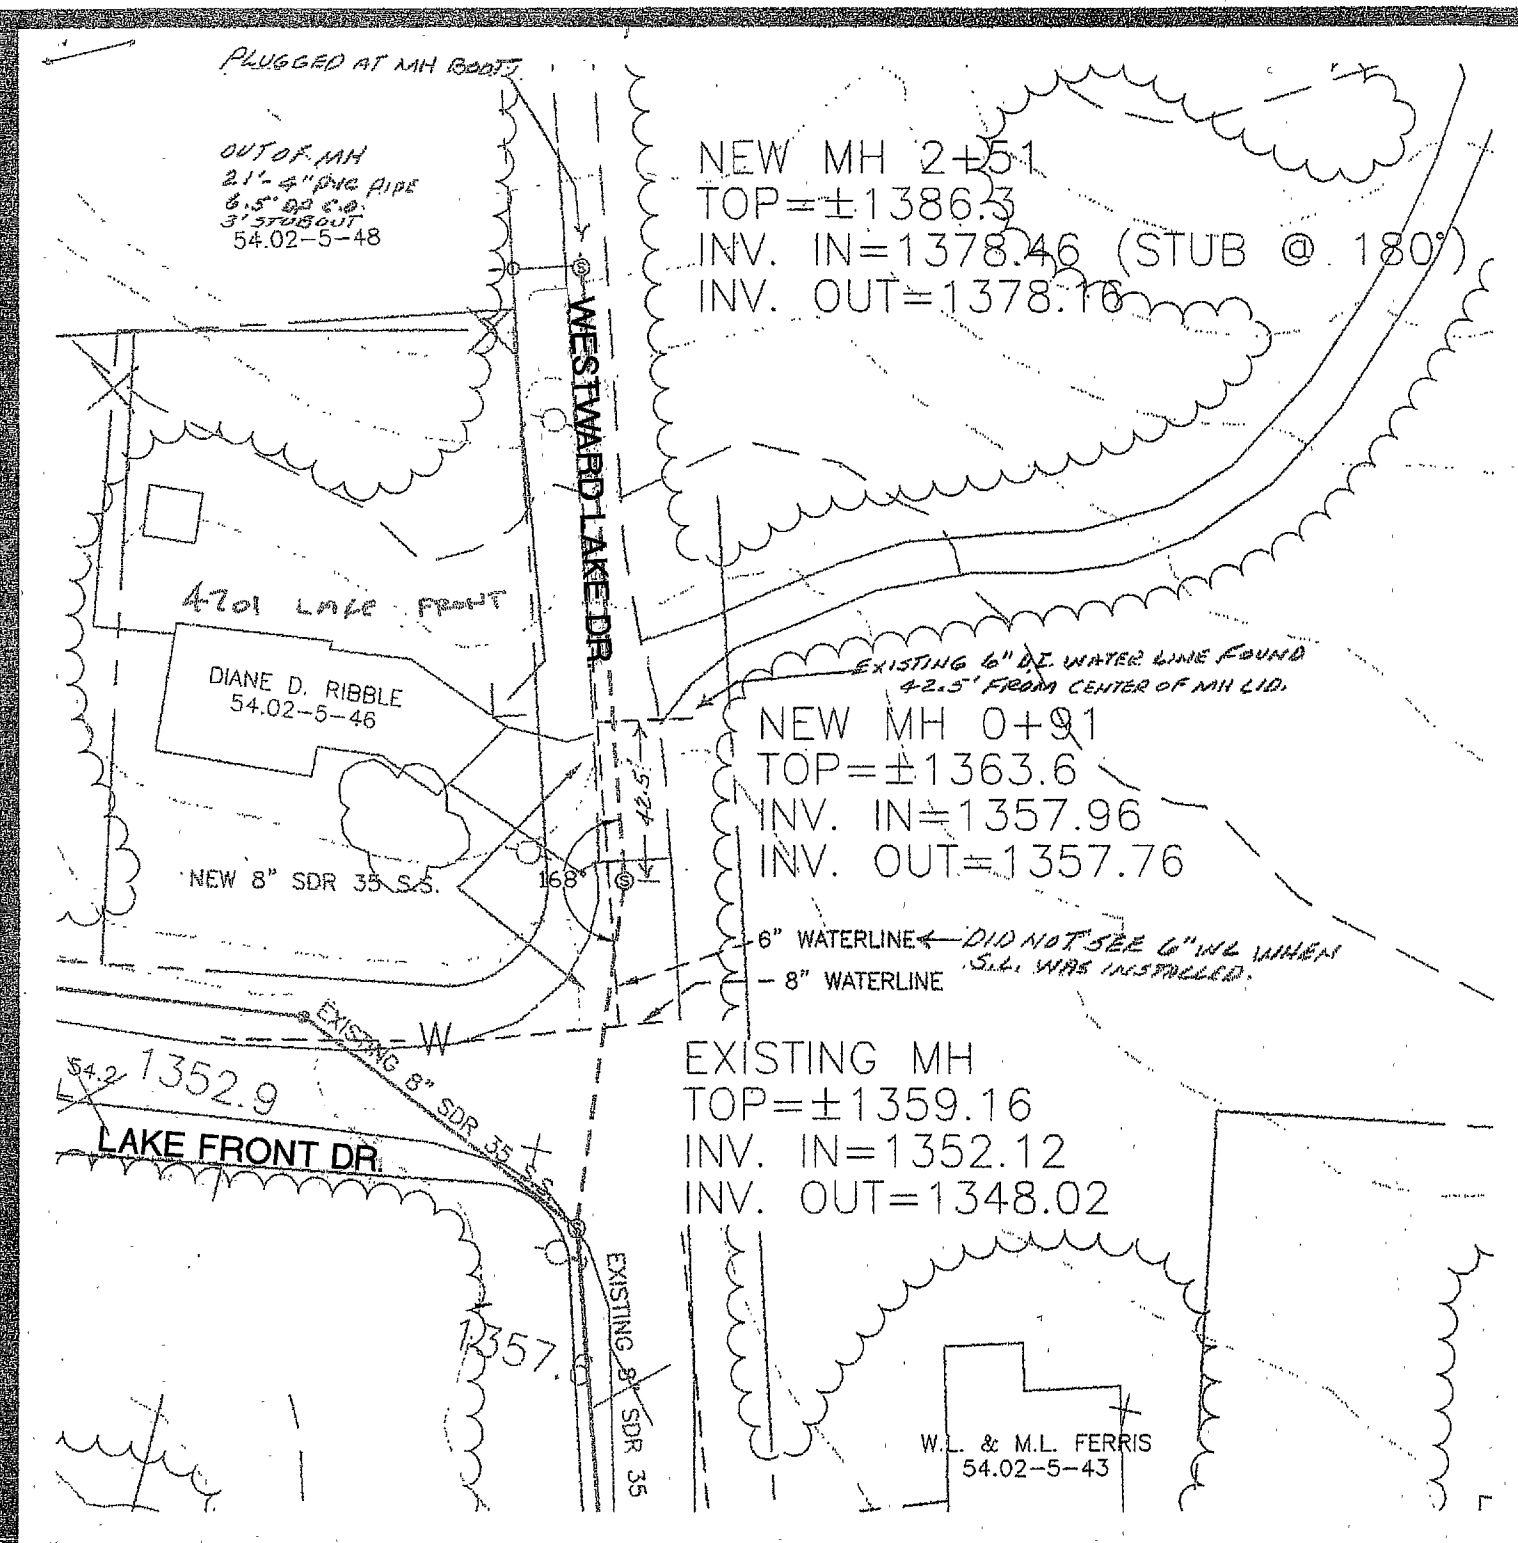

WESTWARD LAKE DR. S.L. EXTENSION  
APRIL 1999

AS BUILT

WVWA ID# 6RNHMY

SI - 000793