



NOTE: VDOT RESERVES THE RIGHT TO REQUIRE GUARDRAIL AT TIME OF FINAL INSPECTION. IF GUARDRAIL IS REQUIRED SHOULDER WIDTH MUST INCREASE BY TWO FEET.

NOTE: C&G-12 TO BE CONSTRUCTED AT ALL INTERSECTIONS (SEE DETAIL SHEET 5)

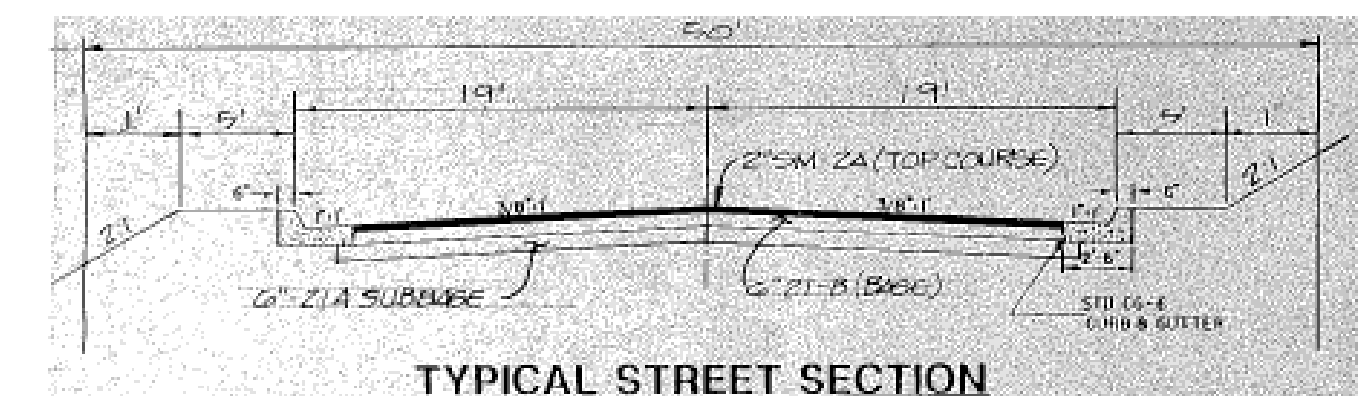

CBR NOTE: SUB-BASE DEPTH FOR SUB-GRADE BASED ALL SECTIONS ON CBR VALUE OF 10. SOIL TEST OF SUB-GRADE MUST BE TAKEN FOR ACTUAL DETERMINATION OF REQUIRED SUB-BASE THICKNESS PRIOR TO CONSTRUCTION.

CBR NOTE: SUB-BASE DEPTH FOR SUB-GRADE BASED ALL SECTIONS ON CBR VALUE OF 10. SOIL TEST OF SUB-GRADE MUST BE TAKEN FOR ACTUAL DETERMINATION OF REQUIRED SUB-BASE THICKNESS PRIOR TO CONSTRUCTION.

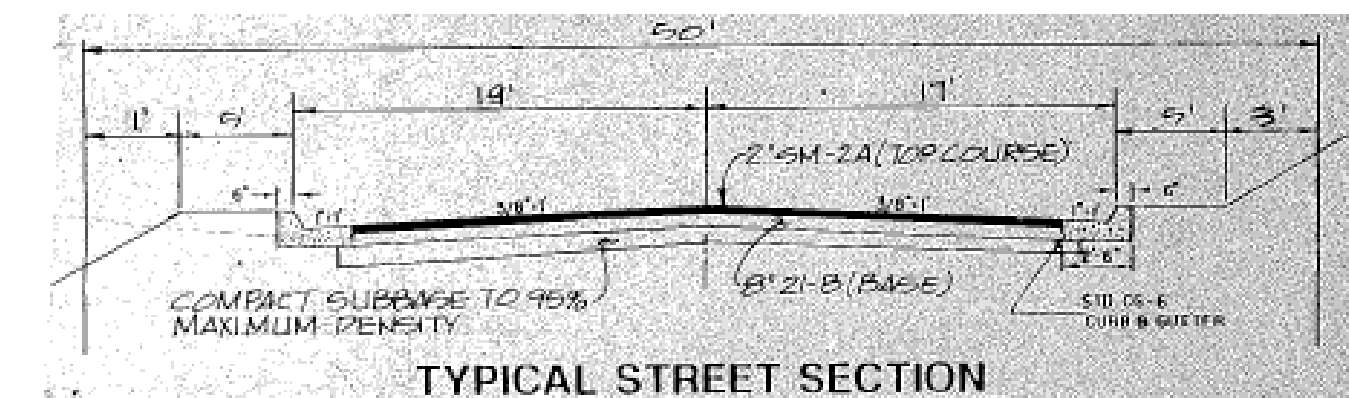


THE EXISTING UNDERGROUND UTILITIES SHOWN HEREON ARE BASED ON AVAILABLE INFORMATION. UTILITIES MAY EXIST WITHIN THE CONSTRUCTION AREA OF THESE PLANS THAT ARE NOT SHOWN. THE CONTRACTOR SHALL BE RESPONSIBLE FOR DETERMINING THE EXACT LOCATION AND DEPTH OF ALL UTILITIES BEFORE COMMENCING WORK, AND FOR ANY DAMAGES WHICH OCCUR BY HIS FAILURE TO LOCATE THESE UNDERGROUND UTILITIES. IF DURING CONSTRUCTION OPERATIONS THE CONTRACTOR SHOULD ENCOUNTER UTILITIES OTHER THAN THOSE SHOWN ON THESE PLANS, HE SHALL IMMEDIATELY NOTIFY THE ENGINEER AND TAKE NECESSARY AND PROPER STEPS TO PROTECT THE FACILITY AND ASSURE CONTINUANCE OF SERVICE. TO MISS UTILITIES, CALL "MISS UTILITIES" AT 1-800-552-7001 (TOLL FREE) 48 HOURS BEFORE DIGGING.

ALL CONSTRUCTION SHALL CONFORM TO THE COUNTY OF ROANOKE AND VIRGINIA DEPARTMENT OF TRANSPORTATION STANDARDS AND SPECIFICATIONS.


REMOVES AREA OF CONTROL FILL COMPACT TO 95% MAX DENSITY - PROVIDE POSITIVE DRAINAGE TO INLET 3.

HOMWOOD CIRCLE (90' R/W)
SCALE: 1"=50'

SEE SHEET 6 FOR STORM PROFILE

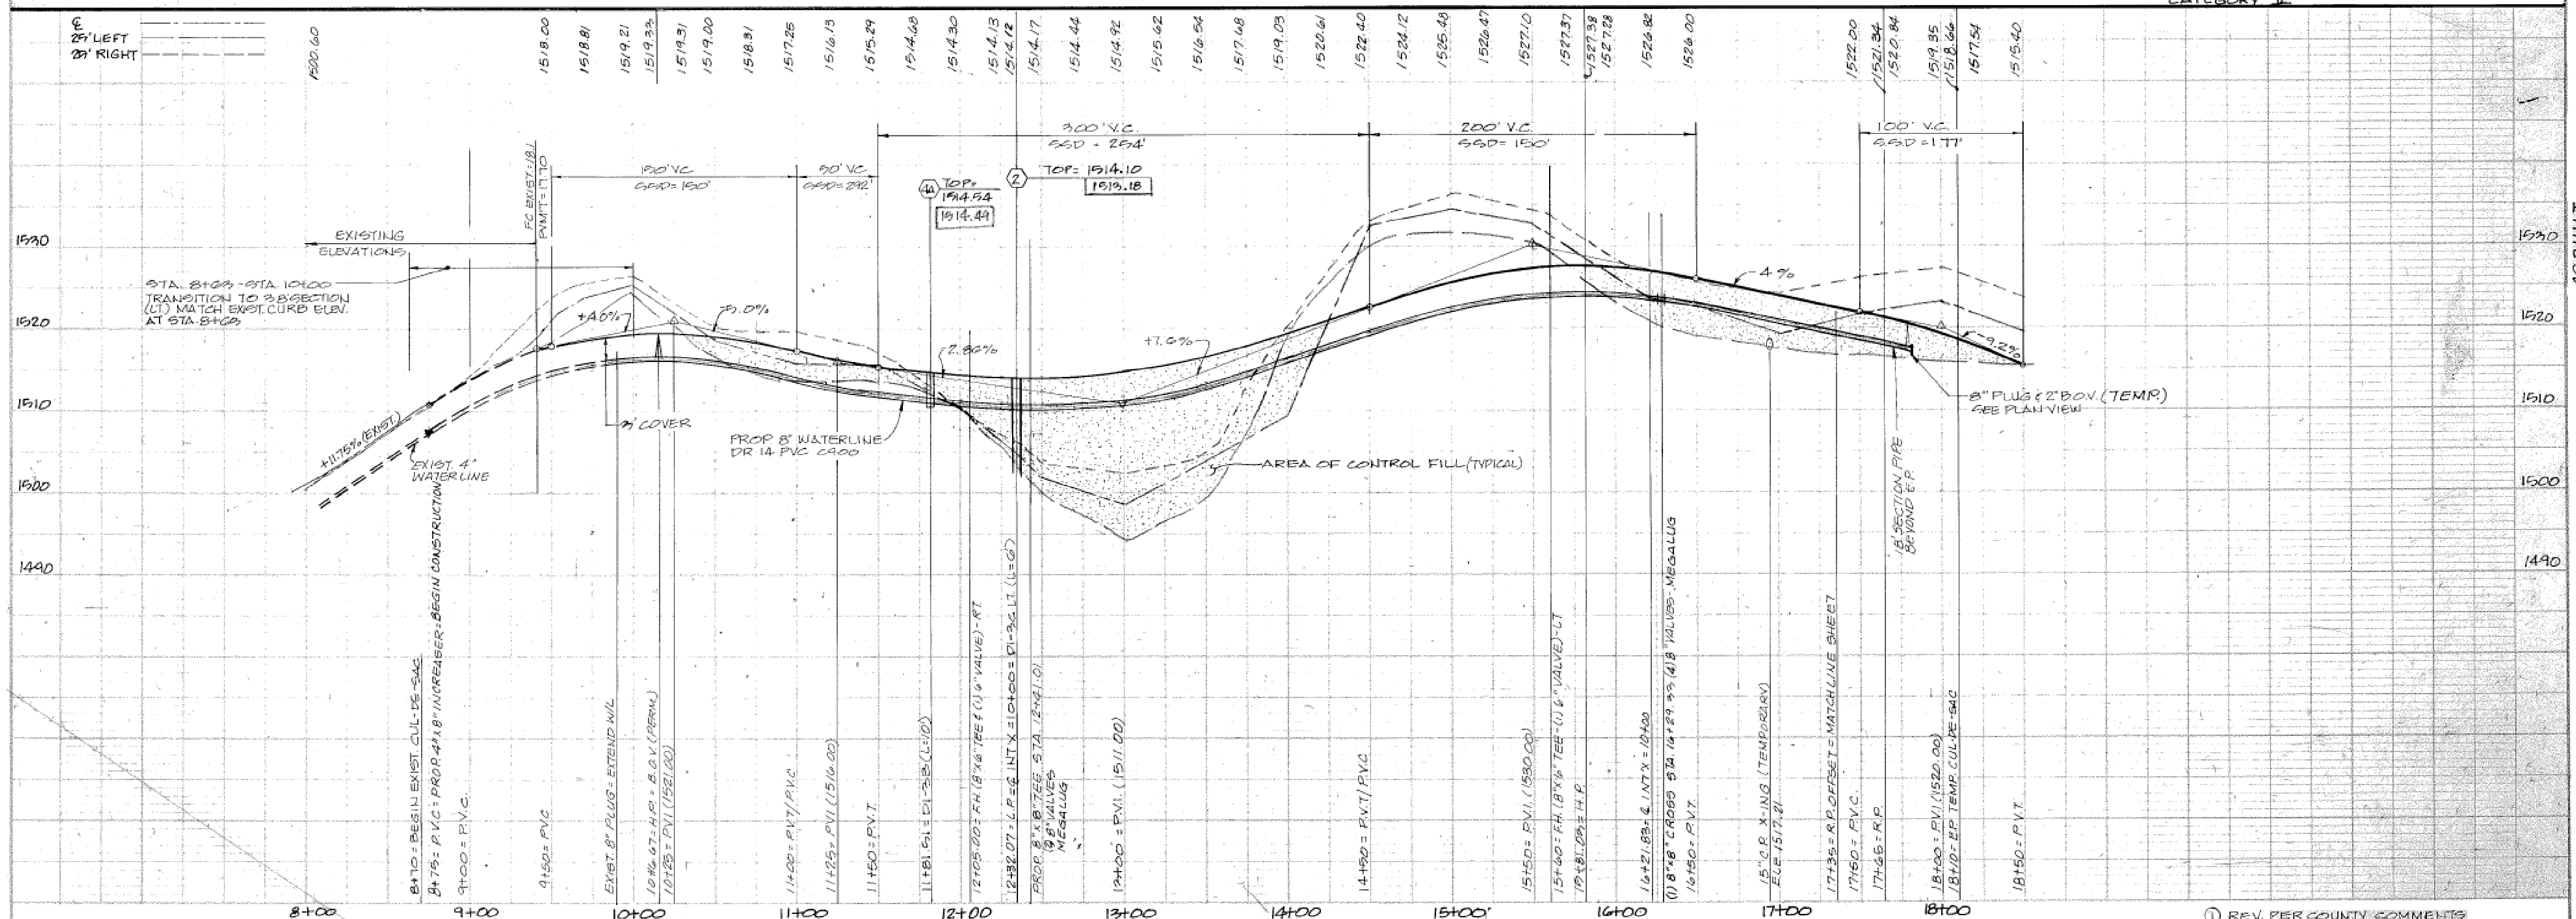

① REV. PER COUNTY COMMENTS
② REV. PER COUNTY COMMENTS
③ REV. E GRADES

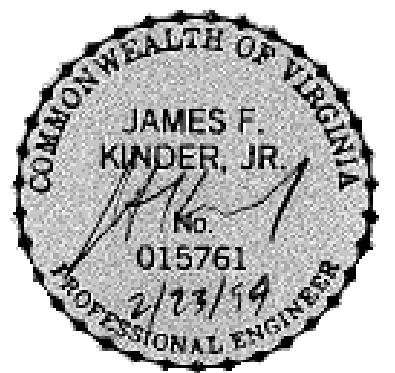

PLANNERS ARCHITECTS
ENGINEERS SURVEYORS

1208 Corporate Circle
Roanoke, Virginia 24018
Phone: 703/773-0580
FAX: 703/772-8050

501 Branchway Road
Suite 100
Richmond, Virginia 23226
Phone: 804/794-0571
FAX: 804/794-2635

1514 East Park Road
Richmond, Virginia 23228
Phone: 804/282-0046
FAX: 804/284-3037

ASBUILT
WEXFORD
PHASE I
PLAN & PROFILE
ROANOKE COUNTY, VIRGINIA

DRAWN BY: DRB
DESIGNED BY: JDE
CHECKED BY: JPK/JDE
DATE: FEB. 22, 1994

REVISIONS:
① MARCH 2, 1994
② APRIL 12, 1994
③ MAY 2, 1994
④ MAY 12, 1994

1"=50' HORIZ
SCALE 1"=10' VERT
SHEET NO.

3 OF 8

JOB NO.
93199

RC-5340