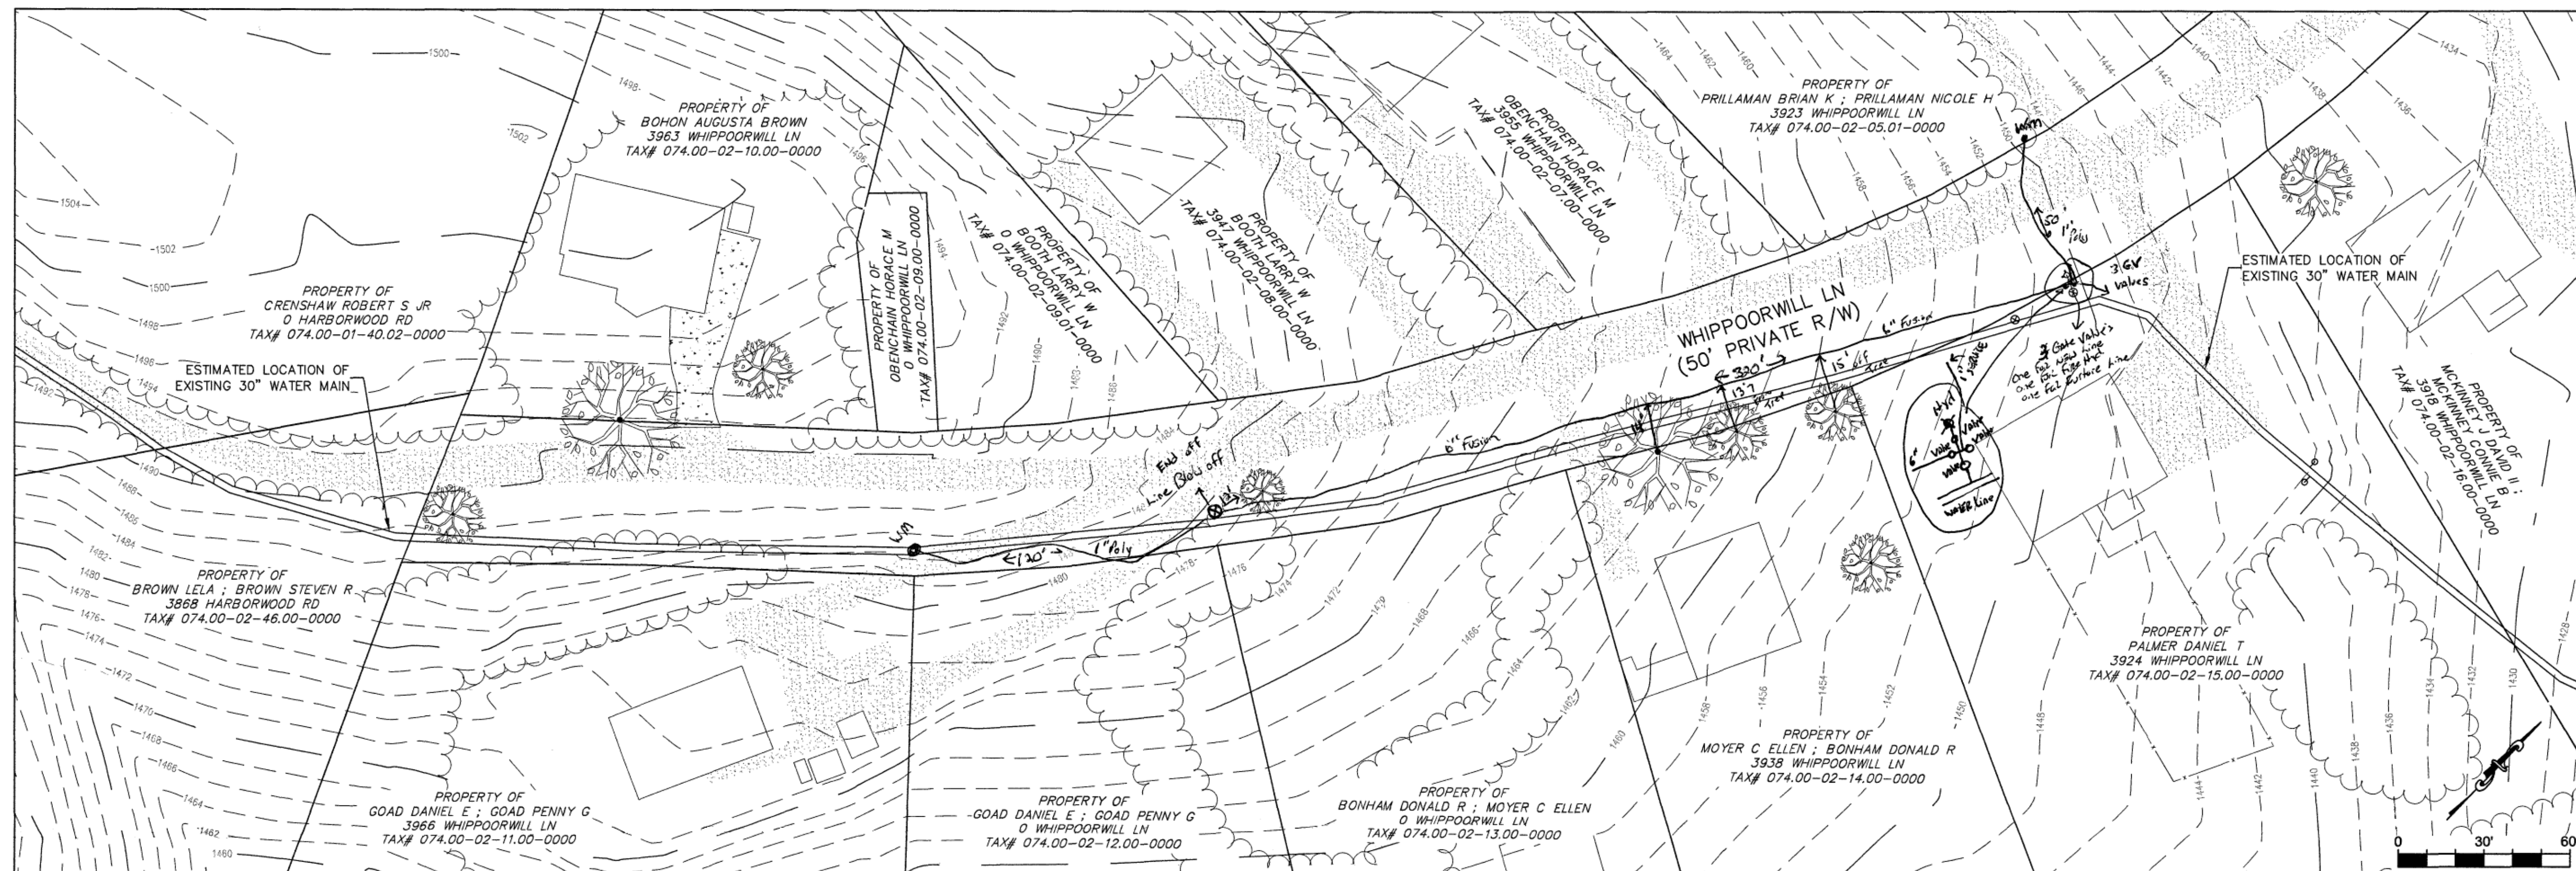



WESTERN VIRGINIA
WATER AUTHORITY

ENGINEERING SERVICES
601 S JEFFERSON ST, SUITE 300
ROANOKE, VA 24011
540-853-5700

3966 WHIPPOORWILL LANE
DIRECTIONAL DRILL WATER EXT.

BASEMAP

Install Contractor		
Construction Start Date		
Completion Date		
	Water Main(s)	
Manufacturer		
Diameter		
Pipe Class		
Material		
Comments		
	Water Service(s)	
Manufacturer		
Diameter		
Pipe Class		
Material		
Comments		
	Water Valve(s) 1	Water Valve(s) 2
Manufacturer		
Valve Type		
Diameter		
Direction to Open / Turns to Close		
Comments		
	Water Valve (s) 3	Water Valve (s) 4
Manufacturer		
Valve Type		
Diameter		
Direction to Close / Turns to Close		
Comments		
	Hydrant(s)	
Authority ID #		
Manufacturer		
Model		
Cast Date		
Static Pressure		
Comments		

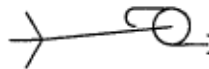LEGEND (EXISTING)		
WATER/FORCEMAIN	STORM	
VALVE		
AIR RELEASE		DROP INLET
BLOW-OFF/ FLUSHING ASSEMBLY		
SINGLE METER BOX		LARGE CURB INLET
DOUBLE METER BOX		
FIRE HYDRANT		SMALL CURB INLET
WELL		
	MANHOLE	
SEWER	OTHER	
MANHOLE		POWER POLE
CLEAN OUT		
		POWER POLE WITH GUY WIRE
		
GAS VALVE		LAMP POST
UTILITY PEDESTAL		
MAILBOX		TRAFFIC POLE
		
		SIGN
		

 DENOTES VALVE TO BE ABANDONED

GENERAL NOTES:
1. PROPERTY LINES SHOWN ON THIS PAGE ARE BASED ON GIS DATA AND HAVE NOT BEEN FIELD SURVEYED.

Donnie Rowen (Field Ops)
As-Built 07/17/2020

[illegible]