

WILLIAM FLEMING HIGH SCHOOL

Roanoke City Schools

3649 Ferncliff Avenue
Roanoke, Virginia 24017

CIVIL & LANDSCAPE ISSUED FOR CONSTRUCTION

MAY 15, 2007

**PERKINS
+ WILL**

1382 Peachtree St. NE
Atlanta, GA 30309
t 404.873.2300
f 404.892.5823
www.perkinswill.com

**Rife + Wood
ARCHITECTS**

In association with:

Caldwell White Associates

Civil Consultant
4203 Monroe Avenue
Roanoke, Virginia 24017
540-368-3400 (o) 540-368-8702 (f)

Faassen & Associates

Food Service Consultant
8576 Sunflower Drive
Charlotte, North Carolina 28227
704-536-9234 (o) 704-535-4200 (f)

Lawrence Perry & Associates

Mechanical & Electrical Consultants
304 West Church Avenue
Roanoke, Virginia 24011
540-342-1816 (o) 540-344-3410 (f)

R.A. Meador

Landscape Consultant
P.O. Box 372
Hardy, Virginia 24011
840-880-4533 (o)

Stewart Acoustical Consultants


Acoustical Consultant
7406 L Chapel Hill Road
Raleigh, North Carolina 27607
919-558-9859 (o) 919-558-9878 (f)

Uzun & Case Engineers

Structural Consultant
1180 West Peachtree Street
Suite 1206
Atlanta, Georgia 30309
678-553-5200 (o) 678-553-5210 (f)

**WILLIAM FLEMING
HIGH SCHOOL**

School Site Project No. 124-40A
Literary Loan No. 11255

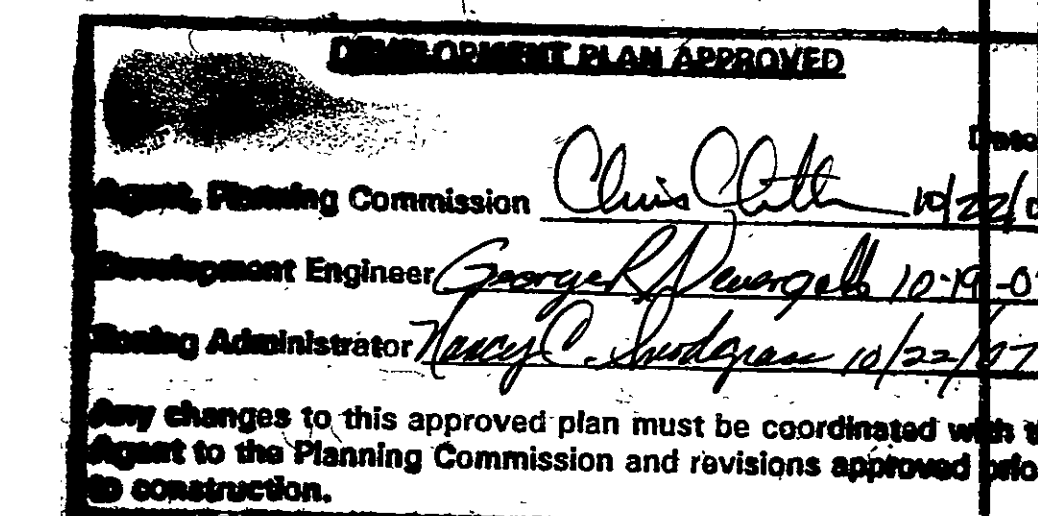


KEY PLAN

NUMBER ISSUE DATE

Revisions

Copyright © 2007 PERKINS + WILL

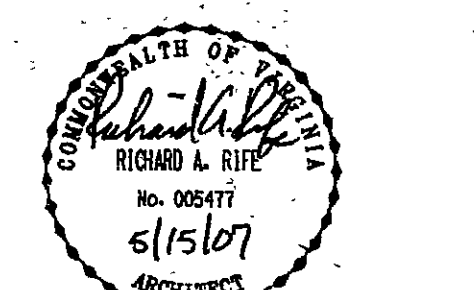

Sheet Information

Date MAY 15, 2007
Job Number 800372.000
Scale
Drawn
Checked
Approved


Title

COVER SHEET
CIVIL &
LANDSCAPE

Sheet

A-000

ISSUED FOR CONSTRUCTION

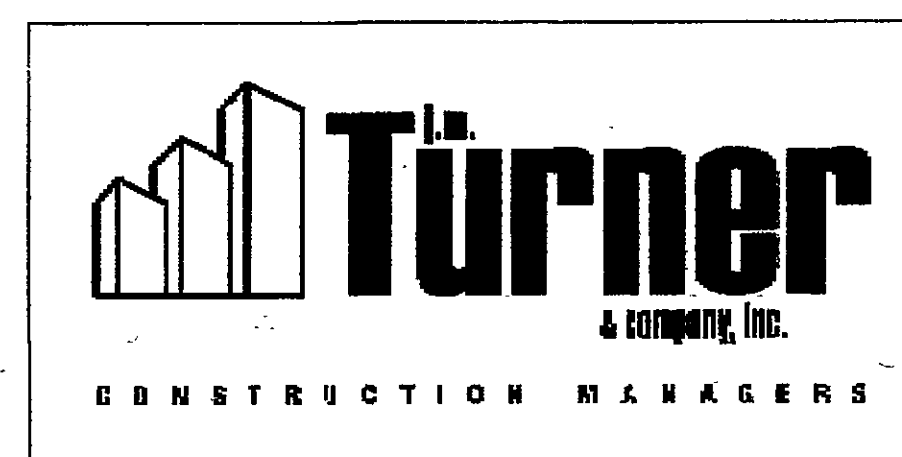

J.M. Turner & Company
130 Church Avenue, Roanoke, Virginia 24011
(540) 343-6749 fax: (540) 343-6031

**Rife + Wood
ARCHITECTS**
1326 Grandin Road Roanoke, Virginia 24015
(540) 344-6015 fax: (540) 344-5982

**PERKINS
+ WILL**

Architecture . Interiors . Planning
1382 Peachtree Street NE
Atlanta, Georgia 30309 USA
404.873.2300 Fax: 404.892.5823
www.perkinswill.com

Beijing . Boston . Charlotte/RTP . Chicago
Dallas . Houston . Los Angeles . Miami
Minneapolis . New York . Shanghai

In association with:

R.A.Meador

Stewart Acoustical Consultants

Uzun & Case Engineers

RECEIVED

SEP 2 6 2007

CITY OF ROANOKE

PLANNING BUILDING AND DEVELOPMENT

Caldwell White Associates
Faassen & Associates
Lawrence Perry & Associates, Inc

As-Built 7.14.09 K. Winslow

CP070035 LD070046