


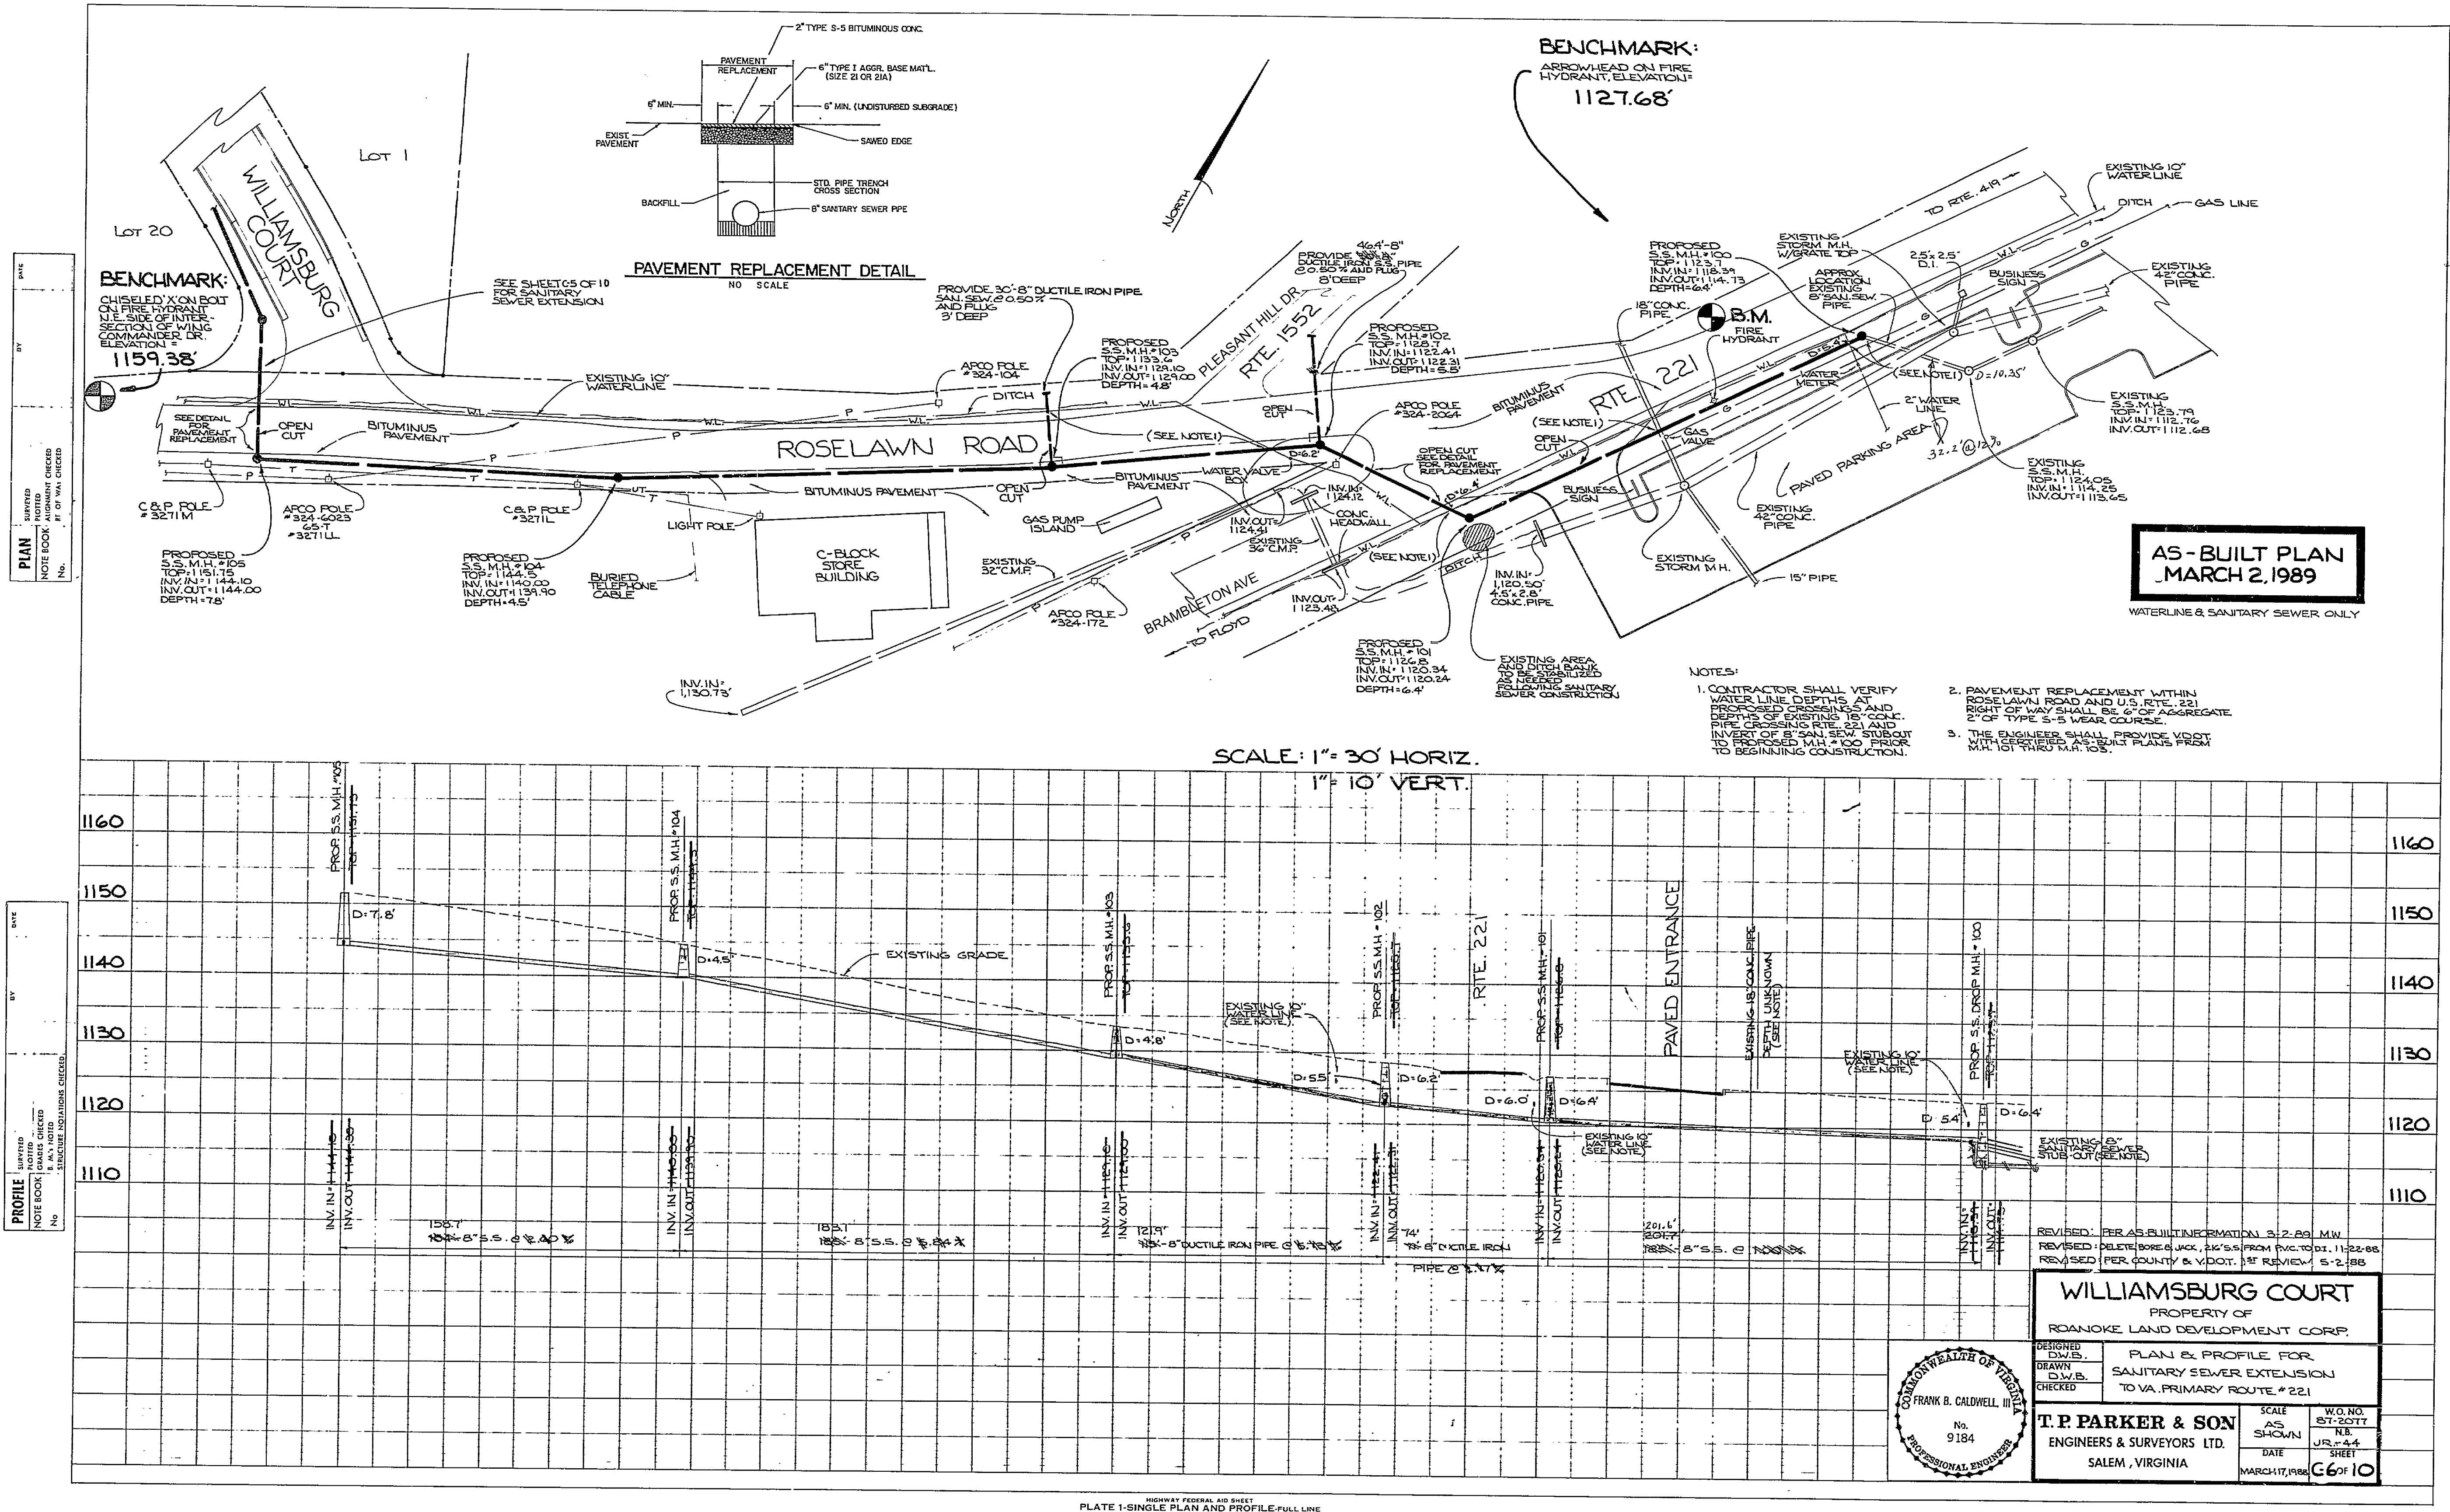

AS-BUILT PLAN
MARCH 2, 1989
WATERLINE & SANITARY SEWER ONLY

WILLIAMSBURG COURT
PROPERTY OF
ROANOKE LAND DEVELOPMENT CORP.

DESIGNED BY: T.P. PARKER & SON
DRAWN BY: T.P. PARKER & SON
CHECKED BY: T.P. PARKER & SON

PLAN & PROFILE FOR
SANITARY SEWER EXTENSION
TO VA PRIMARY ROUTE #221

T.P. PARKER & SON
ENGINEERS & SURVEYORS LTD.
SALEM, VIRGINIA

SCALE: AS SHOWN
DATE: MARCH 17, 1989
SHEET: 10 OF 10

PC-0316