

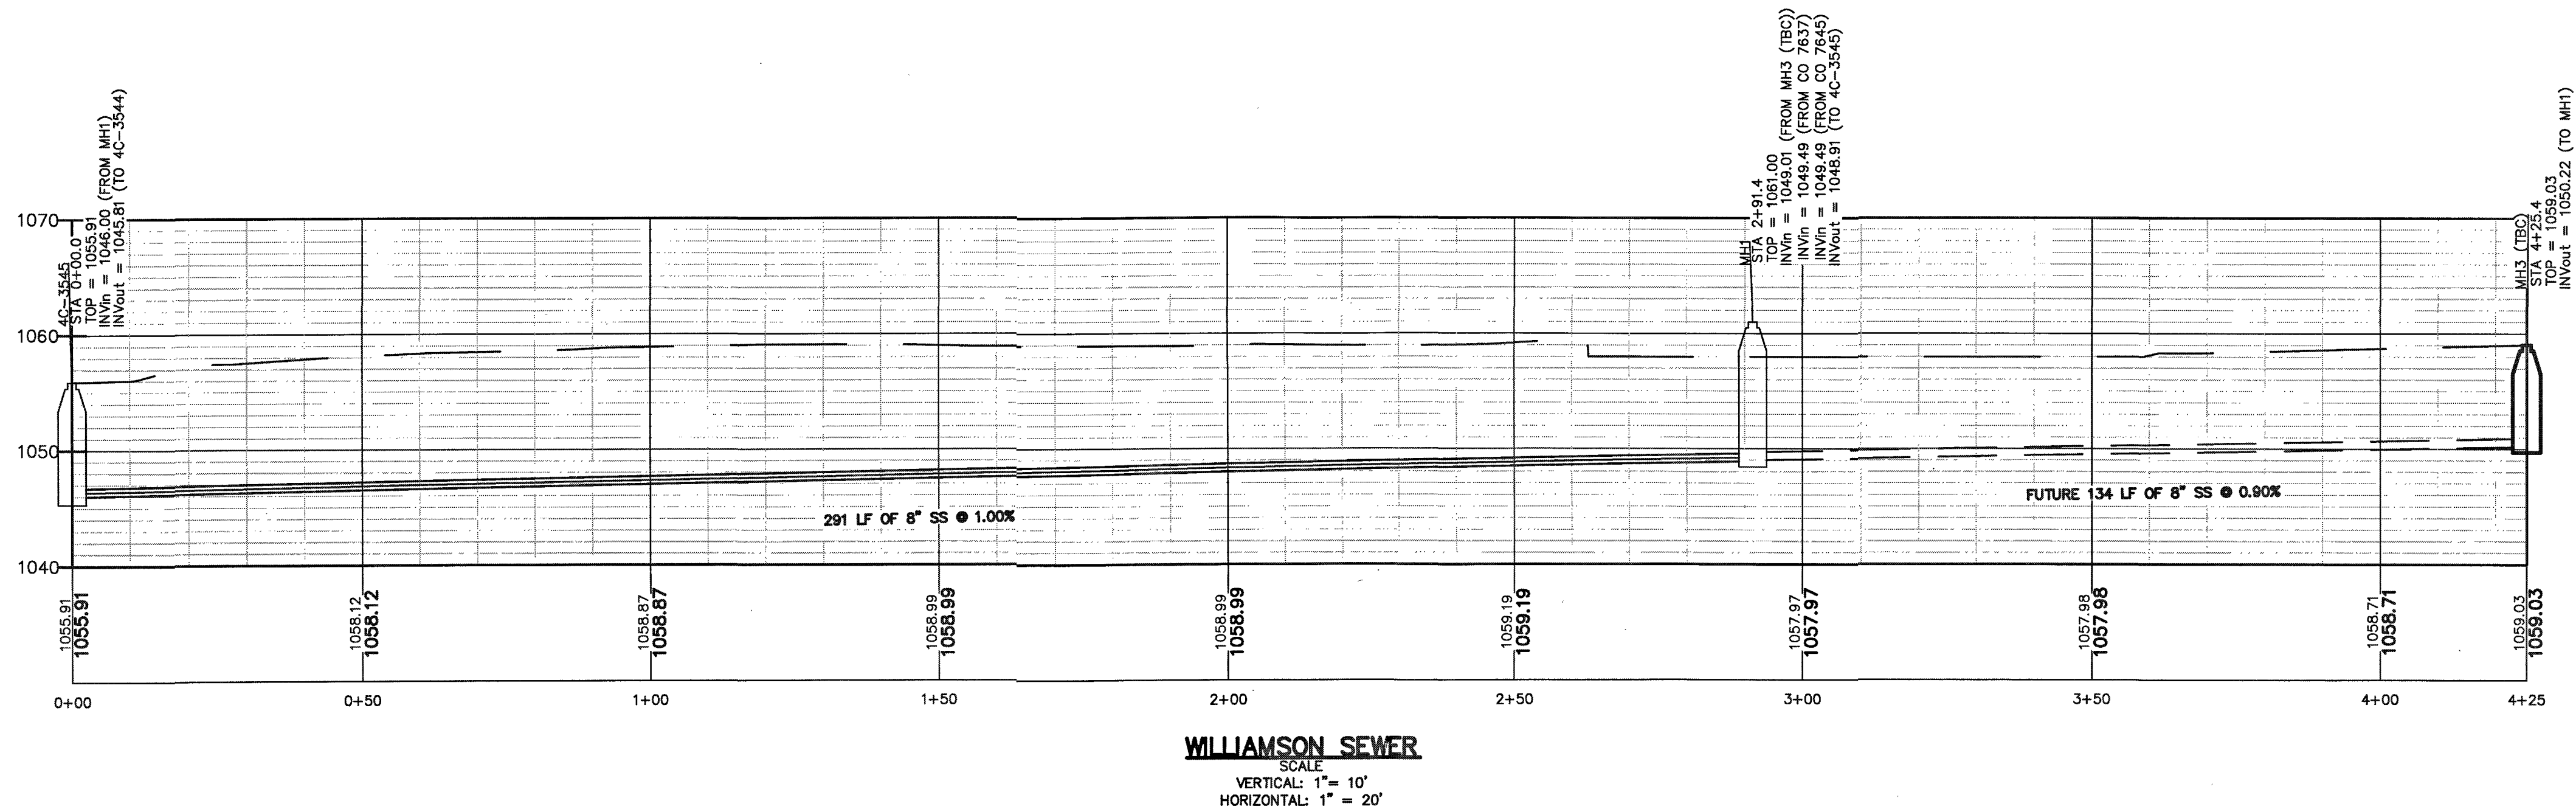


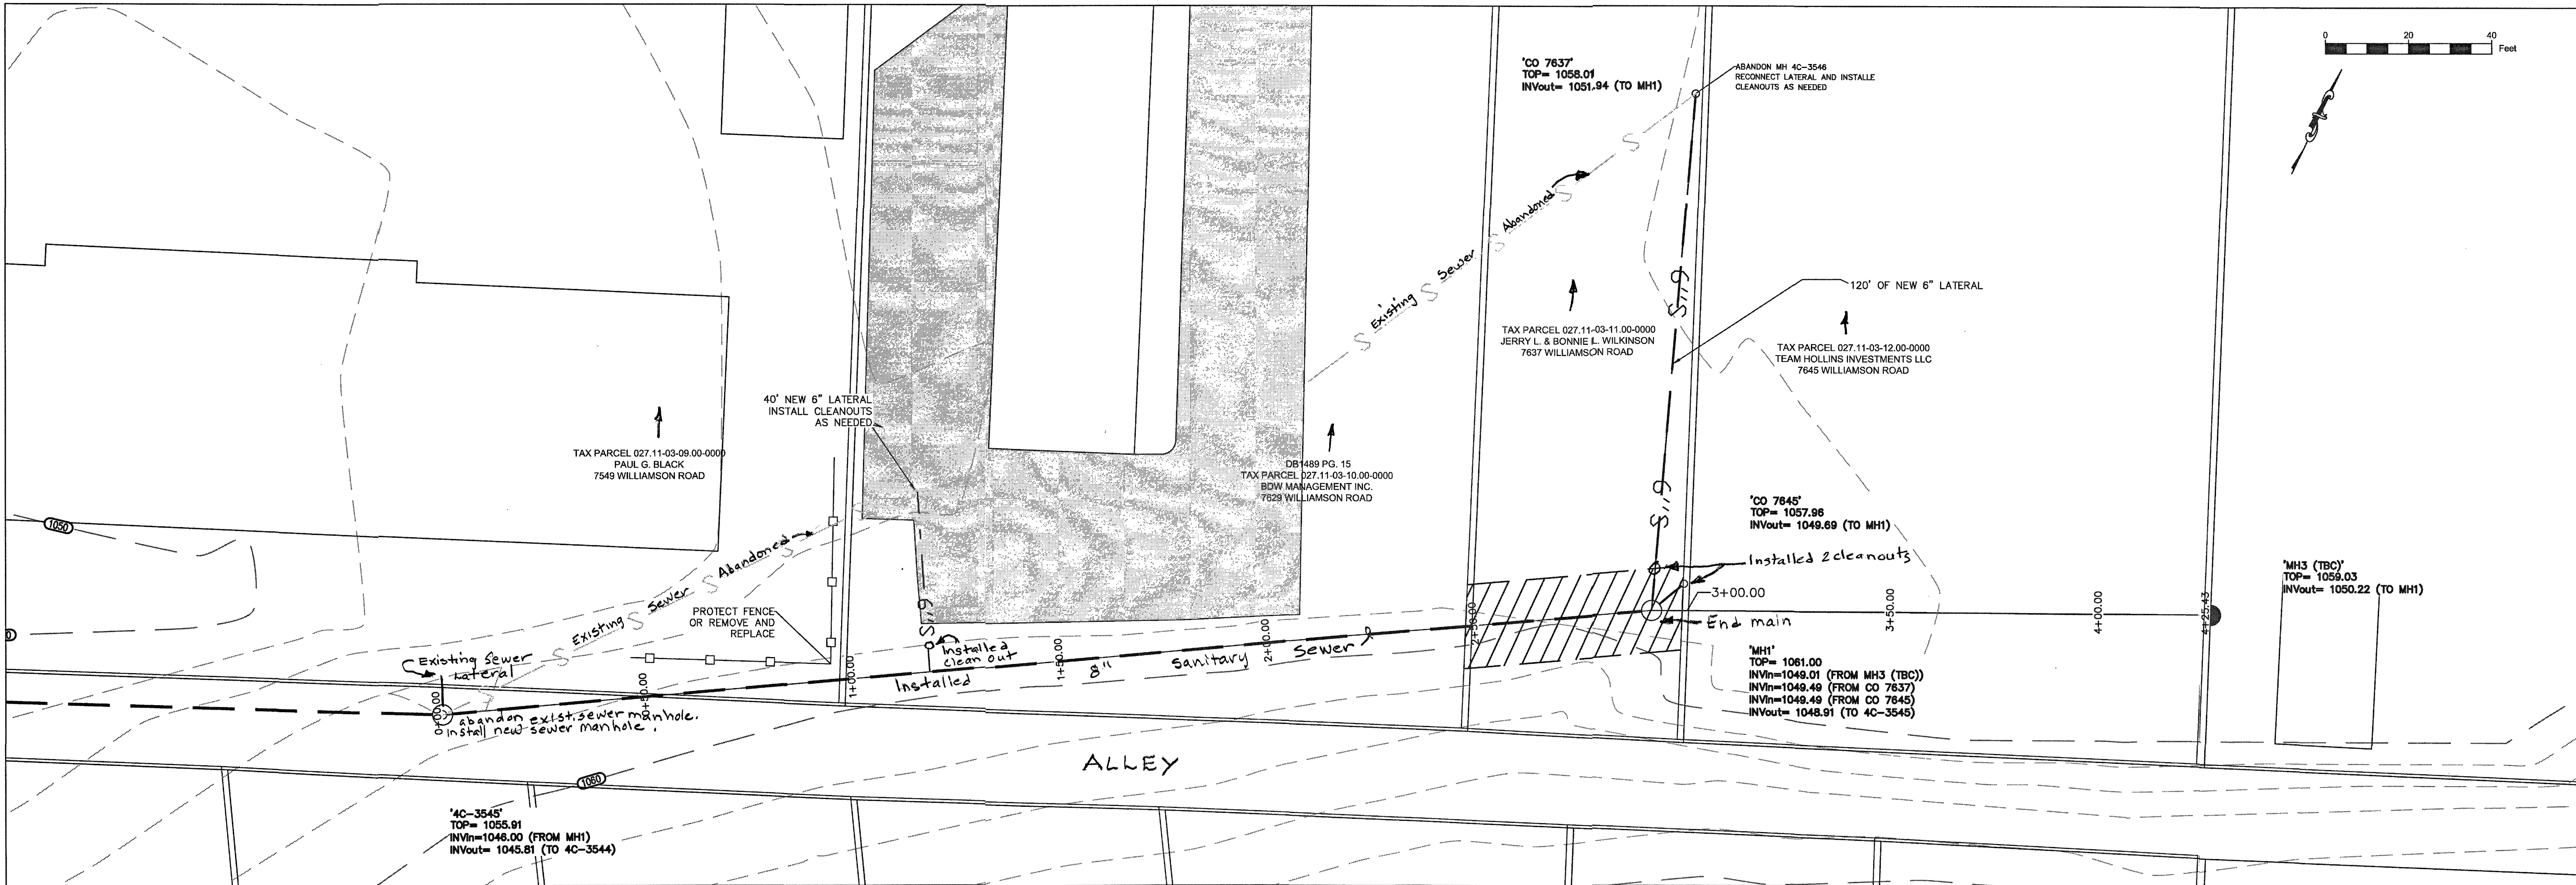

WILLIAMSON SEWER
SCALE
VERTICAL: 1" = 10'
HORIZONTAL: 1" = 20'

As-Built 11/20/2015 (Substantial Completion)
Installed by:
Western Virginia Water Authority -
Field Operations.

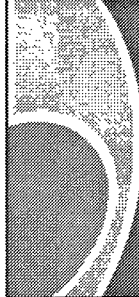

WESTERN VIRGINIA

WATER AUTHORITY

ENGINEERING SERVICES

601 S JEFFERSON ST, SUITE 300

ROANOKE, VA 24011

540-853-5641 or 540-853-5770

7629 WILLIAMSON SEWER

PLAN & PROFILE

Rev	Description	Date	By

Designed: AAS

Drawn: AAS

Checked:

Approved:

Date: 11-11-14

Project:

Sheet 1 of 1