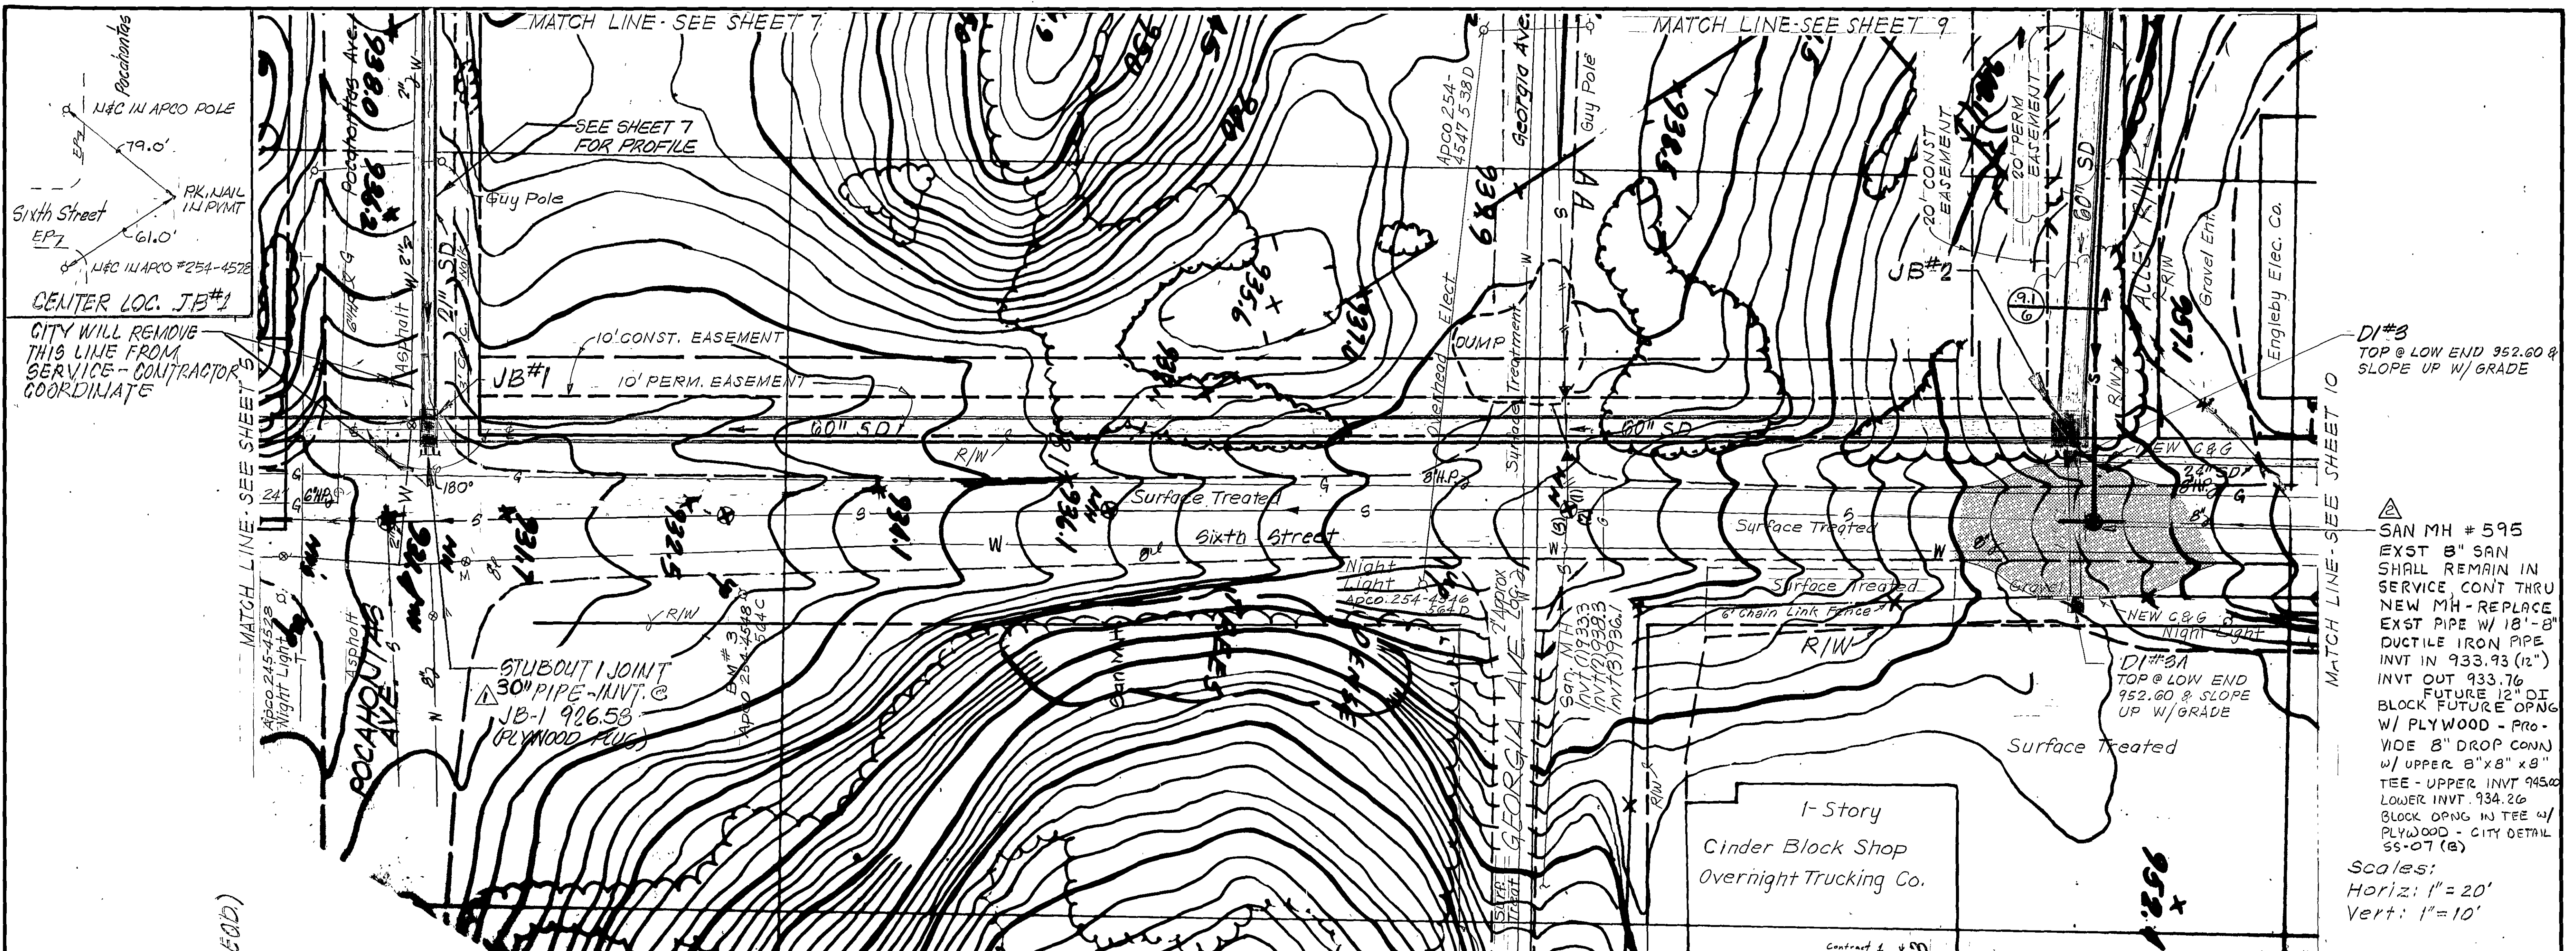


PROFILE

AS BUILT

NOTE: ALL JUNCTION BOX RIGIDS SHALL BE 4' Ø & SUITABLE TO EXTEND TO NEW ELEV. OF DEANWOOD PROJECT.

Mattern & Craig CONSULTING ENGINEERS 5141 401, 707 S. JEFFERSON STREET, ROANOKE, VIRGINIA 24011 (703) 345-9342	DESIGNED: DRM	NORTH	REVISION 1. 10-19-83 PER CHANGE ORDER, NO. 1 2. 10-26-83 ADD SAN SEWER	DATE JULY 1983	BY SWH	DATE JULY 1983	WILLIAMSON ROAD STORM DRAIN - PHASE 1 CONTRACT I-A ROANOKE, VIRGINIA	SHEET 6
	CHECKED: JMA				COMM. 428		PLAN AND PROFILE	# 5825 I-A
	APPROVED: SWH							