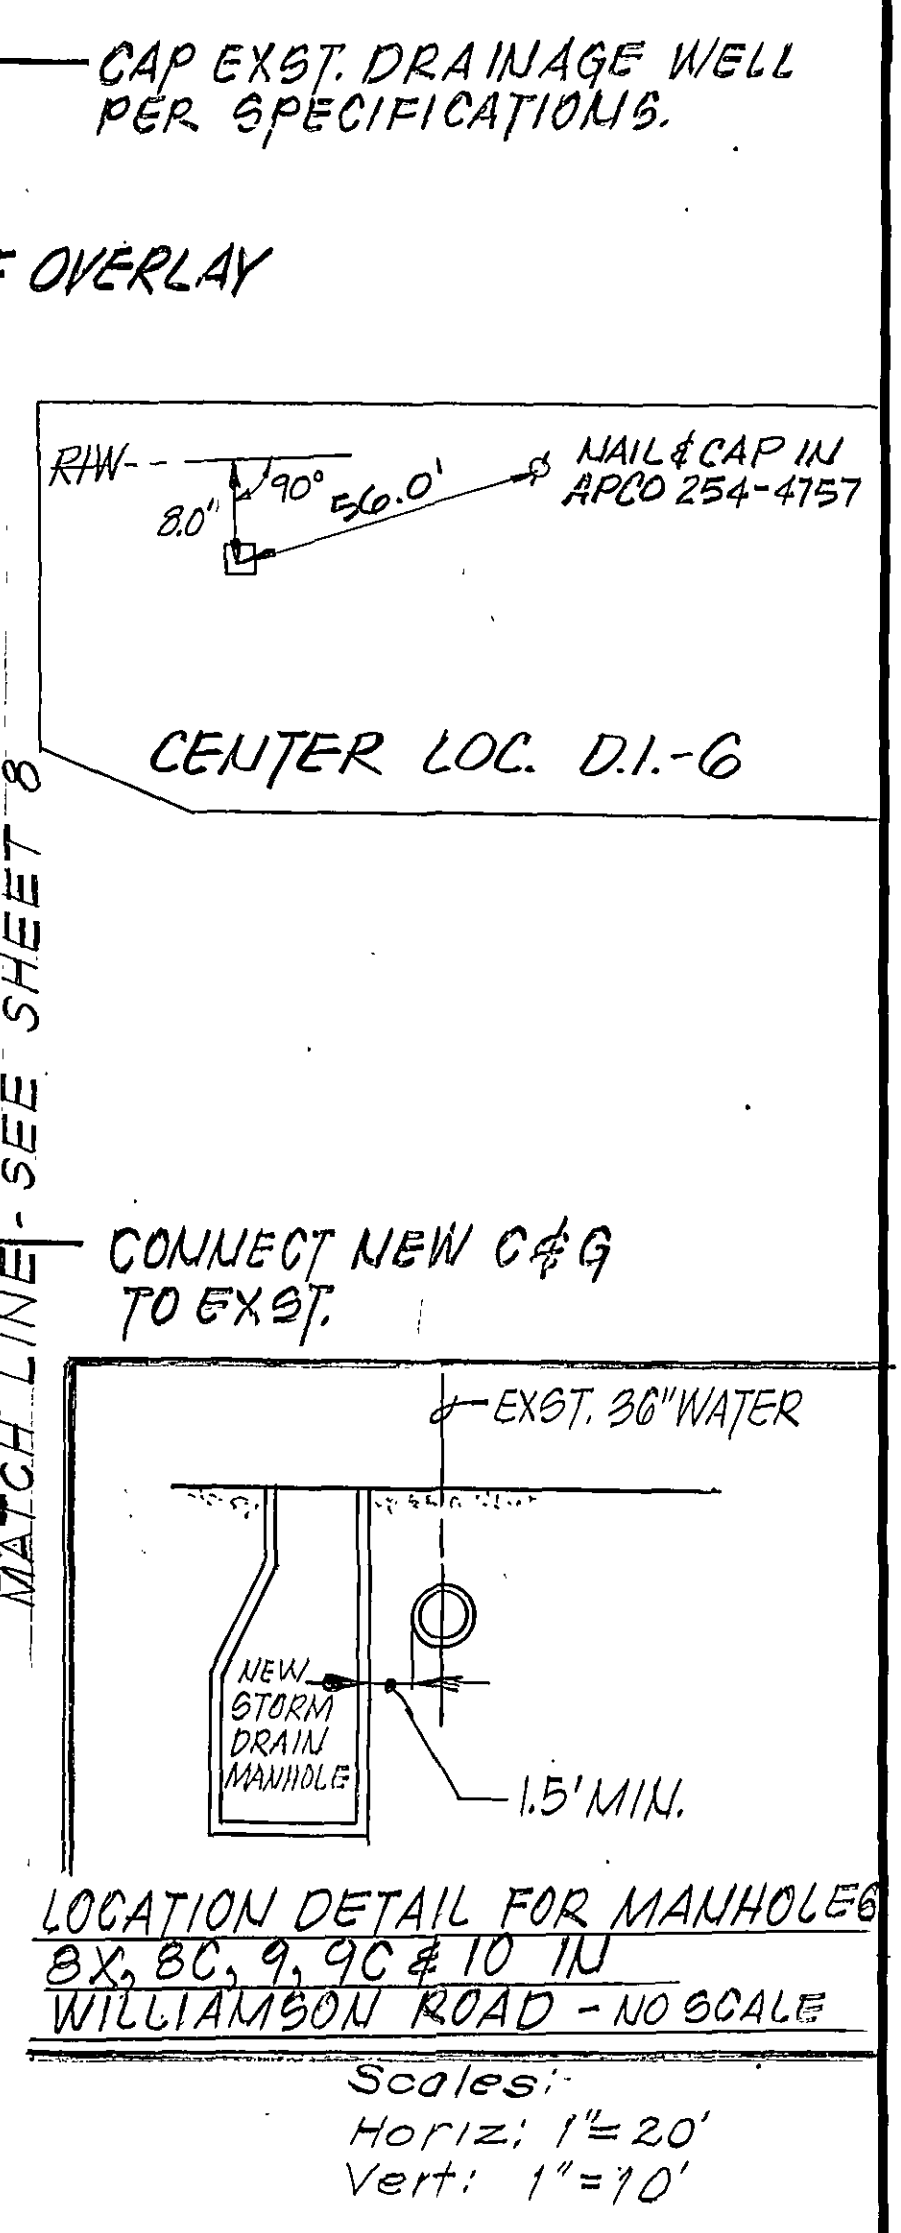
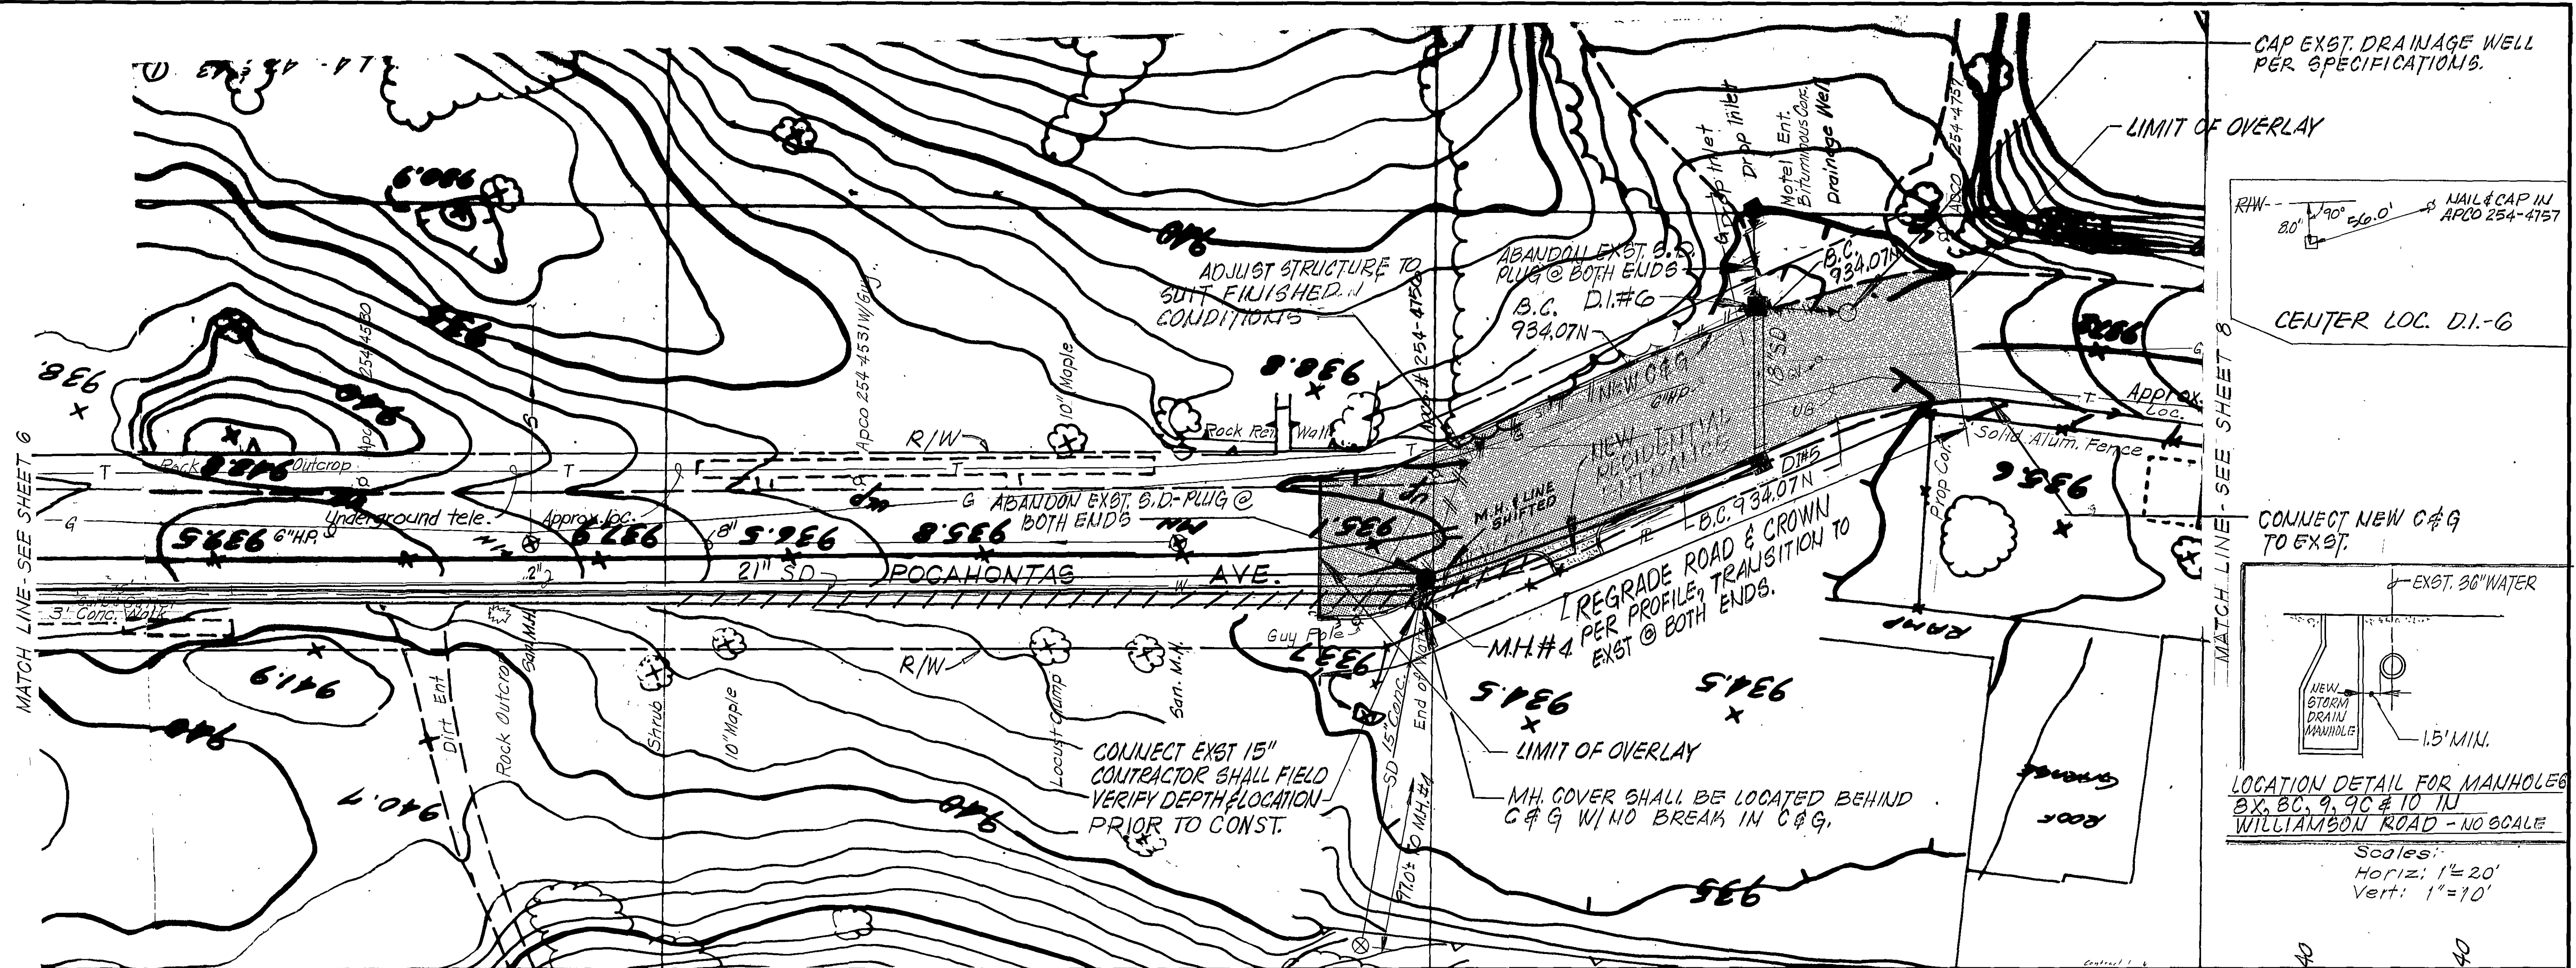


NOTE: 1. CONTRACTOR SHALL FIELD VERIFY DEPTH AND LOCATION OF ALL UNDERGROUND TELEPHONE & GAS MAINS PRIOR TO CONSTRUCTING ANY WORK ON THIS SHEET.

AS BUILT

SUITE 401, 707 S. JEFFERSON STREET ROANOKE, VIRGINIA 24011 (703) 345-9342	DESIGNED: DRM		REVISION	DATE	DESCRIPTION	BY	APP.	DATE	WILLIAMSON ROAD STORM DRAIN - PHASE 1 CONTRACT I-A ROANOKE, VIRGINIA	SHEET 7 #5825 I-A	
	CHECKED: <i>[Signature]</i>										JULY 1983 COMM. 428
	APPROVED: <i>[Signature]</i>										
	PLAN AND PROFILE										