
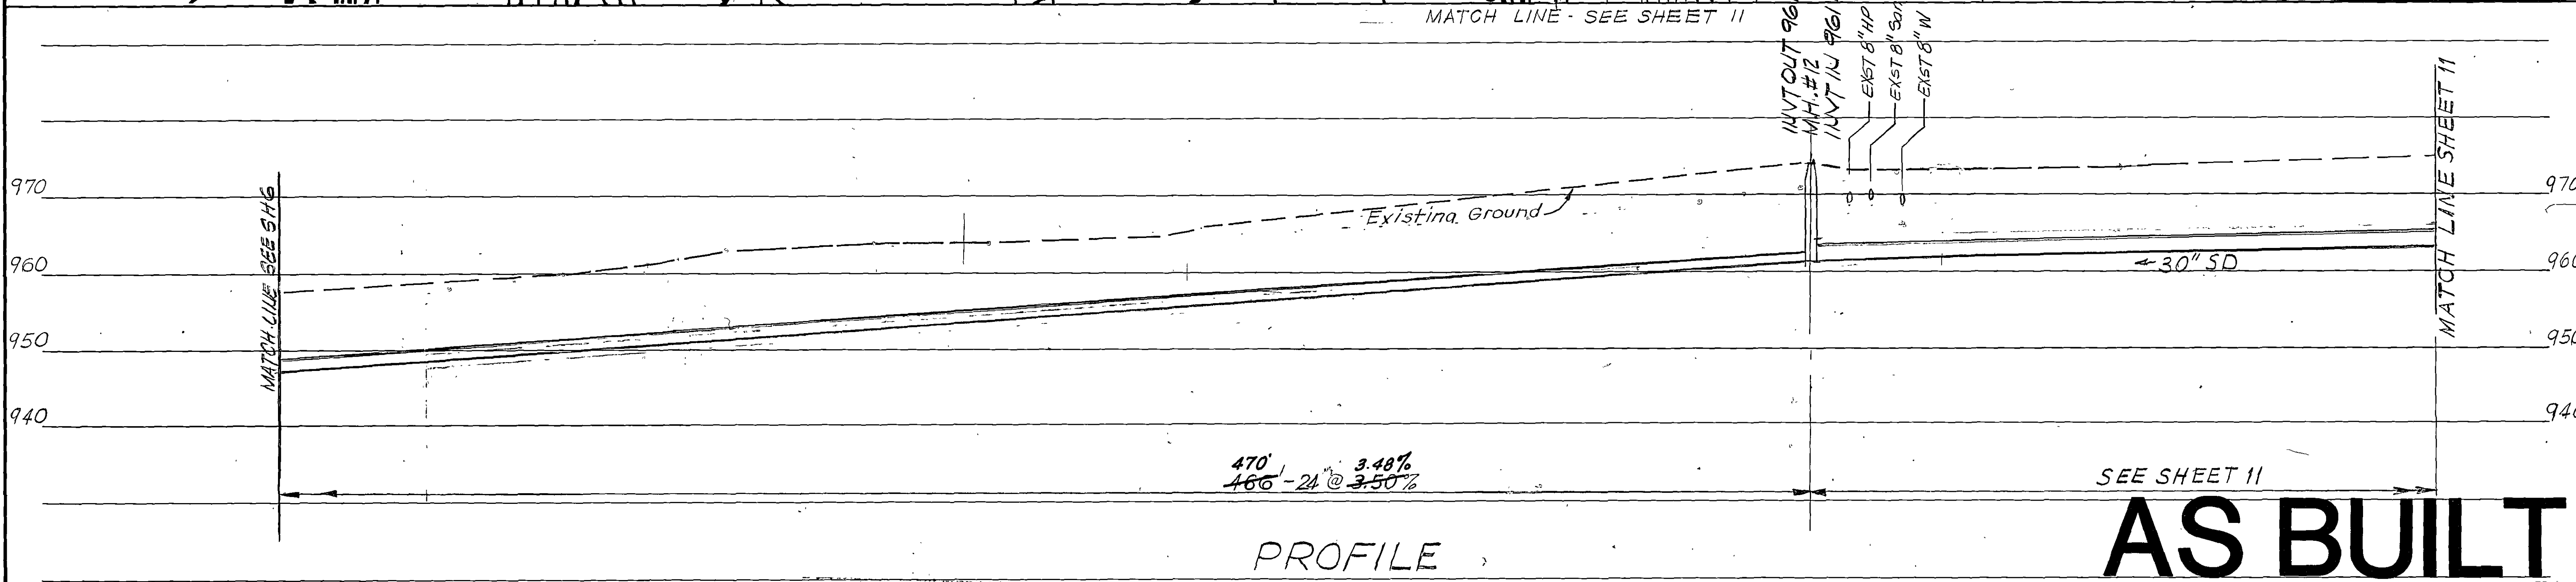


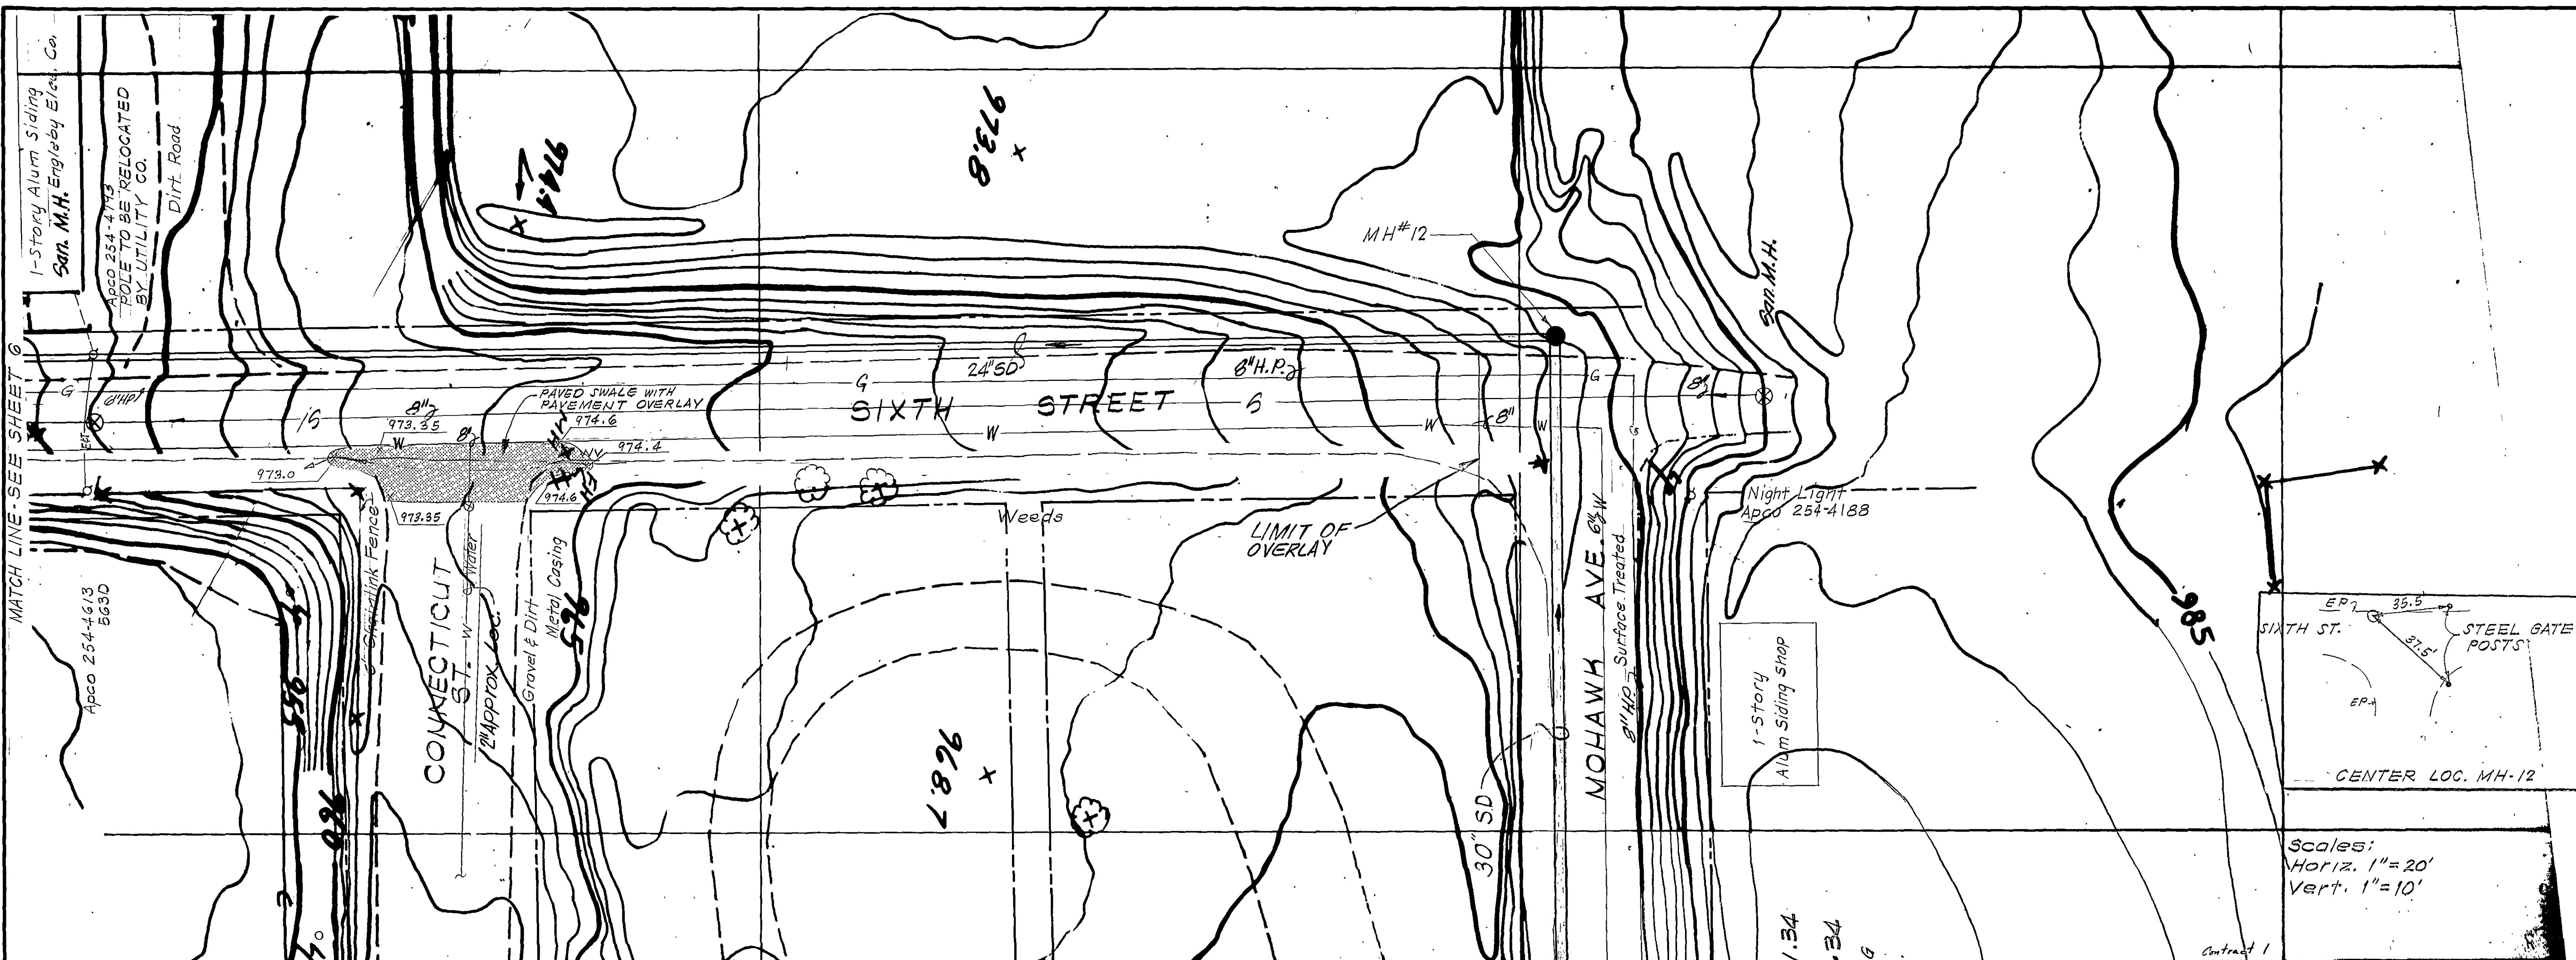

DESIGNED: DRM

CHECKED: [Signature]

APPROVED: [Signature]

REVISION	DATE	DESCRIPTION	BY	APP

DATE
JULY 1983

COMM.
428

WILLIAMSON ROAD STORM DRAIN - PHASE 1

CONTRACT I-A

ROANOKE, VIRGINIA

SHEET
10

#5825
I-A

PLAN AND PROFILE