


NO. _____	SURVEYED _____ BY _____ DATE _____
NOTE BOOK	PLOTTED _____
	PLACES CHECKED _____
	3 M'S NOTED _____
	STRUCTURE MEASUREMENTS CHECKED _____

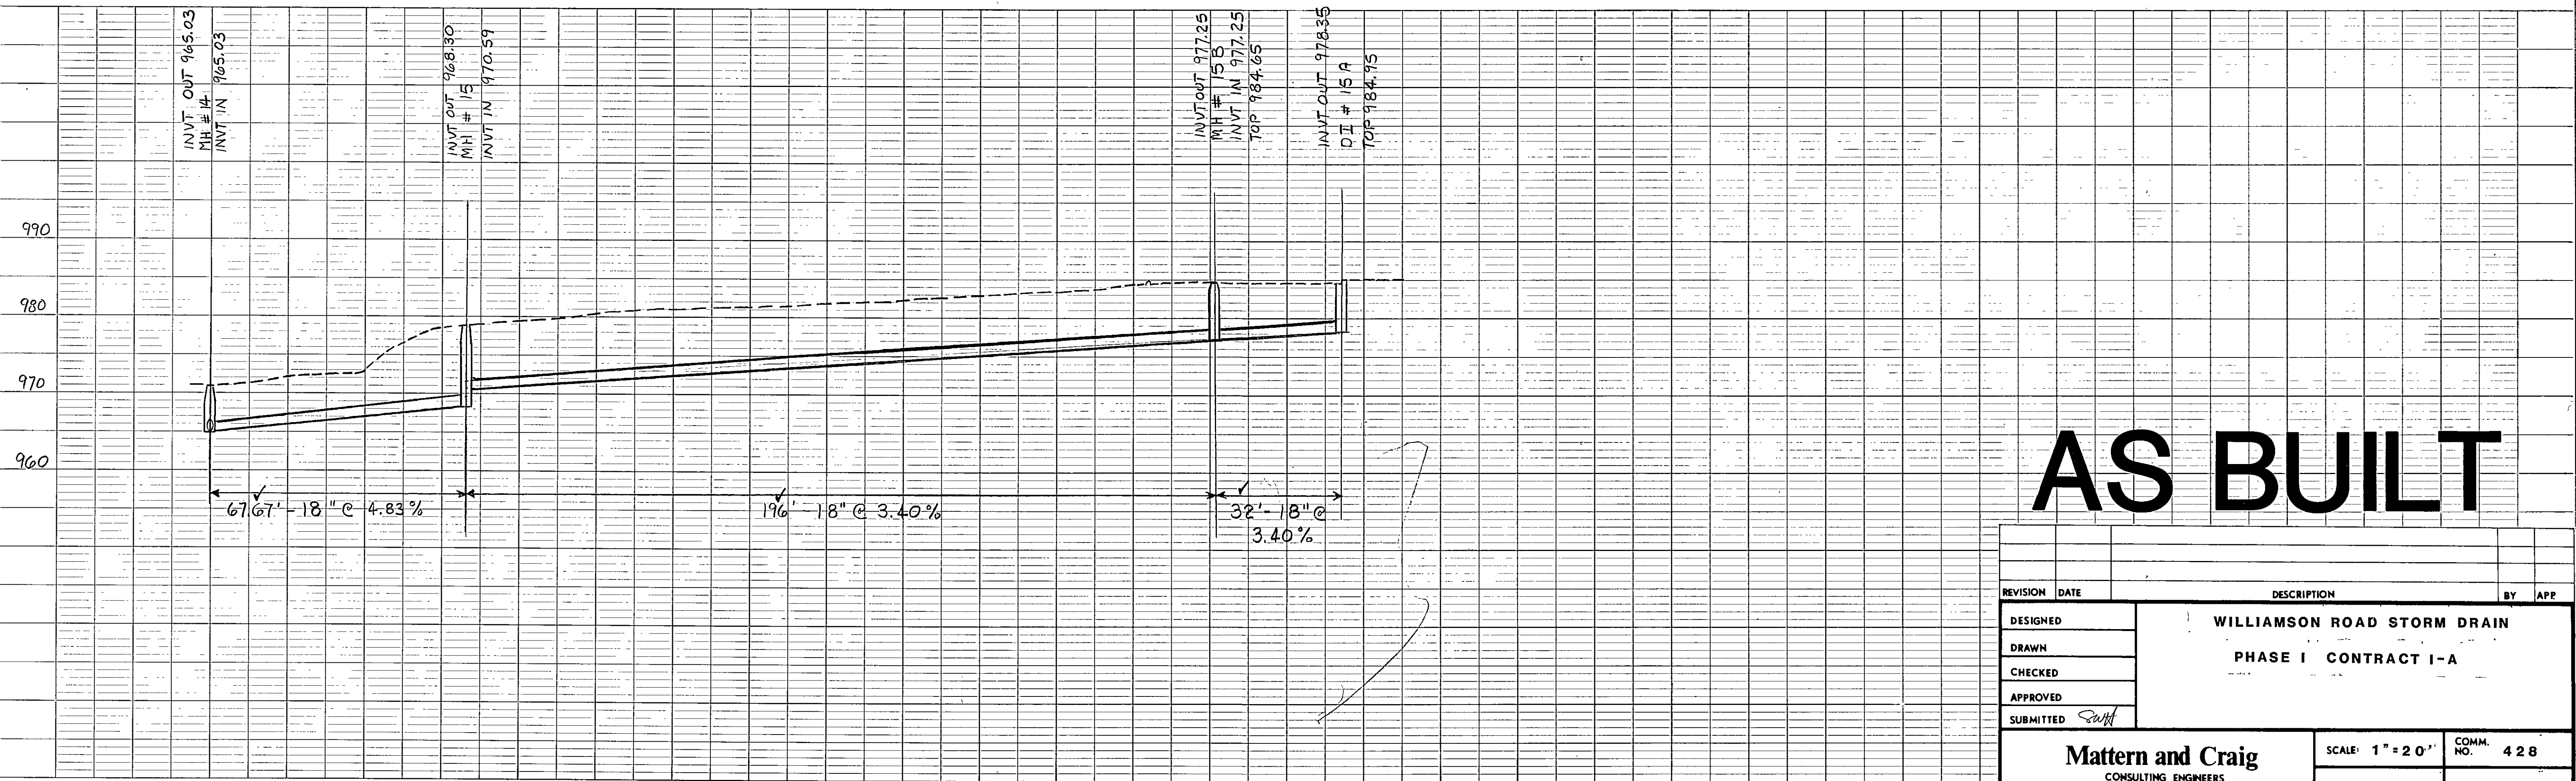

AS BUILT

REVISION	DATE	DESCRIPTION	BY	APP.
		WILLIAMSON ROAD STORM DRAIN		
		PHASE I CONTRACT I-A		
DESIGNED				
DRAWN				
CHECKED				
APPROVED				
SUBMITTED	<i>South</i>			

Mattern and Craig CONSULTING ENGINEERS ROANOKE, VIRGINIA	SCALE:	1" = 20'	COMM. NO.	428
	DATE:	3 / 21 / 84	SHEET	11A

#5825 I-A