
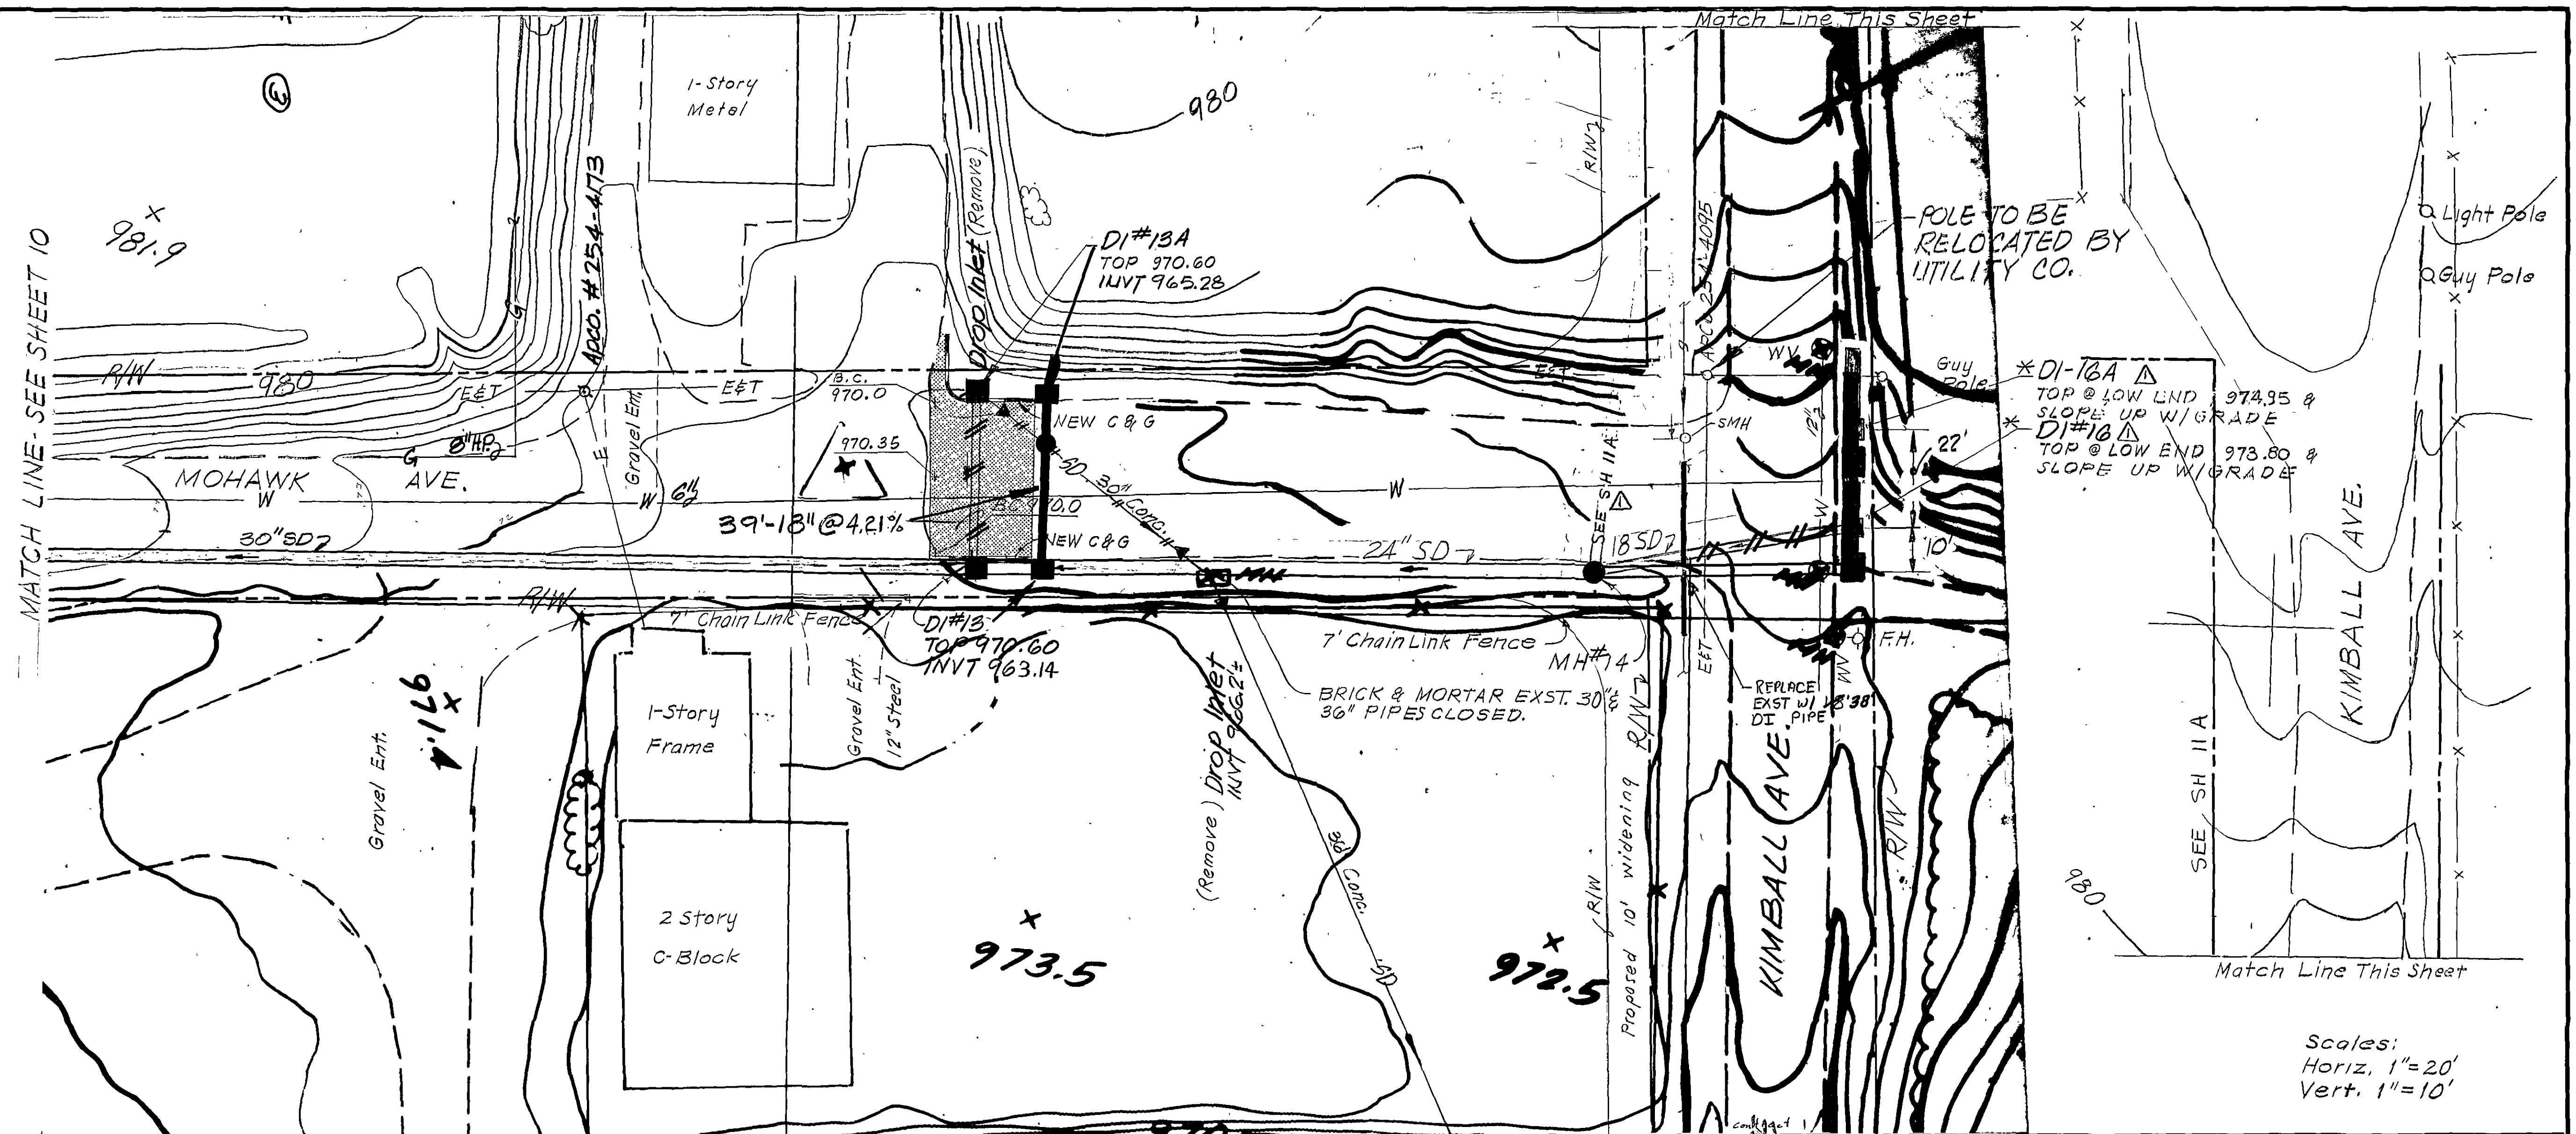
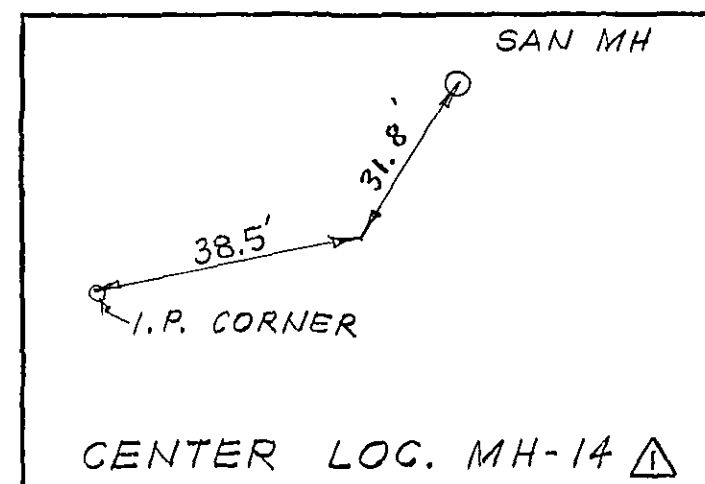


Mattern & Craig
CONSULTING ENGINEERS
SUITE 401 707 S. JEFFERSON STREET ROANOKE VIRGINIA 24011 (703) 345-9342

DESIGNED: **DRM**
CHECKED: **DRM**
APPROVED: **DRM**

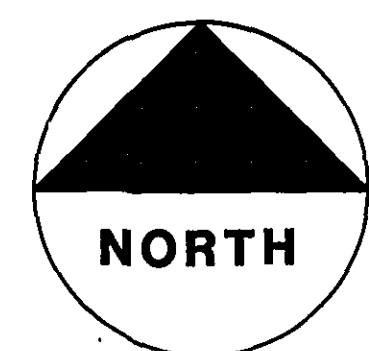

REVISION	DATE	DESCRIPTION	BY	APP
1	3/21/84	REV RE, KIMBALL AVE RECONSTRUCTION		SWH

DATE
JULY 1983
COMM.
428

WILLIAMSON ROAD STORM DRAIN - PHASE 1
CONTRACT I-A
ROANOKE, VIRGINIA
PLAN AND PROFILE

SHEET
11
#5825
I-A