
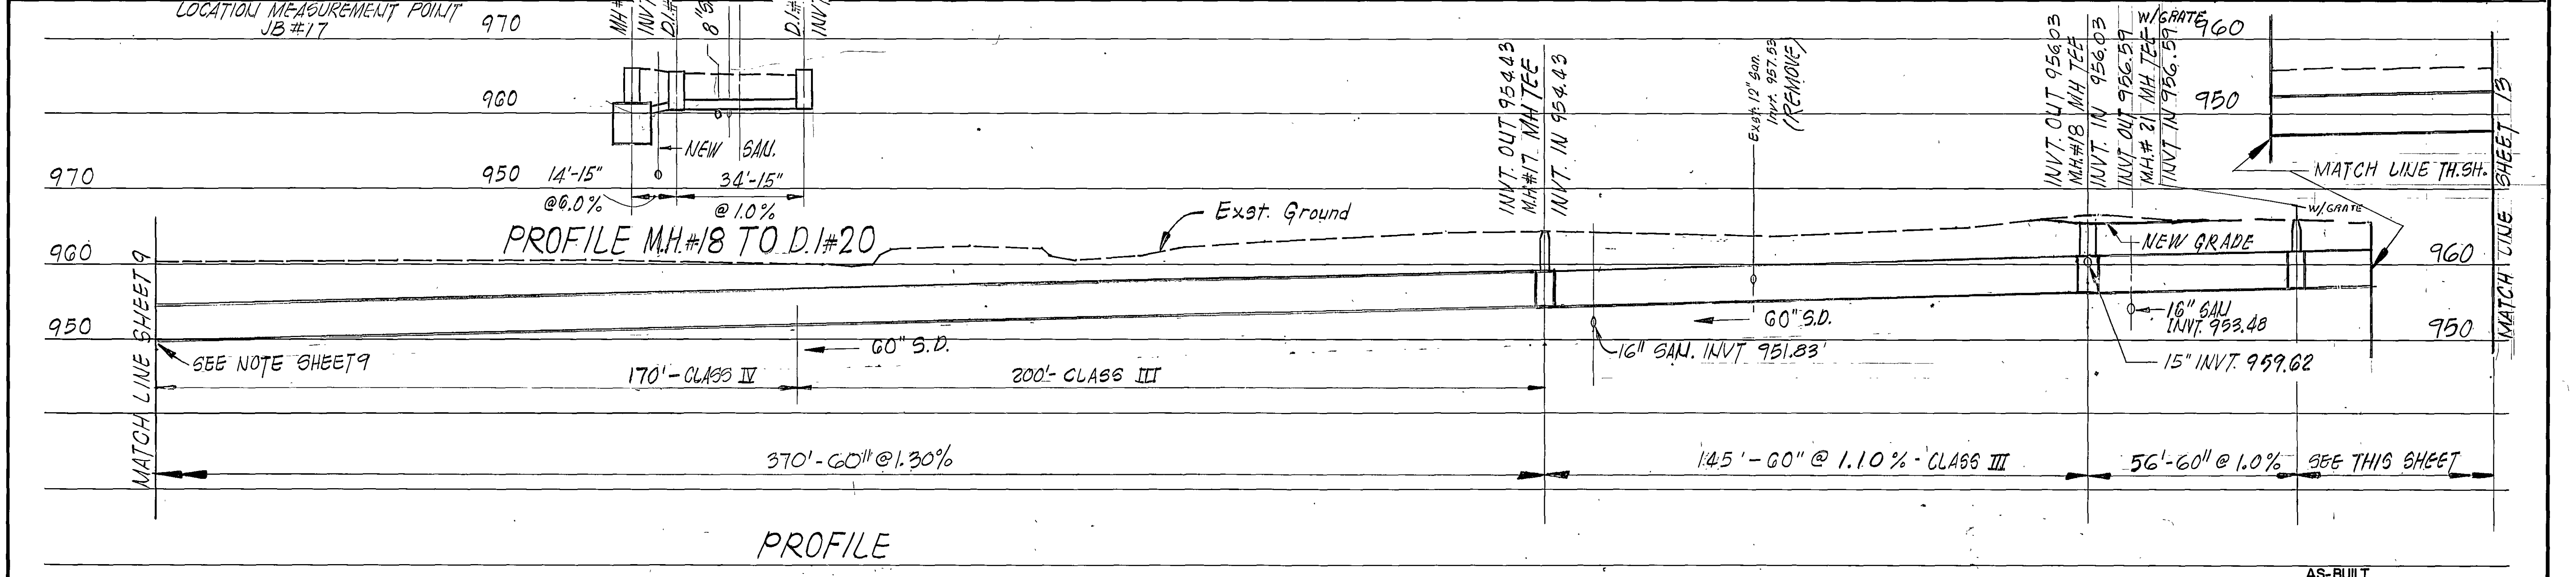


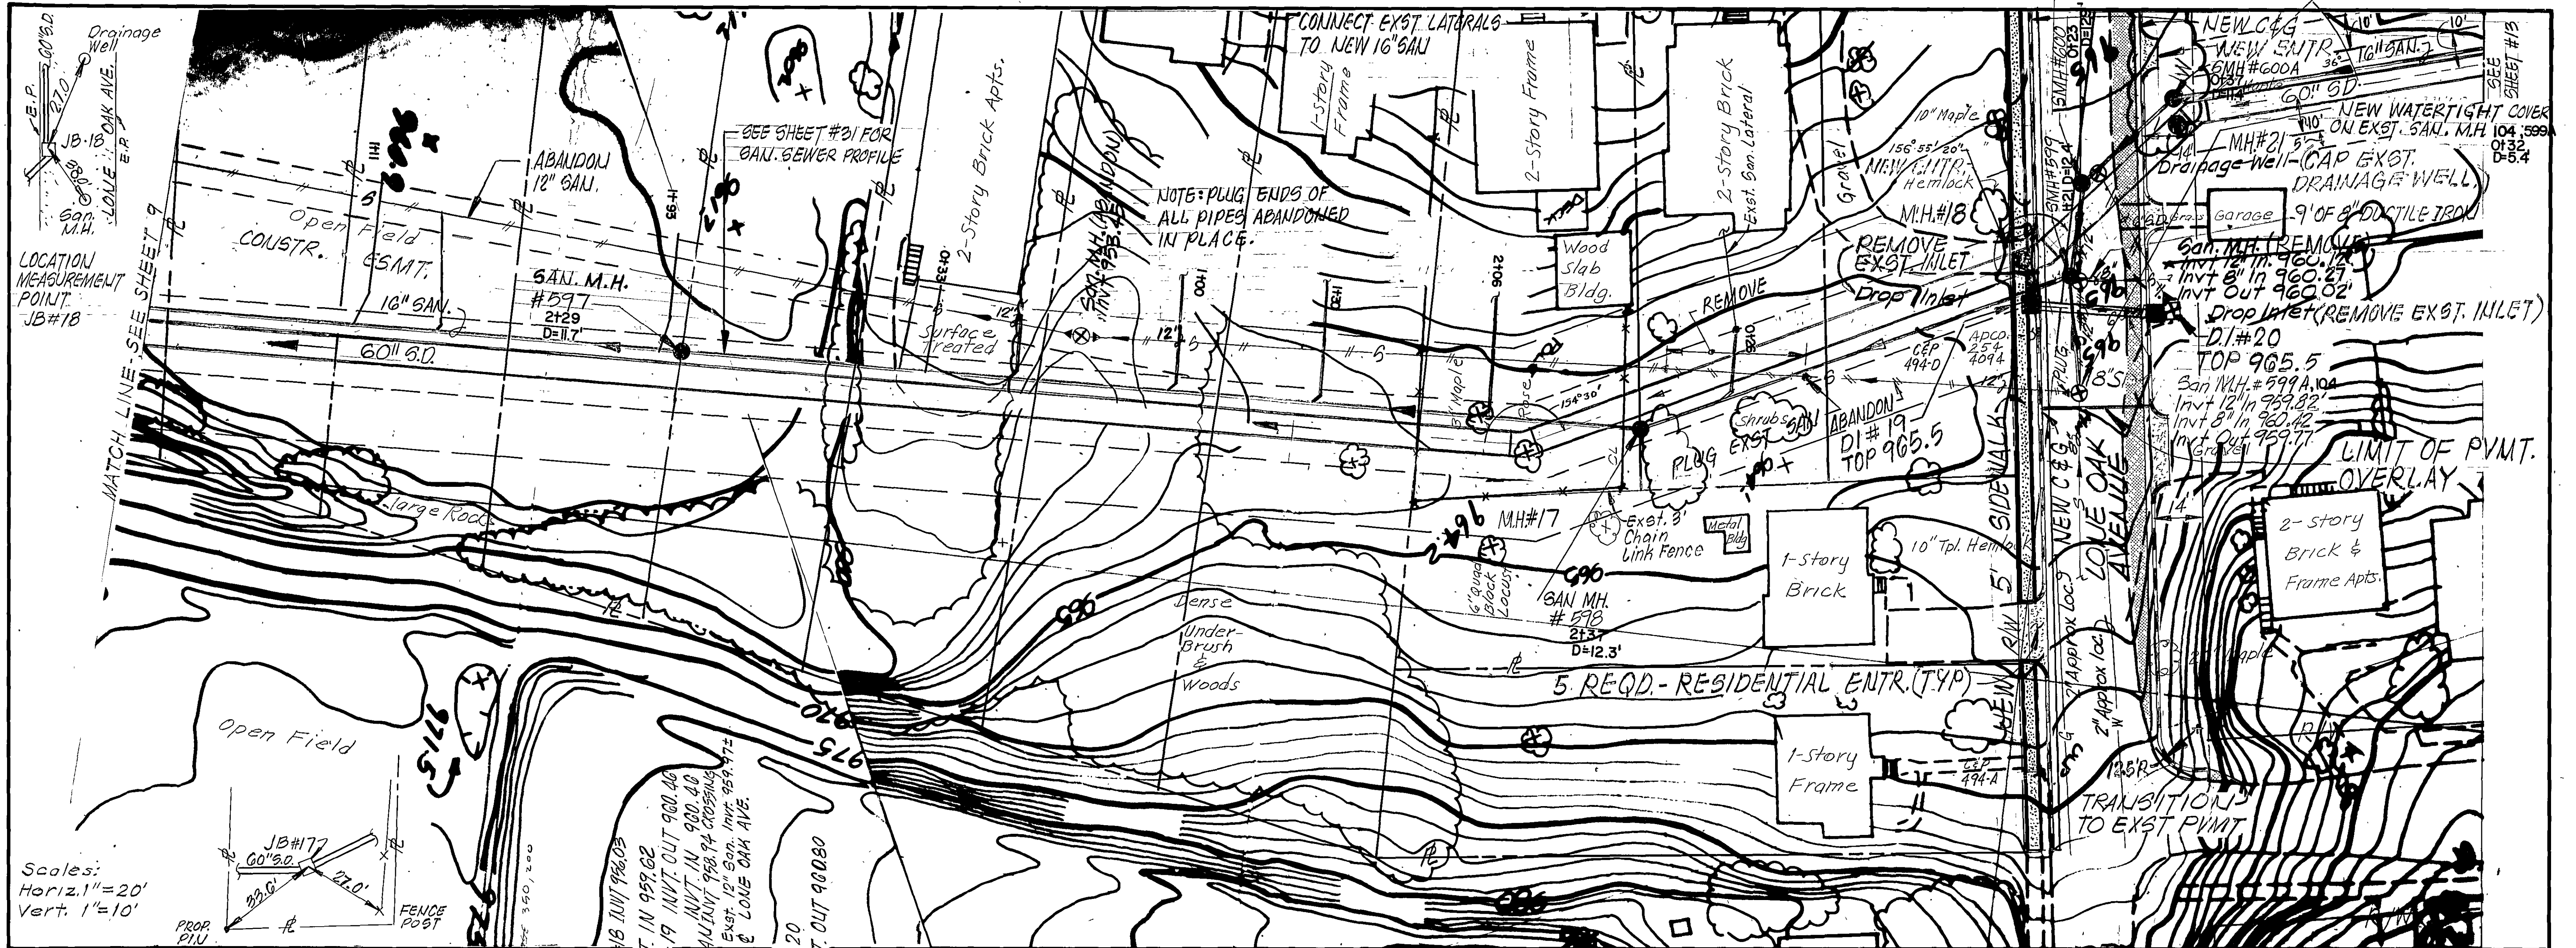

 Mattern & Craig CONSULTING ENGINEERS SUITE 401 707 S. JEFFERSON STREET ROANOKE, VIRGINIA 24011 (703) 345-9342	DESIGNED: <i>CAT</i>	 NORTH	 STEWART W. HUBBELL PROFESSIONAL ENGINEER	REVISION 1 3-15-85 REV SAN & SD	DATE JULY 1983	WILLIAMSON ROAD STORM DRAIN - PHASE 1 CONTRACT I ROANOKE, VIRGINIA	12 SHEET		
	CHECKED: <i>SWA</i>			DATE 11-10-86	DESCRIPTION RECORD DRAWINGS			BY <i>JD</i>	APP. <i>SWA</i>
	APPROVED: <i>SWA</i>							DATE 428	
	PLAN AND PROFILE								