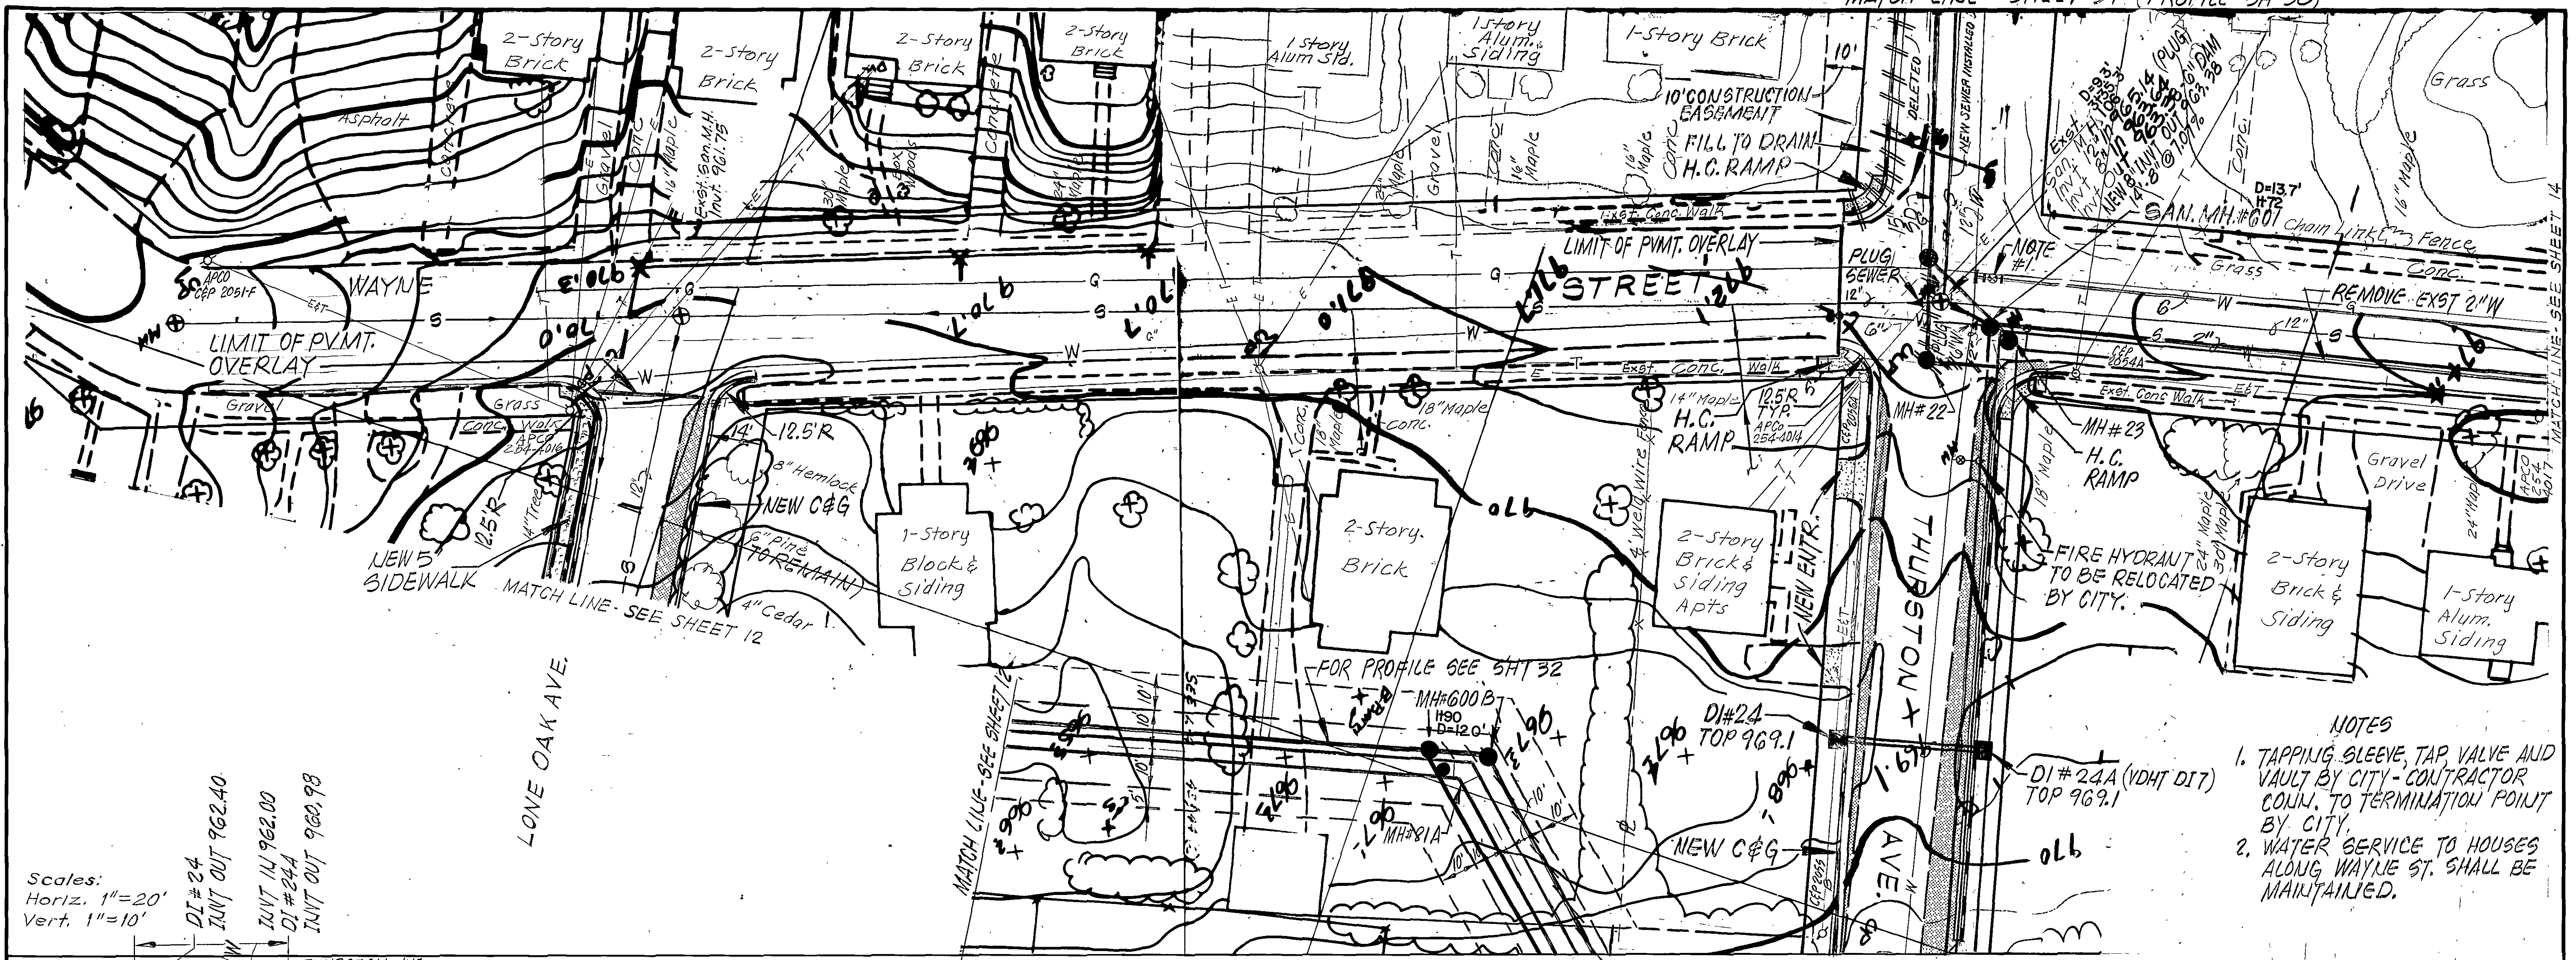


Mattern & Craig CONSULTING ENGINEERS SUITE 401, 707 S. JEFFERSON STREET, ROANOKE, VIRGINIA 24011, (703) 345-9342	DESIGNED: <i>CAT</i>			REVISION	DATE	DESCRIPTION	BY	APP	DATE JULY 1983 COMM. 428	WILLIAMSON ROAD STORM DRAIN - PHASE 1 CONTRACT I ROANOKE, VIRGINIA	SHEET 13
	CHECKED: <i>SWH</i>			1-15-85 REV. SAN & SD	CAT	SWH					
	APPROVED: <i>SWH</i>			11-10-86 RECORD DRAWINGS	JD	SWH					
PLAN AND PROFILE											