


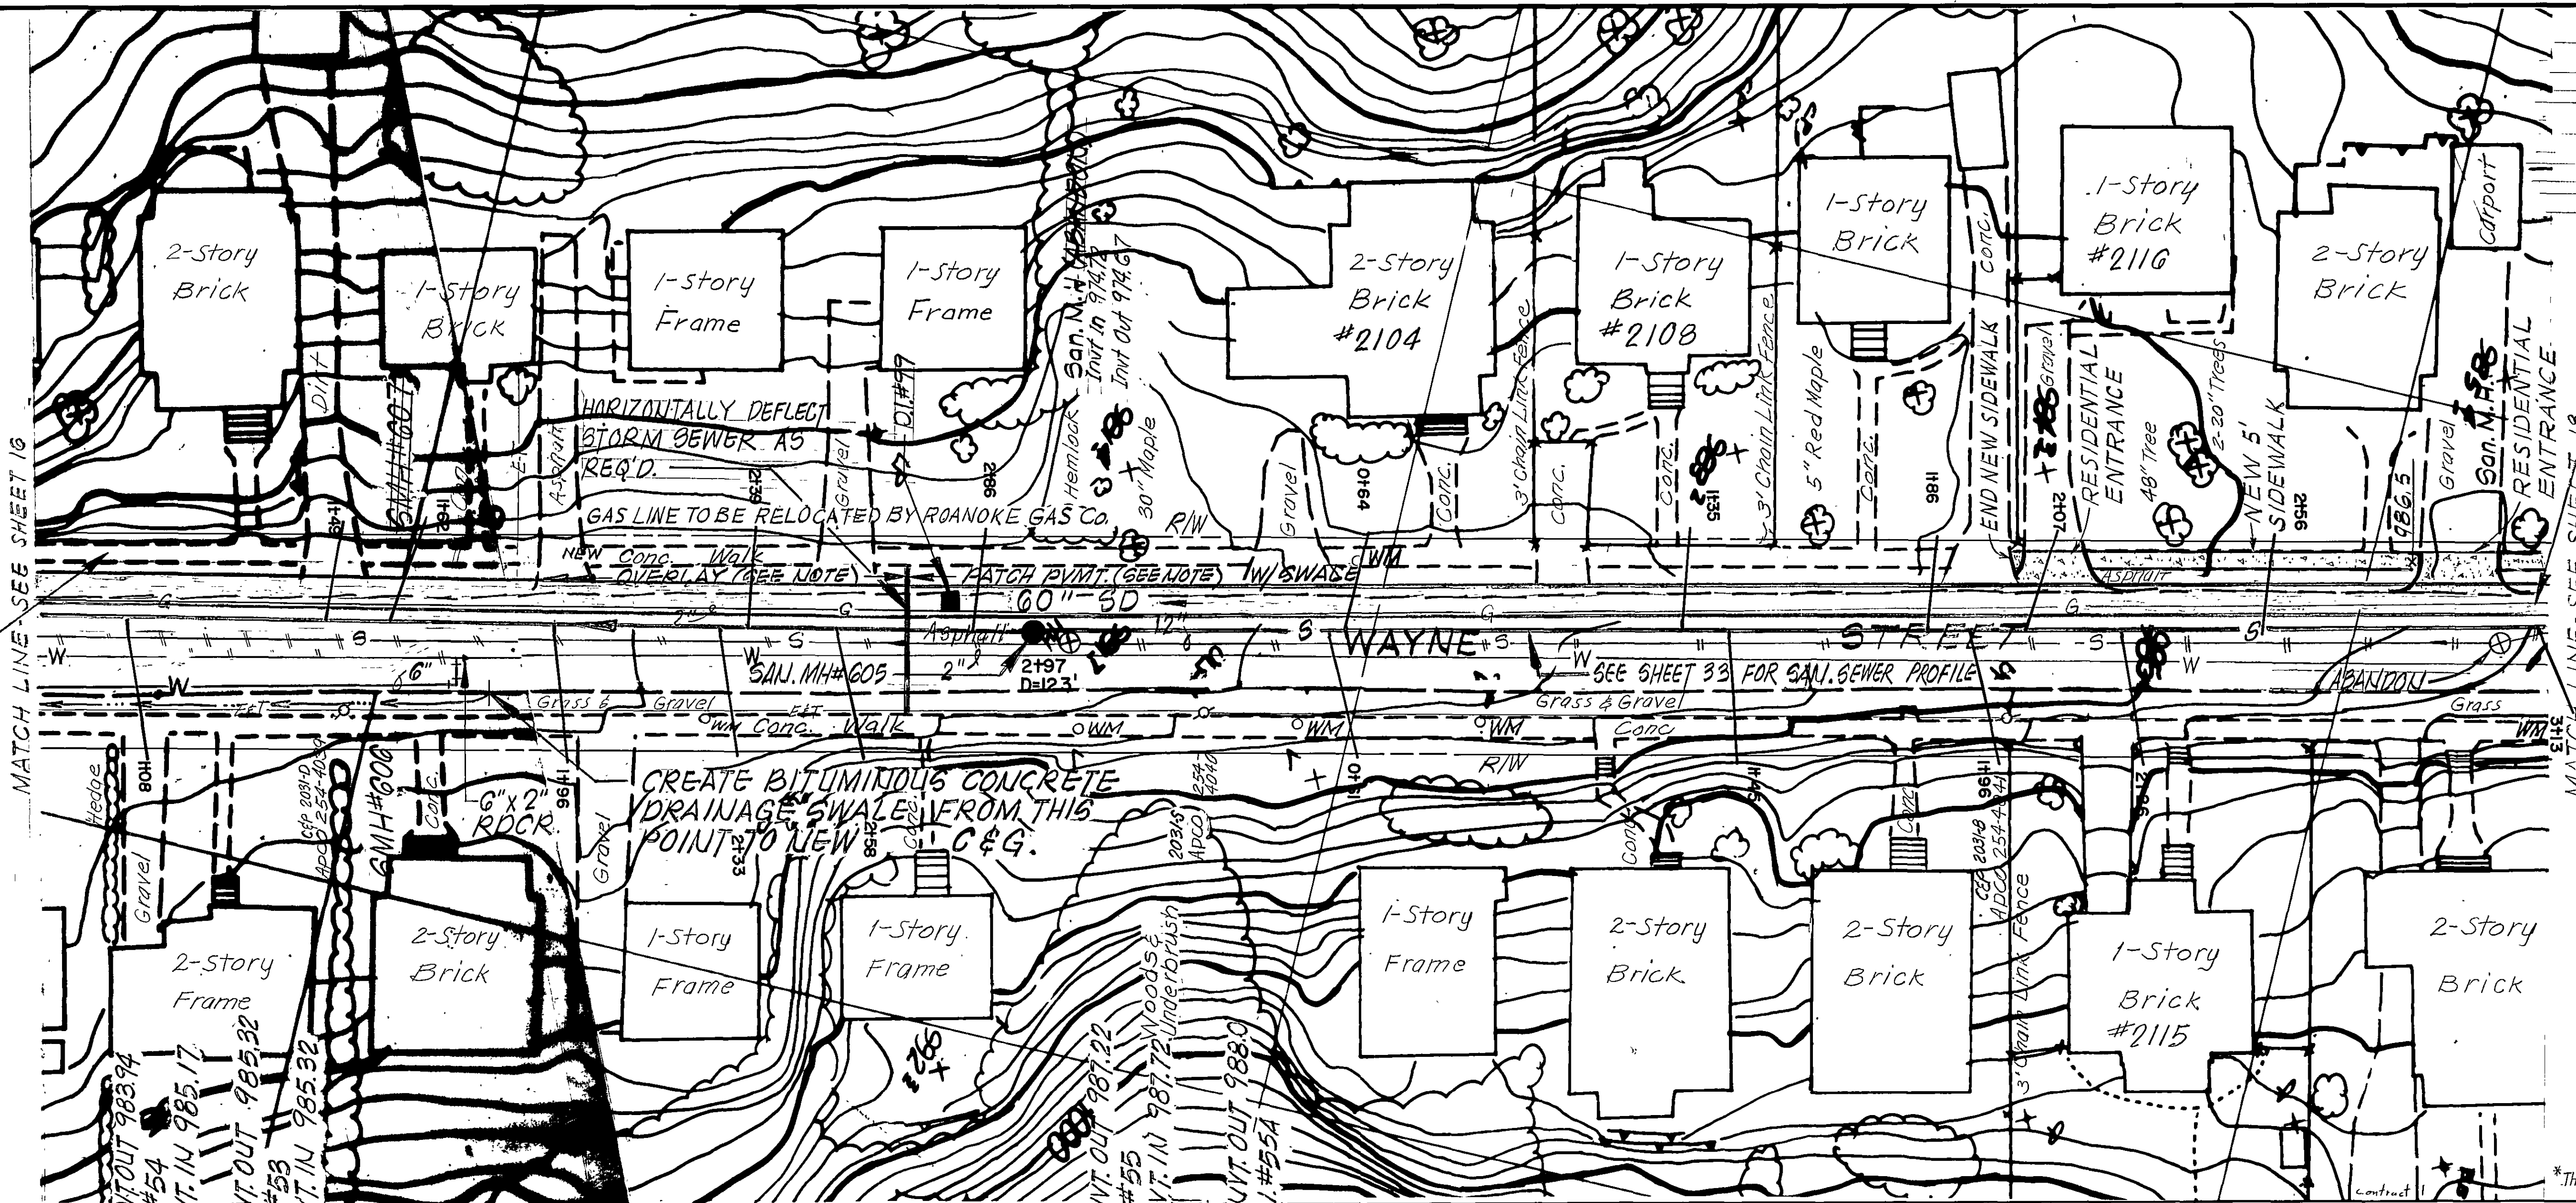


NOTE: CONTRACTOR SHALL LOCATE & CONNECT ALL SAN. LATERALS (FROM ABANDONED EXST. SAN.) TO NEW SAN.

GAS LINE TO BE RELOCATED BY GAS COMPANY

NOTE: Wayne Street shall be overlaid to the south of the limit shown with the surface sloped to the east. As now exists, the street in this reach shall not be crowned. To the north of the limit shown, the pavement disturbed by excavation and the area between the trench and the sidewalk only shall be replaced. A bituminous concrete swale between the edge of the street and the sidewalk shall be created. At the area of the limit line, the swale shall be ended and the excess water directed across the street to the south side on a diagonal.

Scales:
Horiz. 1"=20'
Vert. 1"=10'

*THAT WOULD NOT BE INTERCEPTED BY DI#99

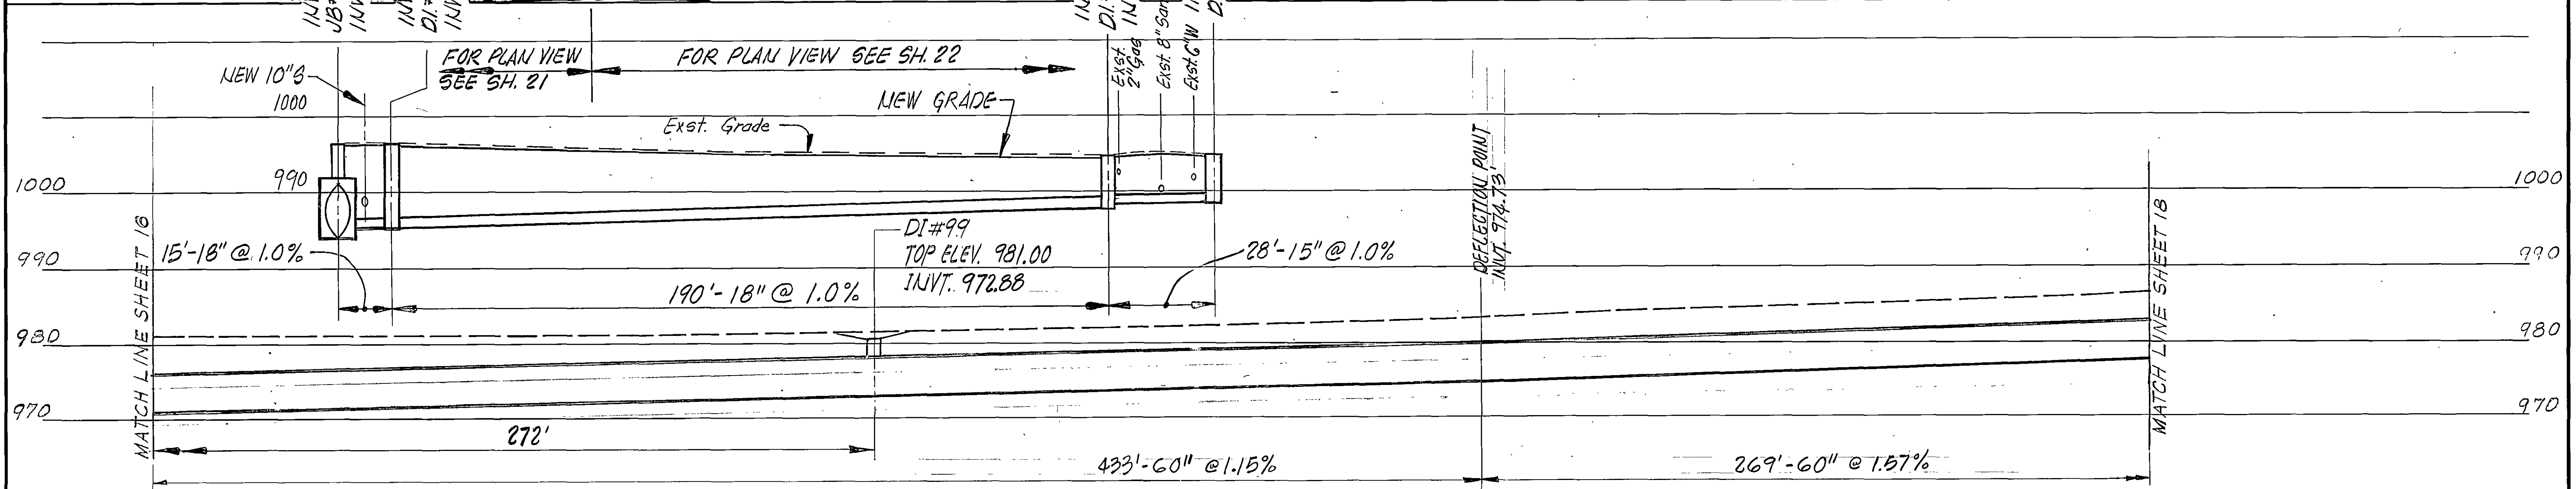

AS-BUILT

SUITE 401, 707 S. JEFFERSON STREET, ROANOKE, VIRGINIA 24011 (703) 345-9342	DESIGNED: CAT			REVISION	DATE	DESCRIPTION	BY	APP.	DATE	WILLIAMSON ROAD STORM DRAIN - PHASE 1 CONTRACT I ROANOKE, VIRGINIA PLAN AND PROFILE	SHEET 17	
	CHECKED: SWH			1	9-15-85	REV. SAN & GD						JULY 1983
	APPROVED: SWH			2	11-10-86	RECORD DRAWINGS	JD					COMM. 428