
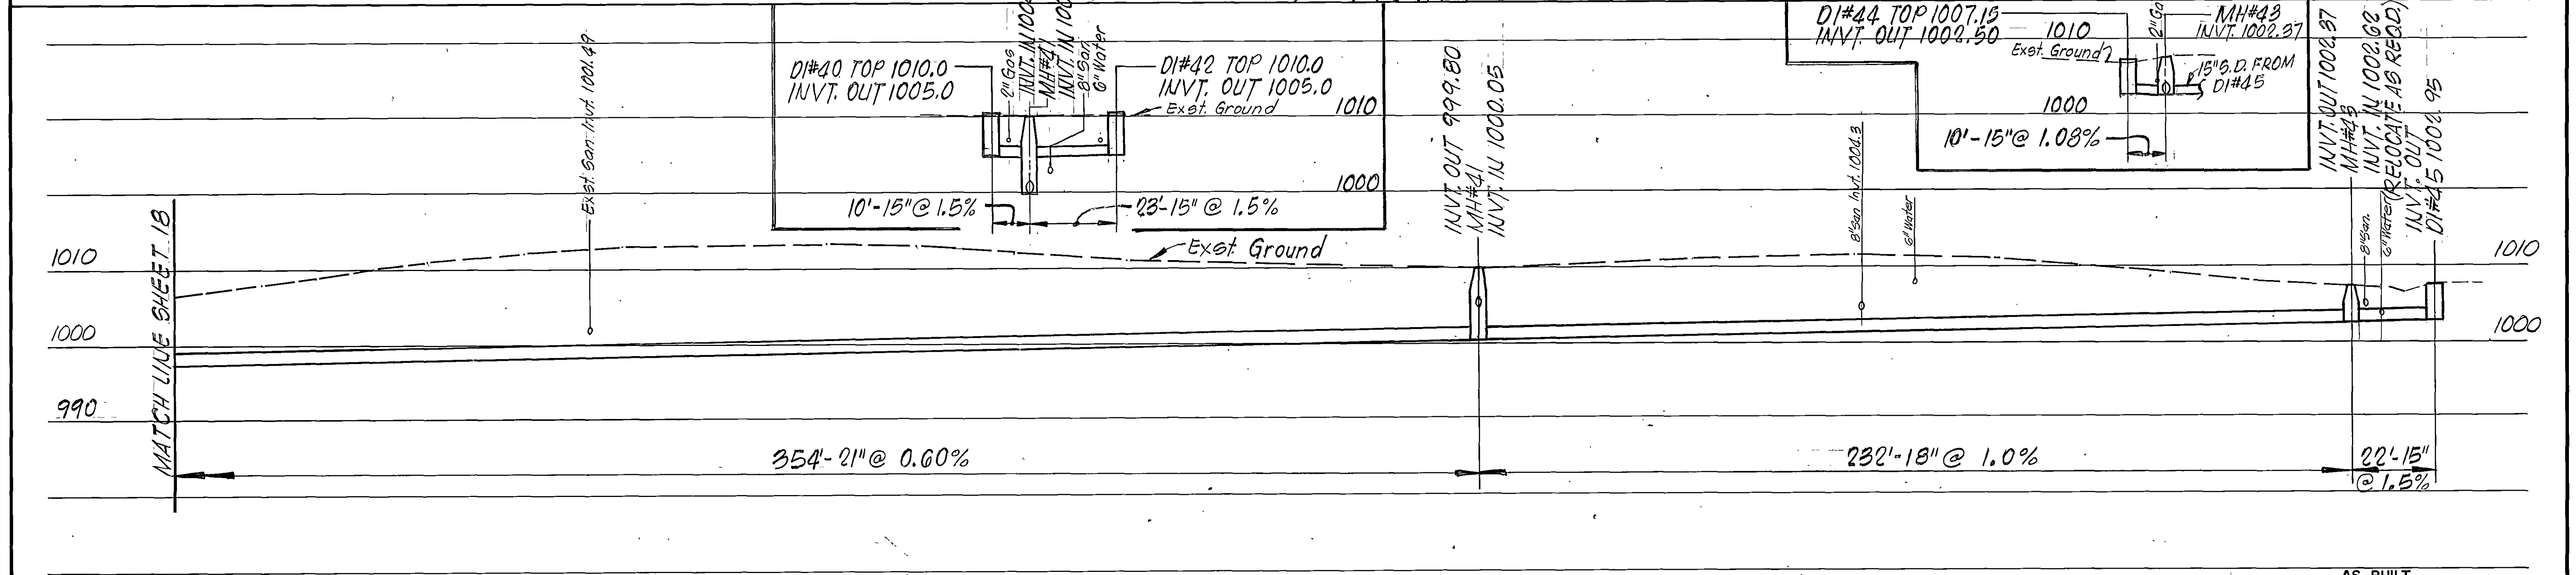


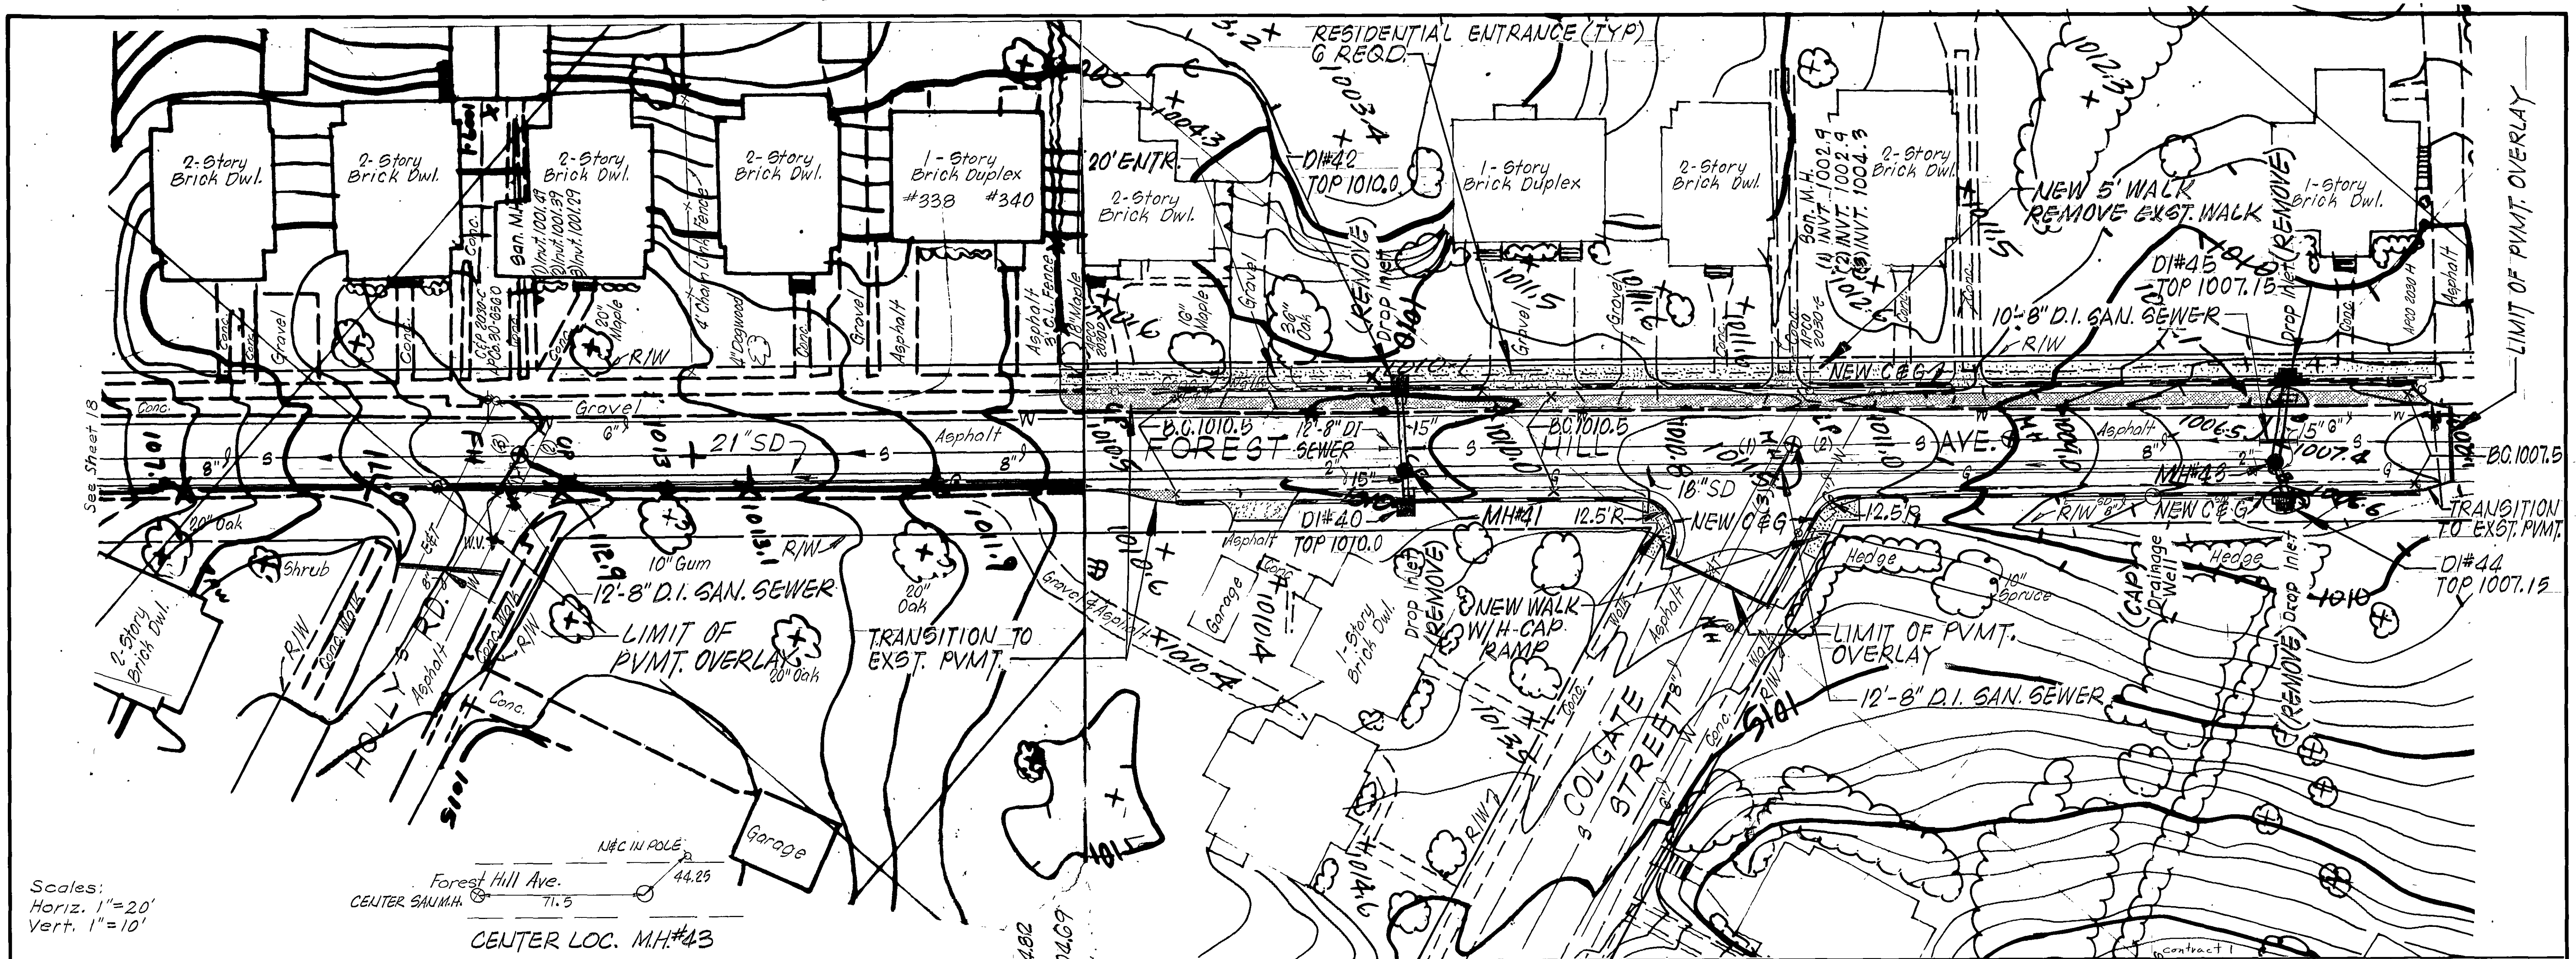

SUITE 401, 707 S. JEFFERSON STREET, ROANOKE, VIRGINIA 24011 (703) 345-9342	DESIGNED: CAT			REVISION	DATE	DESCRIPTION	BY	APP.	DATE	WILLIAMSON ROAD STORM DRAIN - PHASE 1 CONTRACT I ROANOKE, VIRGINIA PLAN AND PROFILE	SHEET 19
	CHECKED: SWA			11-10-86	RECORD DRAWINGS	JD	SWA	JULY 1983			
	APPROVED: SWA							COMM. 428			