
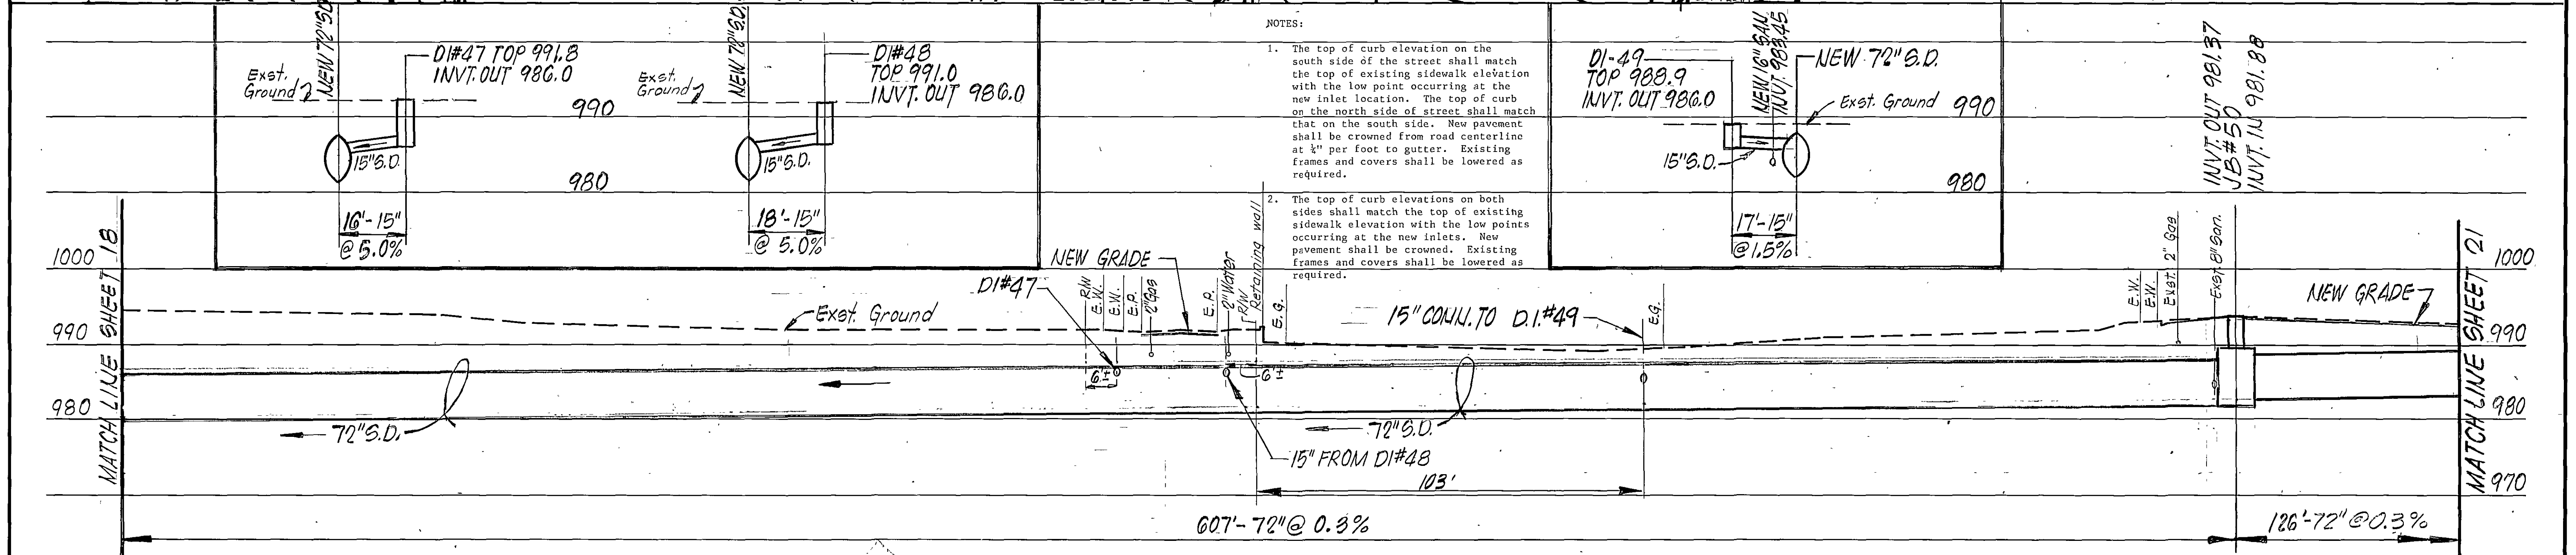


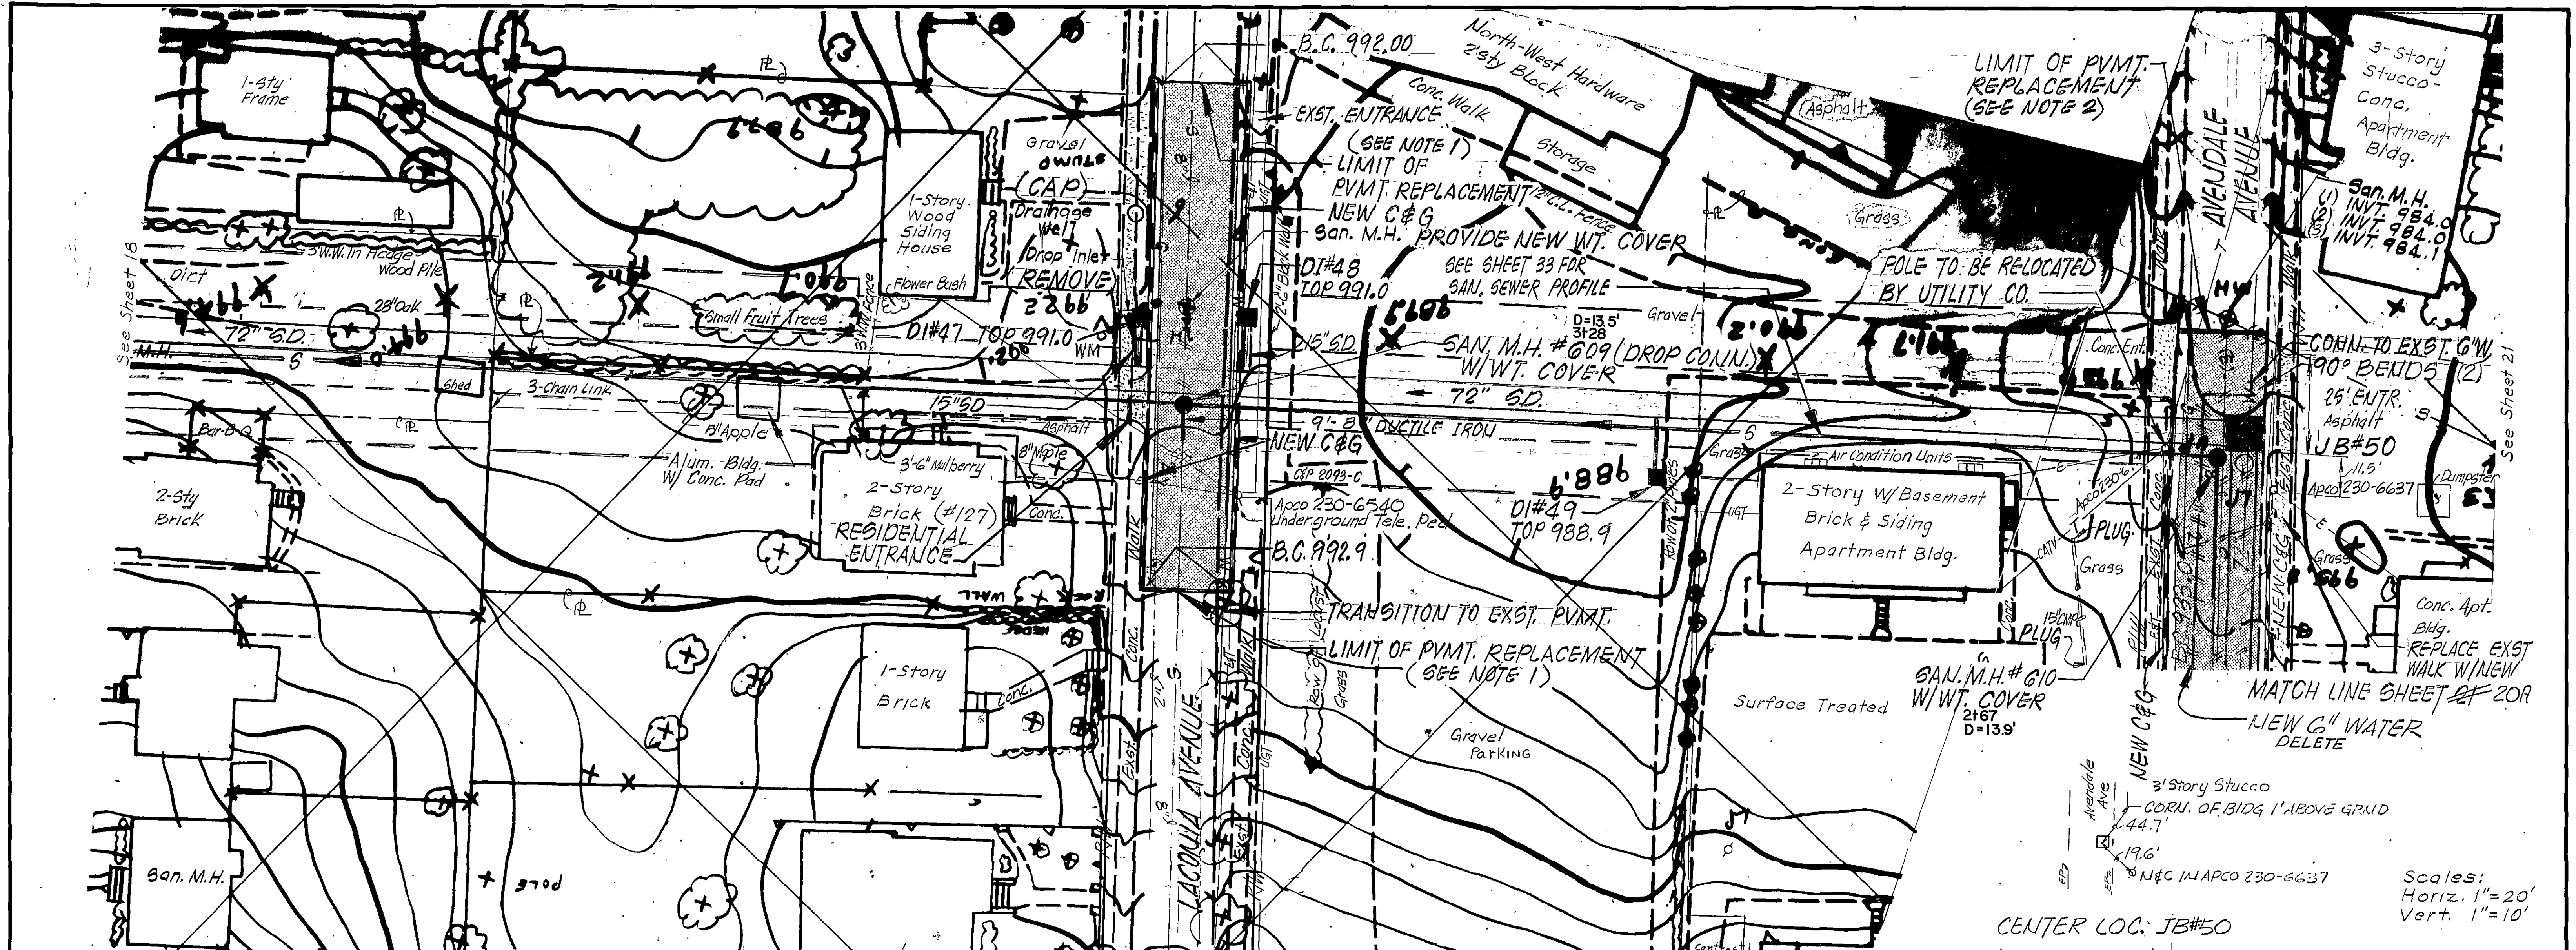

SUITE 401, 707 S. JEFFERSON STREET, ROANOKE, VIRGINIA 24011 (703) 345-9342	DESIGNED: CAT CHECKED: Smith APPROVED: Smith			REVISION DATE DESCRIPTION BY APP.	DATE JULY 1983 COMM. 428	WILLIAMSON ROAD STORM DRAIN - PHASE 1 CONTRACT I ROANOKE, VIRGINIA	SHEET 20
	PLAN AND PROFILE						