
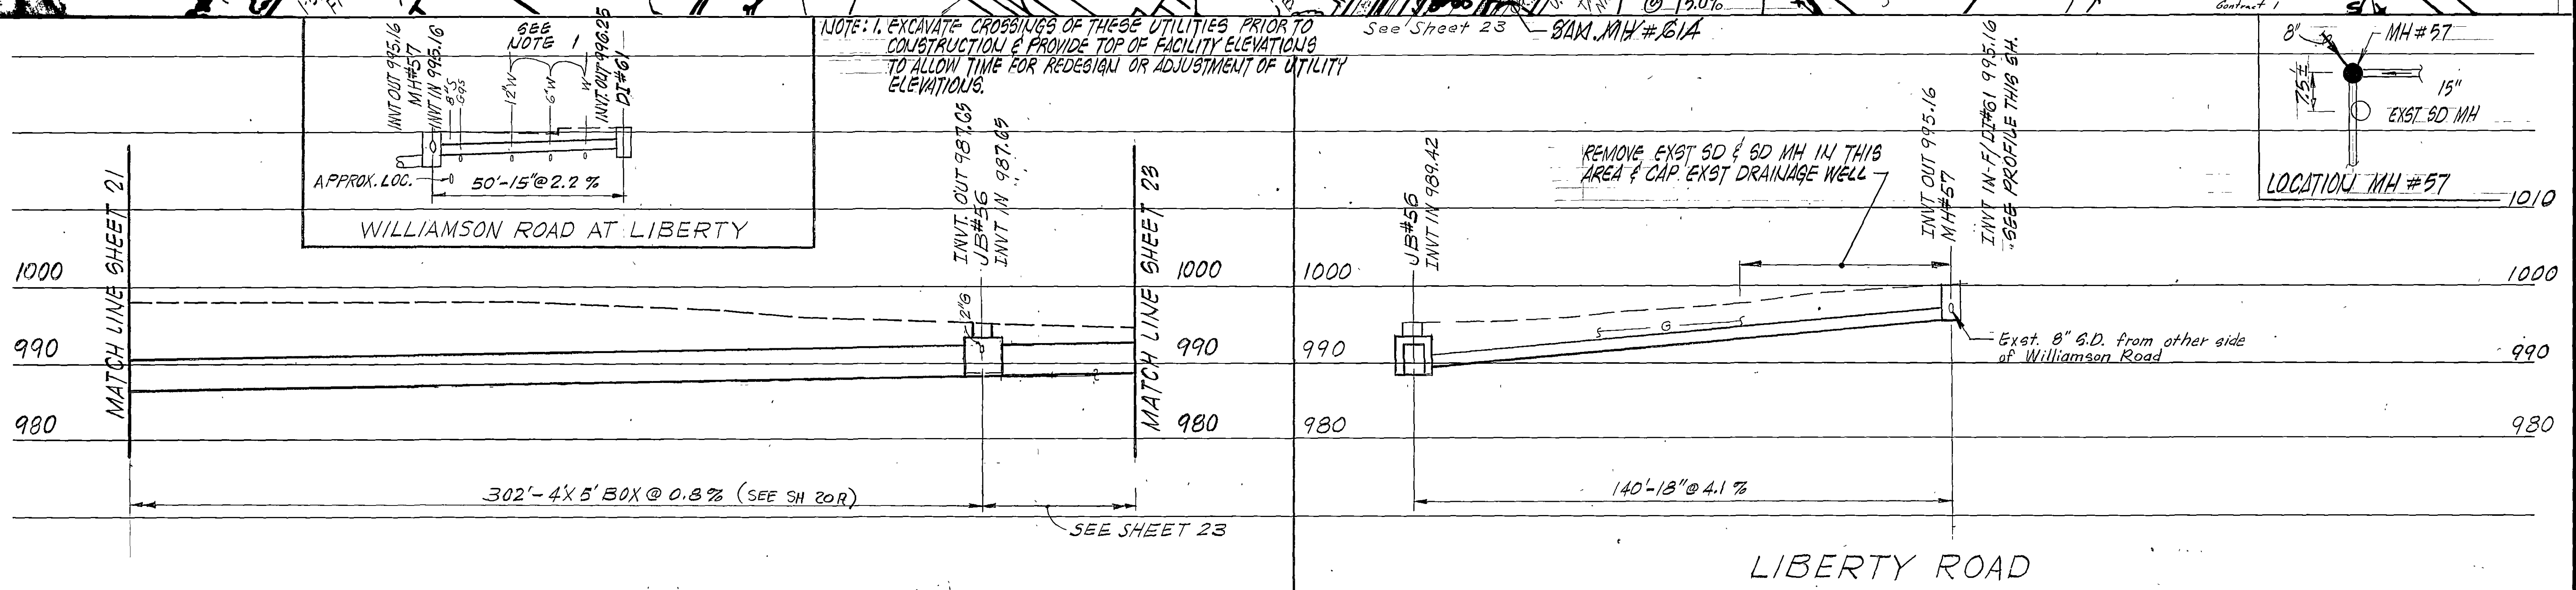


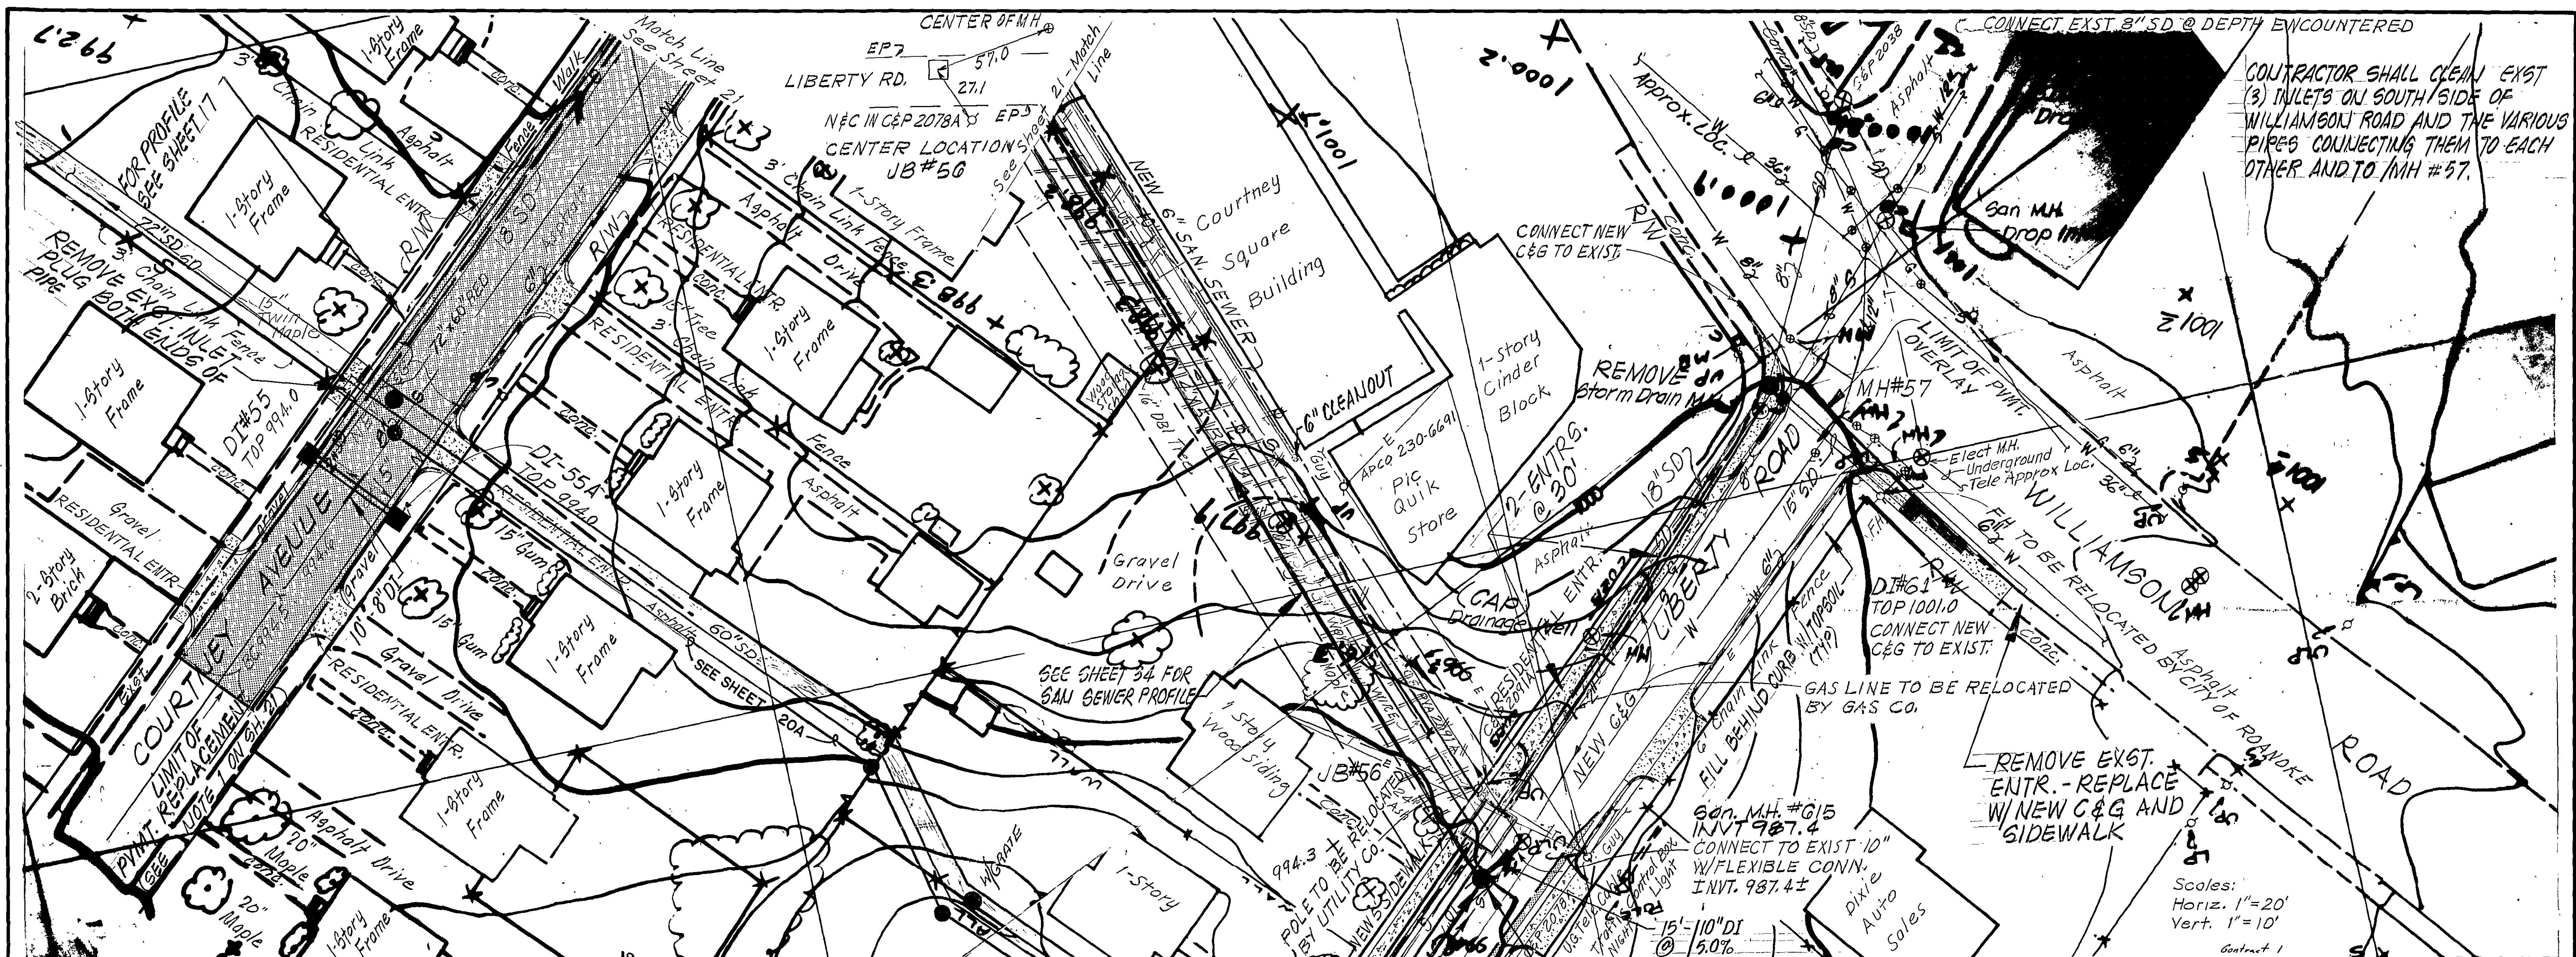

SUITE 401 707 S. JEFFERSON STREET ROANOKE VIRGINIA 24011 (703) 345-9342	DESIGNED: CAT CHECKED: SWH APPROVED: SWH			REVISION 11-10-86 RECORD DRAWINGS	DATE JULY 1983 COMM. 428	WILLIAMSON ROAD STORM DRAIN - PHASE 1 CONTRACT I ROANOKE, VIRGINIA	SHEET 22
	PLAN AND PROFILE						