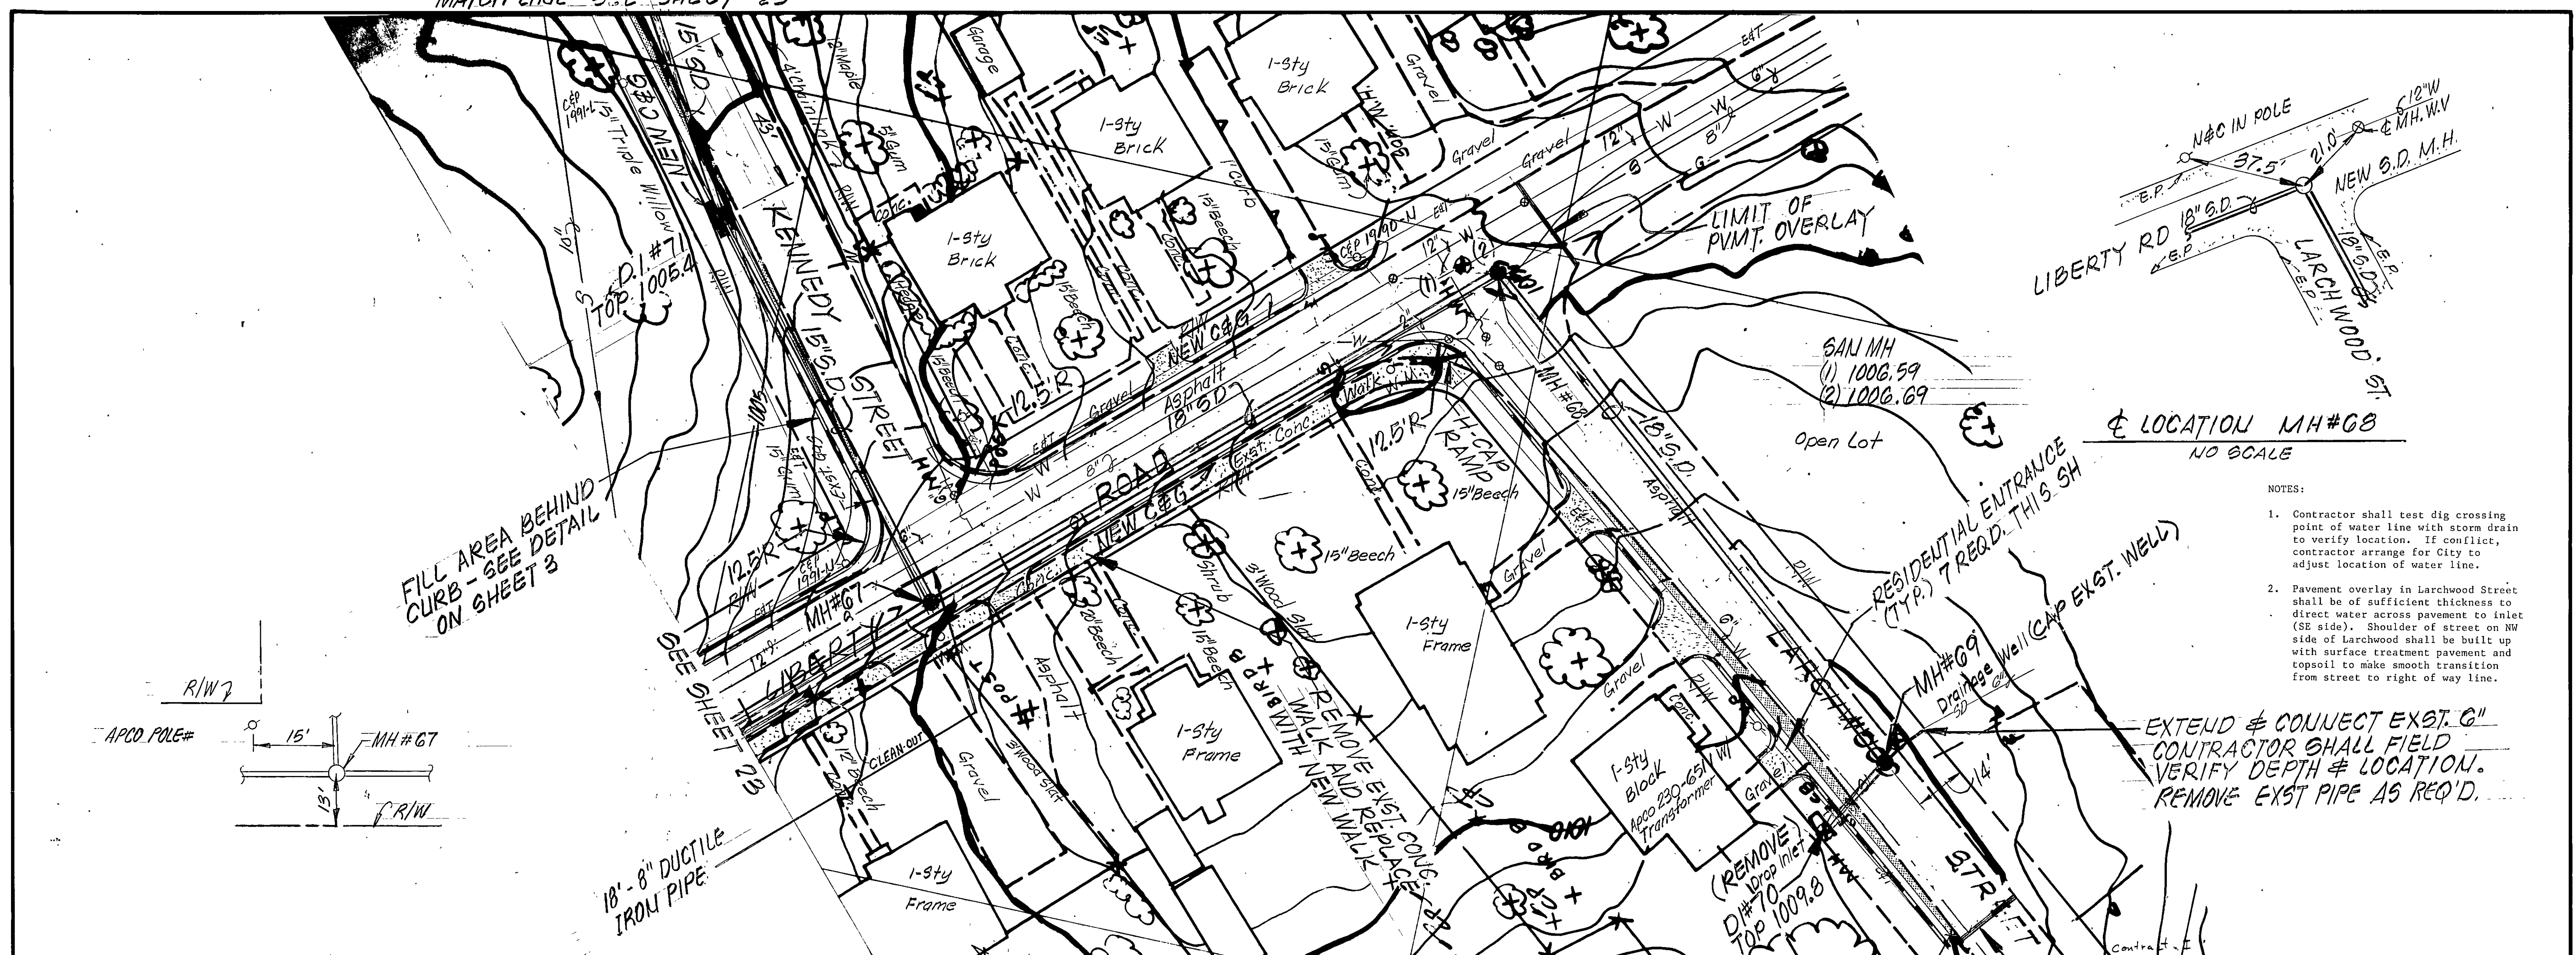


MATCH LINE - SEE SHEET 25

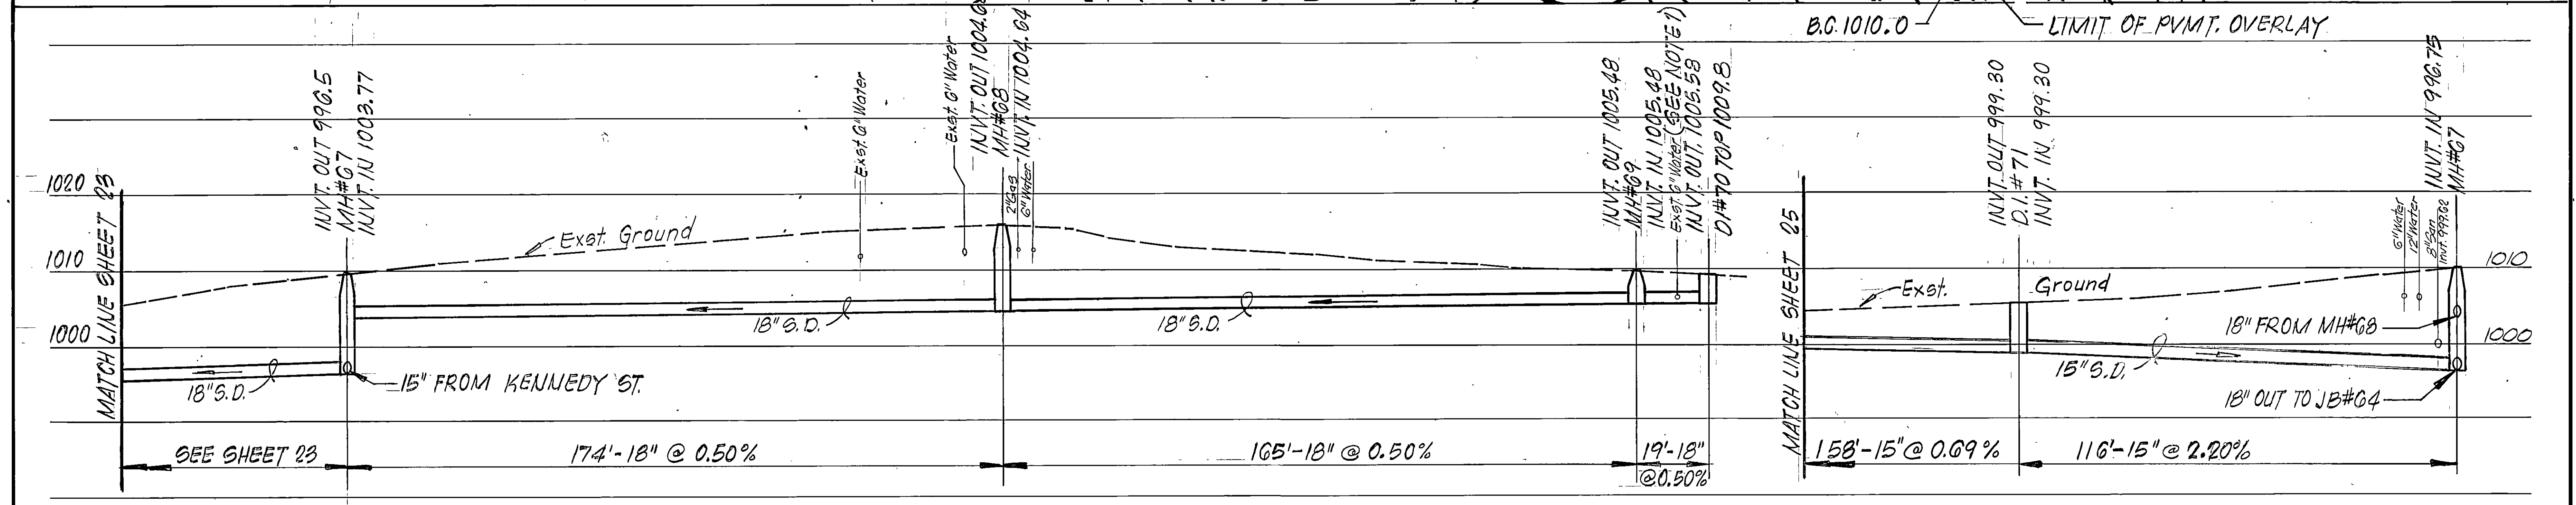


LOCATION MH#68
NO SCALE

NOTES:

1. Contractor shall test dig crossing point of water line with storm drain to verify location. If conflict, contractor arrange for City to adjust location of water line.
2. Pavement overlay in Larchwood Street shall be of sufficient thickness to direct water across pavement to inlet (SE side). Shoulder of street on NW side of Larchwood shall be built up with surface treatment pavement and topsoil to make smooth transition from street to right of way line.

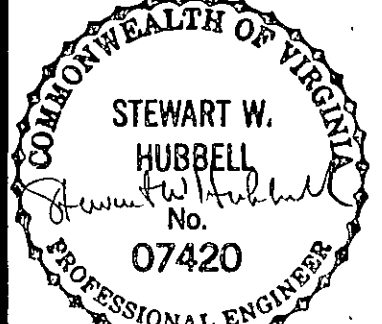
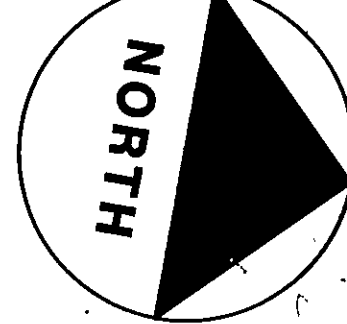
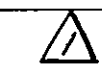
EXTEND & CONNECT EXST. 6\"/>
CONTRACTOR SHALL FIELD
VERIFY DEPTH & LOCATION.
REMOVE EXST PIPE AS REQ'D.



PROFILE - 18" S.D. MH#67 TO DI#70

PROFILE - 15" S.D. - KENNEDY ST.

AS-BUILT

 SUITE 401 707 S. JEFFERSON STREET ROANOKE, VIRGINIA 24011 (703) 345-9342	DESIGNED: CAT			REVISION	DATE	DESCRIPTION	BY	APP.	DATE JULY 1983 COMM. 428	WILLIAMSON ROAD STORM DRAIN - PHASE 1 CONTRACT I ROANOKE, VIRGINIA	SHEET 24
	CHECKED: <i>[Signature]</i>				11-10-86	RECORD DRAWINGS	JD	SWH			
	APPROVED: <i>[Signature]</i>										