
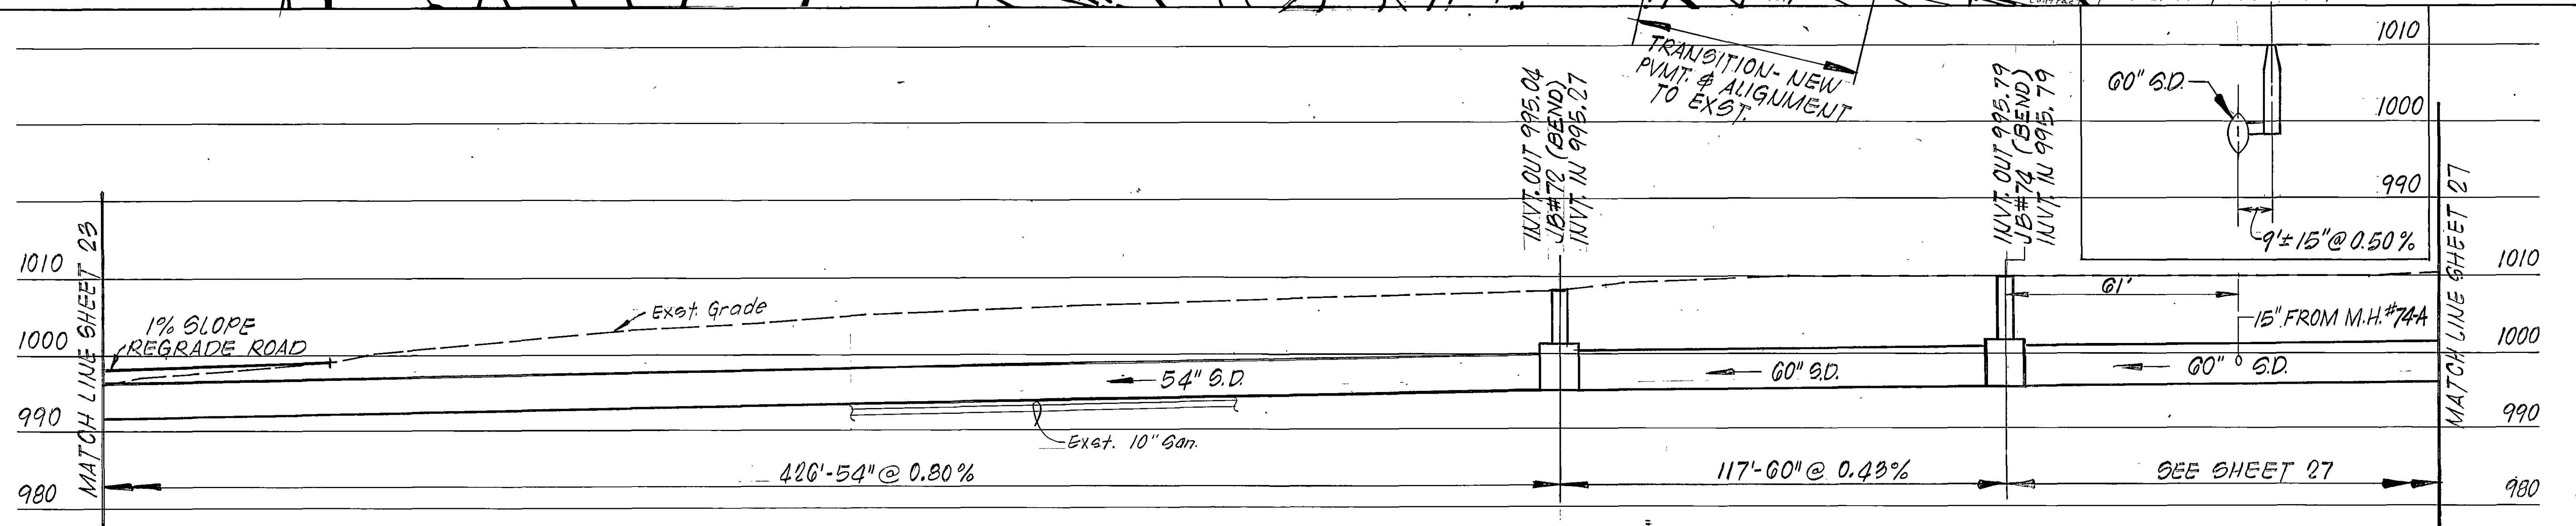
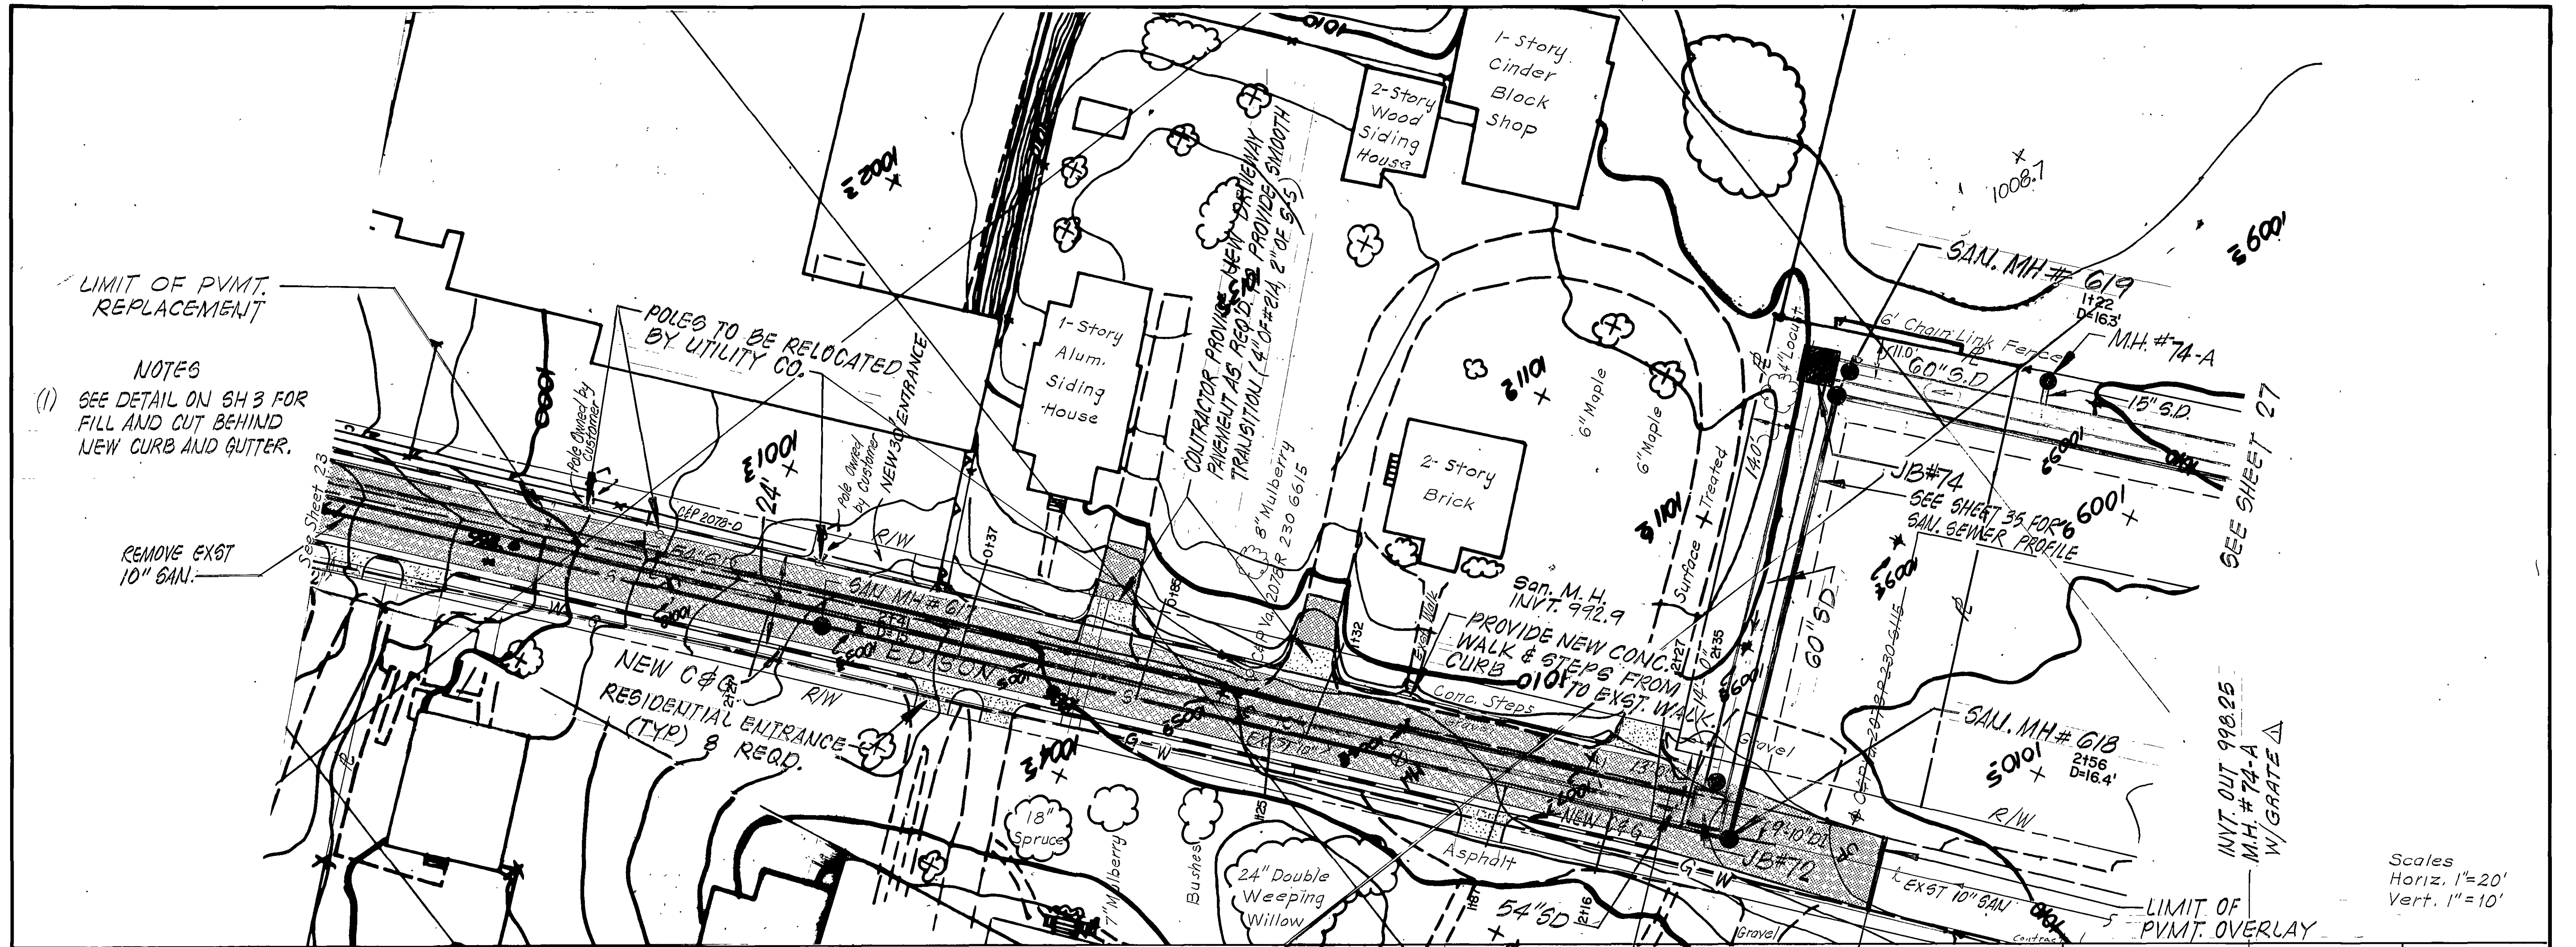
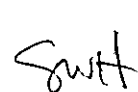
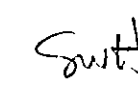
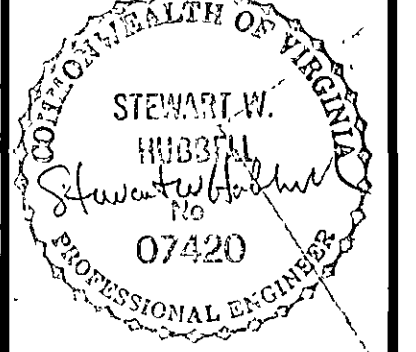


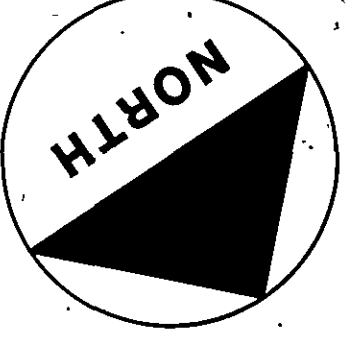

 Mattern & Craig CONSULTING ENGINEERS SUITE 401, 707 S. JEFFERSON STREET ROANOKE VIRGINIA 24011 (703) 345-9342	DESIGNED:  CHECKED:  APPROVED: 			<table border="1"> <thead> <tr> <th>REVISION</th> <th>DATE</th> <th>DESCRIPTION</th> <th>BY</th> <th>APP</th> <th>DATE</th> </tr> </thead> <tbody> <tr> <td>1</td> <td>11-10-86</td> <td>RECORD DRAWINGS</td> <td>JD</td> <td>SW</td> <td>JULY 1983</td> </tr> <tr> <td></td> <td></td> <td></td> <td></td> <td></td> <td>COMM. 428</td> </tr> </tbody> </table>	REVISION	DATE	DESCRIPTION	BY	APP	DATE	1	11-10-86	RECORD DRAWINGS	JD	SW	JULY 1983						COMM. 428	AS - BUILT WILLIAMSON ROAD STORM DRAIN - PHASE 1 CONTRACT I ROANOKE, VIRGINIA PLAN AND PROFILE	SHEET 26
	REVISION	DATE	DESCRIPTION	BY	APP	DATE																		
1	11-10-86	RECORD DRAWINGS	JD	SW	JULY 1983																			
					COMM. 428																			