
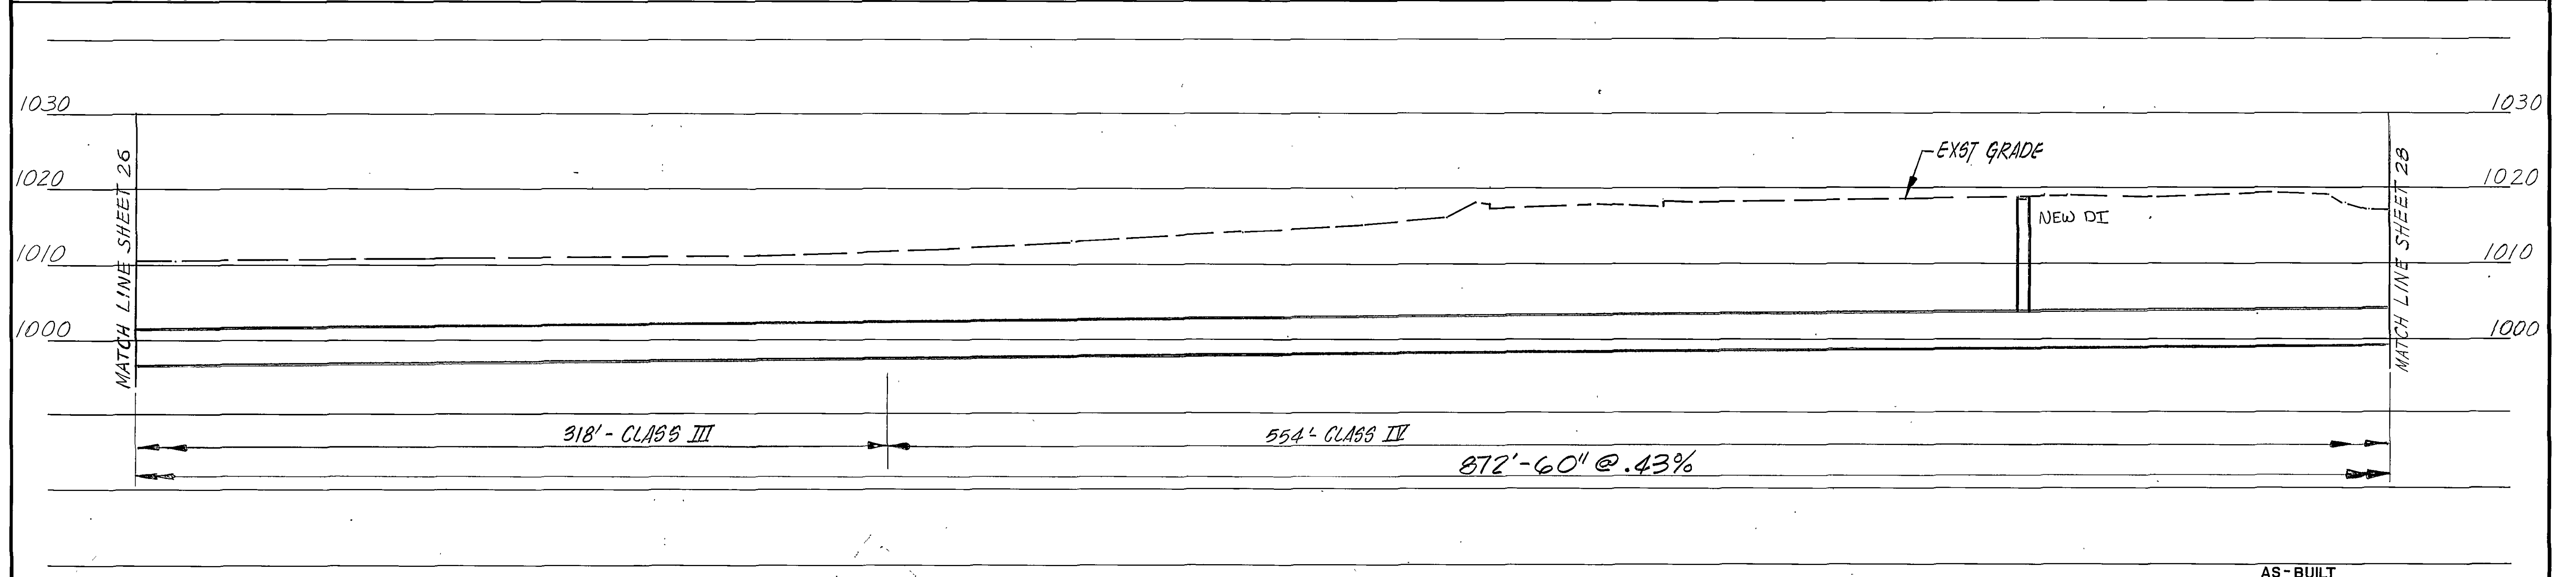
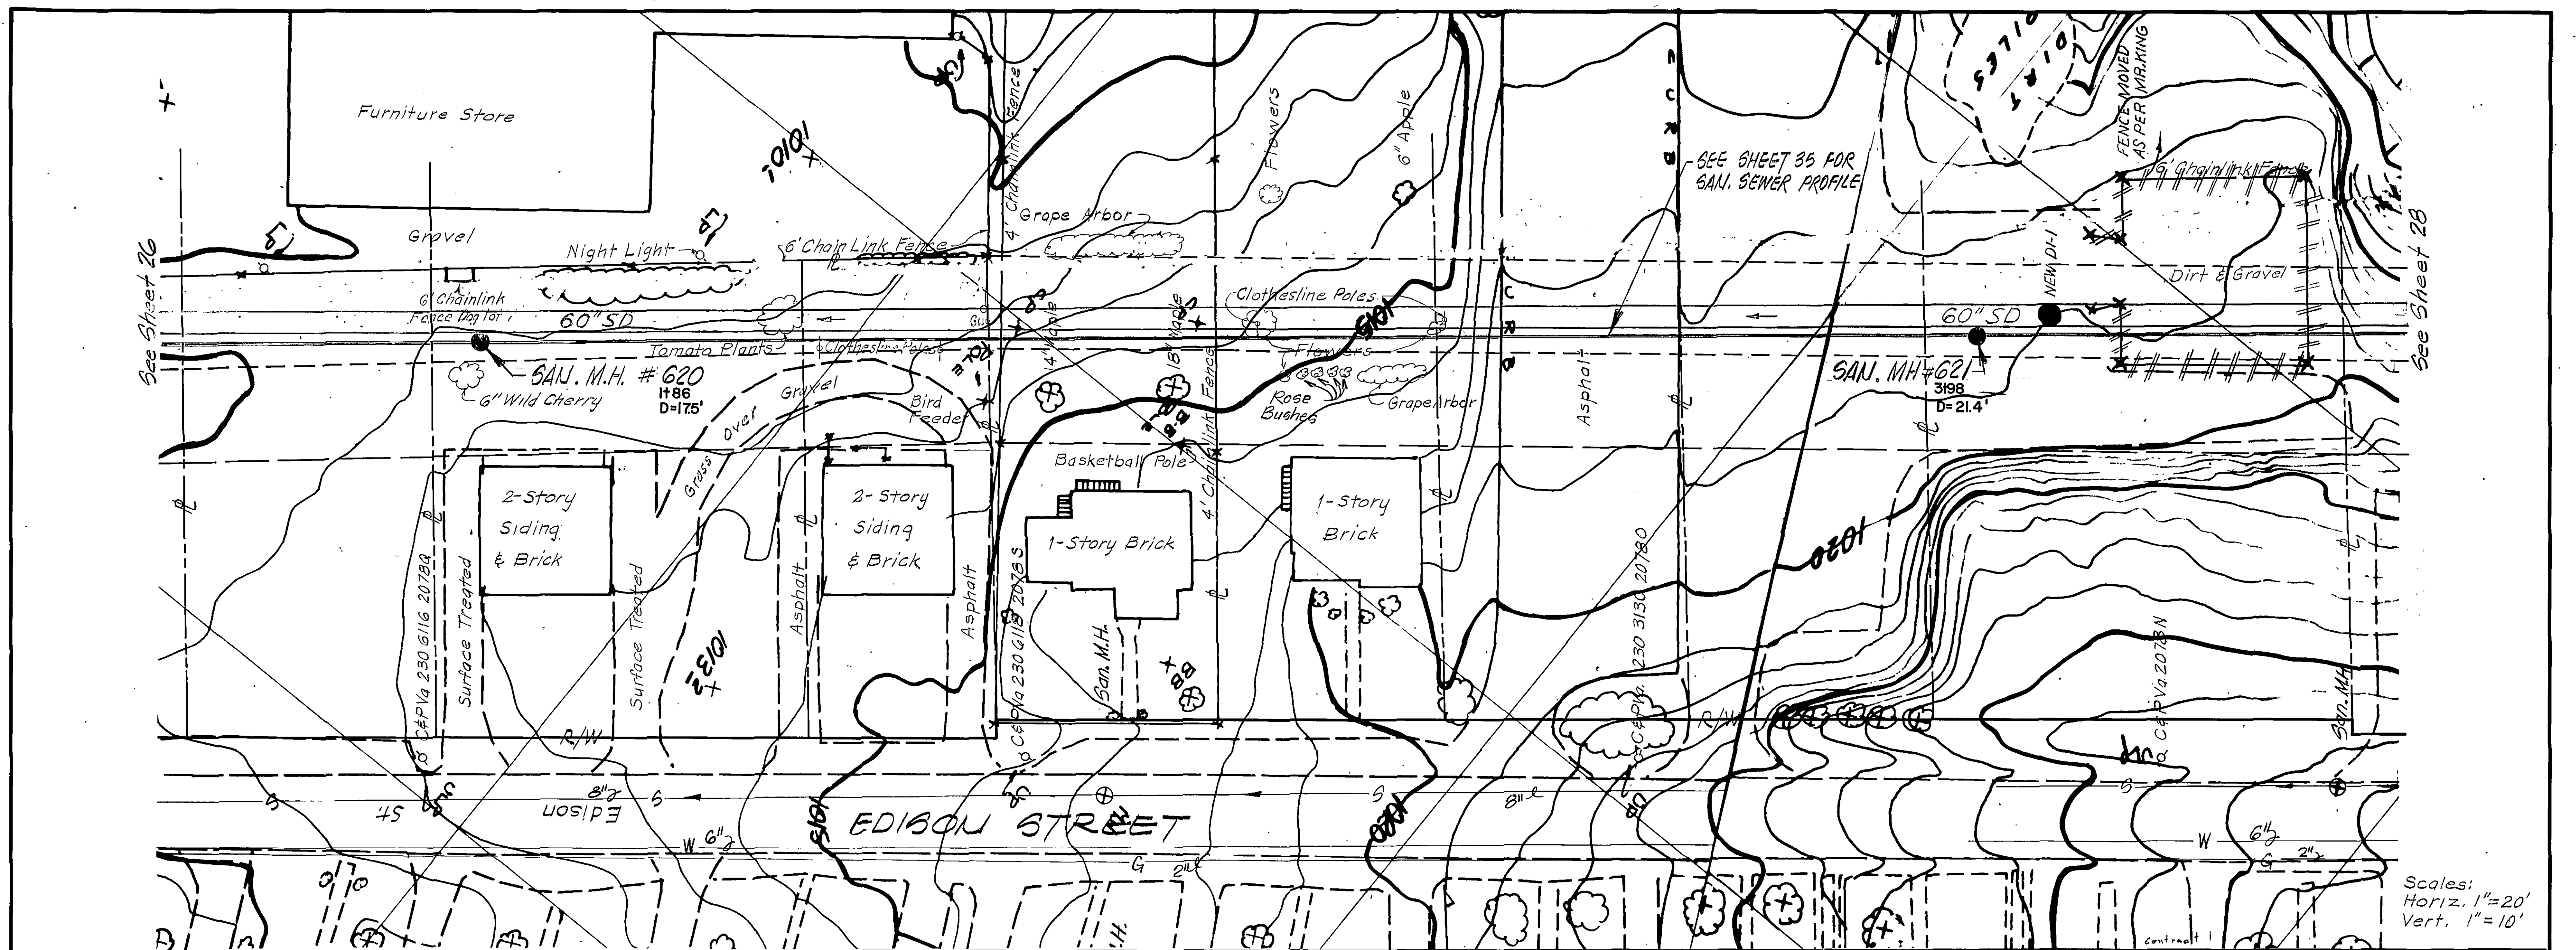
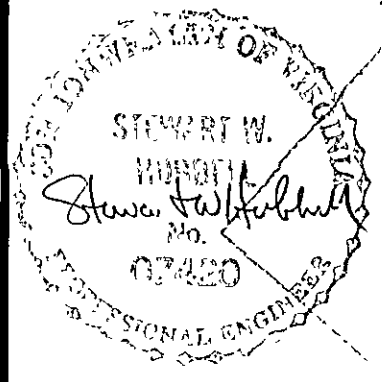


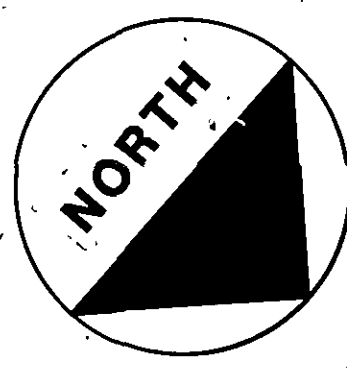

 SUITE 401 707 S. JEFFERSON STREET ROANOKE VIRGINIA 24011 (703) 345-9342	DESIGNED: CAT			REVISION	DATE	DESCRIPTION	BY	APP.	DATE	WILLIAMSON ROAD STORM DRAIN - PHASE 1 CONTRACT I ROANOKE, VIRGINIA PLAN AND PROFILE	SHEET 27
	CHECKED: Smith			11-10-86	RECORD DRAWINGS	JD	SW	JULY 1983			
	APPROVED: Smith							COMM. 428			