
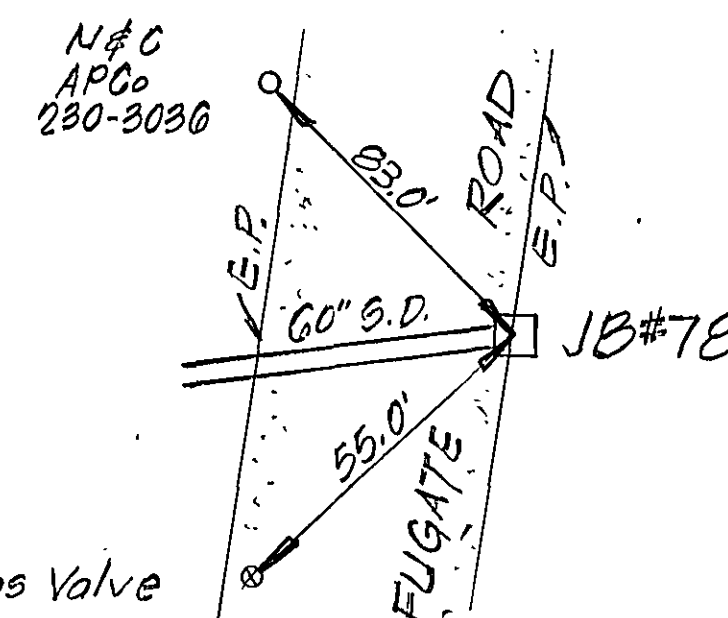


SEE SHEET 37 FOR
SANITARY SEWER
PROFILE

INVT. OUT 1003.62
DI#77

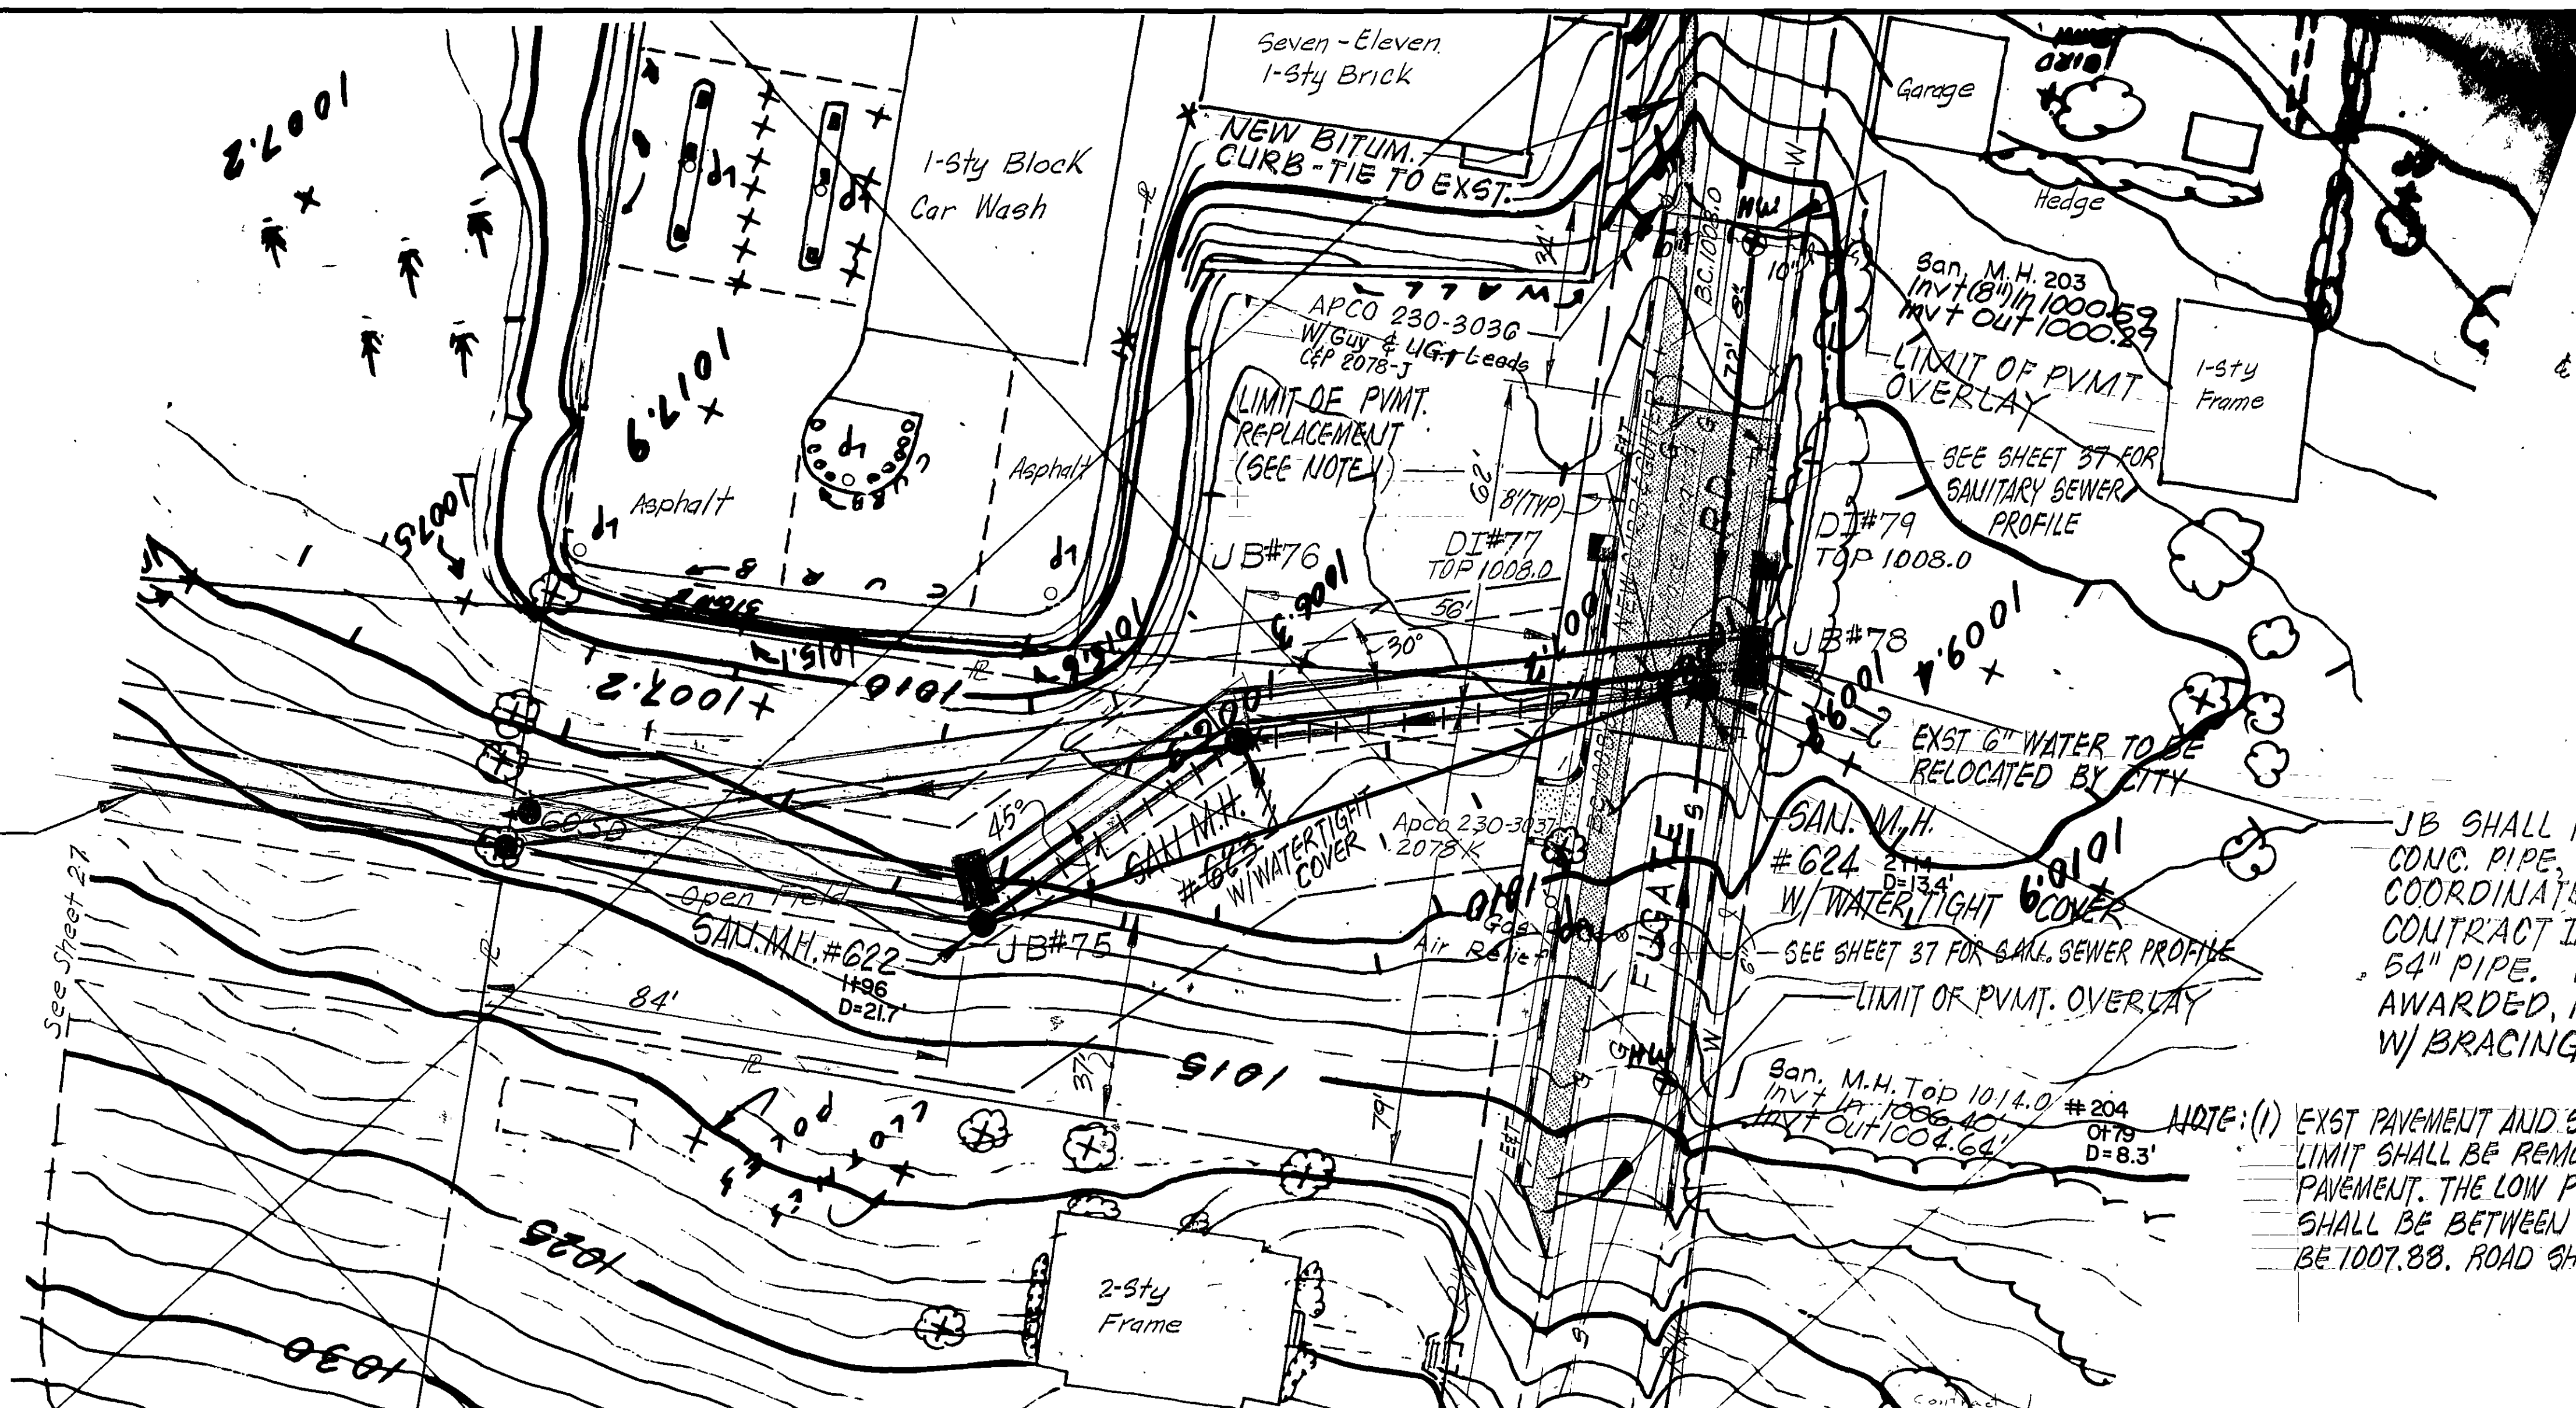


CENTER LOC. JB#78

JB SHALL HAVE A HOLE FOR 54" DIA.
CONC. PIPE, INVT. 1000.69 - CONTRACTOR
COORDINATE W/ CONTRACTOR OF
CONTRACT II, WHO IS TO INSTALL THE
54" PIPE. IF CONTRACT II IS NOT
AWARDED, PROVIDE 3/4" PLYWOOD
W/ BRACING OVER OPENING.

NOTE: (1) EXST PAVEMENT AND SUBGRADE AS REQ'D. WITHIN THIS
LIMIT SHALL BE REMOVED AND REPLACED WITH NEW
PAVEMENT. THE LOW POINT OF THE TOP OF THE NEW PVMT.
SHALL BE BETWEEN NEW INLETS. ELEV AT & ROAD SHALL
BE 1007.88. ROAD SHALL BE CROWNED AT 1/4" PER FOOT.

Scales:
Horiz. 1"=20'
Vert. 1"=10'

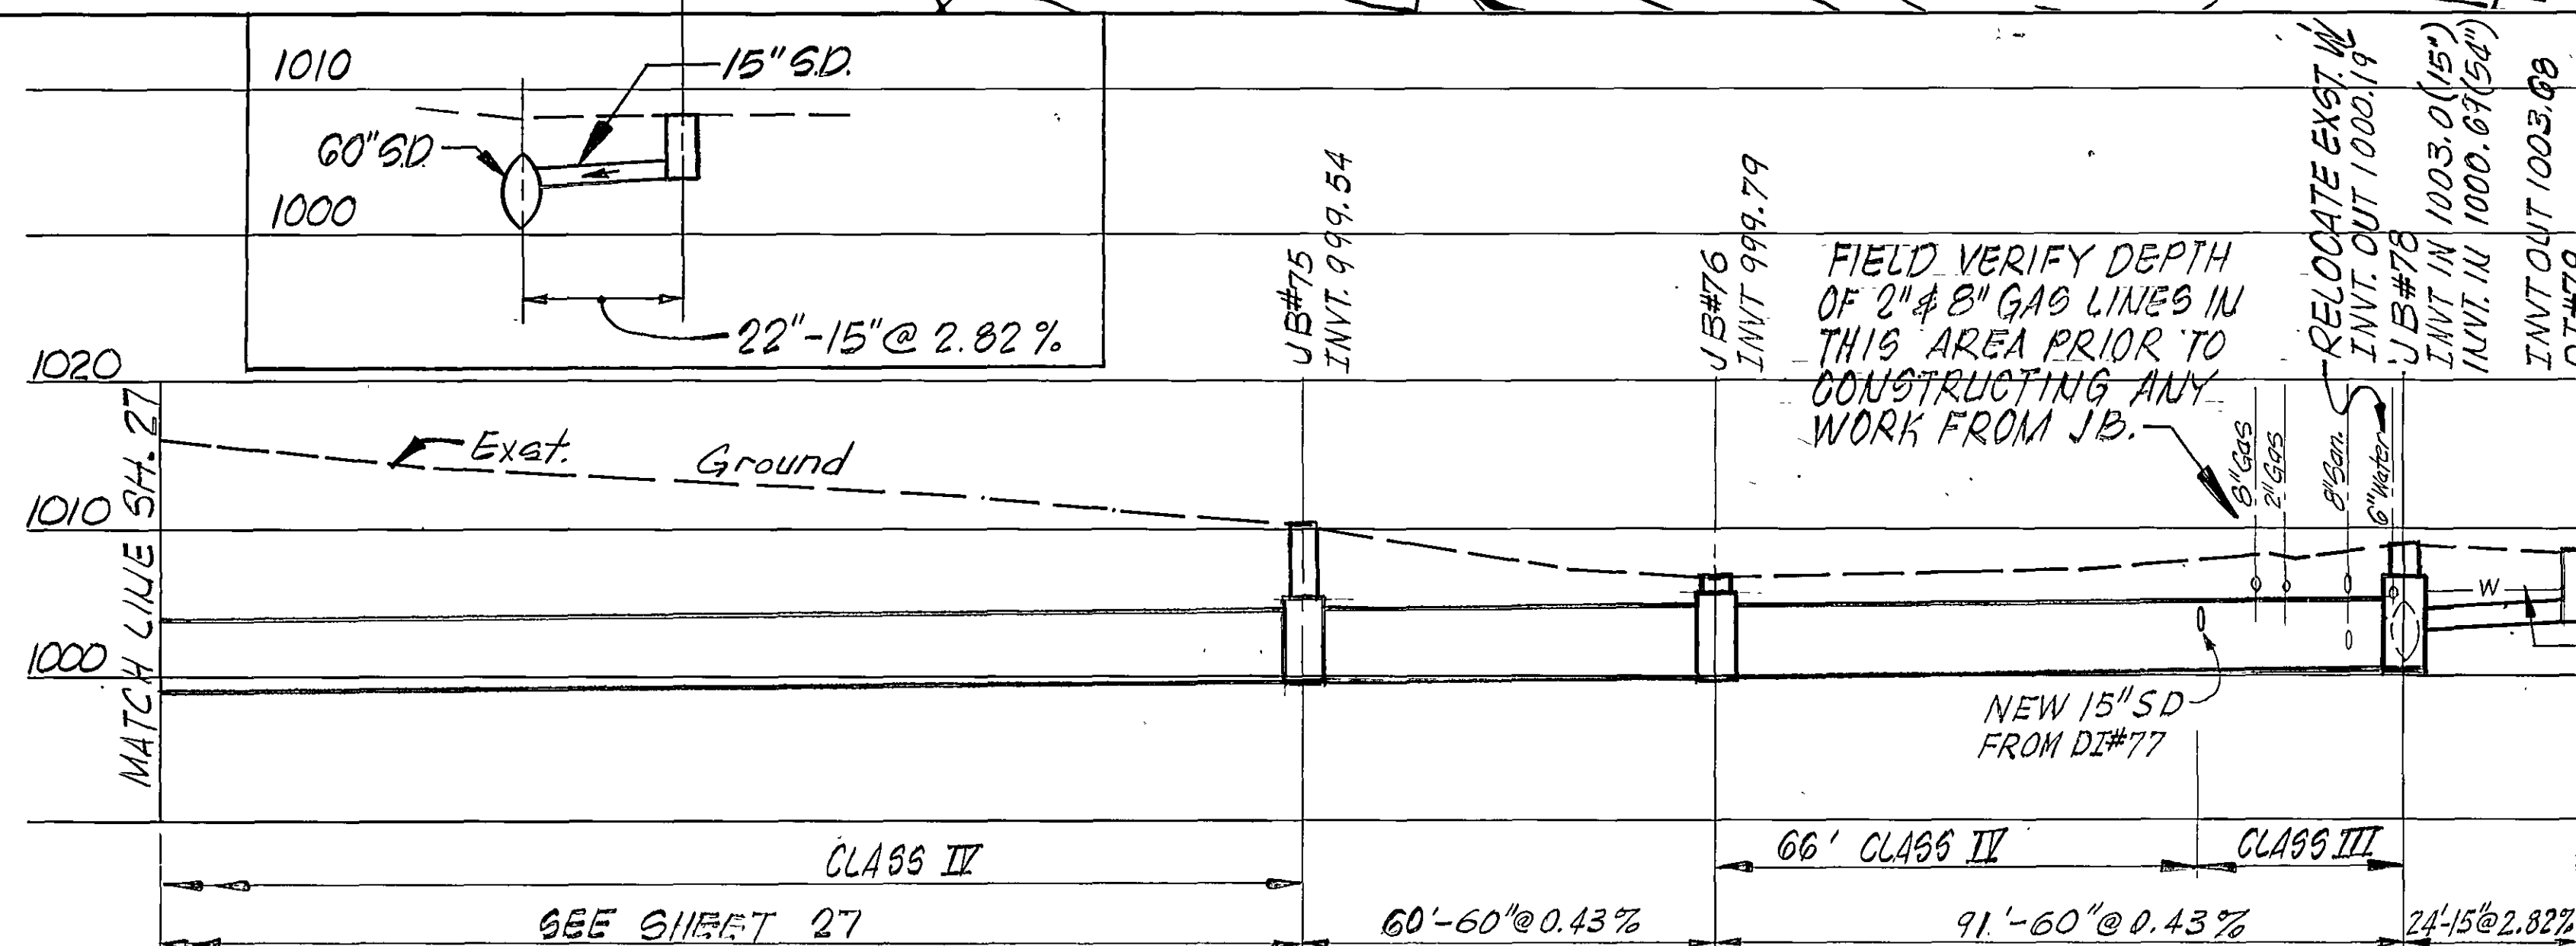

NOTE: THIS SHEET ~~MAY~~ BE REVISED
CITY WILL ADVISE - DUE TO
NEGOTIATION W/ PROPERTY OWNER


STORM DRAIN PROFILE

AS-BUILT



SUITE 401 707 S. JEFFERSON STREET ROANOKE VIRGINIA 24011 (703) 345-9342

DESIGNED:
CAT
CHECKED:
SMT
APPROVED:
SMT

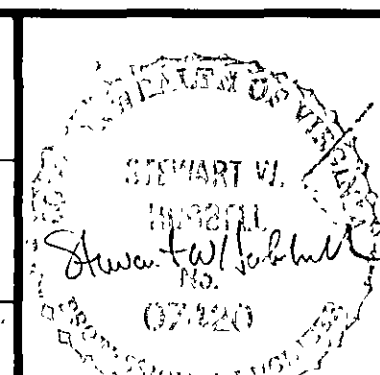

REVISION	DATE	DESCRIPTION	BY	APP
1	11-10-86	RECORD DRAWINGS	JD	SMT

DATE
JULY
1983
COMM.
428

WILLIAMSON ROAD STORM DRAIN - PHASE 1
CONTRACT I

ROANOKE,

VIRGINIA

PLAN AND PROFILE

SHEET

28