
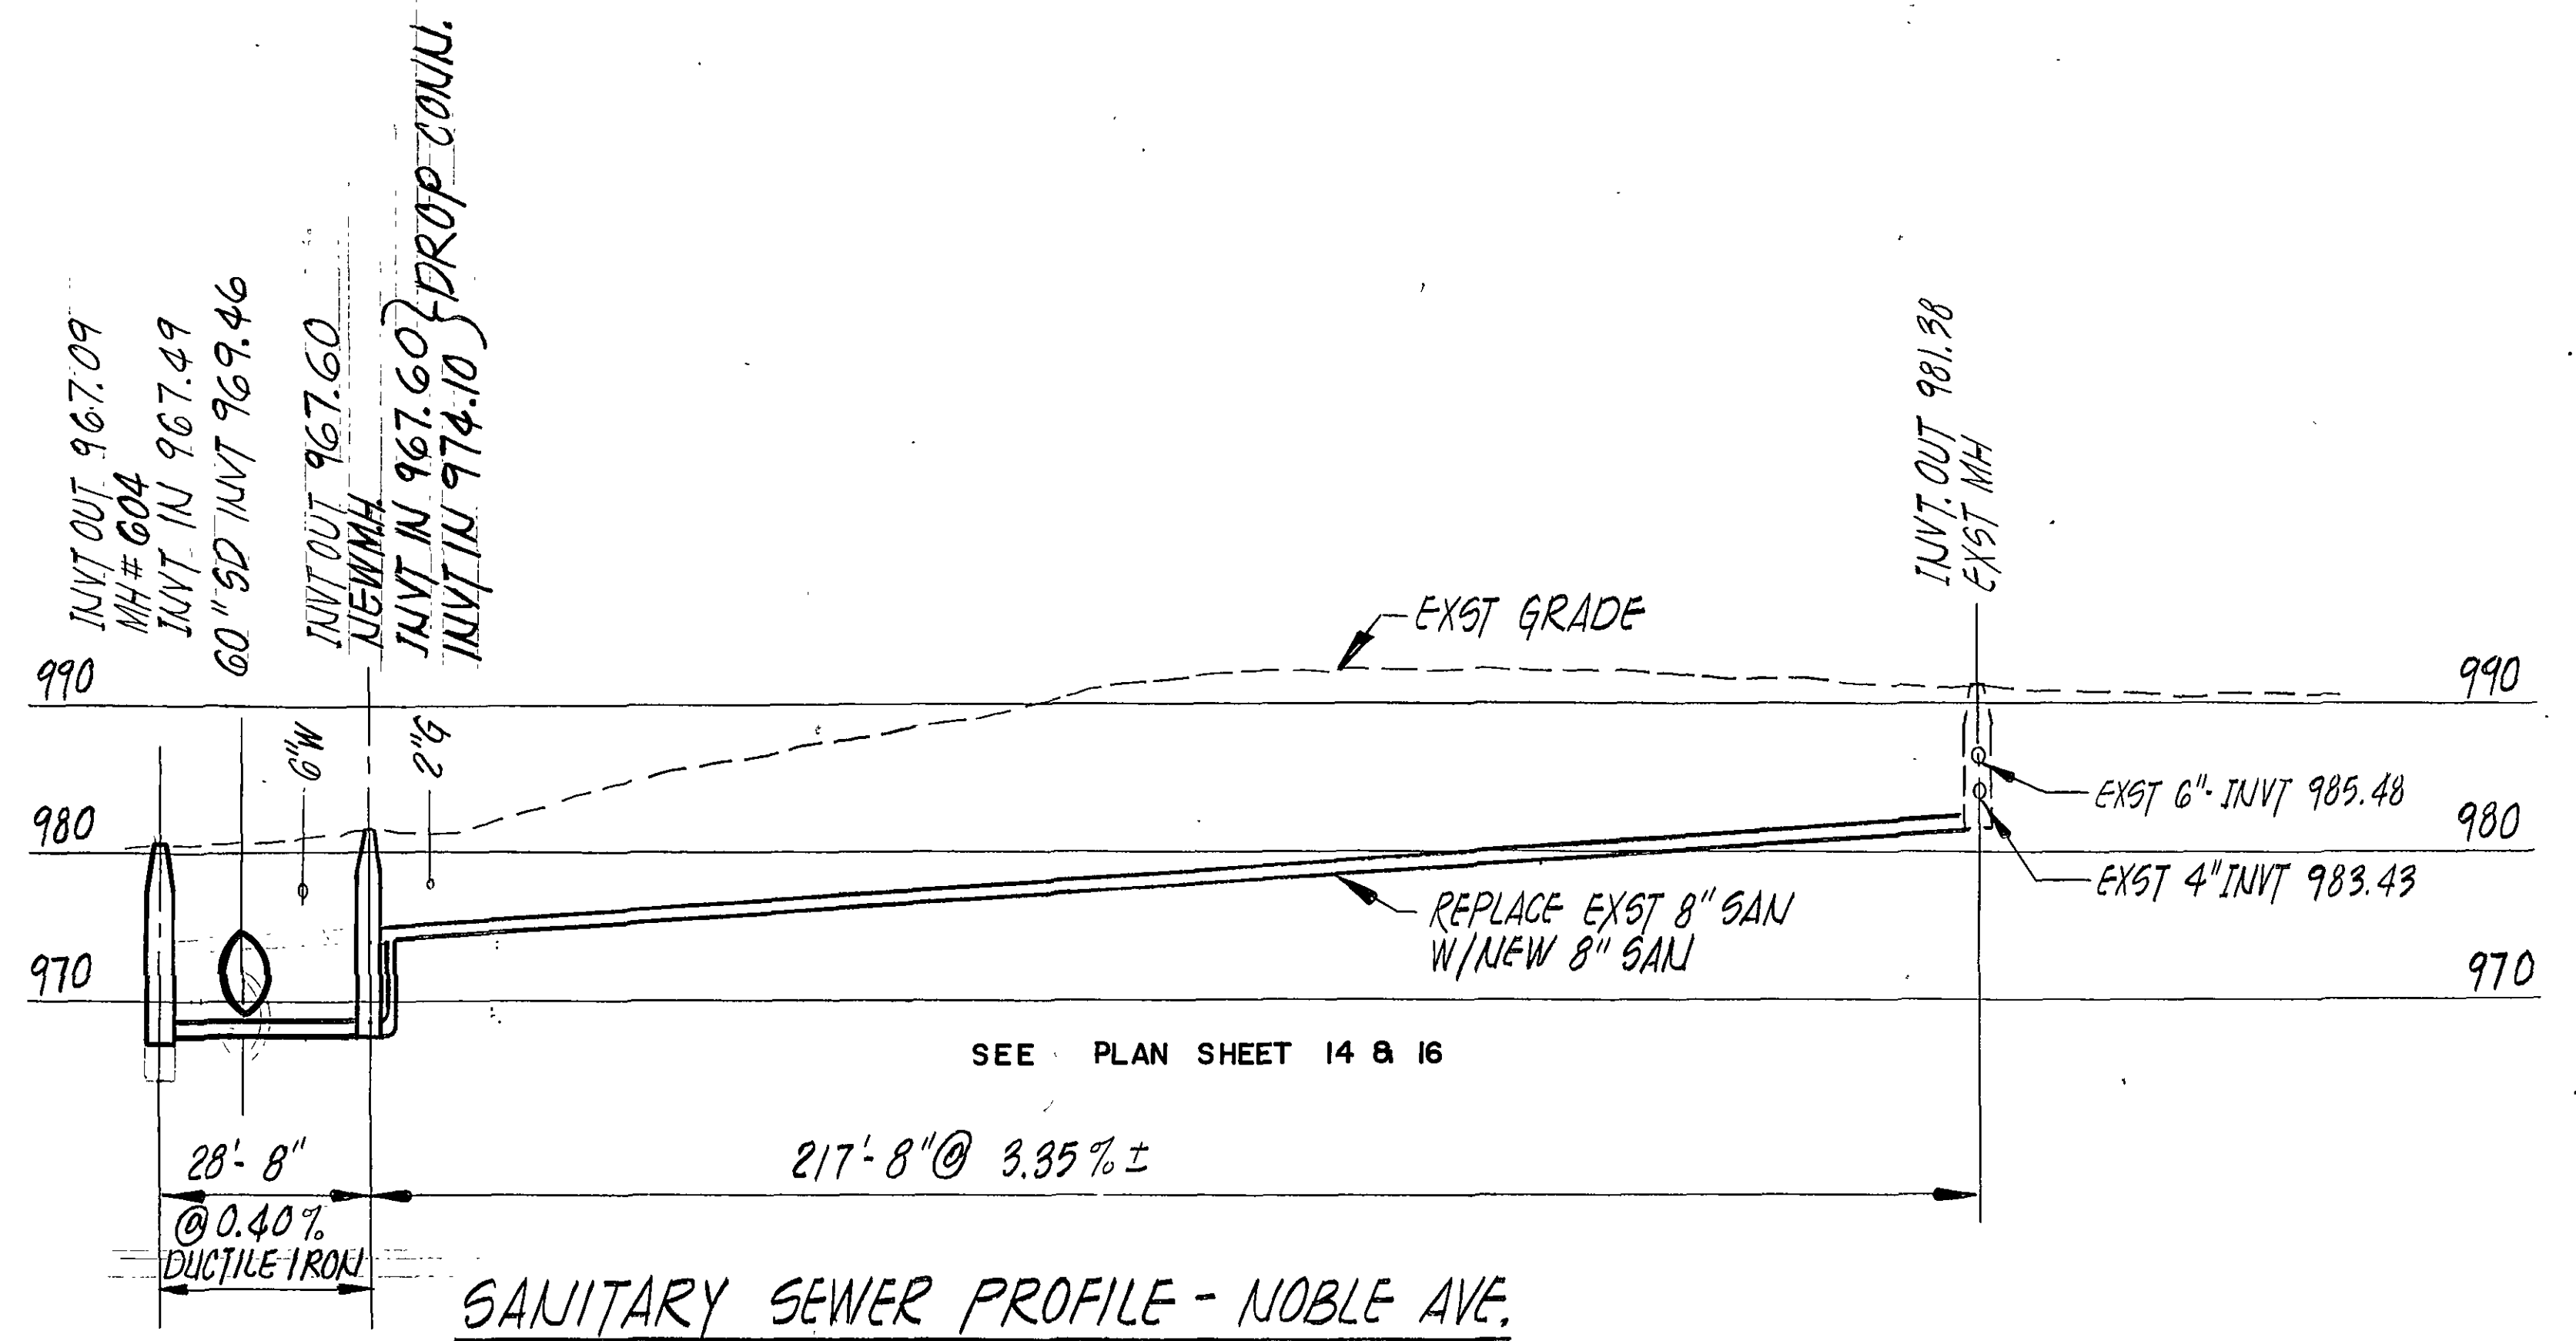
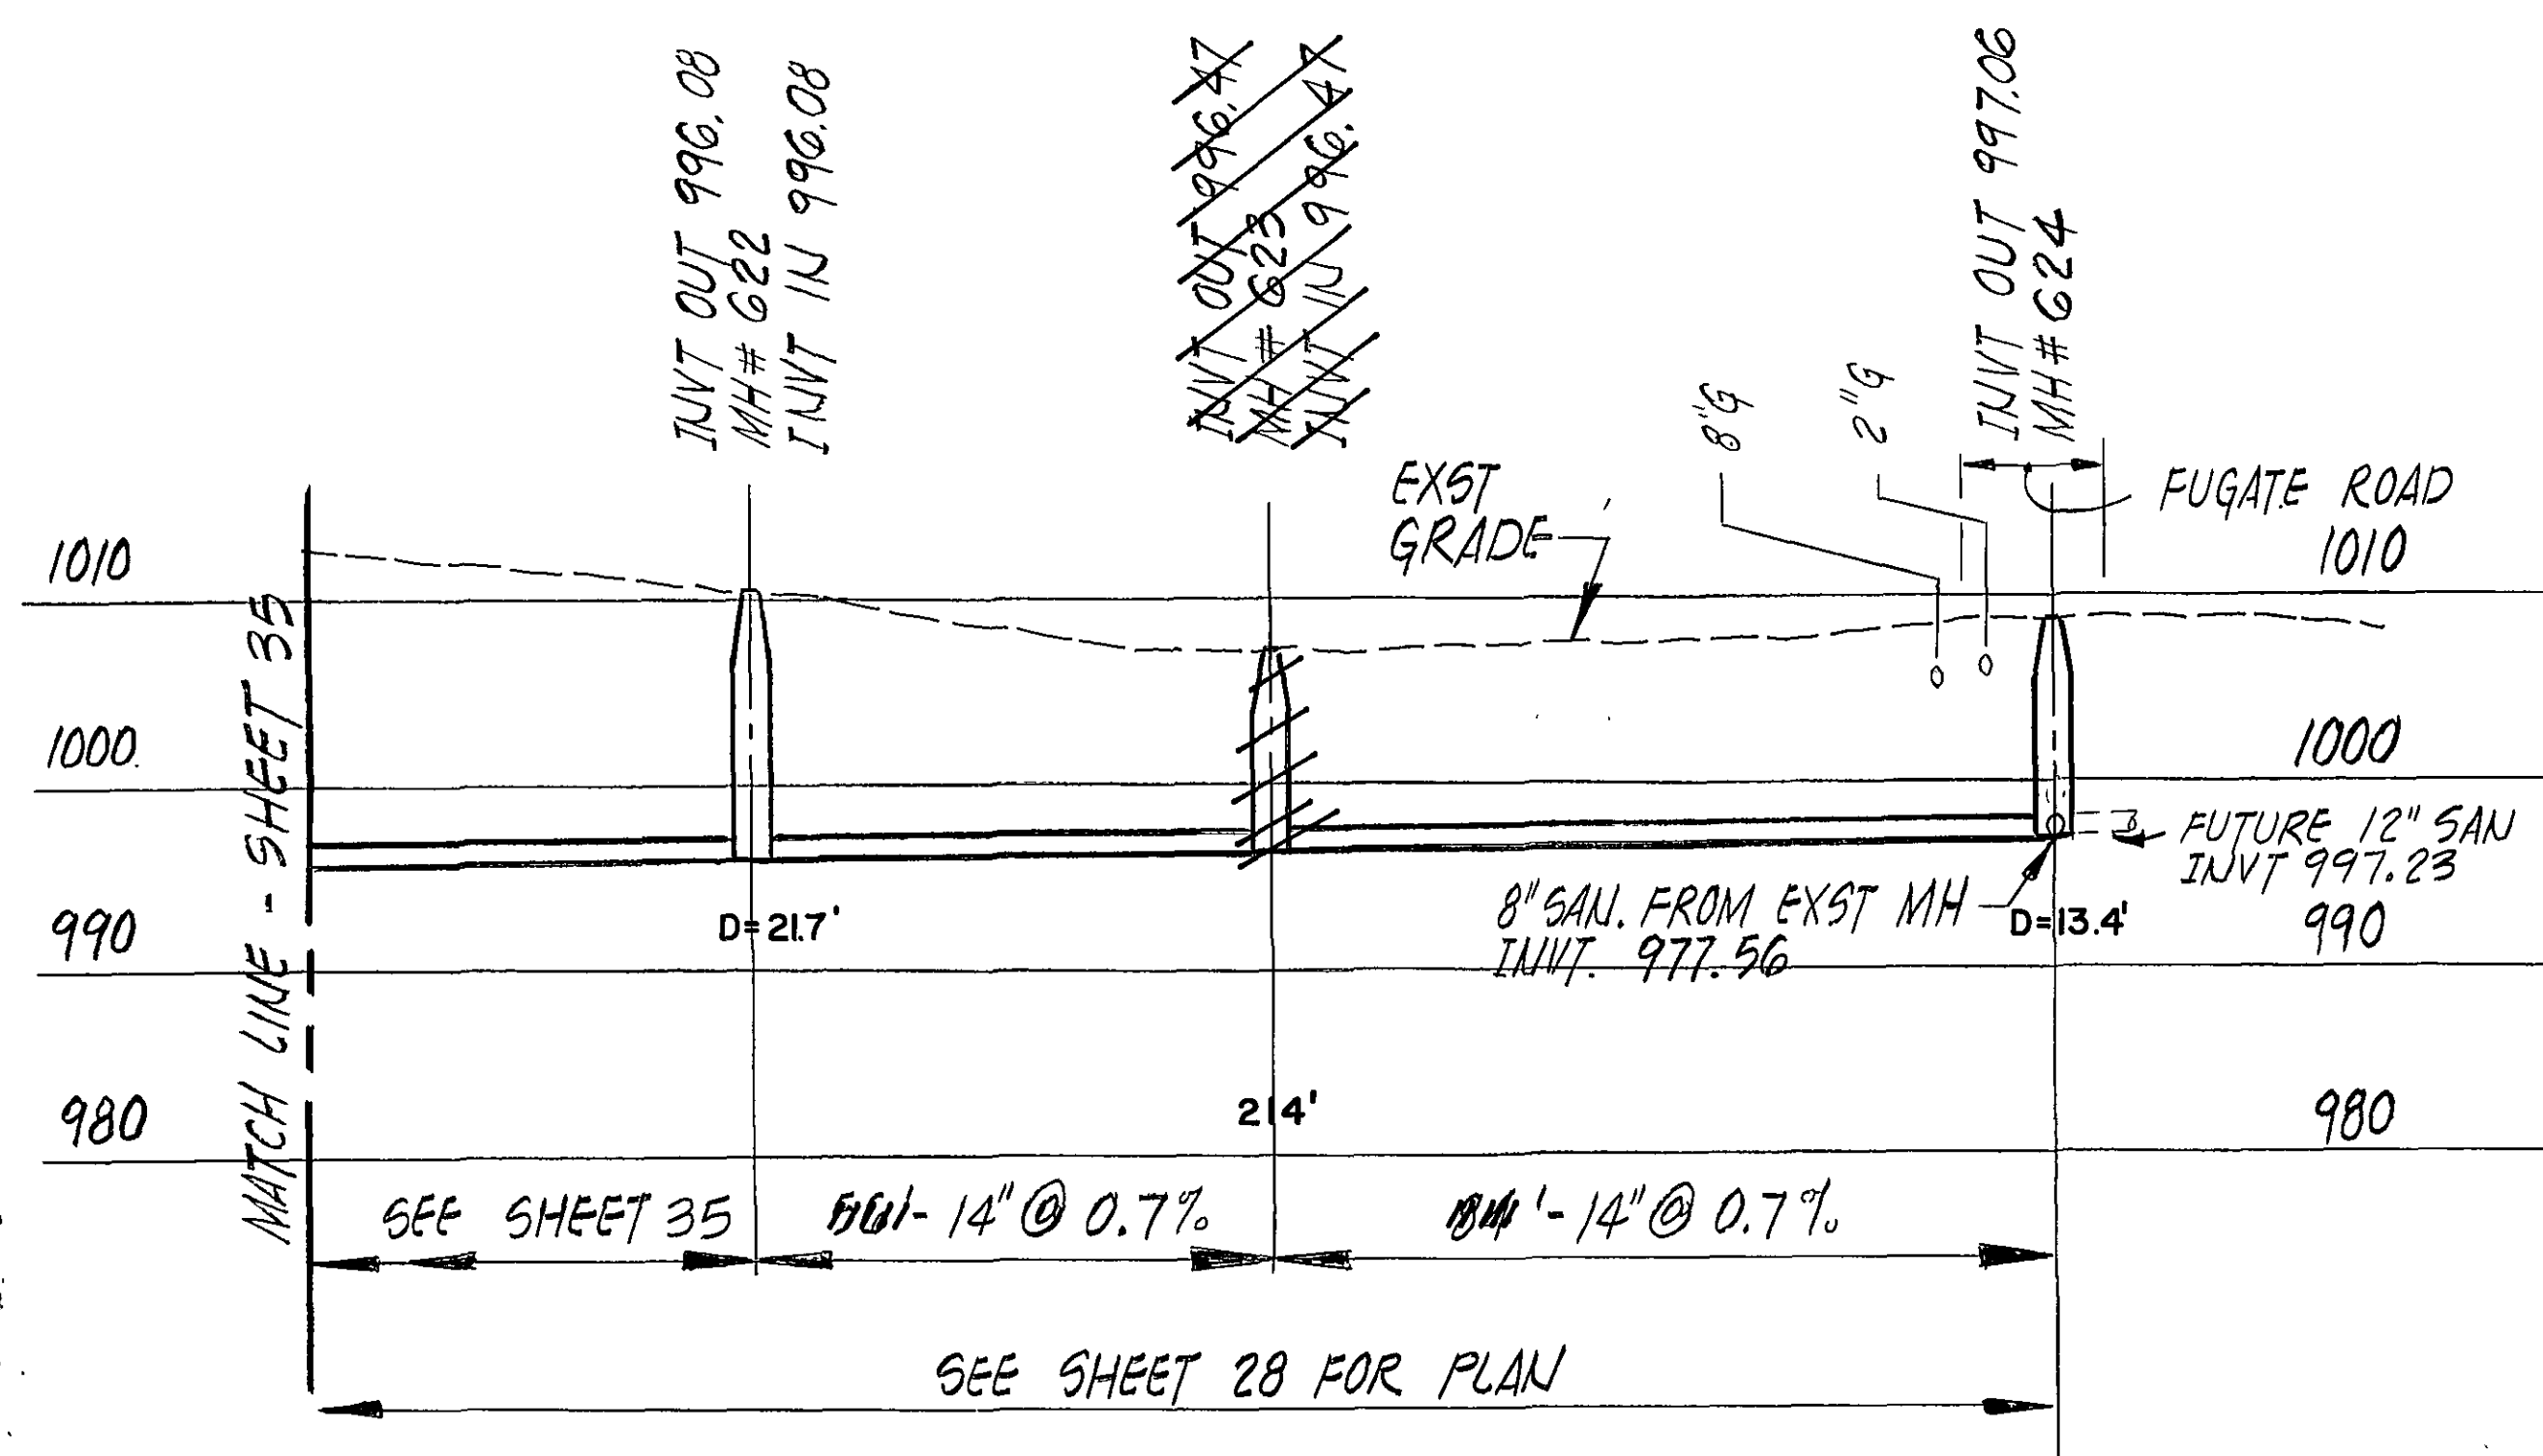
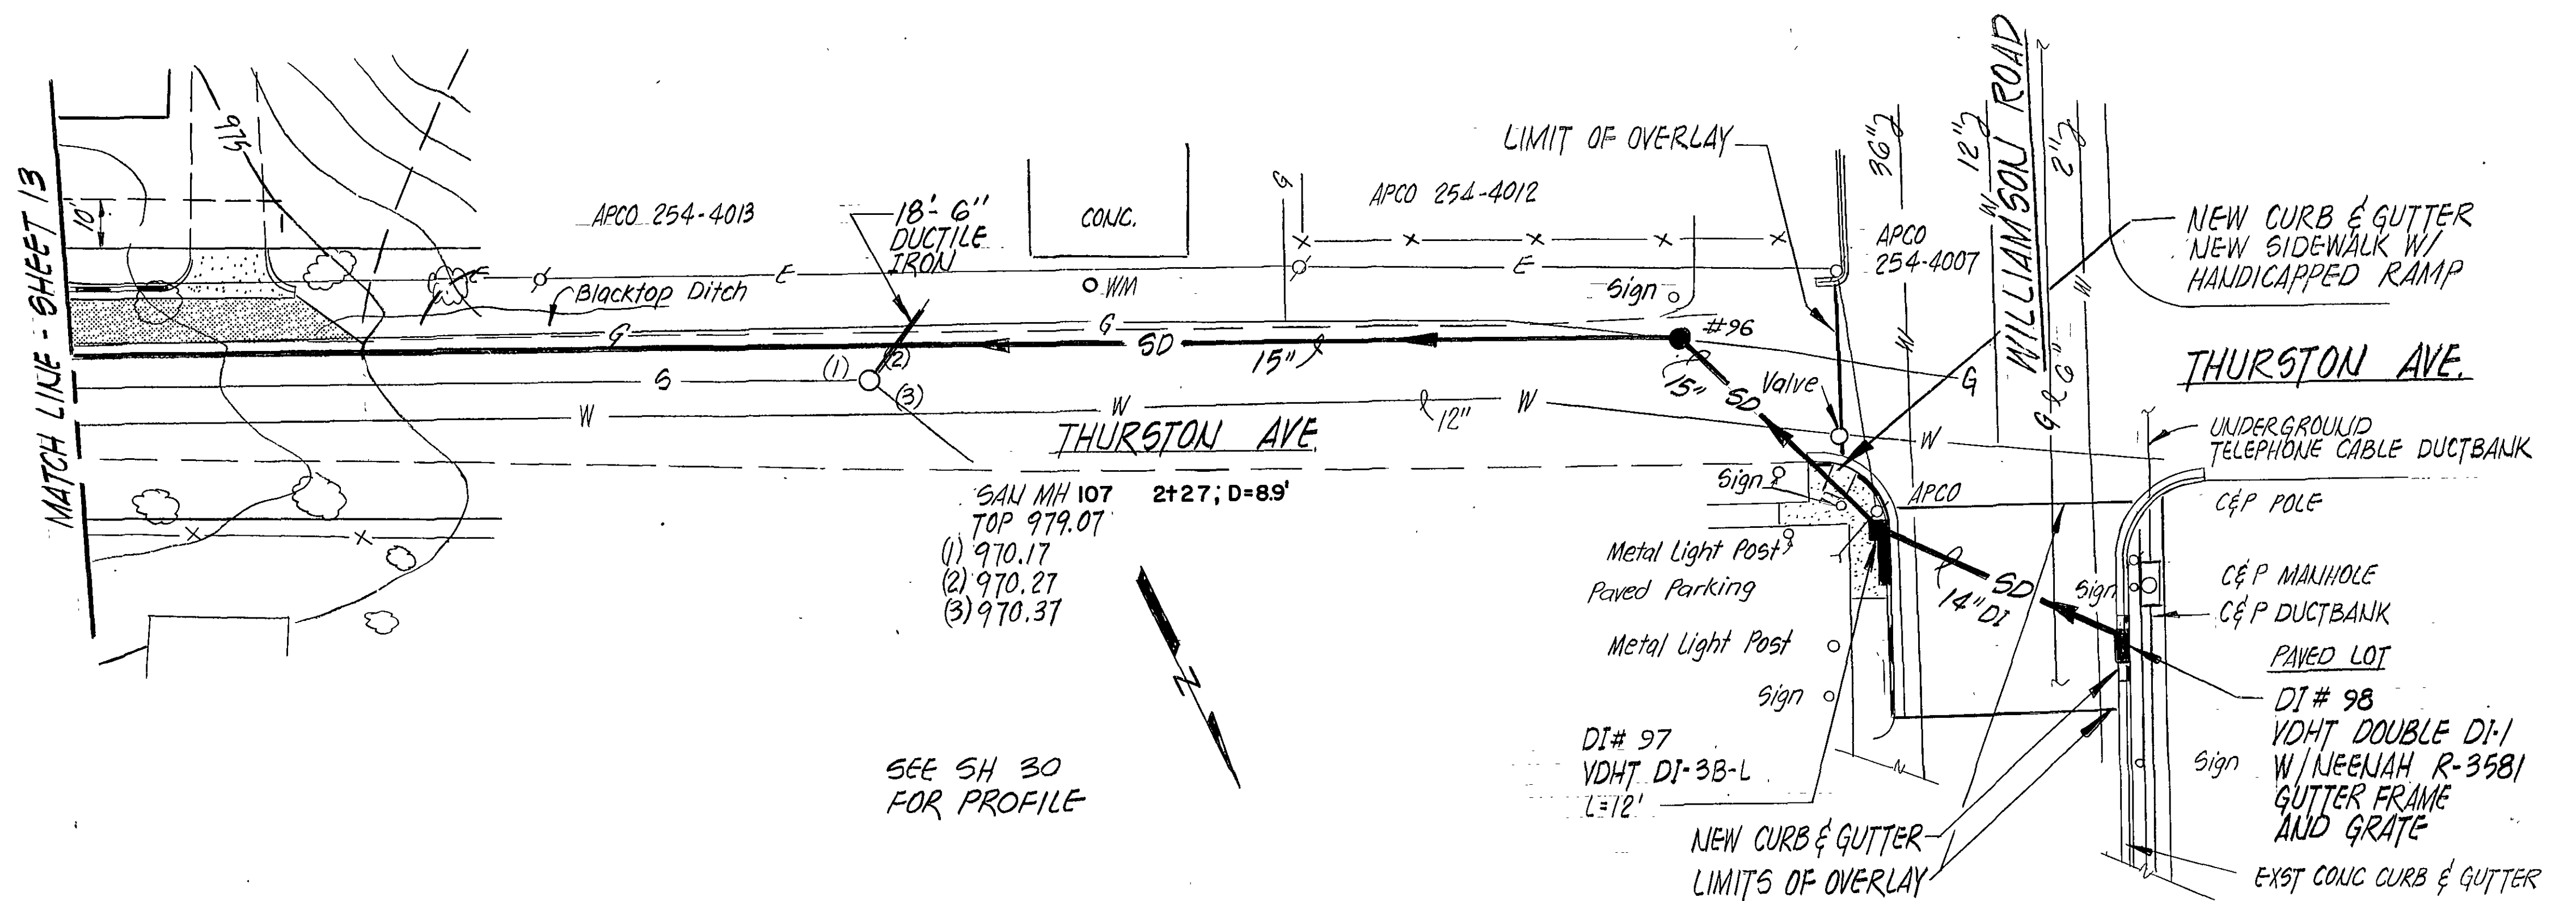


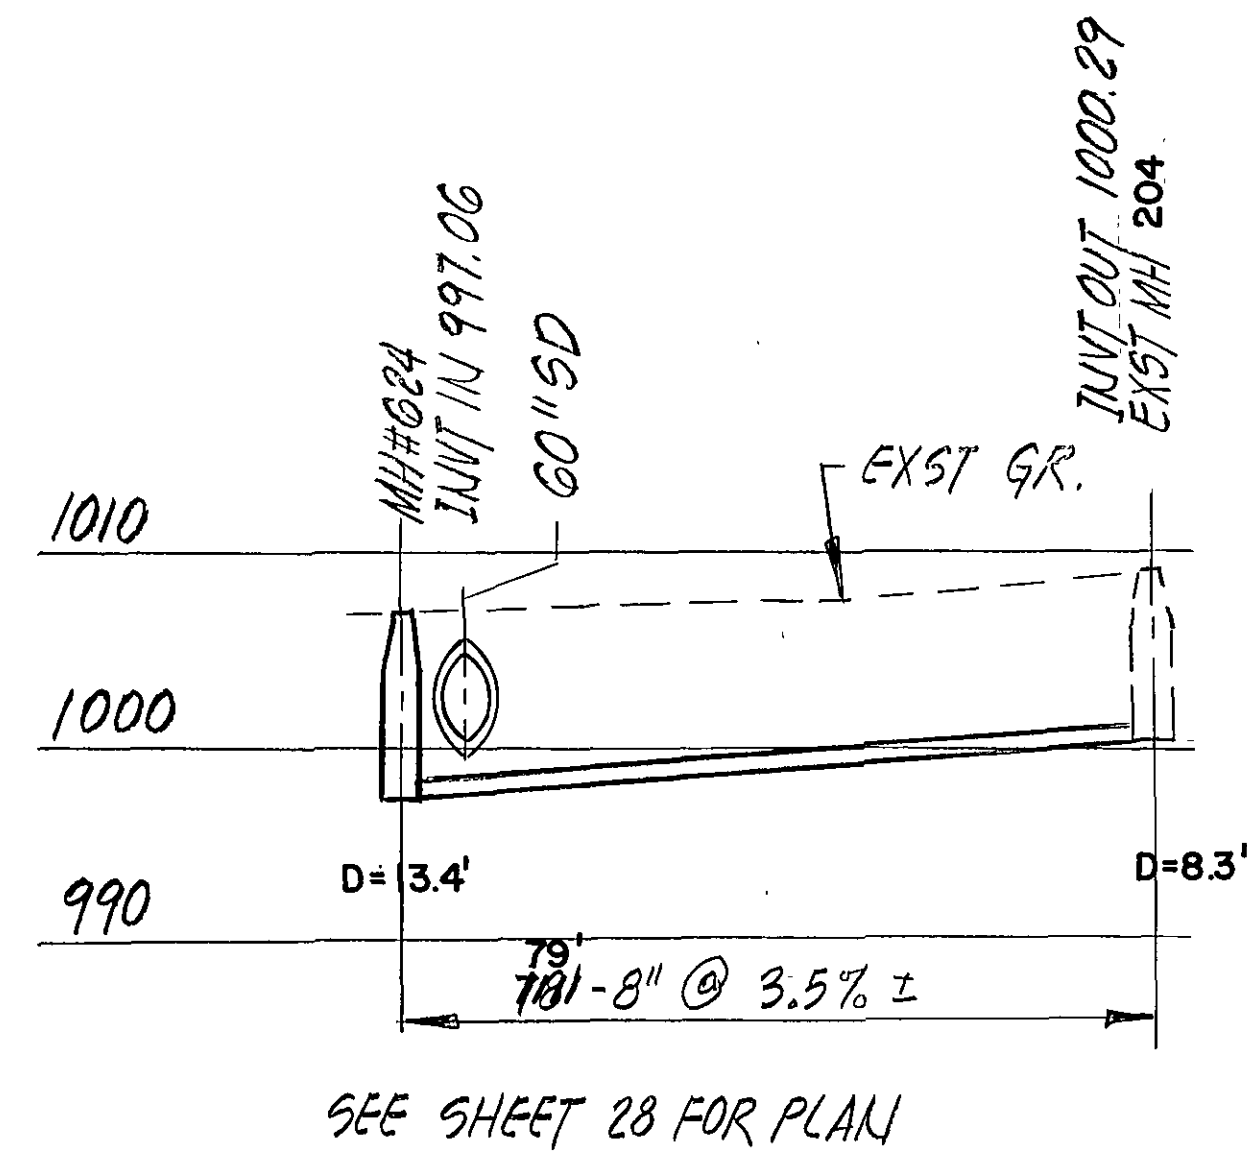

Mattern & Craig
CONSULTING ENGINEERS

SUITE 401, 707 S. JEFFERSON STREET ROANOKE, VIRGINIA 24011 (703) 345-9342

DESIGNED: CAT

CHECKED: Smith

APPROVED: Smith

Stewart H. H. H.

REVISION	DATE	DESCRIPTION	BY	APP
①	3-15-89	REV SAN & SD		gwh
②	11-10-86	RECORD DRAWINGS	JD	gwh

DATE
JULY
1983
COMM.
428

PLAN AND PROFILE

SHEET
37