


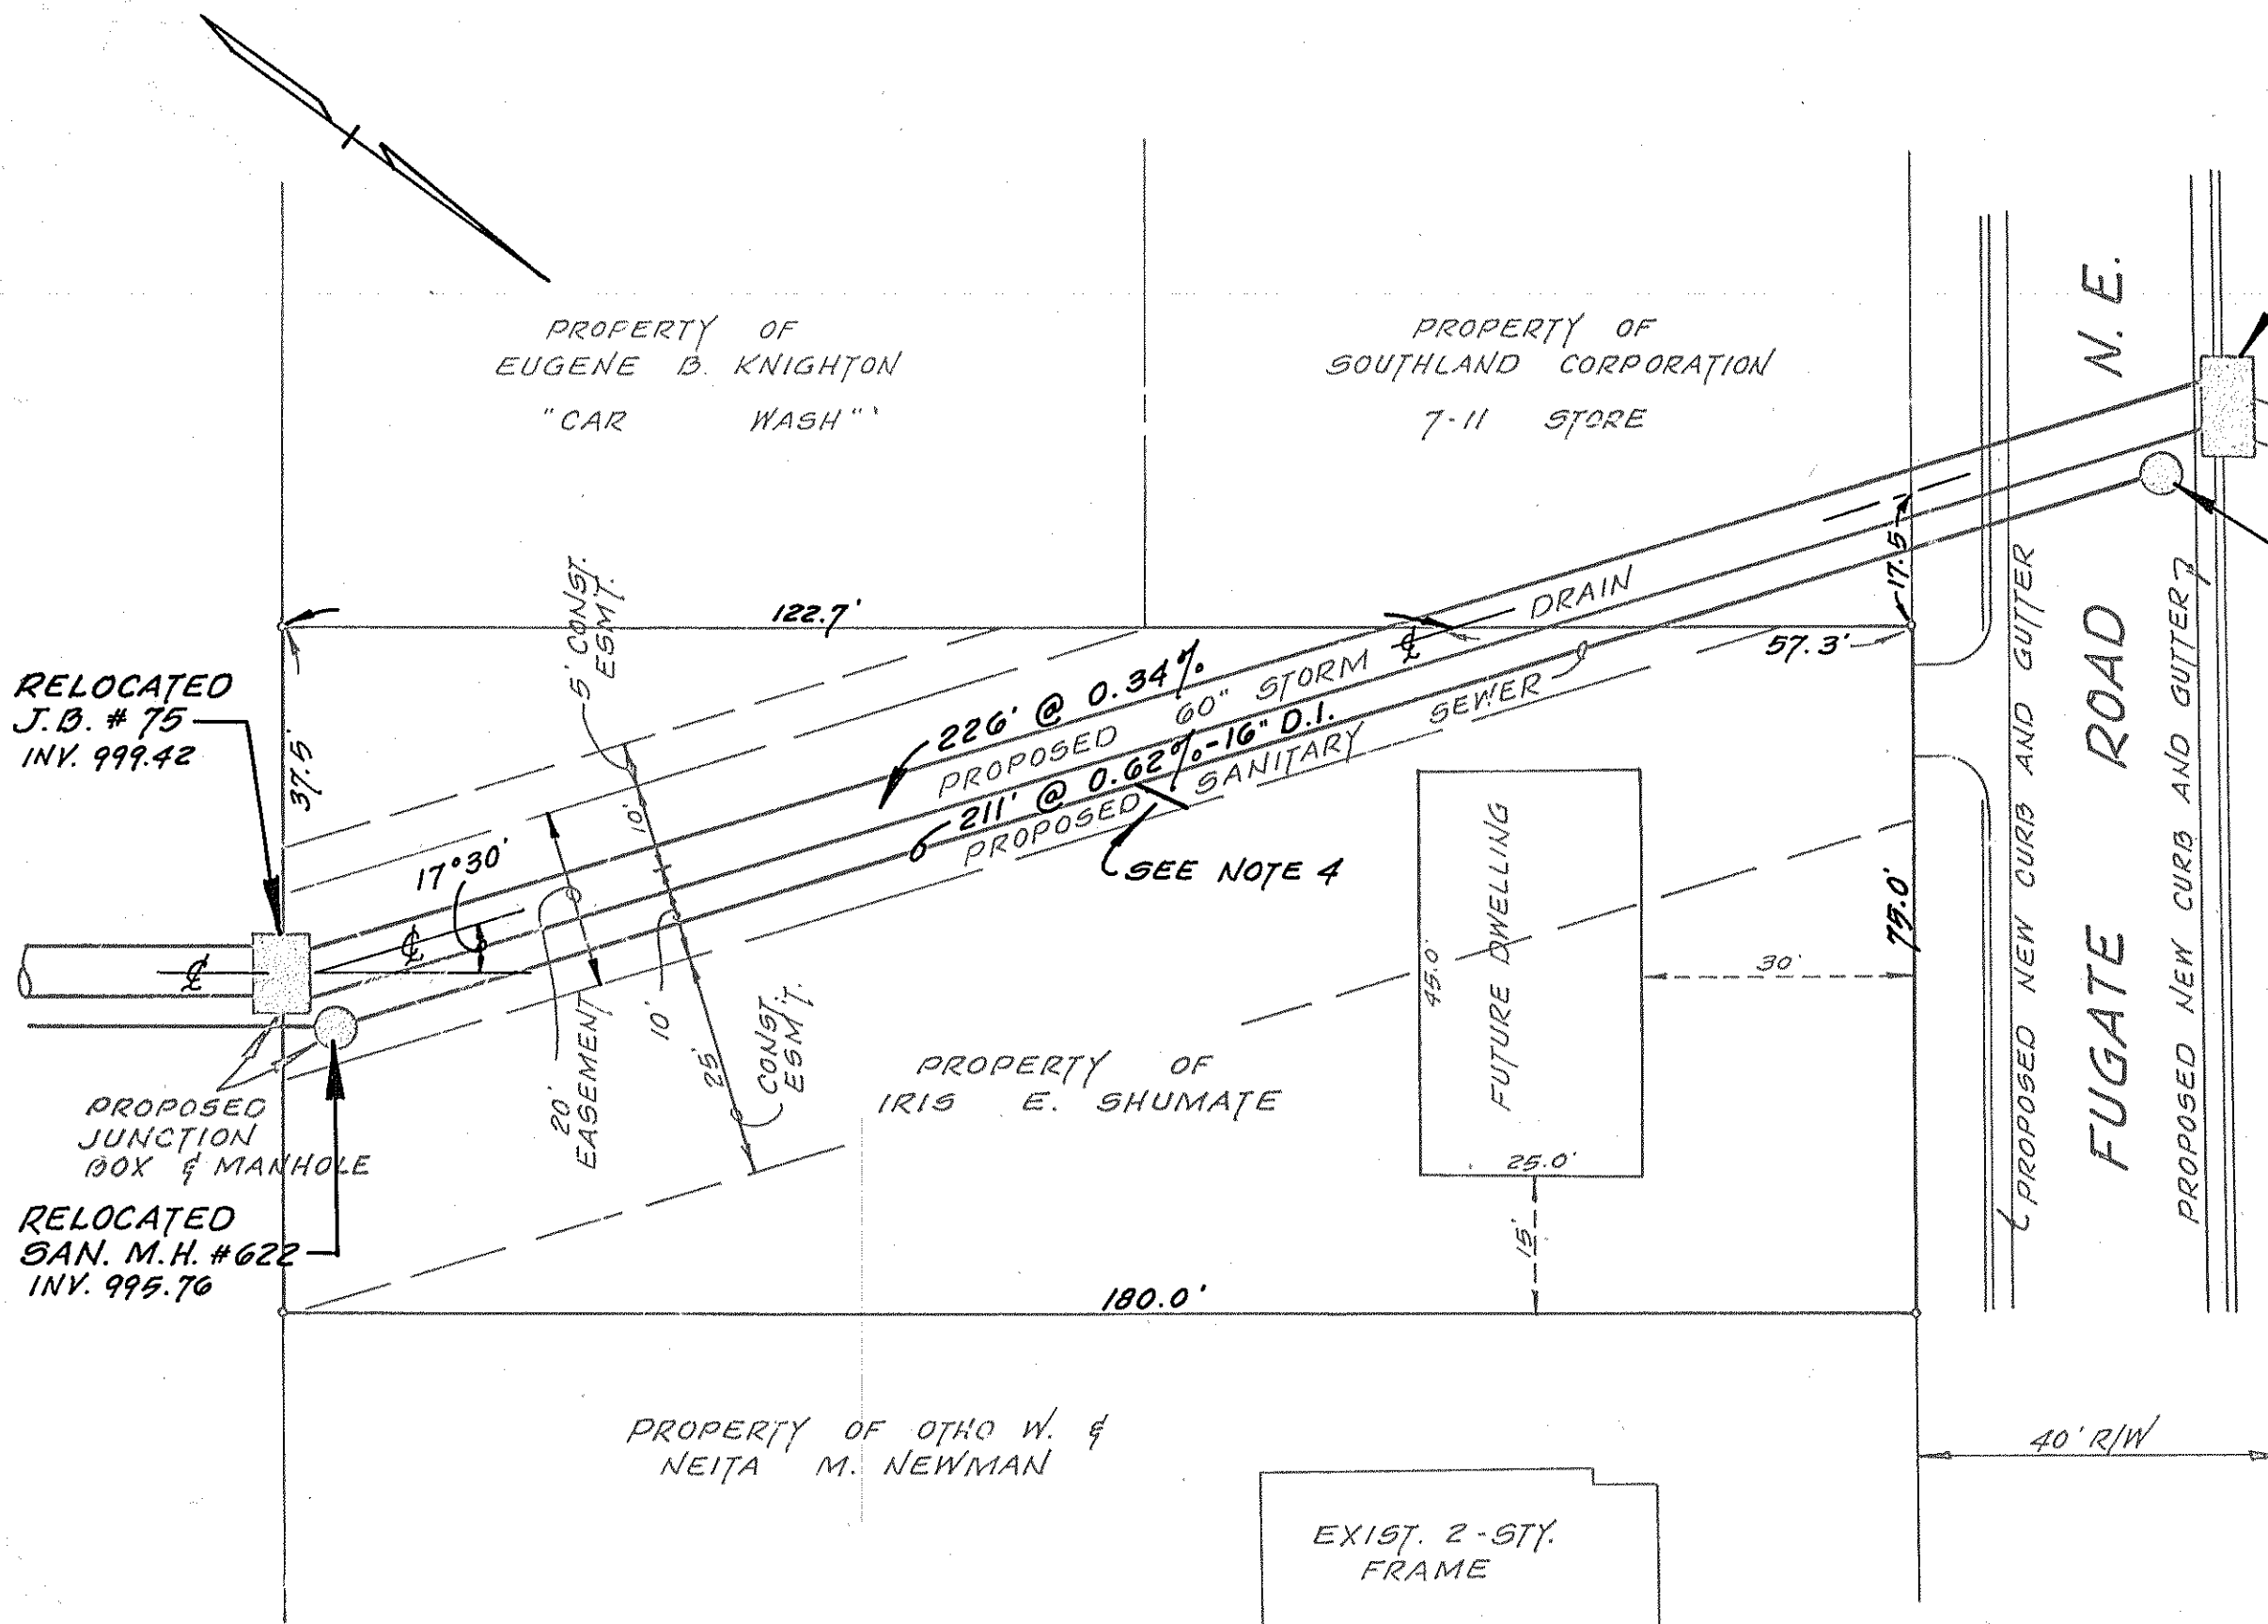

JB #78
INV. OUT 1000.19
INV. IN 1000.69 - SEE
NOTE ON SH. 28

SAN. M.H. #624
INV. OUT 997.06

RELOCATED
J.B. #75
INV. 999.42

RELOCATED
SAN. M.H. #622
INV. 995.76

- NOTES:
1. LOCATION OF JB #78 IS UNCHANGED.
 2. INVERTS OF RELOCATED JB #75 AND RELOCATED SAN. M.H. #622 ARE SAME AS PIPES AT THESE LOCATIONS PRIOR TO THE RELOCATIONS.
 3. EASEMENT ON SOUTHLAND CORP. (7-11) PROPERTY HAS NOT CHANGED.
 4. INSTALL A SAN. SEWER LATERAL AT THIS APPROX. LOCATION, EXTEND TO ESM'T. LINE AND CAP (WATERTIGHT) FOR FUTURE CONNECTION. OBTAIN AN ACCURATE DESCRIPTION OF THE LOCATION AND MARK ON RECORD PLAN SET.
 5. LOCATION OF SAN. M.H. #624 IS UNCHANGED. INVERT SHALL REMAIN AS SHOWN. ANY ADJUSTMENT SHALL OCCUR IN THE SLOPE.

#5825-T

(NOT TO SCALE)